



TFIBER

TELANGANA FIBER GRID

TELANGANA FIBER GRID CORPORATION LIMITED
GOVERNMENT OF TELANGANA

AS BUILT DOCUMENTATION (ABD) FOR PLB HDPE DUCT LAYING – INTRA

District Name : VIKARABAD

Mandal Name : MOMINPET

ABD Agency Name : M SAVITRI

MB Agency Name : M SAVITRI

ABD Length in Kms : 1.951 Kms

VIKARABAD DISTRICT			
MOMINPET MANDAL			
SL.No	Village Name	Books	Meters
1	GUTTAMEEDI TANDA	1	326
2	KASALABAD TANDA	1	694
3	MITYANAIK TANDA	1	671
4	YELLAMMAGADDA TANDA	1	260
Total			1951



TELANGANA FIBER GRID

TELANGANA FIBER GRID

ITE & C GOVERNMENT OF TELANGANA

7th Floor, Splendid Towers, S.P. Road

Opp: Begumpet Police Station,



Begumpet, Hyderabad-500016.


 






AS - BUILT DRAWINGS (ABD)

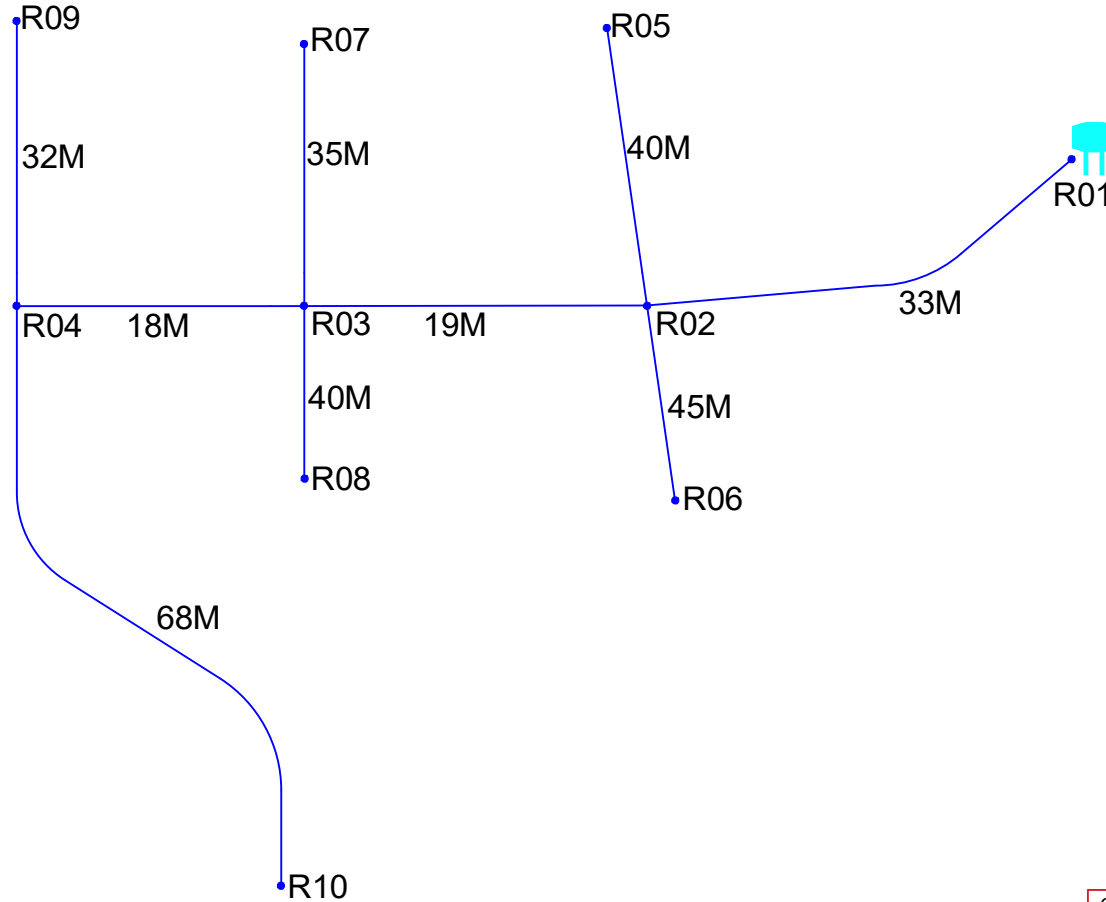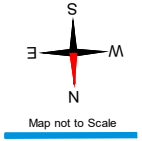GUTTAMEEDI TANDA

(MOMINPET MANDAL-VIKARABAD DIST.)

SINGLELINE LOOP DIAGRAM FOR GUTTAMEEDI TANDA (MOMINPET)






 






	DUCT PIPE
	ROAD
	OHSR
	G.P OFFICE
	TEMPLE
	HOSPITAL
	SCHOOL
	DUCT GAP

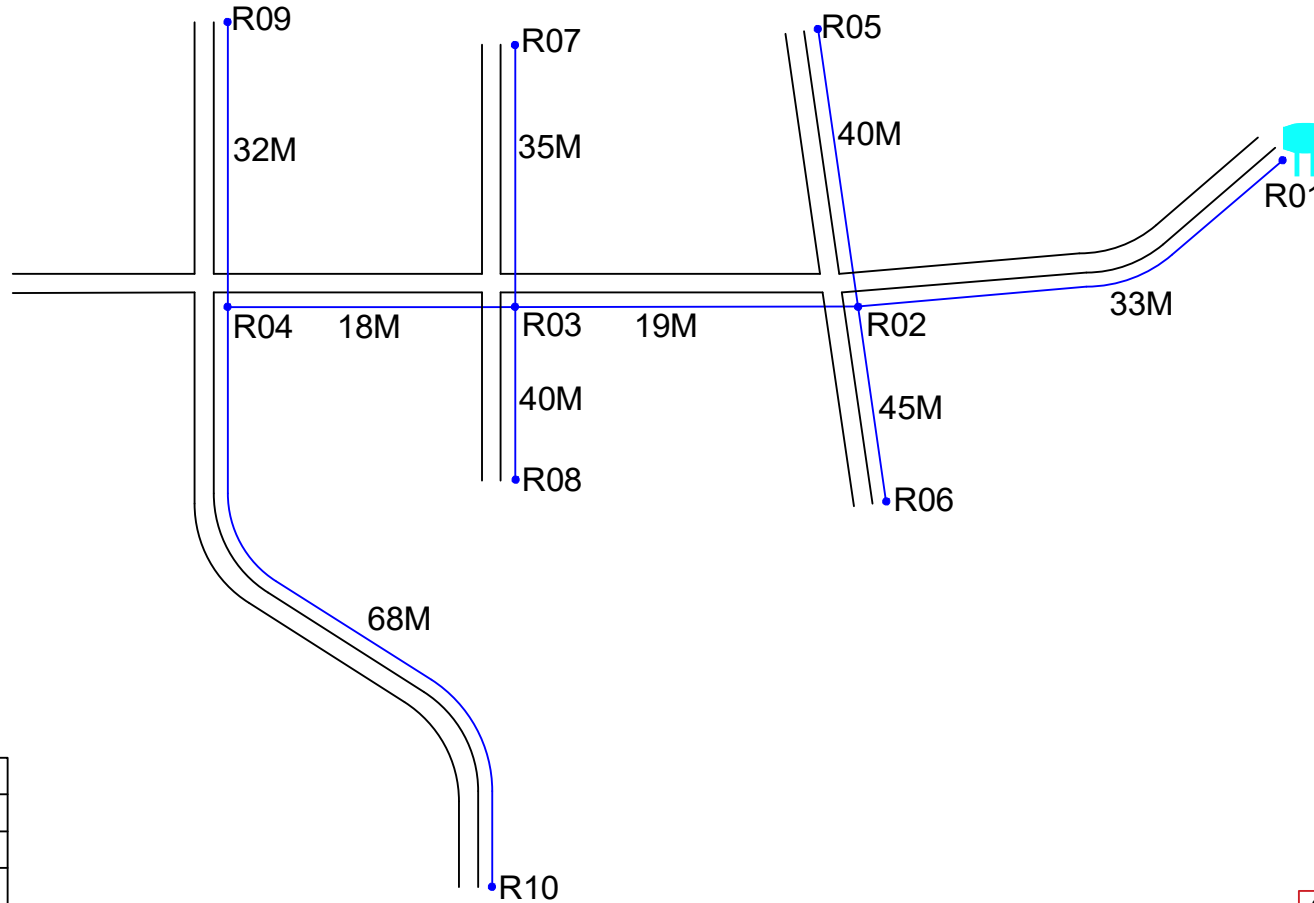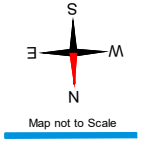Sheet No. 01
Route Distance : 326 M

Checked	Designation	Signature

DUCTLAYING ROUTE DIAGRAM FOR GUTTAMEEDI TANDA (MOMINPET)




	DUCT PIPE
	ROAD
	OHSR
	G.P OFFICE
	TEMPLE
	HOSPITAL
	SCHOOL
	DUCT GAP

Sheet No. 01
Route Distance : 326 M

Checked	Designation	Signature


ROAD OFFSET DETAILING FOR GUTTAMEEDI TANDA (MOMINPET)

Arb : R01-R02

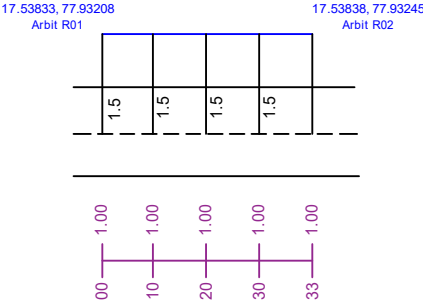


Length : 33 M

Arb : R02-R03

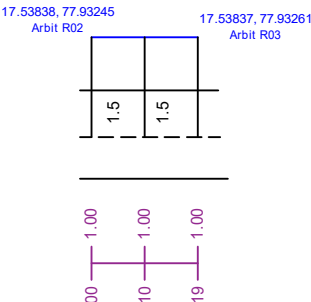


Length : 19 M

Arb : R03-R04

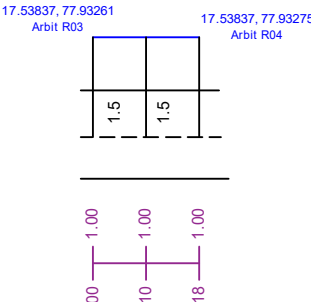


Length : 18 M

Arb : R02-R05

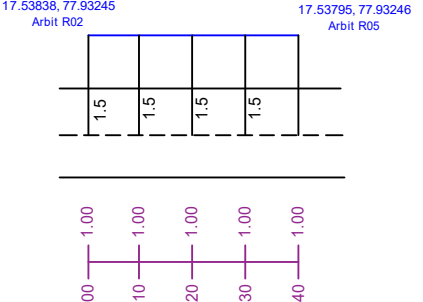


Length : 40 M

Arb : R02-R06

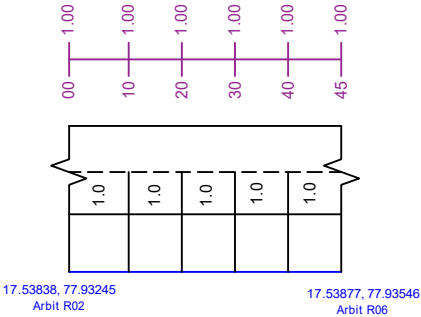


Length : 45 M

Arb : R03-R07

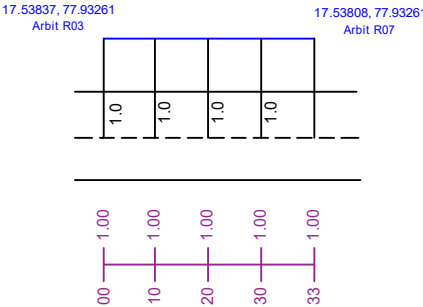


Length : 33 M

Arb : R03-R08

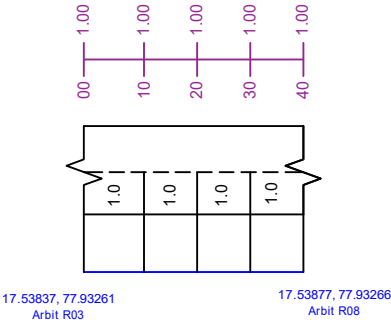

Length : 40 M


Arb : R04-R09

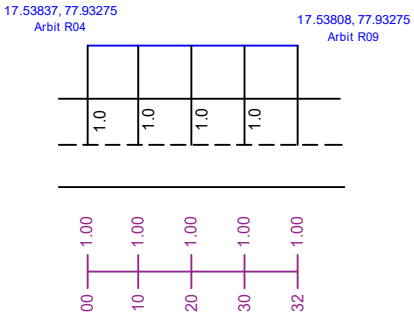

Length : 32 M

Checked	Designation	Signature

ROAD OFFSET DETAILING FOR GUTTAMEEDI TANDA (MOMINPET)

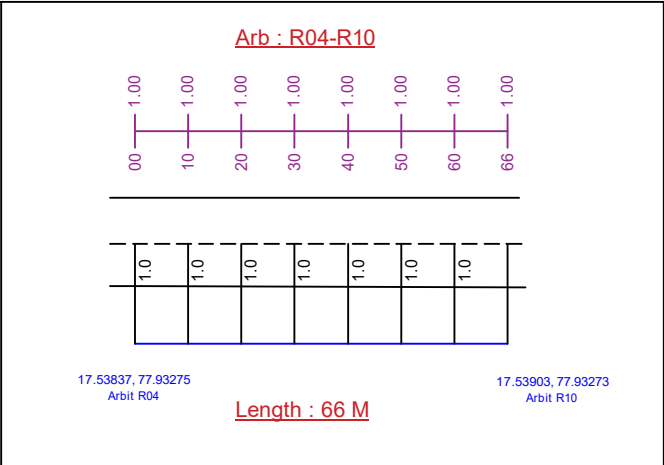

Sheet No. 02
Route Distance : 326 M

Checked	Designation	Signature



TELANGANA FIBER GRID

TELANGANA FIBER GRID

ITE & C GOVERNMENT OF TELANGANA

7th Floor, Splendid Towers, S.P. Road

Opp: Begumpet Police Station,



Begumpet, Hyderabad-500016.


 






AS - BUILT DRAWINGS (ABD)

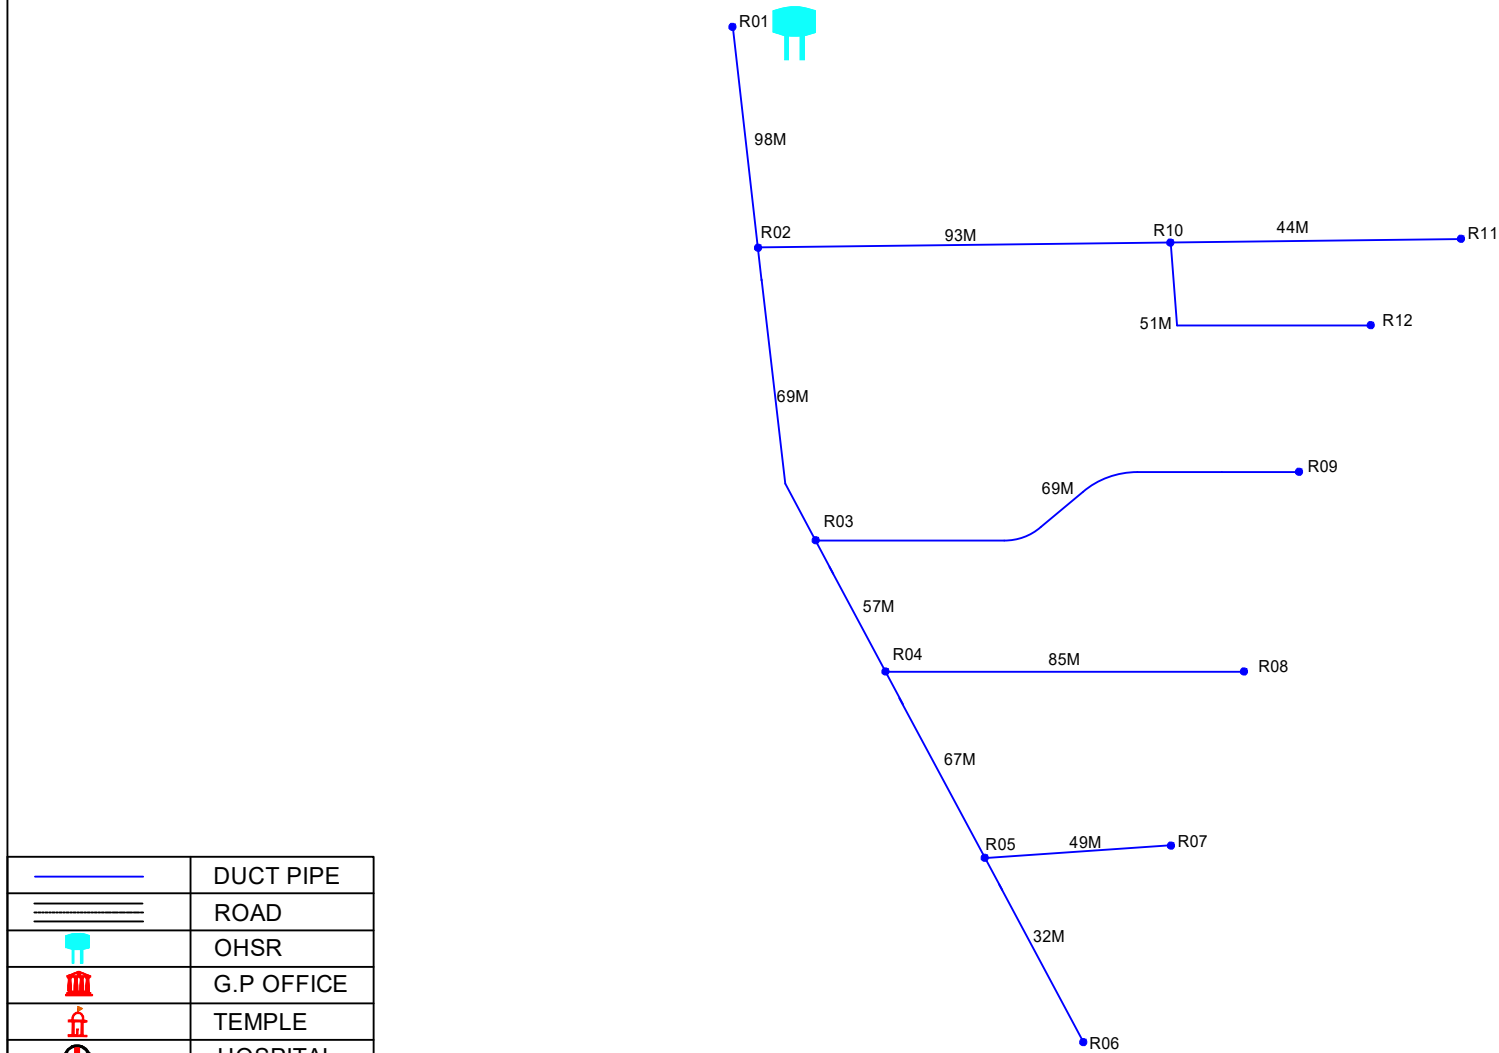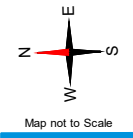KASALABAD TANDA

(MOMINPET MANDAL-VIKARABAD DIST.)

SINGLELINE LOOP DIAGRAM FOR KASALABAD TANDA (MOMINPET)






 






	DUCT PIPE
	ROAD
	OHSR
	G.P OFFICE
	TEMPLE
	HOSPITAL
	SCHOOL
	DUCT GAP

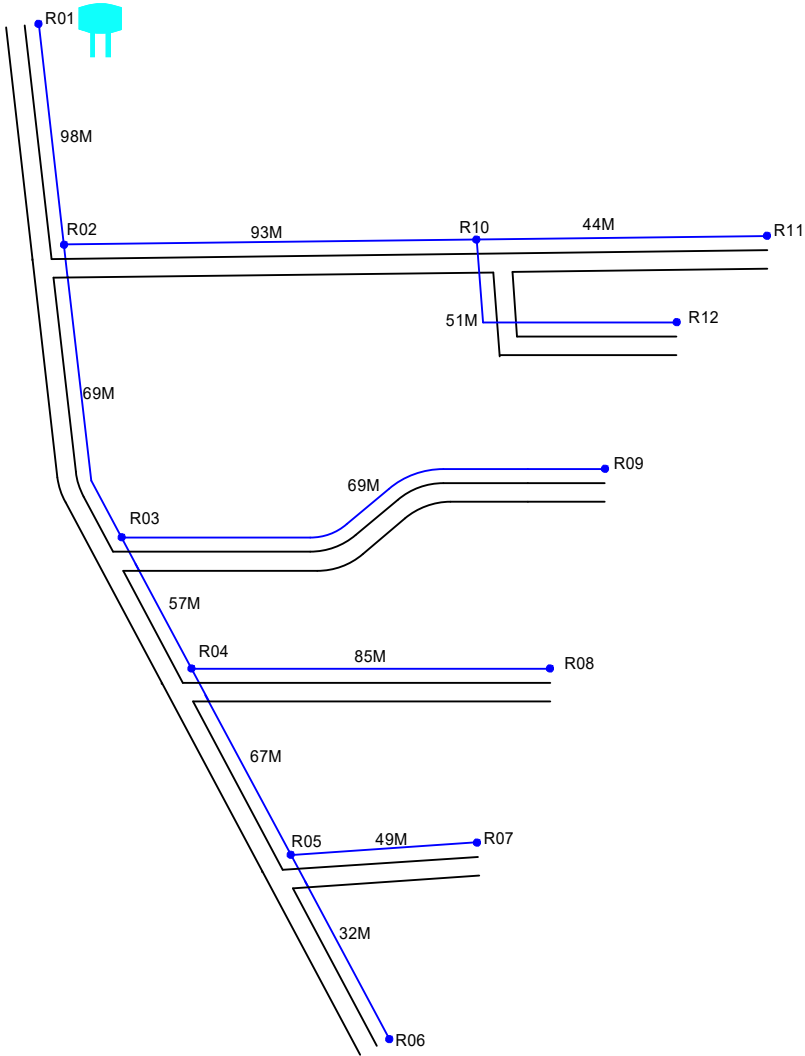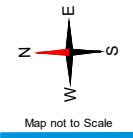Sheet No. 01
Route Distance : 694 M

Checked	Designation	Signature

DUCTLAYING ROUTE DIAGRAM FOR KASALABAD TANDA (MOMINPET)




	DUCT PIPE
	ROAD
	OHSR
	G.P OFFICE
	TEMPLE
	HOSPITAL
	SCHOOL
	DUCT GAP

Sheet No. 01
Route Distance : 694 M


Checked	Designation	Signature

ROAD OFFSET DETAILING FOR KASALABAD TANDA (MOMINPET)


Arb : R01-R02

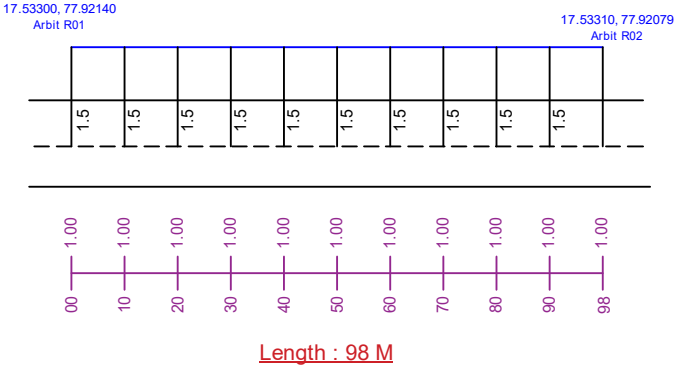


Arb : R02-R03

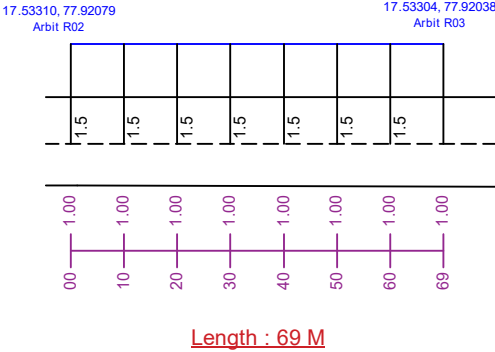


Arb : R03-R04

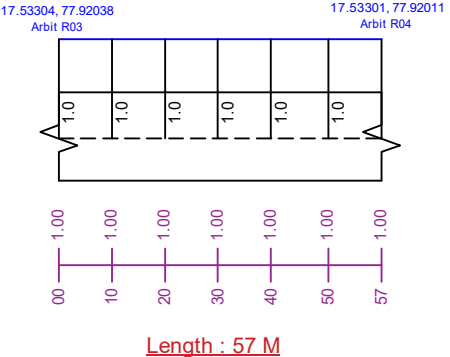


Arb : R04-R05

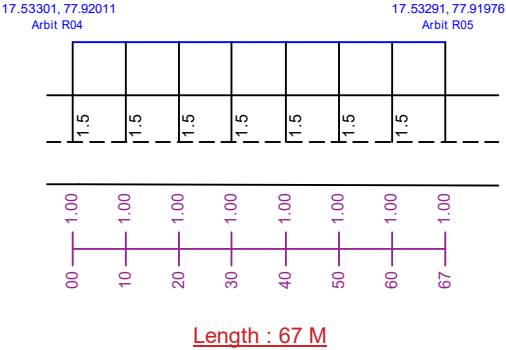

Arb : R05-R06

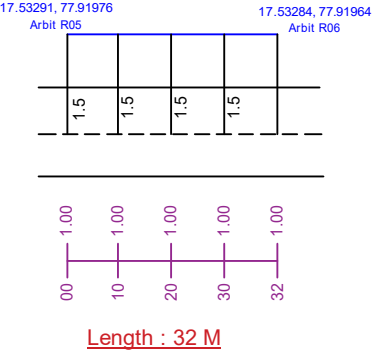


Arb : R05-R07

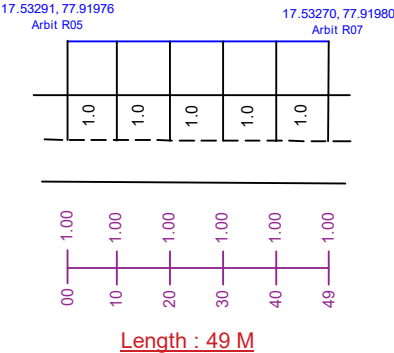


Checked	Designation	Signature

ROAD OFFSET DETAILING FOR KASALABAD TANDA (MOMINPET)


Arb : R04-R08

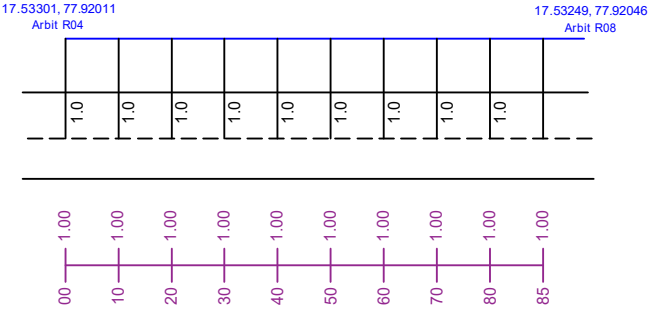


Arb : R03-R09

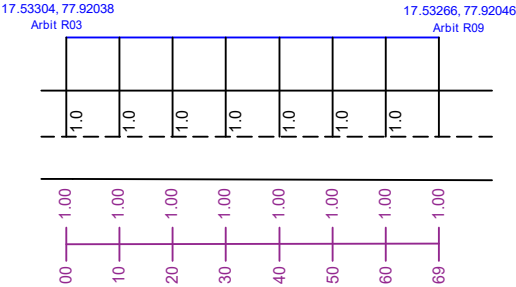


Arb : R02-R10

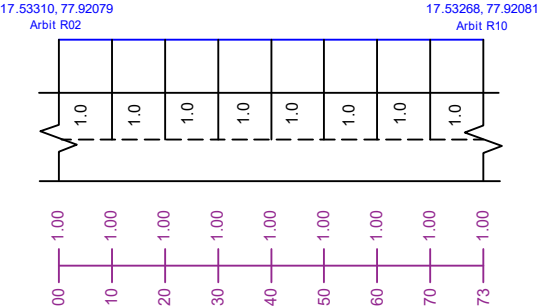

Arb : R10-R11

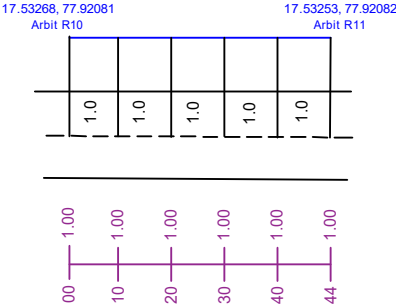

Arb : R10-R12

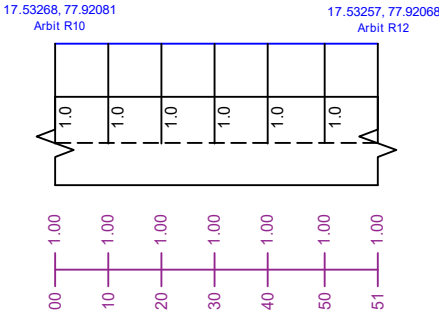

Checked	Designation	Signature



TELANGANA FIBER GRID

TELANGANA FIBER GRID

ITE & C GOVERNMENT OF TELANGANA

7th Floor, Splendid Towers, S.P. Road

Opp: Begumpet Police Station,



Begumpet, Hyderabad-500016.

AS - BUILT DRAWINGS (ABD)

MITYANAİK TANDA

(MOMINPET MANDAL-VIKARABAD DIST.)



SINGLELINE LOOP DIAGRAM FOR MITYANAIAK TANDA (MOMINPET)

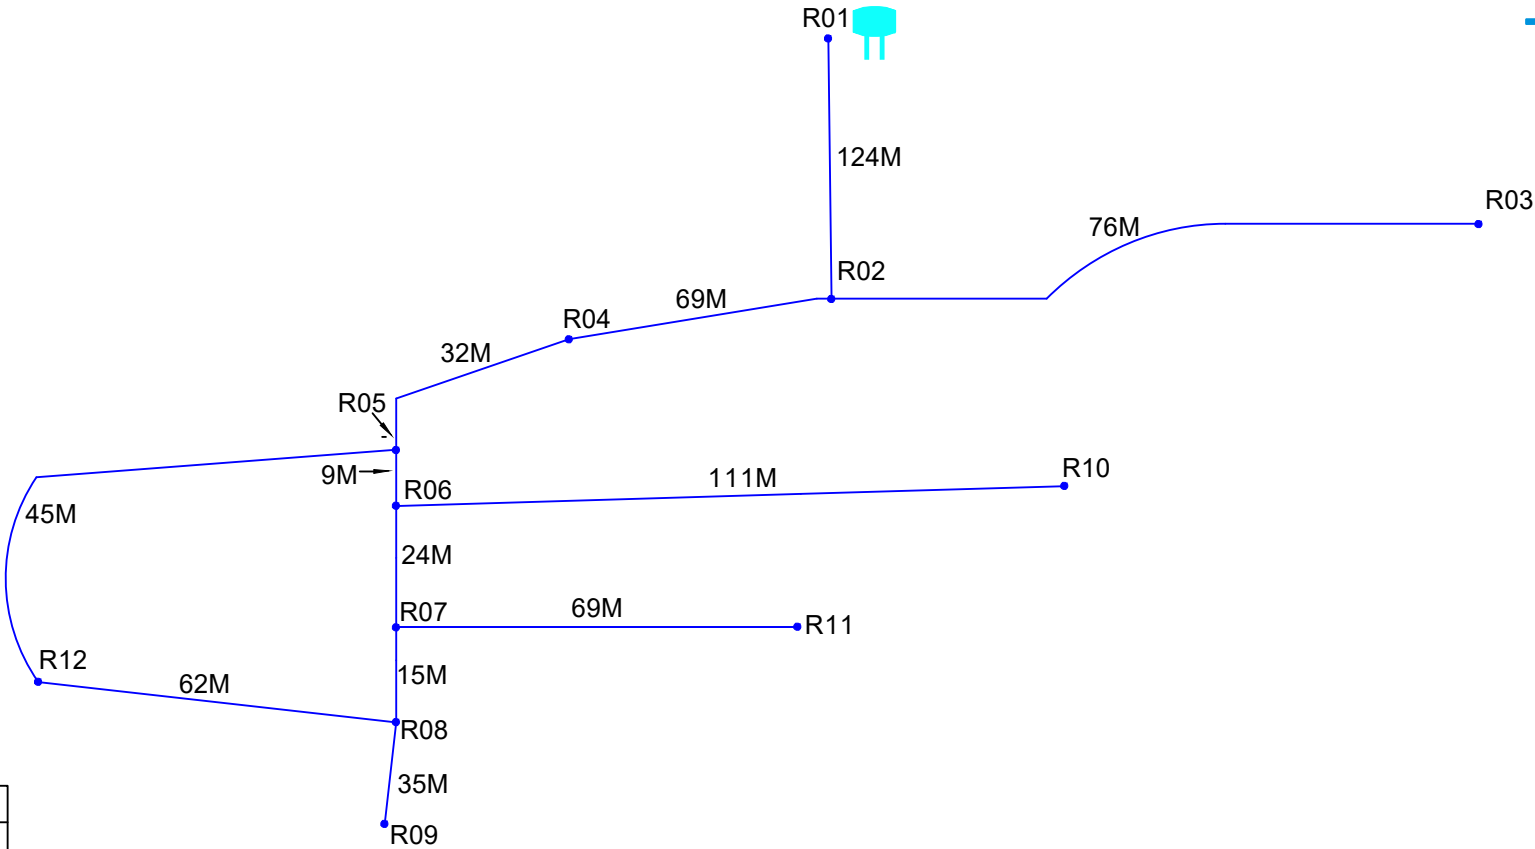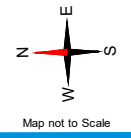
 






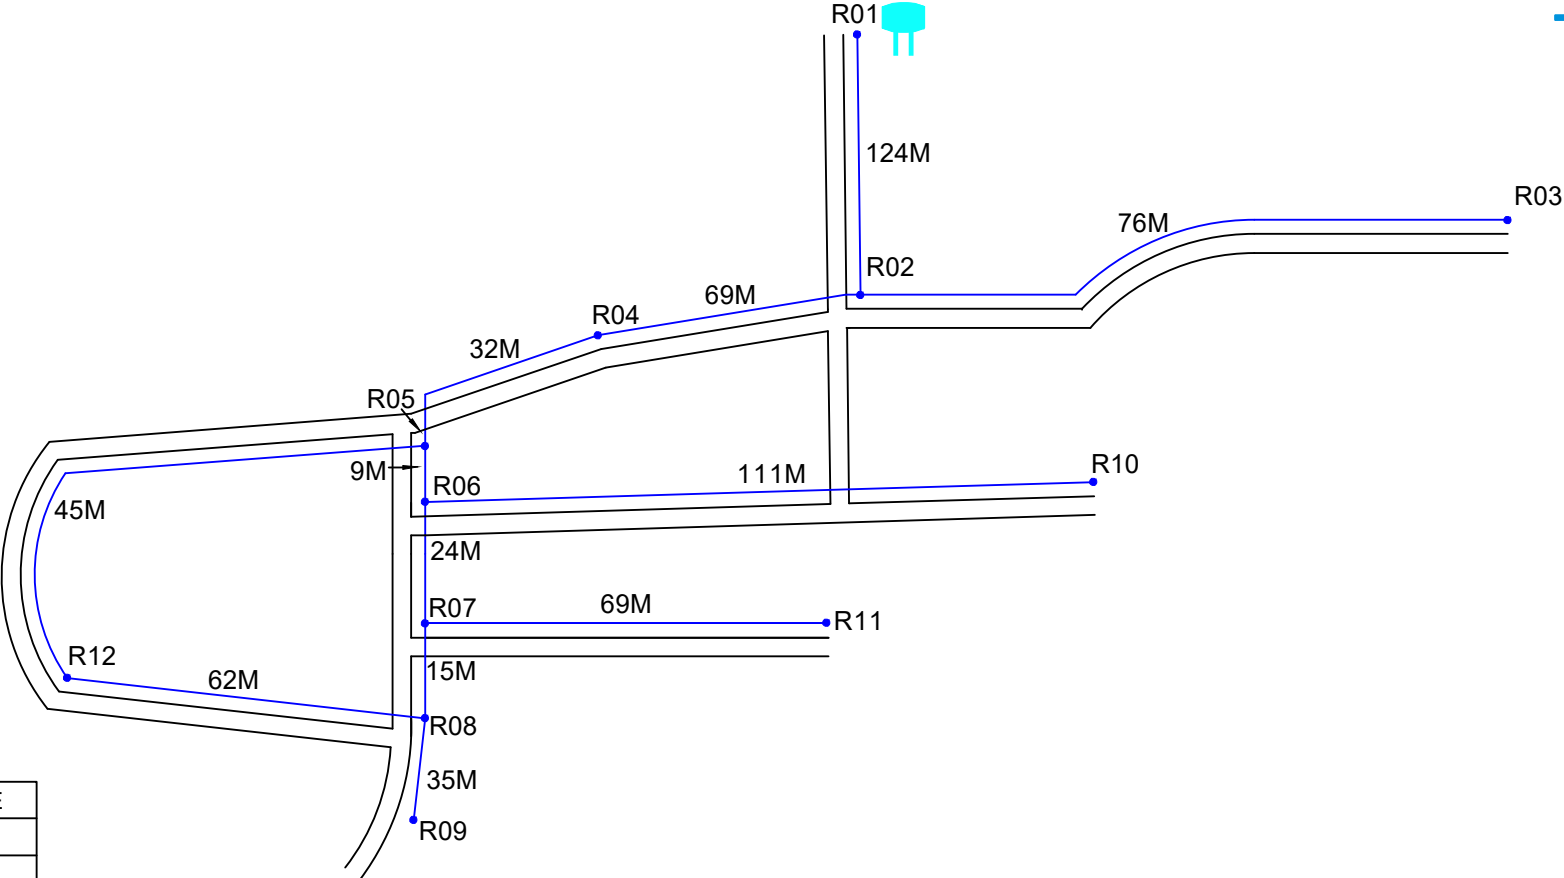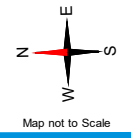

Checked	Designation	Signature

Sheet No. 01
Route Distance : 671 M

DUCTLAYING ROUTE DIAGRAM FOR MITYANAIK TANDA (MOMINPET)



	DUCT PIPE
	ROAD
	OHSR
	G.P OFFICE
	TEMPLE
	HOSPITAL
	SCHOOL
	DUCT GAP

Sheet No. 01
Route Distance : 671 M


Checked	Designation	Signature

ROAD OFFSET DETAILING FOR MITYANAİK TANDA OHSR (MOMINPET)

Arb : R01-R02

17.54805, 77.93577
Arbit R01

17.54813, 77.93471
Arbit R02

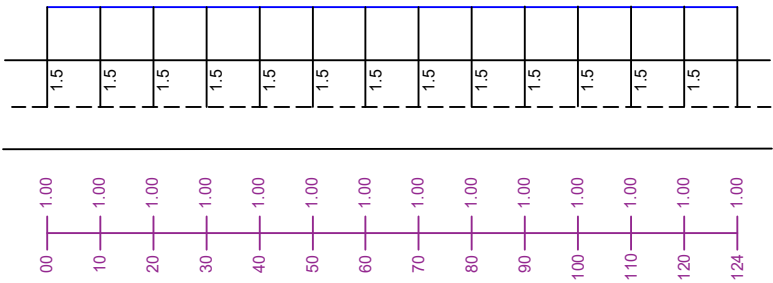


Length : 124 M

Arb : R02-R03

17.54813, 77.93471
Arbit R02

17.54754, 77.93492
Arbit R03

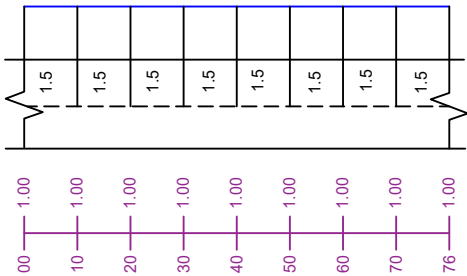


Length : 76 M

Arb : R02-R04

17.54813, 77.93471
Arbit R02

17.54874, 77.93472
Arbit R04

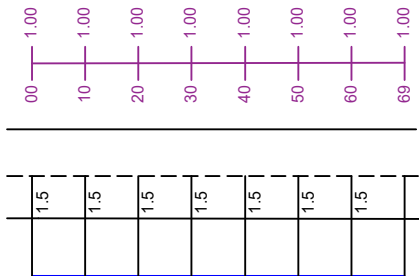


Length : 69 M

Arb : R04-R05

17.54874, 77.93472
Arbit R04

17.54892, 77.93451
Arbit R05

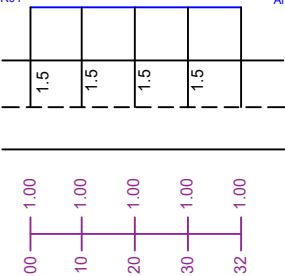


Length : 32 M

Arb : R05-R06

17.54892, 77.93451
Arbit R05

17.54889, 77.93444
Arbit R06





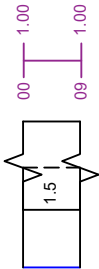


Length : 09 M

Sheet No. 01
Route Distance : 671 M



Checked	Designation	Signature

ROAD OFFSET DETAILING FOR MITYANAIAK TANDA OHSR (MOMINPET)

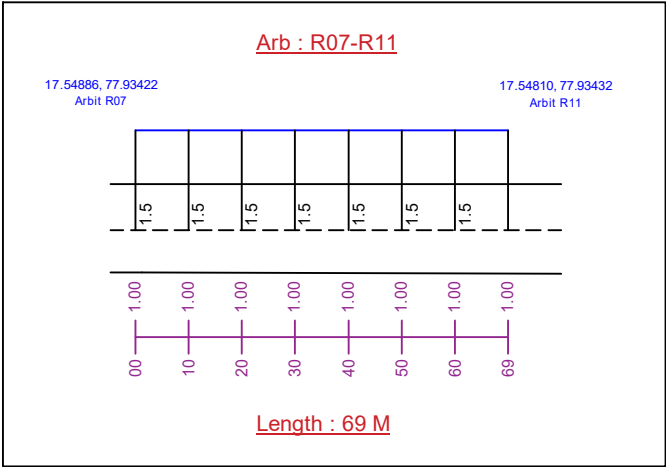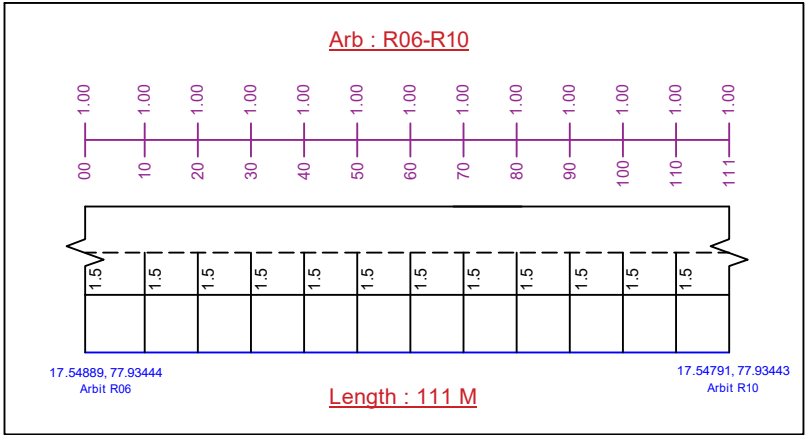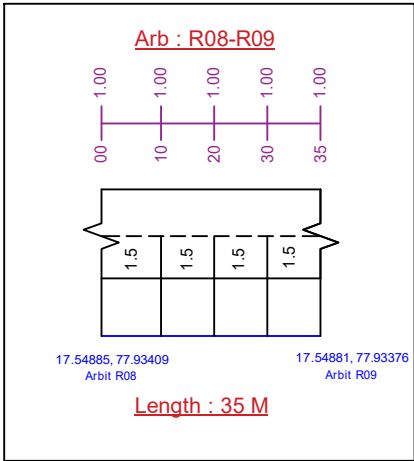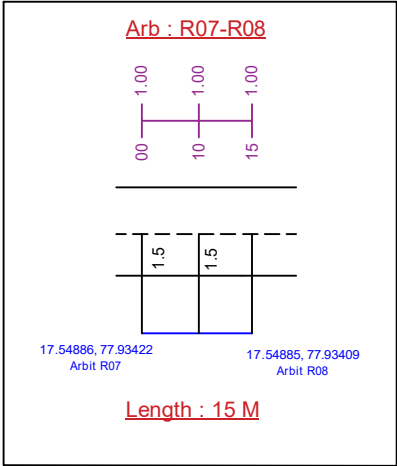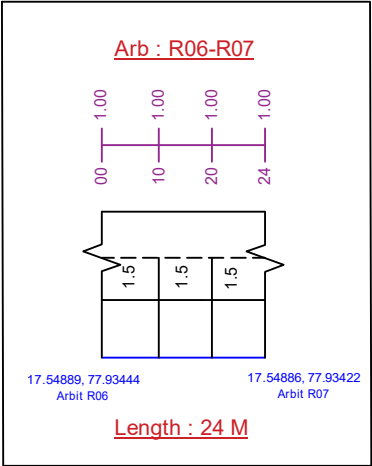

Checked	Designation	Signature

ROAD OFFSET DETAILING FOR MITYANAİK TANDA OHSR (MOMINPET)

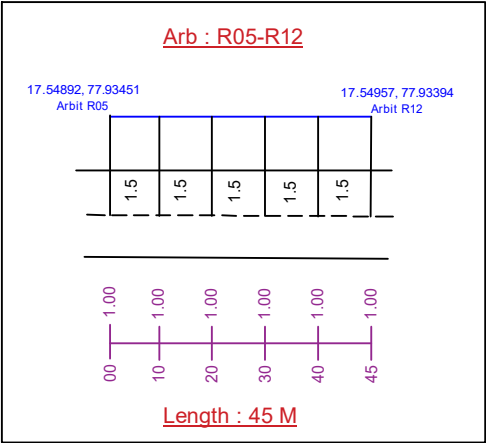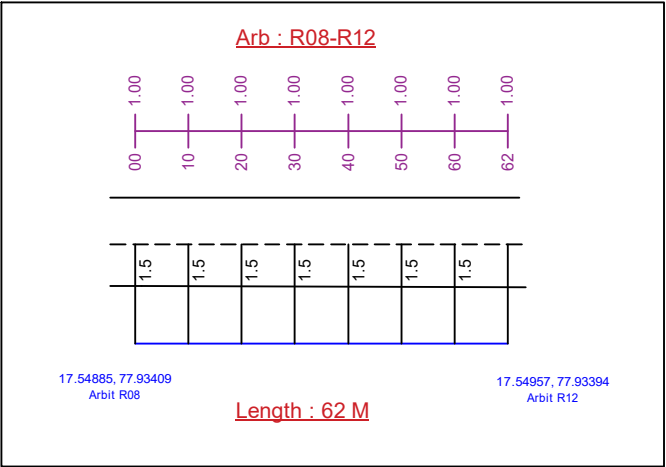

Checked	Designation	Signature



TELANGANA FIBER GRID

TELANGANA FIBER GRID

ITE & C GOVERNMENT OF TELANGANA

7th Floor, Splendid Towers, S.P. Road

Opp: Begumpet Police Station,



Begumpet, Hyderabad-500016.


 






AS - BUILT DRAWINGS (ABD)

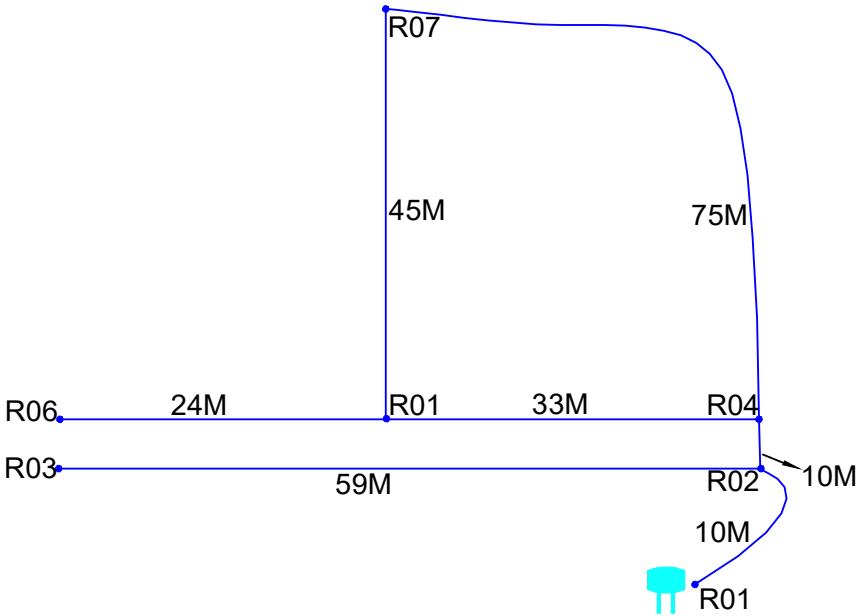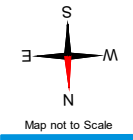YELLAMMAGADDA TANDA

(MOMINPET MANDAL-VIKARABAD DIST.)

SINGLELINE LOOP DIAGRAM FOR YELLAMMAGADDA TANDA (MOMINPET)











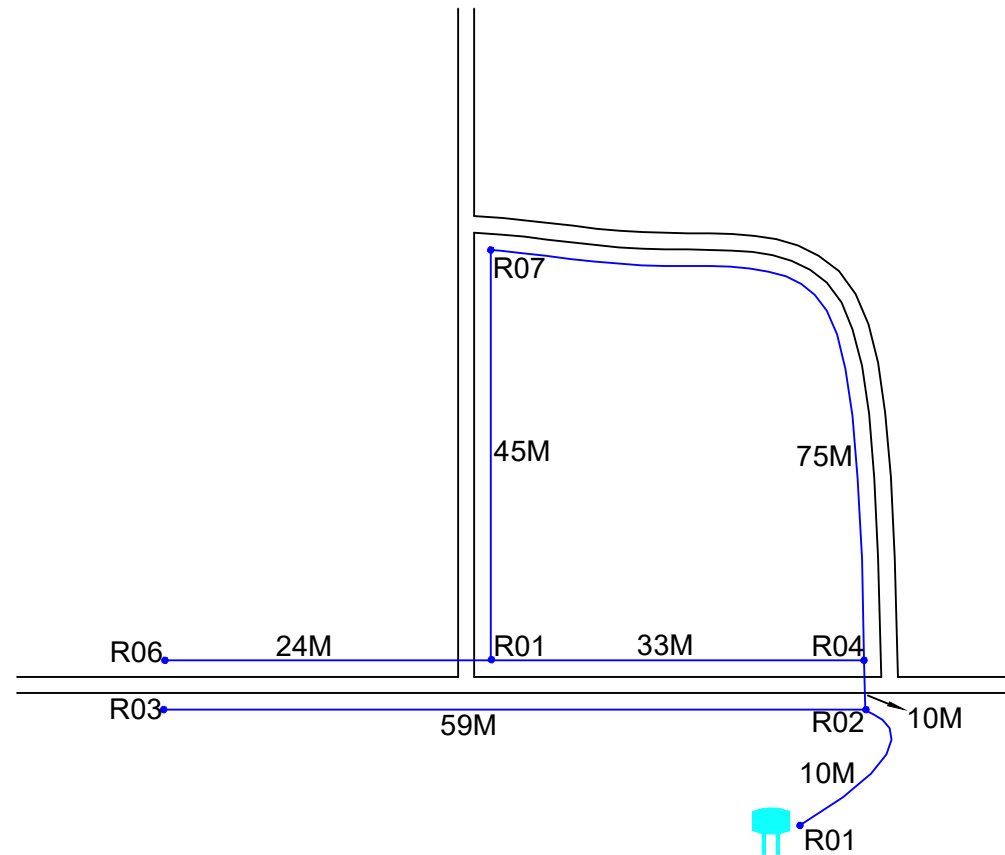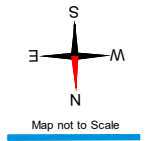

	DUCT PIPE
	ROAD
	OHSR
	G.P OFFICE
	TEMPLE
	HOSPITAL
	SCHOOL
	DUCT GAP

Sheet No. 01
Route Distance : 260 M

Checked	Designation	Signature

DUCTLAYING ROUTE DIAGRAM FOR YELLAMMAGADDA TANDA (MOMINPET)










	DUCT PIPE
	ROAD
	OHSR
	G.P OFFICE
	TEMPLE
	HOSPITAL
	SCHOOL
	DUCT GAP

Sheet No. 01
Route Distance : 260 M

Checked	Designation	Signature

ROAD OFFSET DETAILING FOR YELLAMMAGADDA TANDA (MOMINPET)

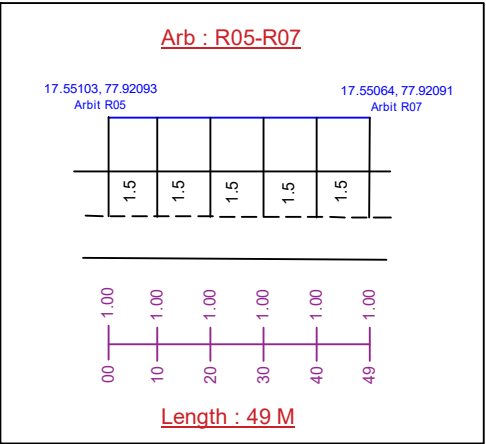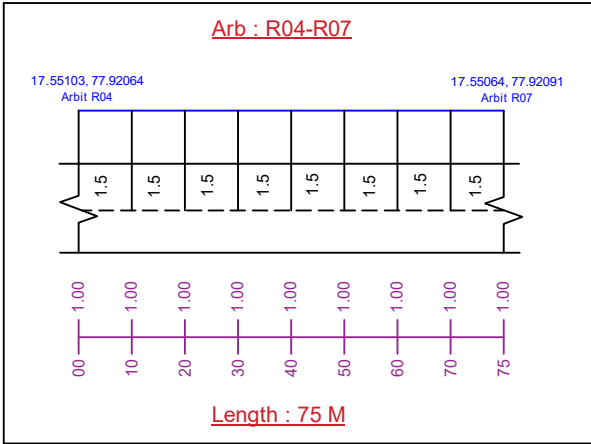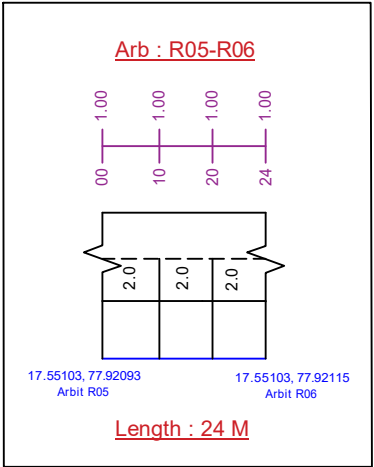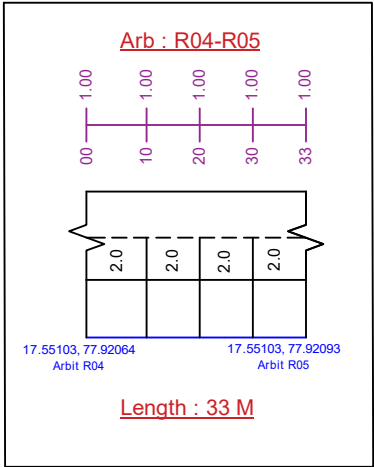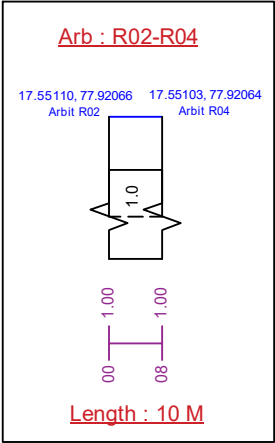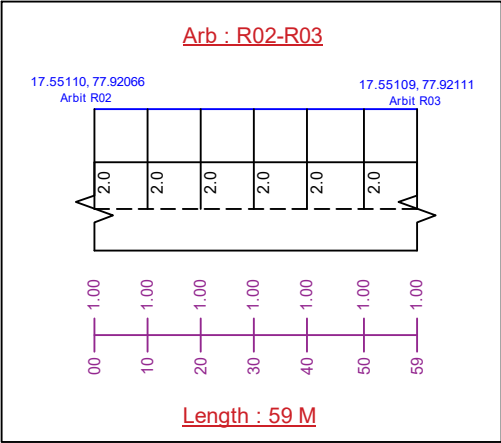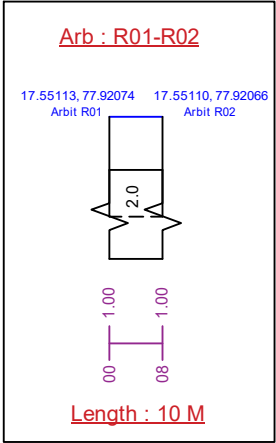

Checked	Designation	Signature