



TFIBER

TELANGANA FIBER GRID

TELANGANA FIBER GRID CORPORATION LIMITED
GOVERNMENT OF TELANGANA

AS BUILT DOCUMENTATION (ABD) FOR PLB HDPE DUCT LAYING – INTRA

District Name : VIKARABAD

Mandal Name : MOMINPET

ABD Agency Name : RAMKRISHY INFRA

MB Agency Name : RAMKRISHY INFRA

ABD Length in Kms : 80.182 Kms

	VIKARABAD DISTRICT		
	MOMINPET MANDAL		
SL.No	Village Name	Books	Meters
1	BALREDDYGUDA	1	2096
2	BURUGUPALLE	1	2887
3	CHAKRAMPALLE	1	6092
4	CHANDRAYANPALLE	1	3261
5	CHEEMALDARI	1	3430
6	DEVARAMPALLE	1	3133
7	DURGAMCHERUVU	1	3261
8	GOVINDHAPUR	1	2310
9	IZRACHITTAMPALLE	1	1657
10	KASALABAD	1	1872
11	KESARAM	1	3488
12	LACHANAIK TANDA	1	839
13	MALLAREDDYGUDA	1	1586
14	MEKAVANAMPALLE	1	5266
15	MOMINPET	1	14577
16	MORANGAPALLE	1	5321
17	NEW KOLKONDA	1	3131
18	RAVULAPALLE	1	1102
19	SOMLANAIK TANDA	1	1059
20	SYEDALIPUR	1	1637
21	TEKULAPALLE	1	6027
22	VELCHAL	1	3519
23	YENKEPALLE	1	2631
	Total		80182



TELANGANA FIBER GRID

TELANGANA FIBER GRID

ITE & C GOVERNMENT OF TELANGANA

7th Floor, Splendid Towers, S.P. Road

Opp: Begumpet Police Station,



Begumpet, Hyderabad-500016.

AS - BUILT DRAWINGS (ABD)

BALREDDYGUDA

(MOMINPET MANDAL-VIKARABAD DIST.)

SINGLELINE LOOP DIAGRAM FOR BALREDDYGUDA (MOMINPET)

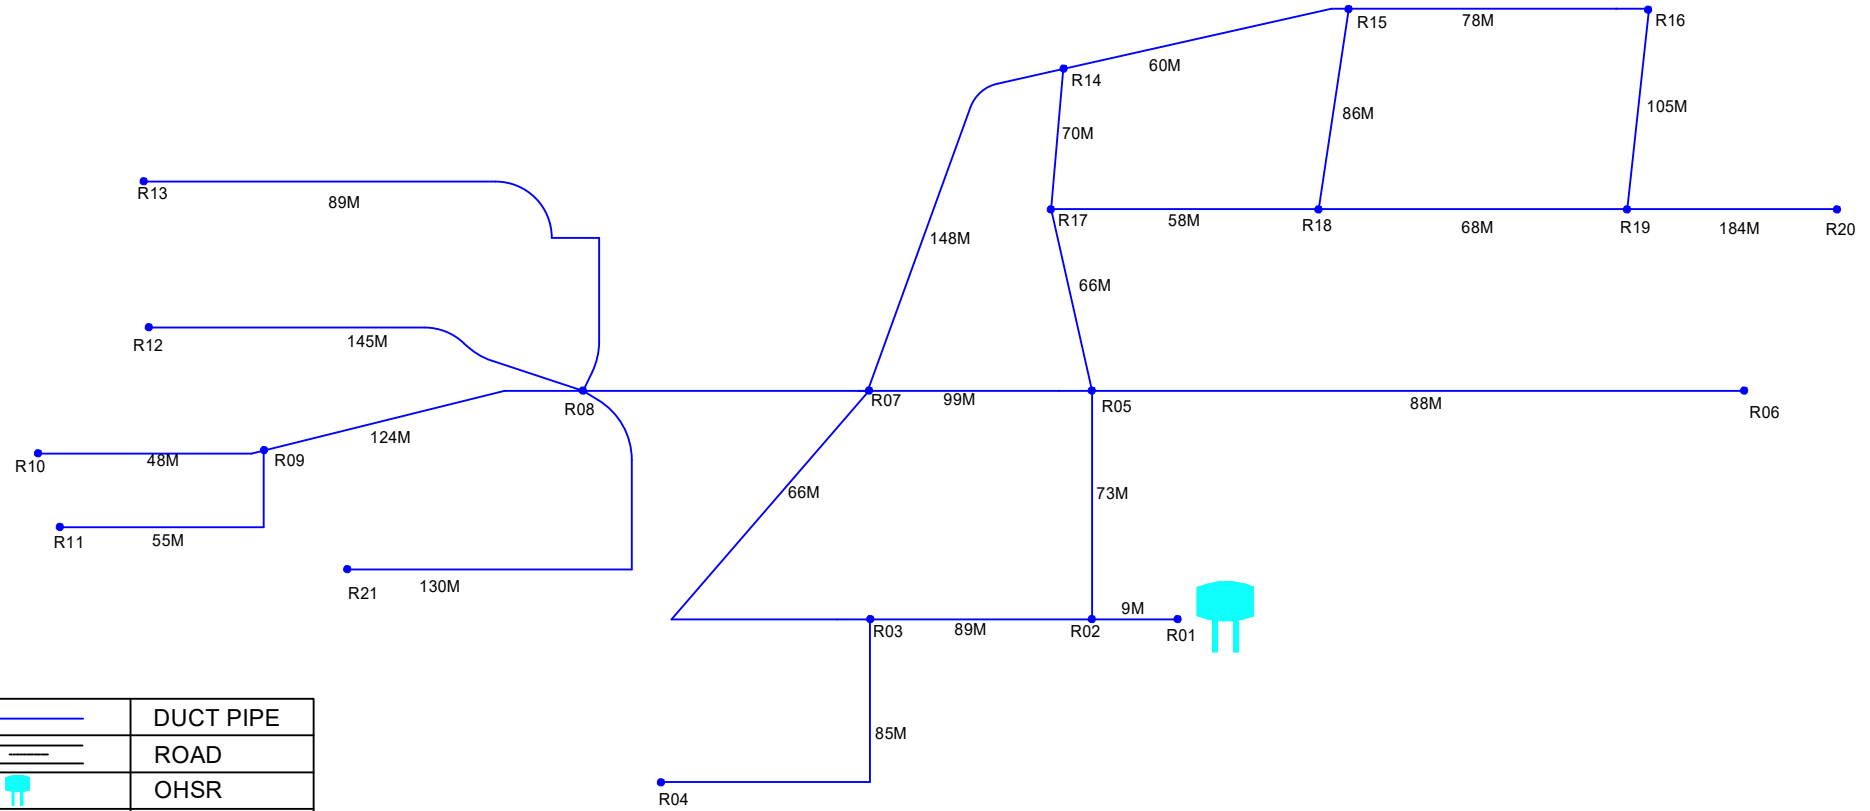
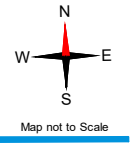


	DUCT PIPE
	ROAD
	OHSR
	G.P OFFICE
	TEMPLE
	HOSPITAL
	SCHOOL
	DUCT GAP

Sheet No. 01
Route Distance : 2096 M

Checked	Designation	Signature

DUCTLAYING LINE CHAIN DIAGRAM FOR BALREDDYGUDA (MOMINPET)

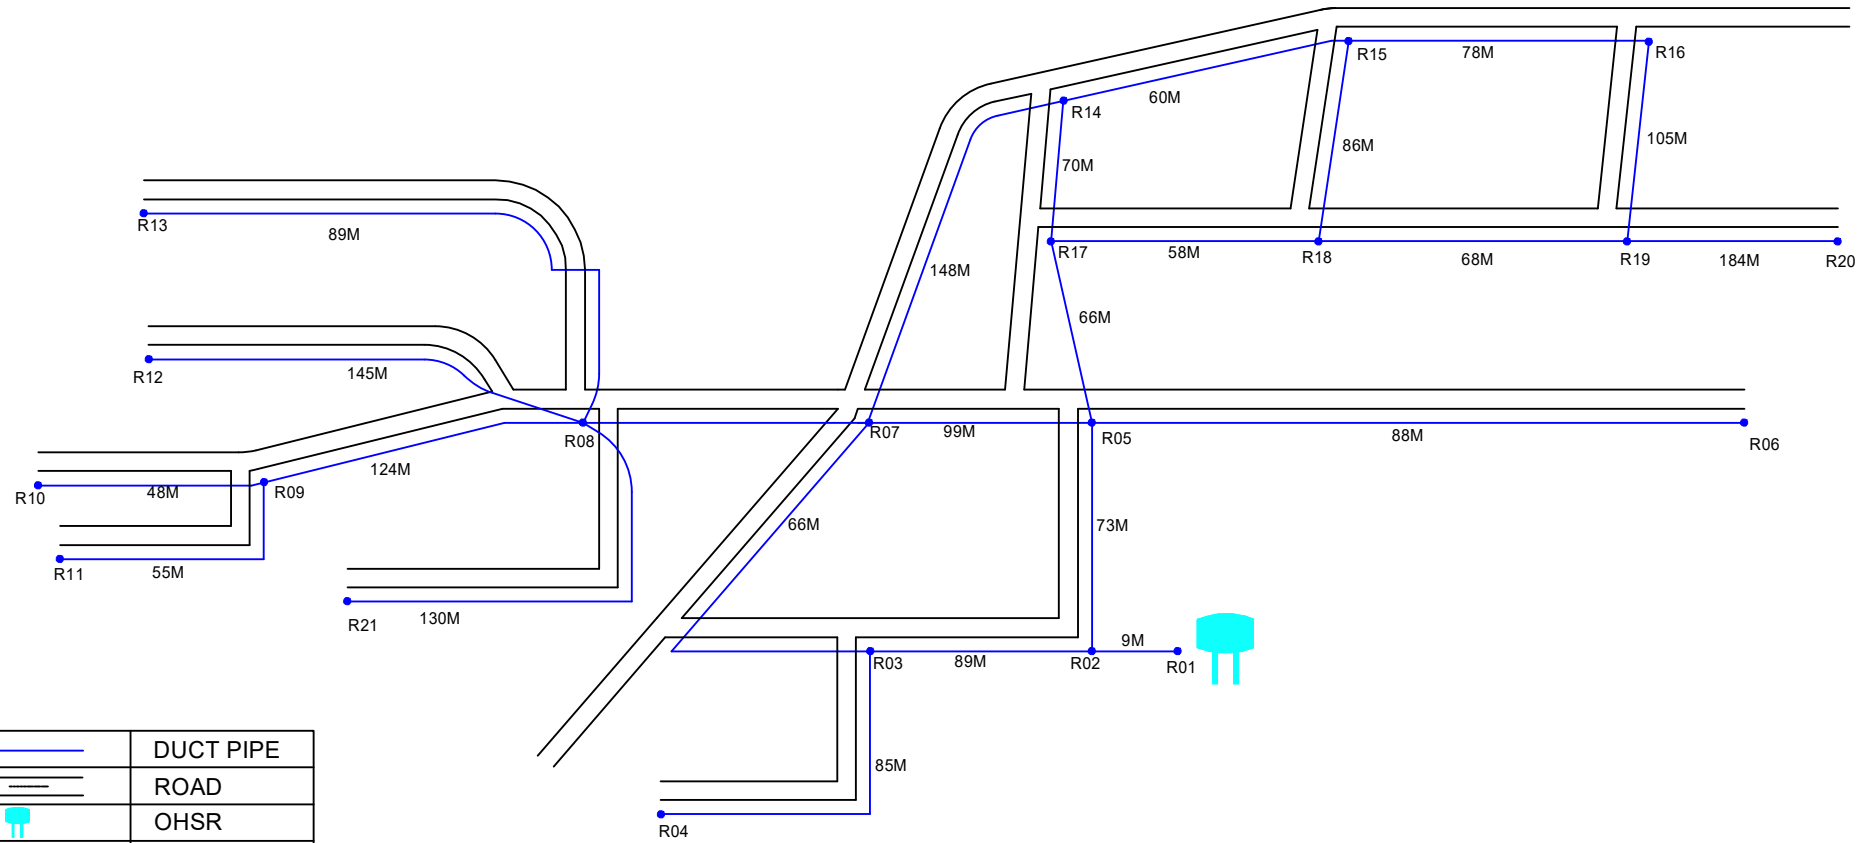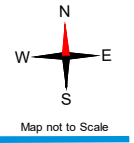


	DUCT PIPE
	ROAD
	OHSR
	G.P OFFICE
	TEMPLE
	HOSPITAL
	SCHOOL
	DUCT GAP

Sheet No. 01
Route Distance : 2096 M


Checked	Designation	Signature

ROAD OFFSET DETAILING FOR BALREDDYGUDA (MOMINPET)


Arb : R01-R02

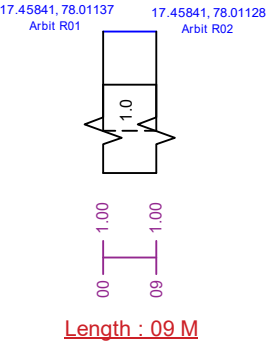


Arb : R02-R03

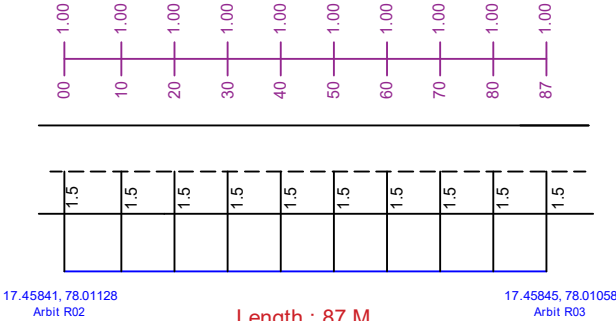


Arb : R03-R04

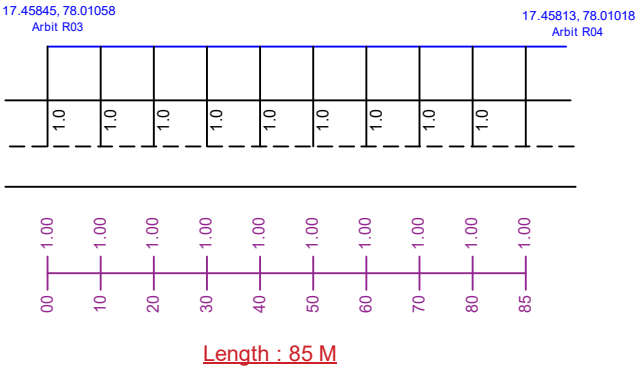

Arb : R02-R05

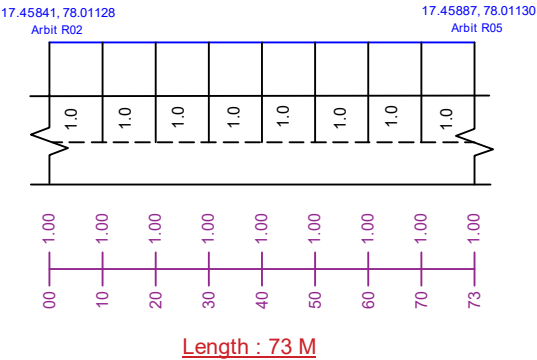


Arb : R05-R06

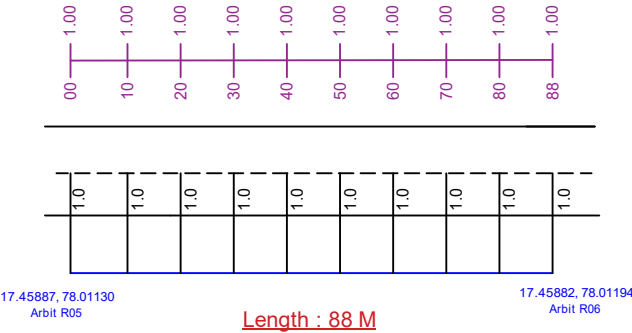


Checked	Designation	Signature

ROAD OFFSET DETAILING FOR BALREDDYGUDA (MOMINPET)


Arb : R05-R07

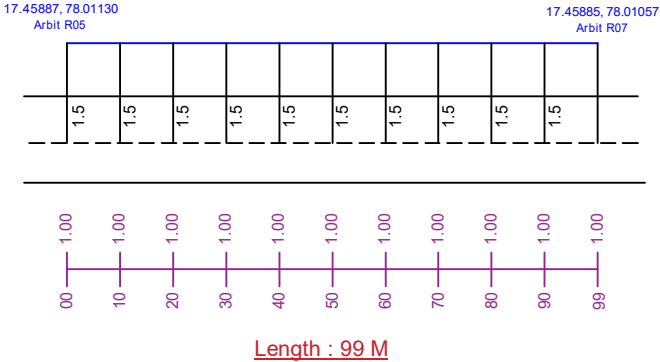


Arb : R03-R07

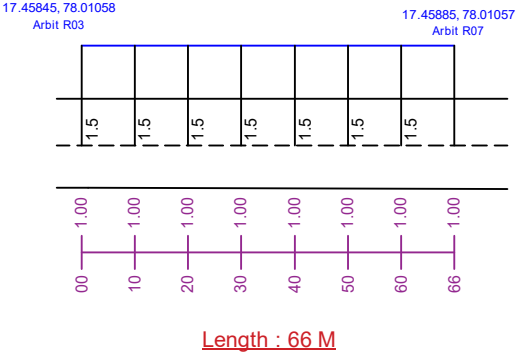

Arb : R07-R08

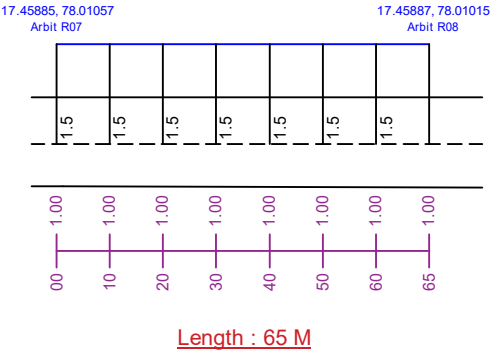


Arb : R08-R09

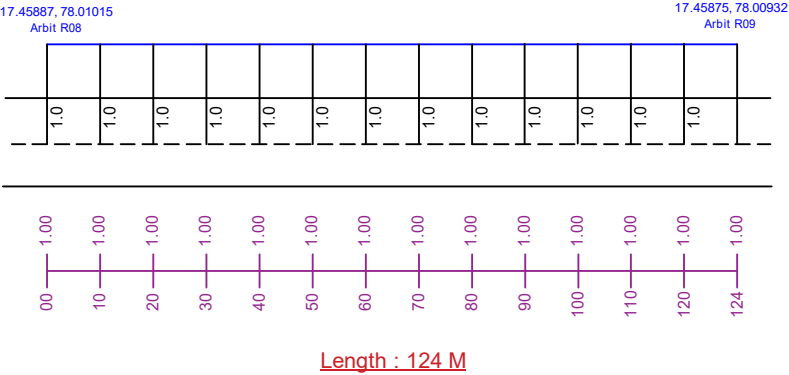

Checked	Designation	Signature


ROAD OFFSET DETAILING FOR BALREDDYGUDA (MOMINPET)

Arb : R09-R10

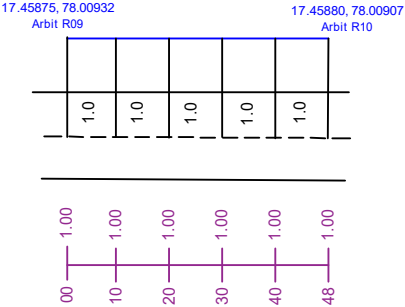


Length : 48 M

Arb : R09-R11

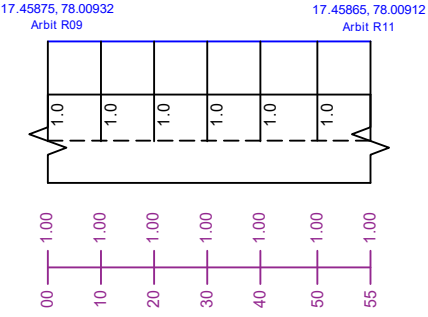


Length : 55 M

Arb : R08-R12

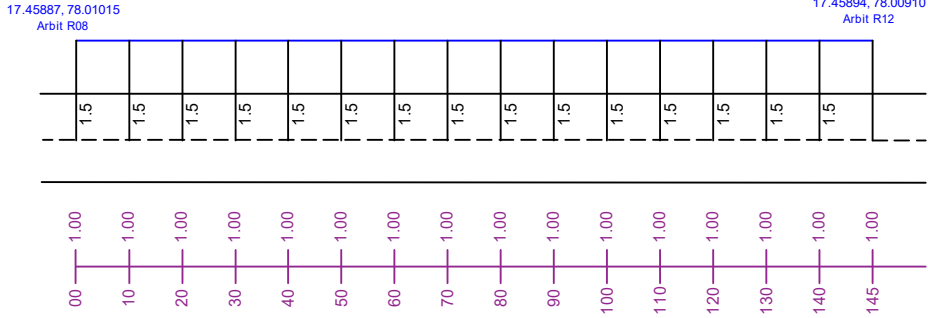

Length : 145 M

Arb : R08-R12

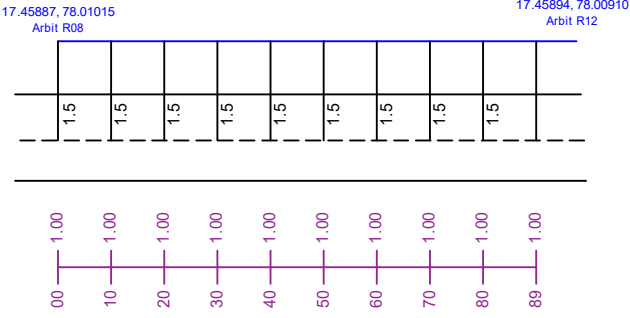


Length : 89 M

Checked	Designation	Signature


ROAD OFFSET DETAILING FOR BALREDDYGUDA (MOMINPET)

Arb : R08-R21

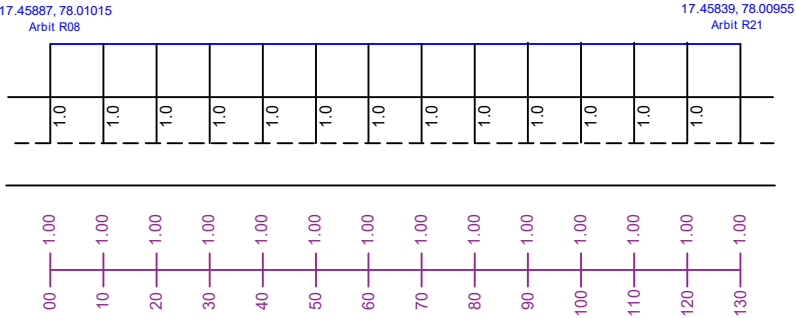


Length : 130 M

Arb : R07-R14

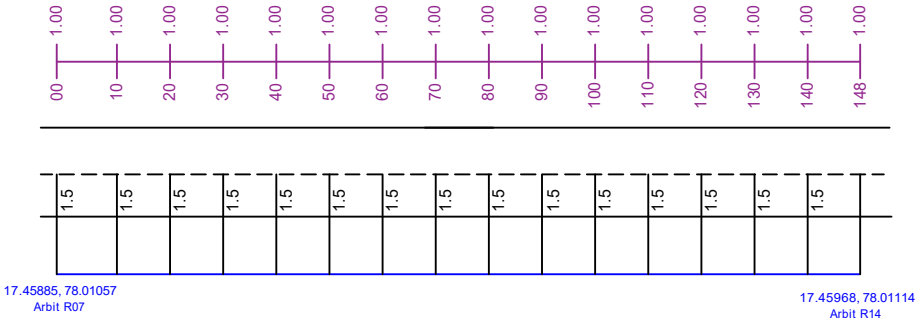


Length : 148 M

Arb : R14-R15

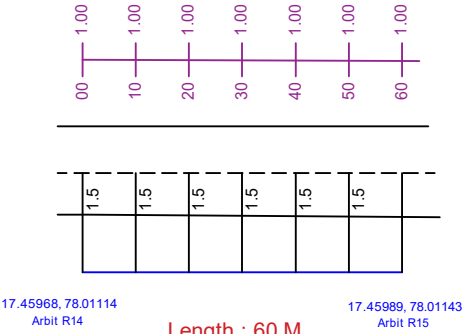

Length : 60 M






Arb : R15-R16

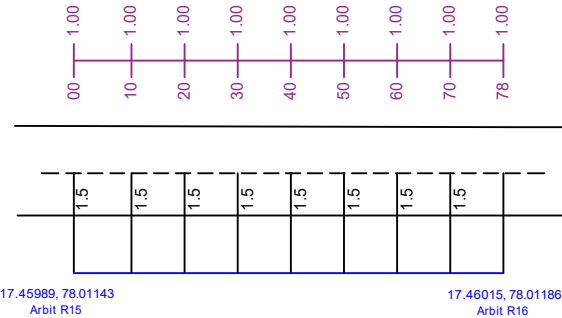

Length : 78 M

Checked	Designation	Signature

ROAD OFFSET DETAILING FOR BALREDDYGUDA (MOMINPET)

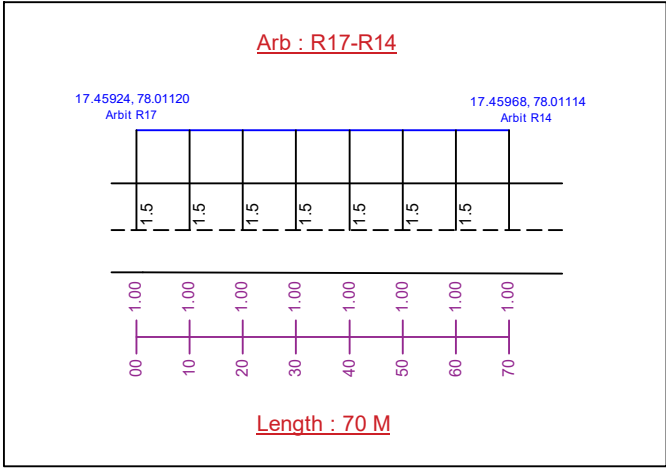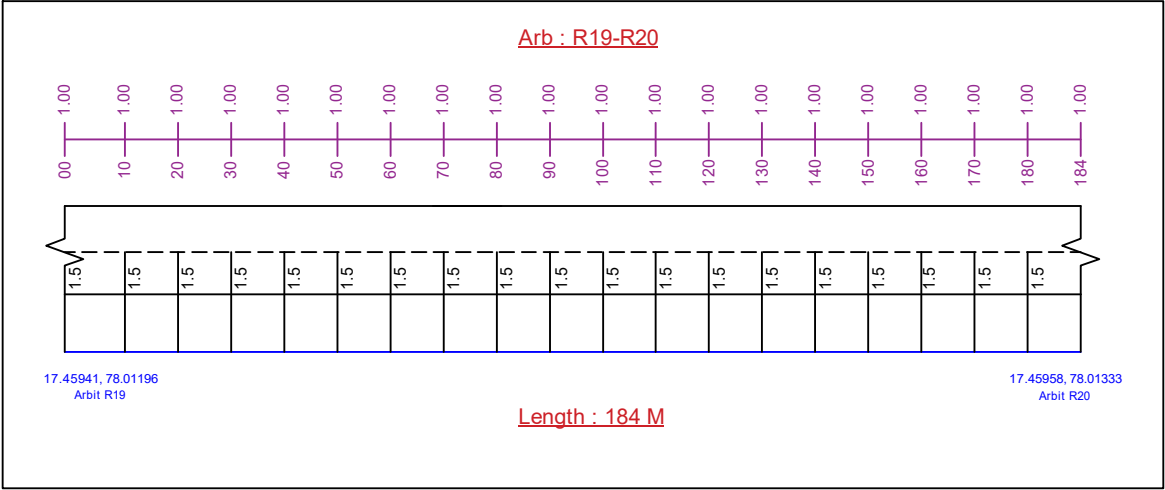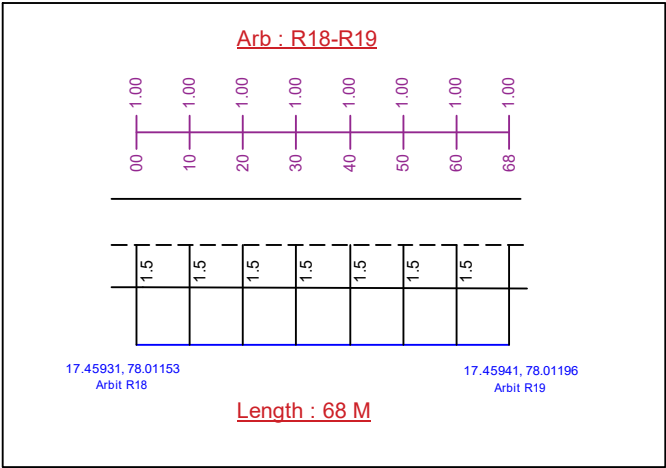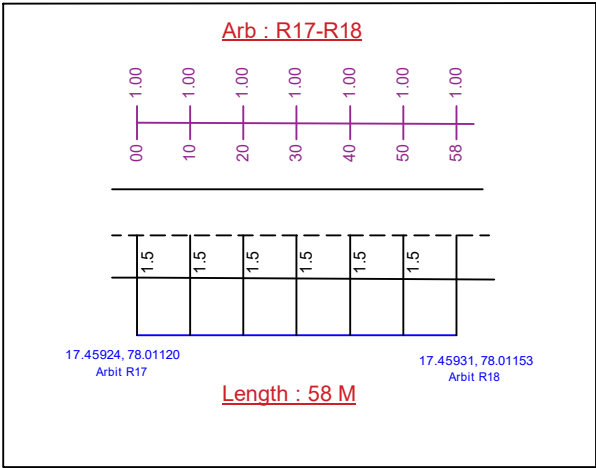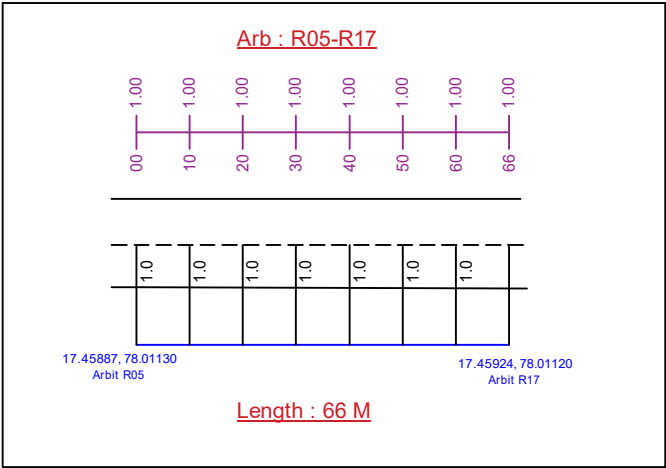



Checked	Designation	Signature

ROAD OFFSET DETAILING FOR BALREDDYGUDA (MOMINPET)

Arb : R18-R15

17.45931, 78.01153
Arbit R18

17.45989, 78.01143
Arbit R15

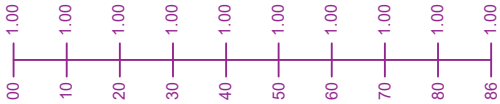
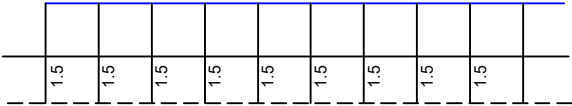


Length : 86 M

Arb : R19-R16

17.45941, 78.01196
Arbit R19

17.46015, 78.01186
Arbit R16

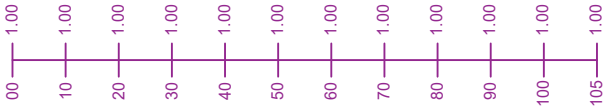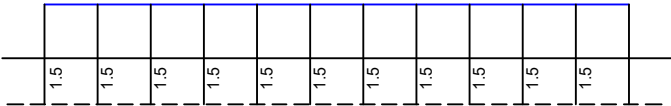

Length : 105 M

Sheet No. 06
Route Distance : 2096M

Checked	Designation	Signature



TELANGANA FIBER GRID

TELANGANA FIBER GRID

ITE & C GOVERNMENT OF TELANGANA

7th Floor, Splendid Towers, S.P. Road

Opp: Begumpet Police Station,



Begumpet, Hyderabad-500016.


 






AS - BUILT DRAWINGS (ABD)

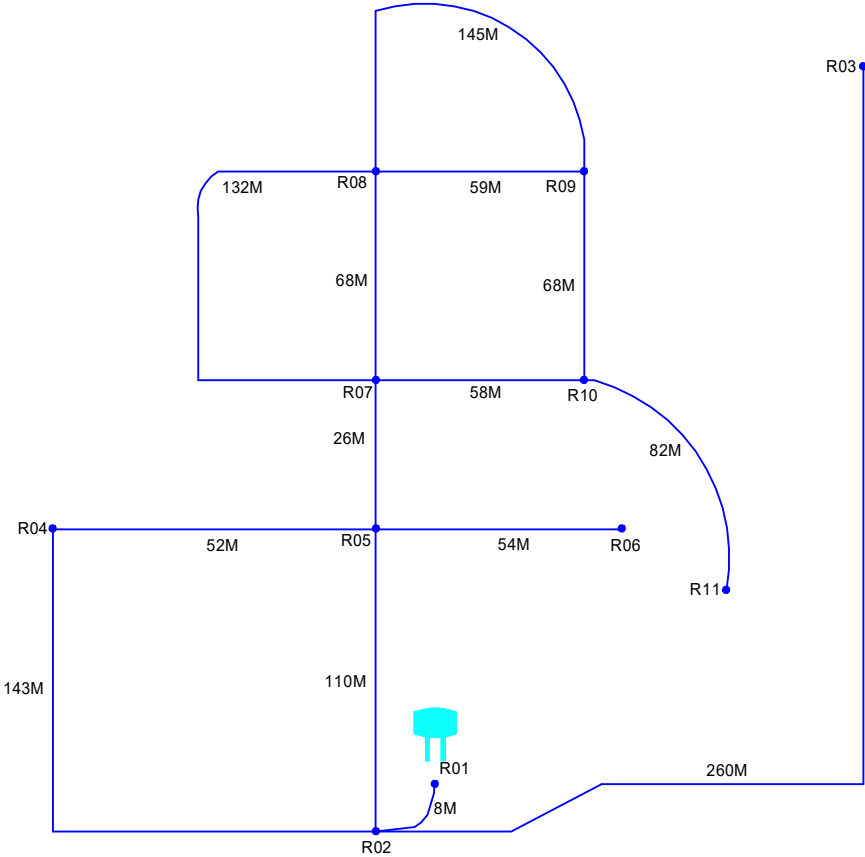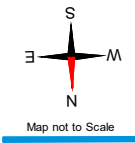BURUGUPALLE

(MOMINPET MANDAL-VIKARABAD DIST.)

SINGLELINE LOOP DIAGRAM FOR BURUGUPALLE OHSR1 (MOMINPET)






 






	DUCT PIPE
	ROAD
	OHSR
	G.P OFFICE
	TEMPLE
	HOSPITAL
	SCHOOL
	DUCT GAP

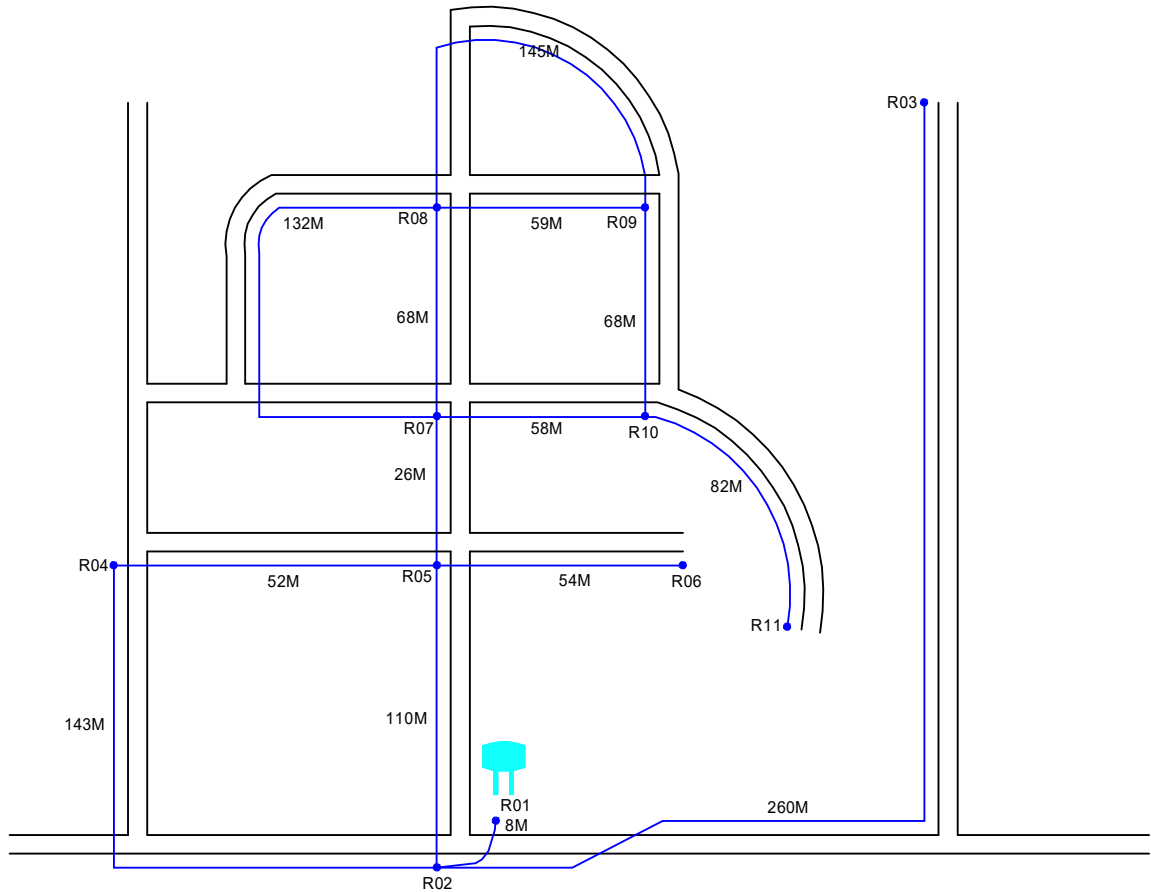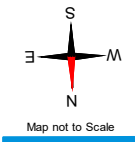Sheet No. 01
Route Distance : 2887 M

Checked	Designation	Signature

DUCTLAYING ROUTE DIAGRAM FOR BURUGUPALLE OHSR1 (MOMINPET)




	DUCT PIPE
	ROAD
	OHSR
	G.P OFFICE
	TEMPLE
	HOSPITAL
	SCHOOL
	DUCT GAP

Sheet No. 01
Route Distance : 2887 M

Checked	Designation	Signature


ROAD OFFSET DETAILING FOR BURUGUPALLE OHSR1 (MOMINPET)

Arb : R01-R02

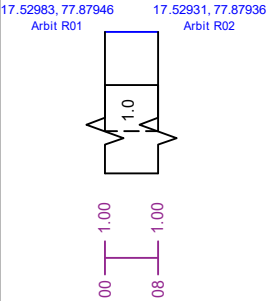


Length : 08 M

Arb : R02-R03

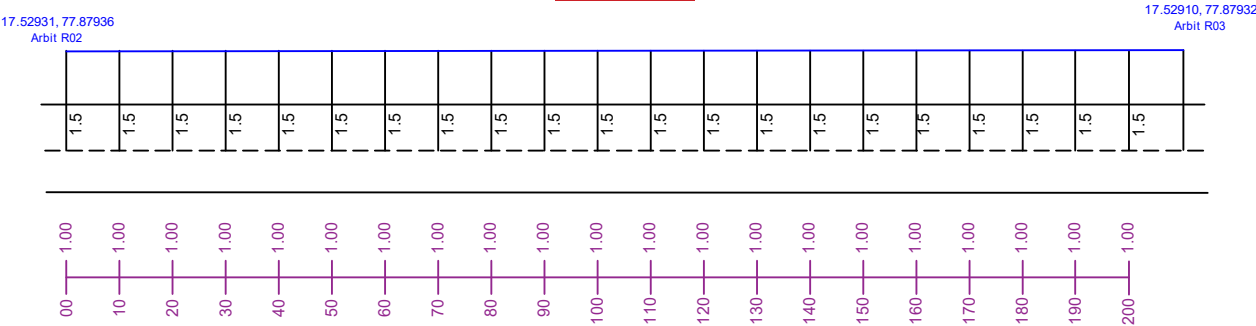


Length : 260 M

Arb : R02-R03

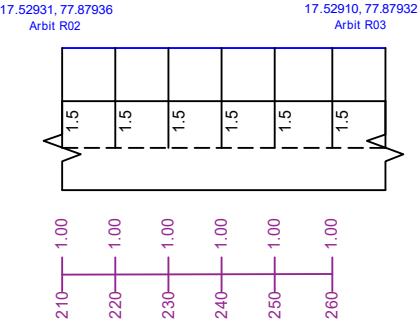

Length : 260 M







Arb : R02-R04

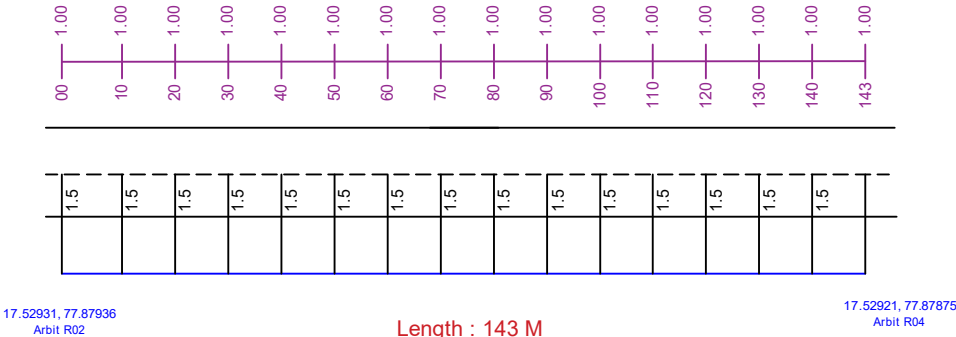

Length : 143 M



Checked	Designation	Signature

ROAD OFFSET DETAILING FOR BURUGUPALLE OHSR1 (MOMINPET)

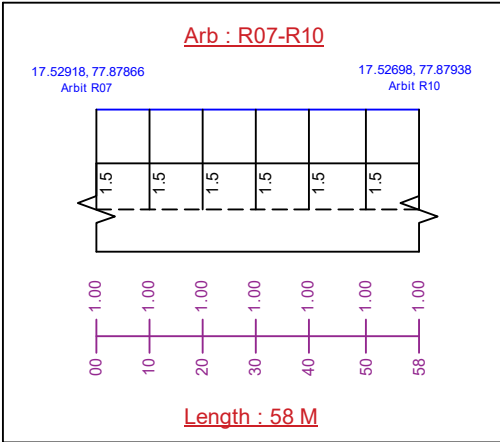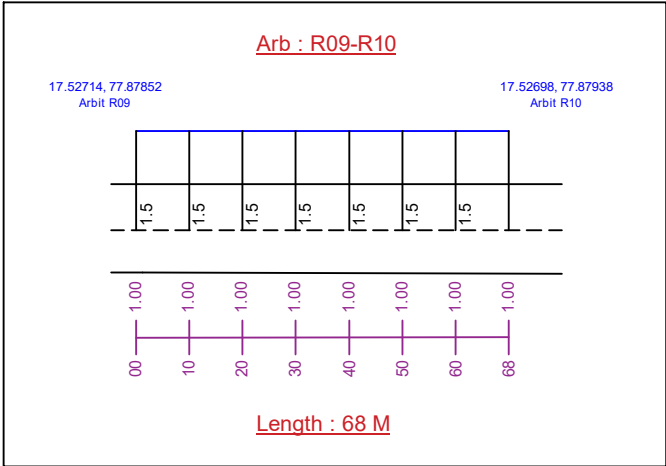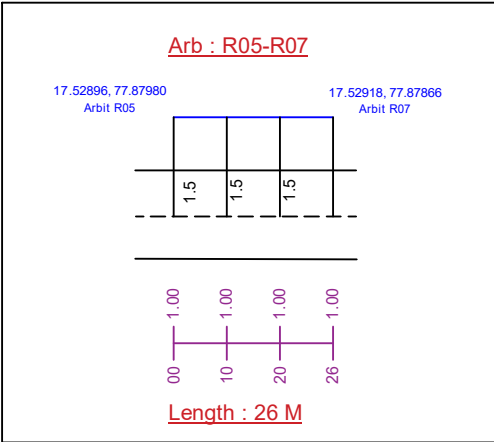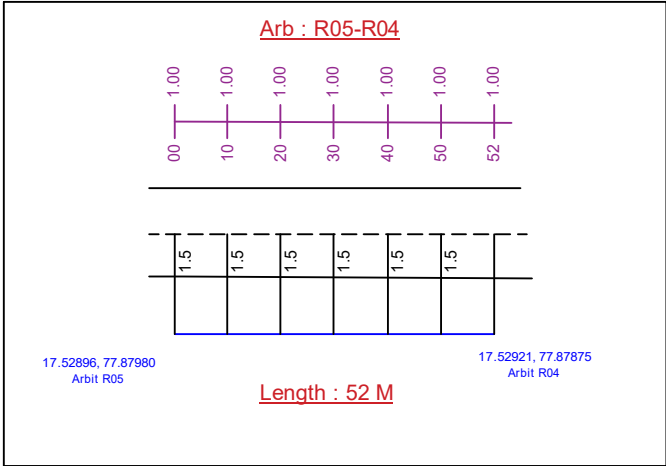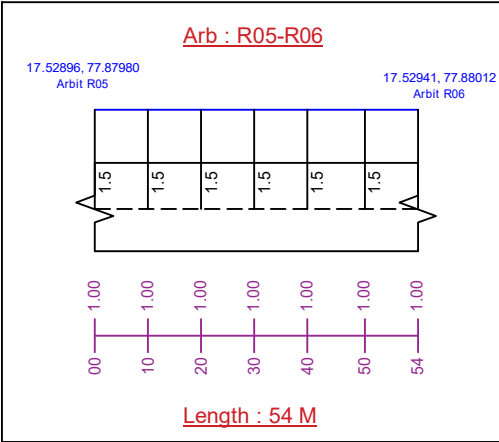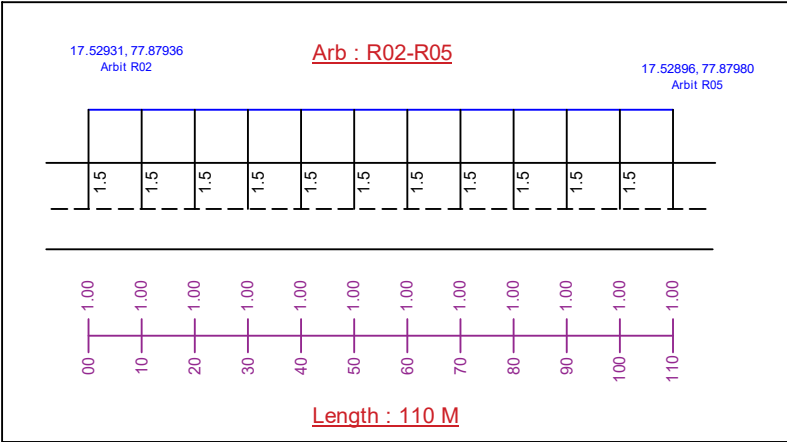



Checked	Designation	Signature


 


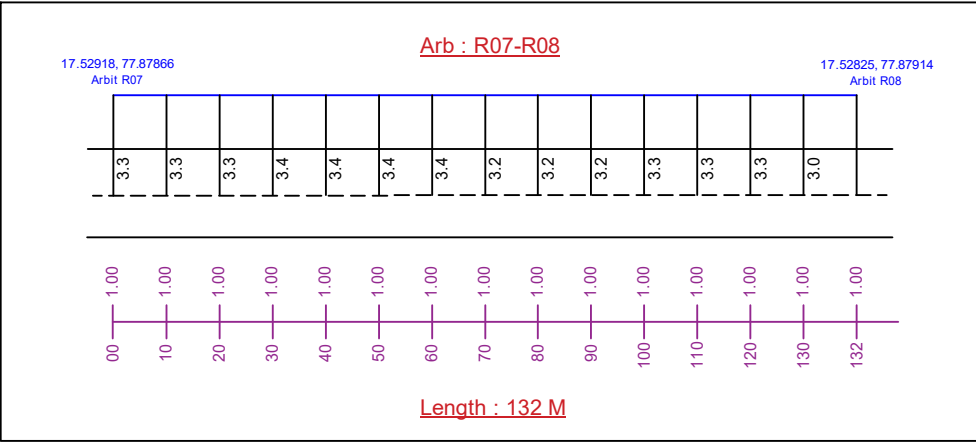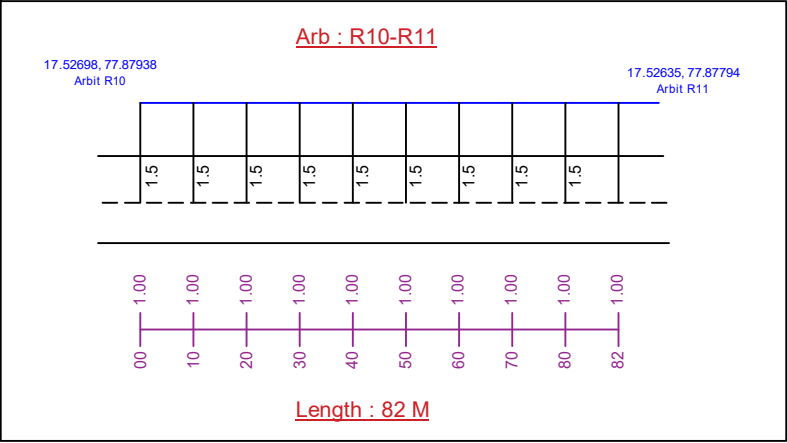



ROAD OFFSET DETAILING FOR BURUGUPALLE OHSR1 (MOMINPET)

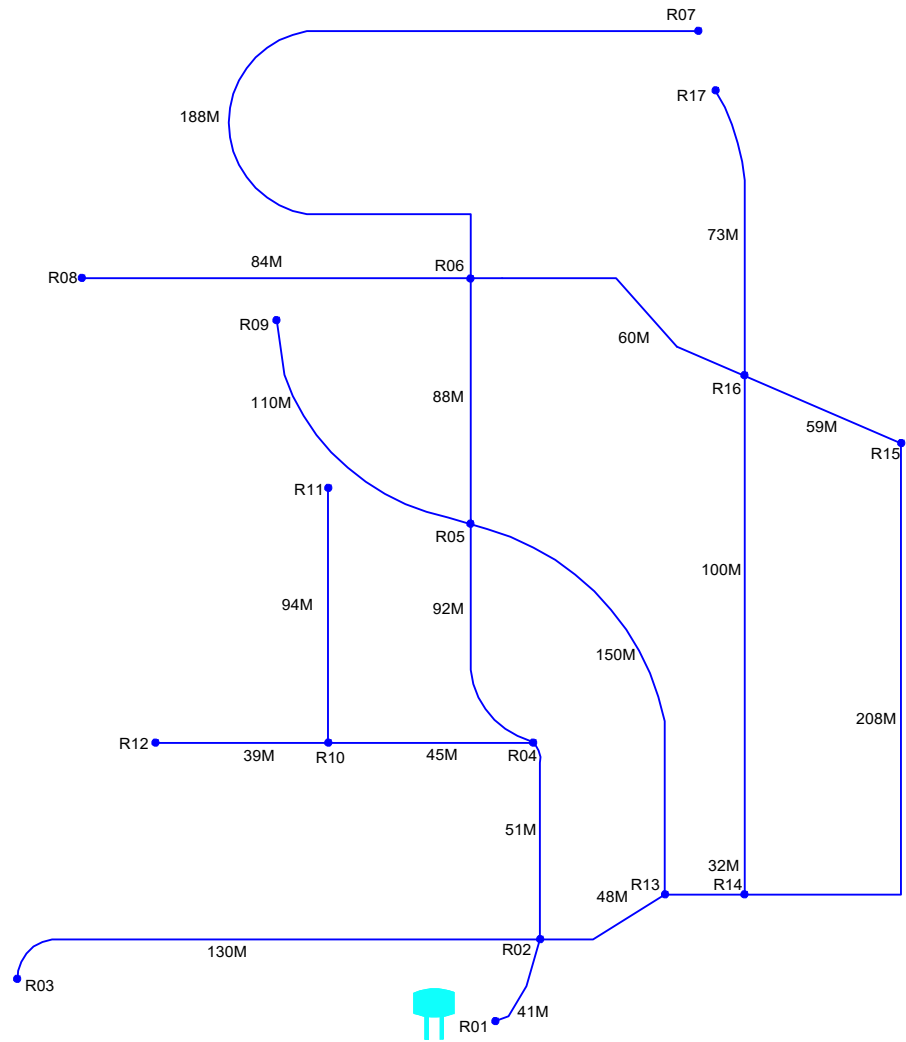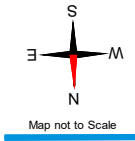

Checked	Designation	Signature

SINGLELINE LOOP DIAGRAM FOR BURUGUPALLE OHSR2 (MOMINPET)






 






	DUCT PIPE
	ROAD
	OHSR
	G.P OFFICE
	TEMPLE
	HOSPITAL
	SCHOOL
	DUCT GAP

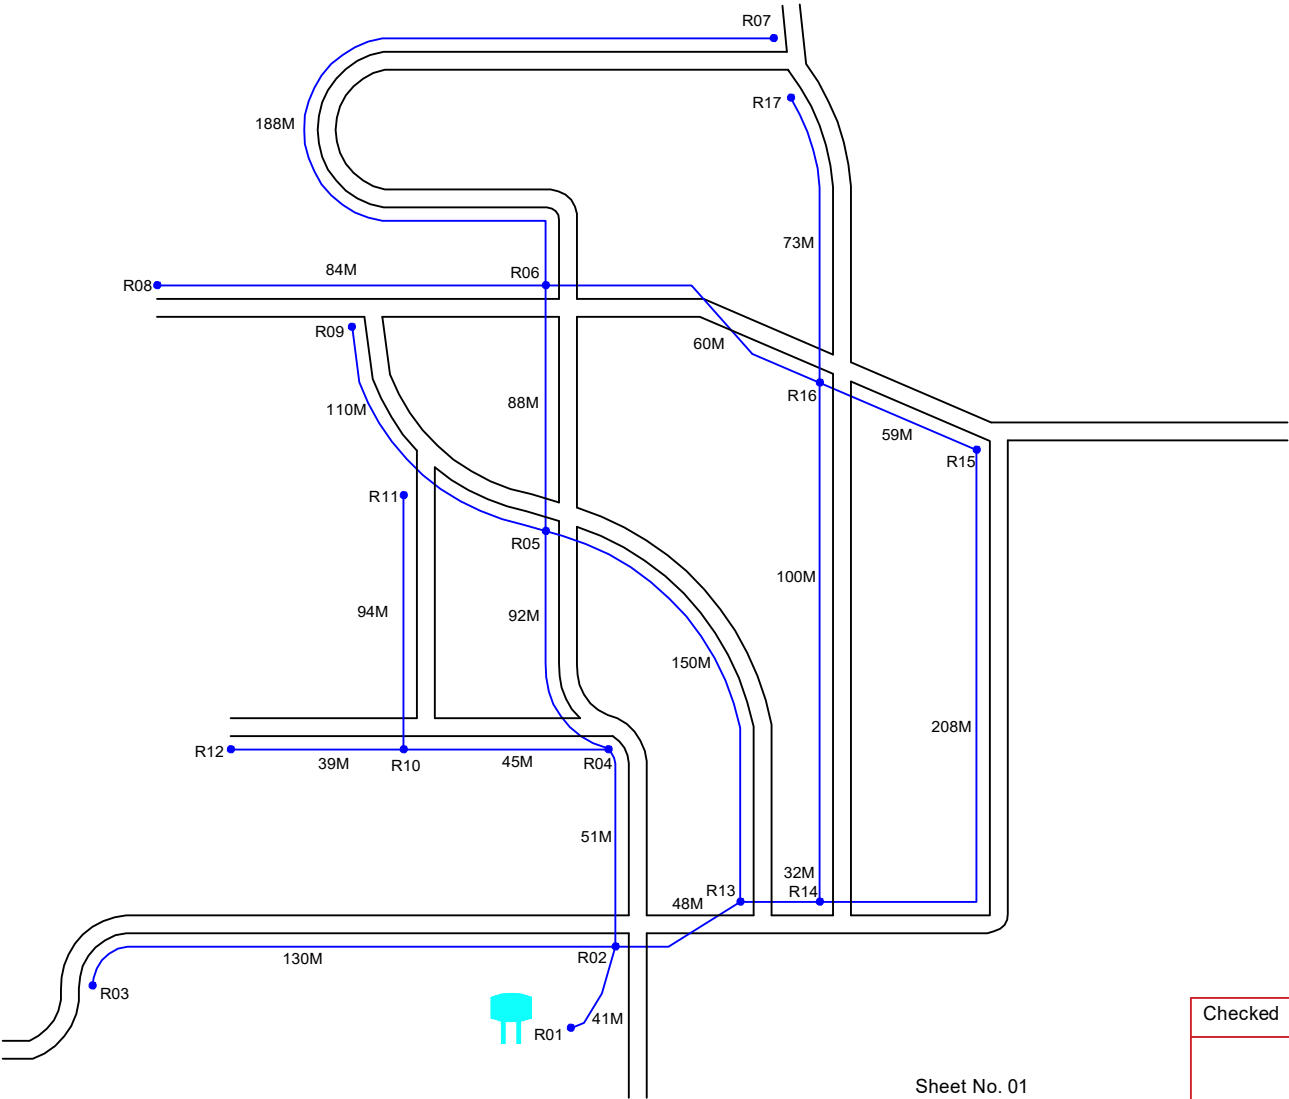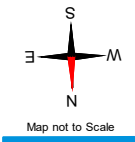Sheet No. 01
Route Distance : 2887 M

Checked	Designation	Signature

DUCTLAYING ROUTE DIAGRAM FOR BURUGUPALLE OHSR2 (MOMINPET)




	DUCT PIPE
	ROAD
	OHSR
	G.P OFFICE
	TEMPLE
	HOSPITAL
	SCHOOL
	DUCT GAP

Sheet No. 01
Route Distance : 2887 M


Checked	Designation	Signature

ROAD OFFSET DETAILING FOR BURUGUPALLE OHSR2 (MOMINPET)


Arb : R01-R02

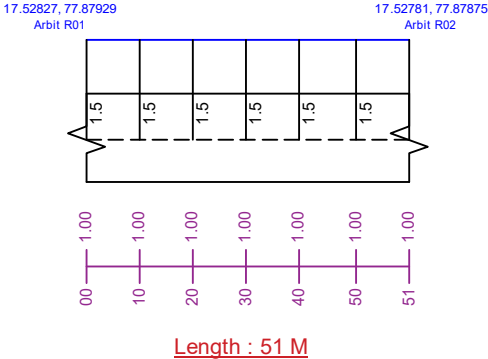


Arb : R02-R03

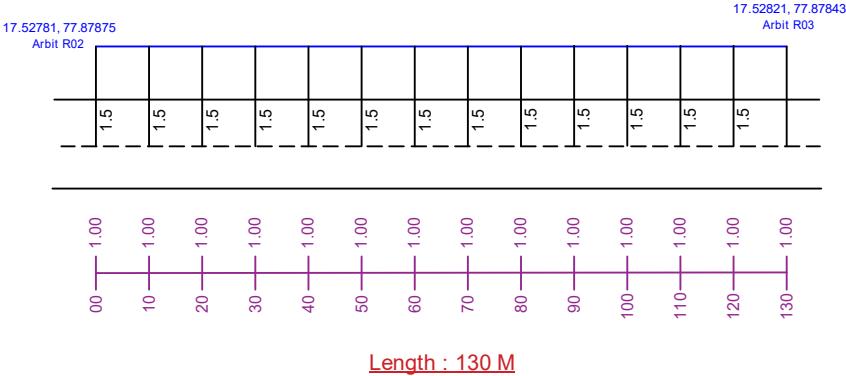

Arb : R02-R04



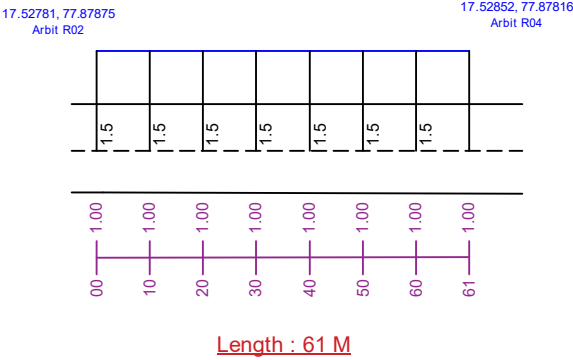


Arb : R04-R05

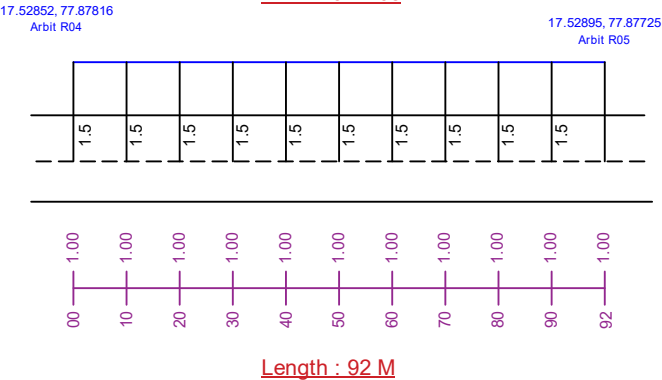

Checked	Designation	Signature






ROAD OFFSET DETAILING FOR BURUGUPALLE OHSR2 (MOMINPET)

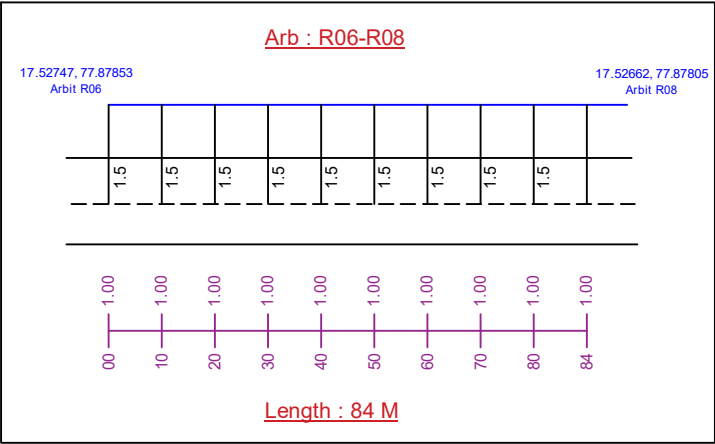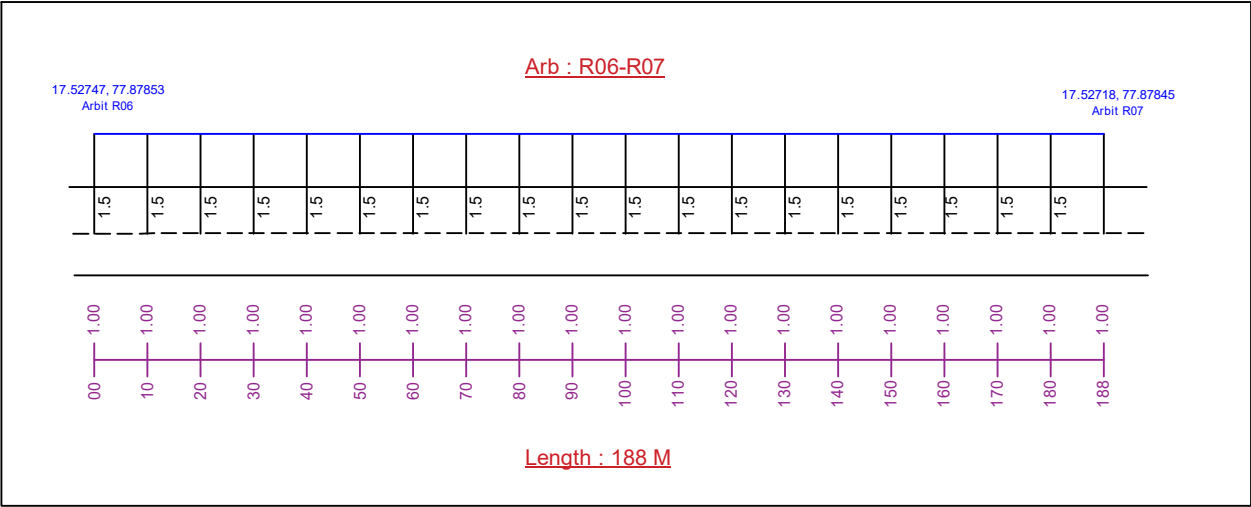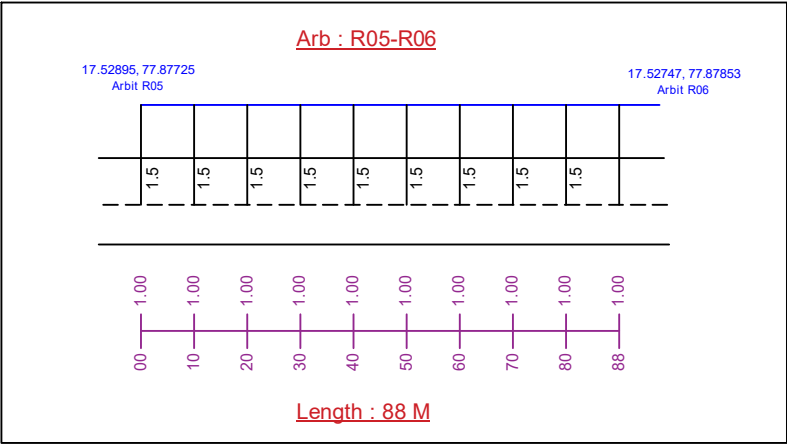

Sheet No. 02
Route Distance : 2887 M





Checked	Designation	Signature

ROAD OFFSET DETAILING FOR BURUGUPALLE OHSR2 (MOMINPET)

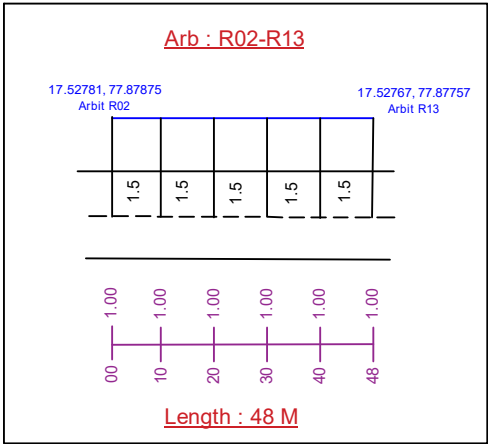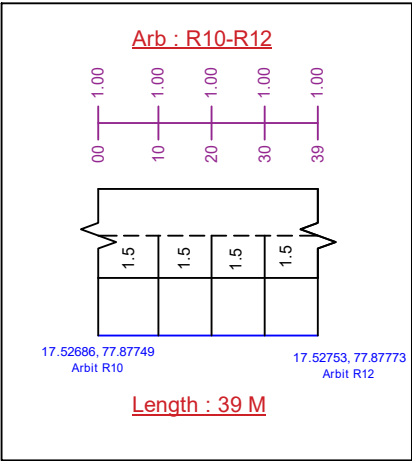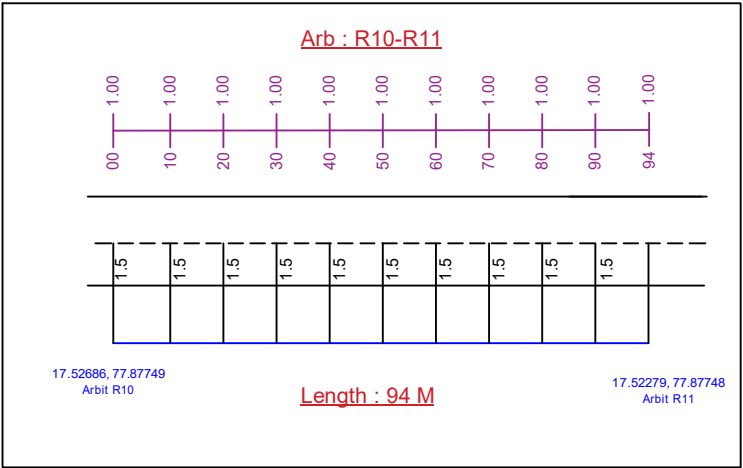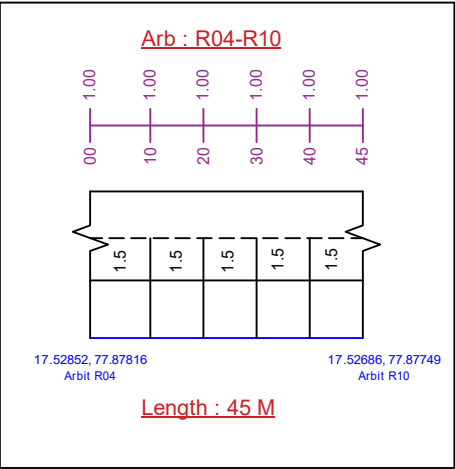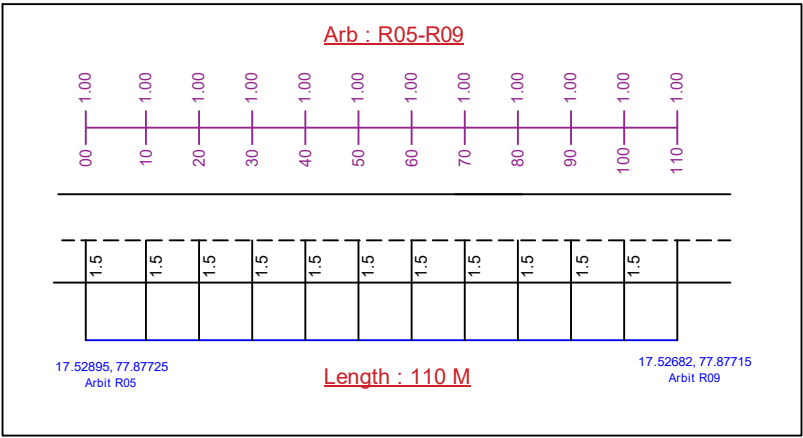

Checked	Designation	Signature


ROAD OFFSET DETAILING FOR BURUGUPALLE OHSR2 (MOMINPET)

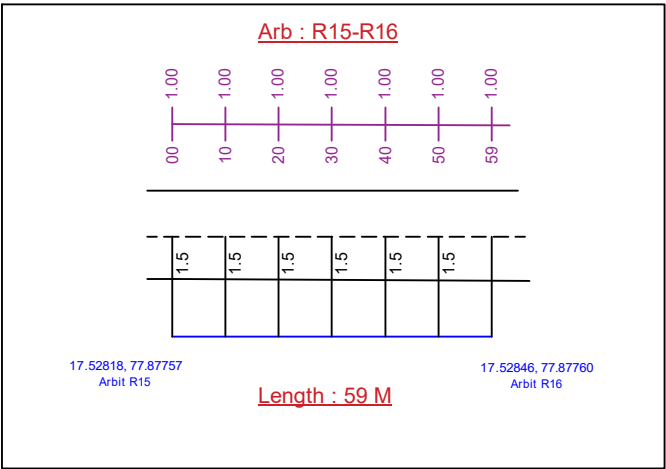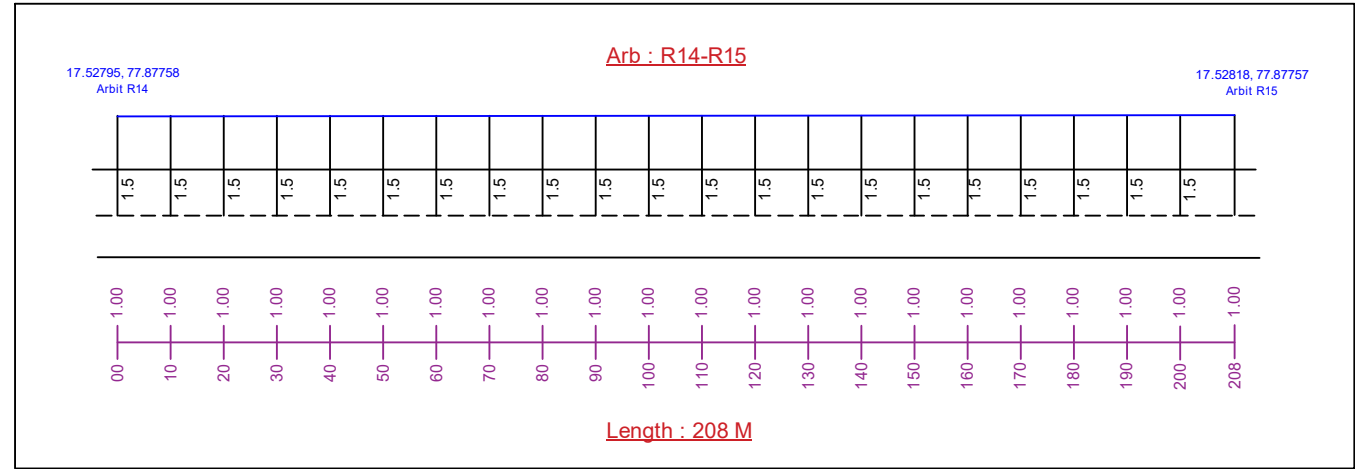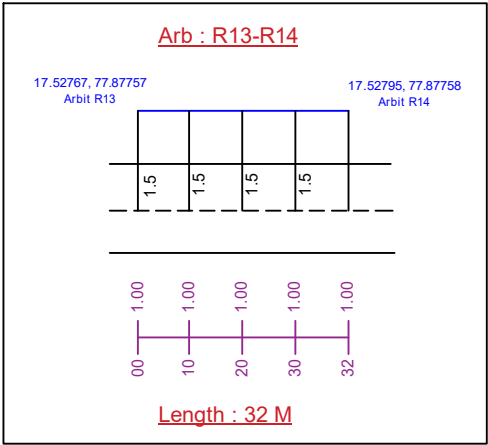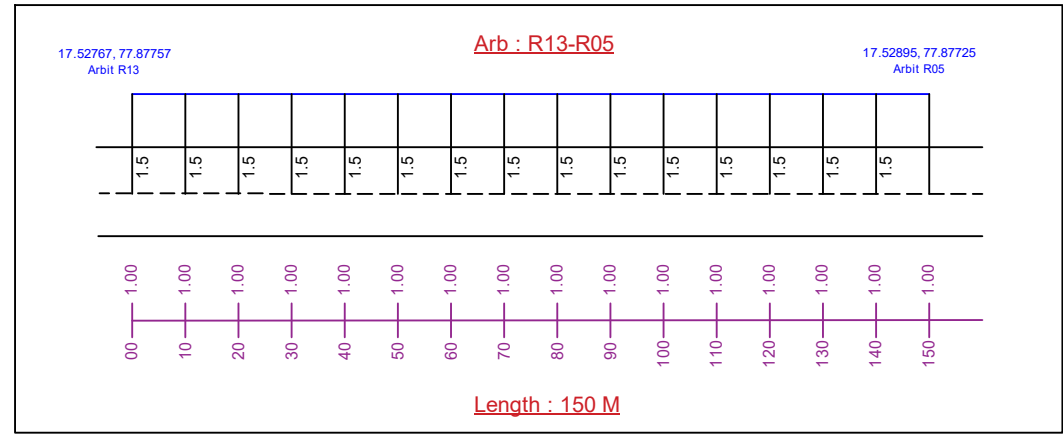


Checked	Designation	Signature

ROAD OFFSET DETAILING FOR BURUGUPALLE OHSR2 (MOMINPET)

Arb : R16-R06

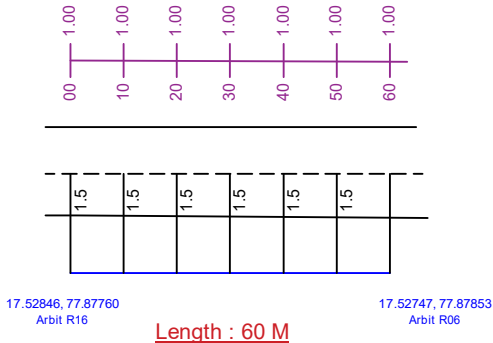

Arb : R16-R17

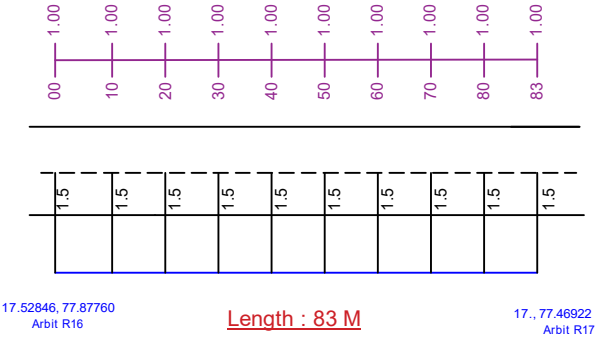

Checked	Designation	Signature



TELANGANA FIBER GRID

TELANGANA FIBER GRID

ITE & C GOVERNMENT OF TELANGANA

7th Floor, Splendid Towers, S.P. Road

Opp: Begumpet Police Station,



Begumpet, Hyderabad-500016.


 






AS - BUILT DRAWINGS (ABD)

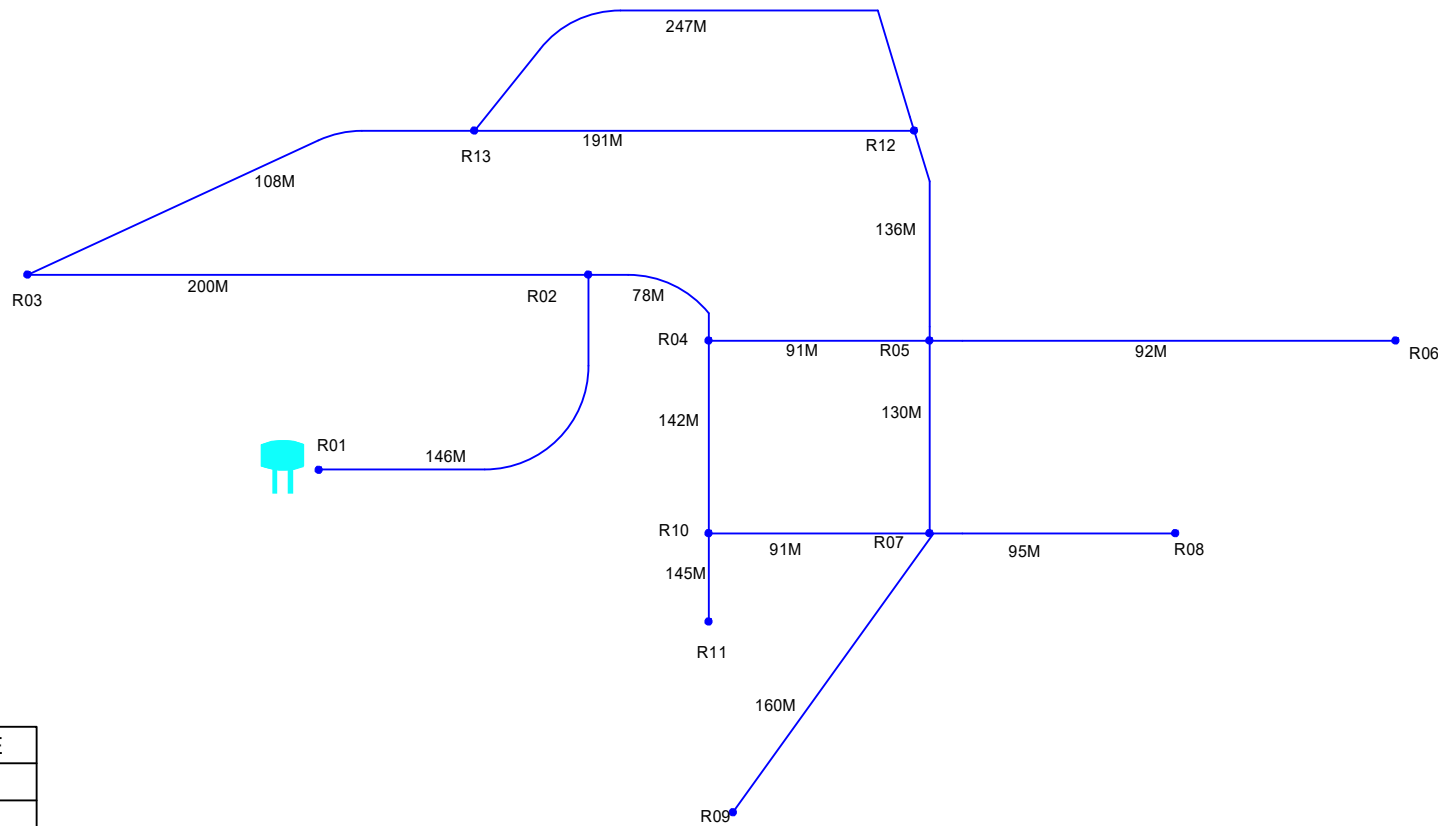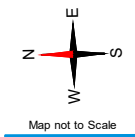CHAKRAMPALLE

(MOMINPET MANDAL-VIKARABAD DIST.)

SINGLELINE LOOP DIAGRAM FOR CHAKRAMPALLE OHSR1 (MOMINPET)






 






	DUCT PIPE
	ROAD
	OHSR
	G.P OFFICE
	TEMPLE
	HOSPITAL
	SCHOOL
	DUCT GAP

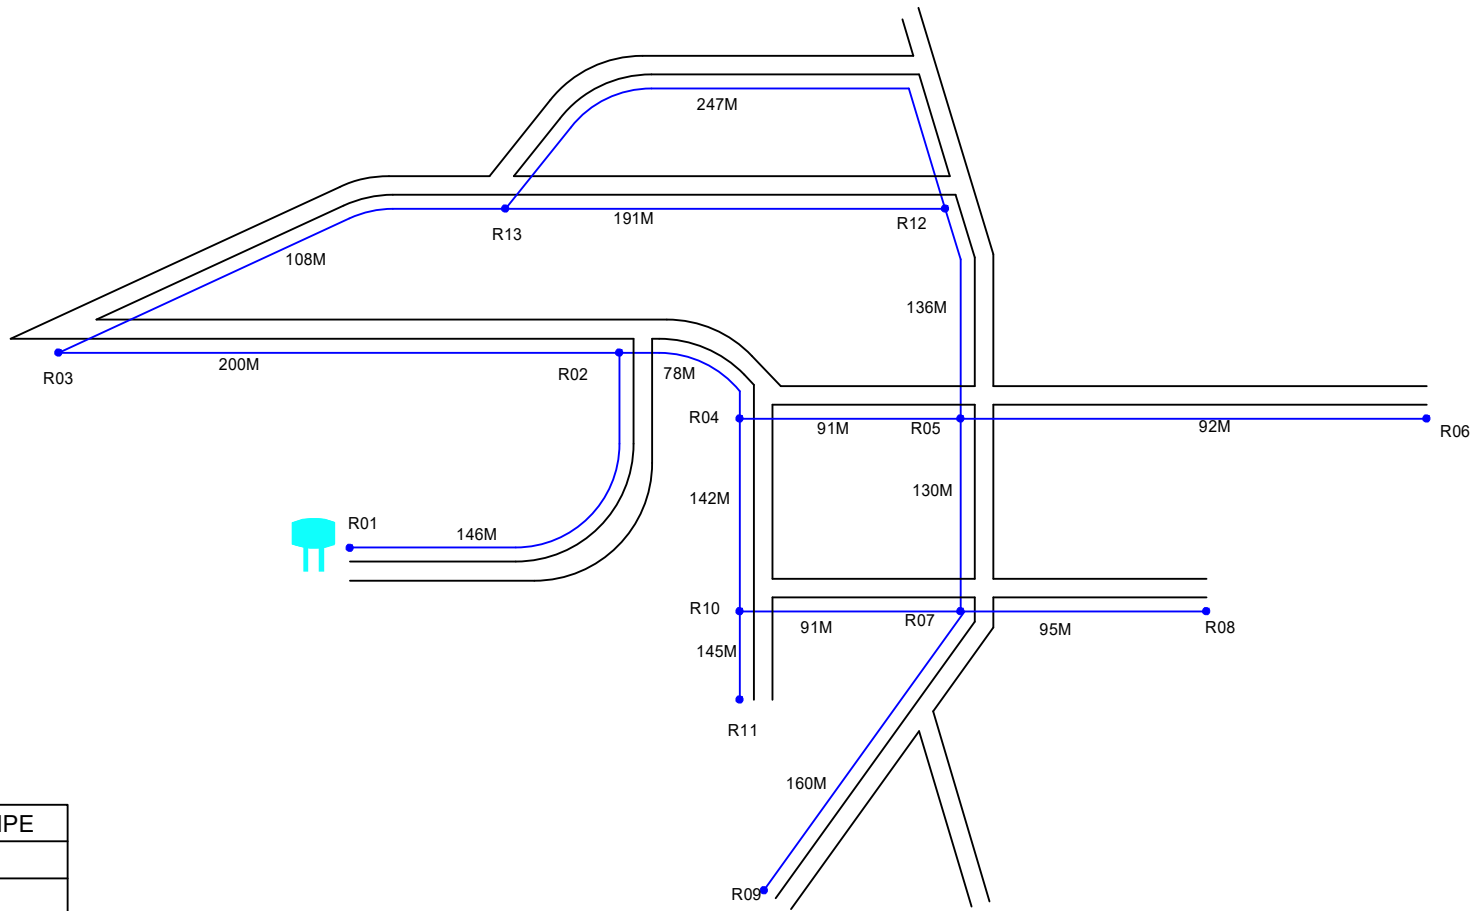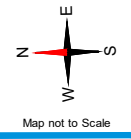Sheet No. 01
Route Distance : 6092 M

Checked	Designation	Signature

DUCTLAYING ROUTE DIAGRAM FOR CHAKRAMPALLE OHSR1 (MOMINPET)






	DUCT PIPE
	ROAD
	OHSR
	G.P OFFICE
	TEMPLE
	HOSPITAL
	SCHOOL
	DUCT GAP

Sheet No. 01
Route Distance : 6092 M

Checked	Designation	Signature


ROAD OFFSET DETAILING FOR CHAKRAMPALLE OHSR1 (MOMINPET)

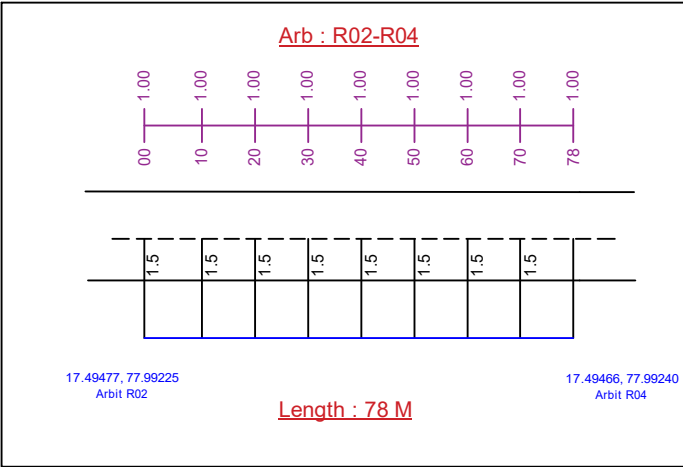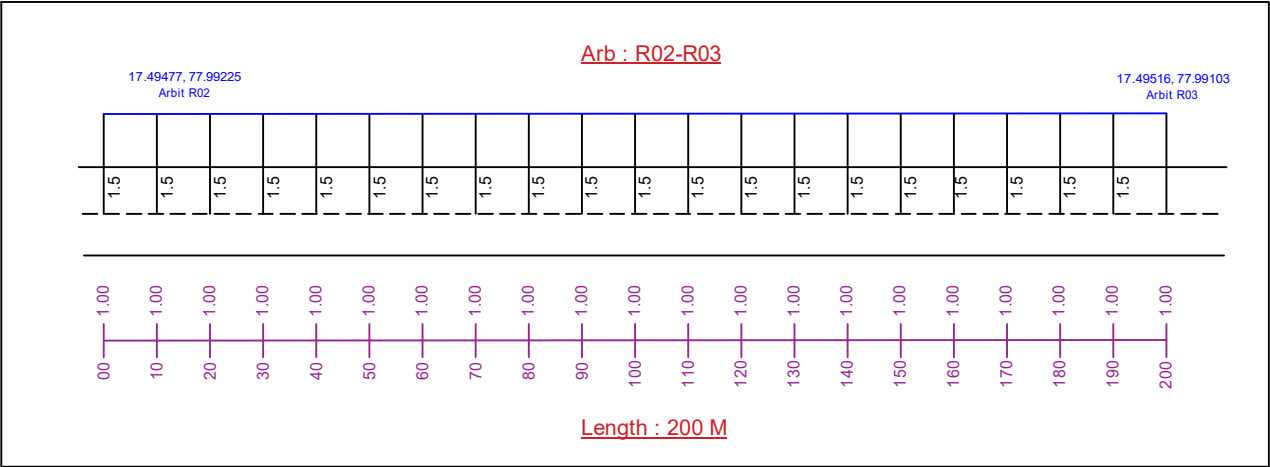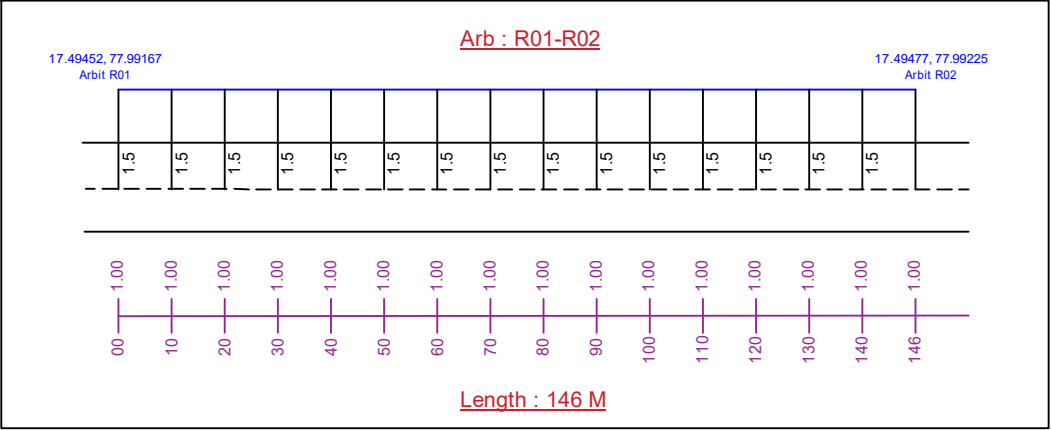

Checked	Designation	Signature

ROAD OFFSET DETAILING FOR CHAKRAMPALLE OHSR1 (MOMINPET)

Arb : R04-R05

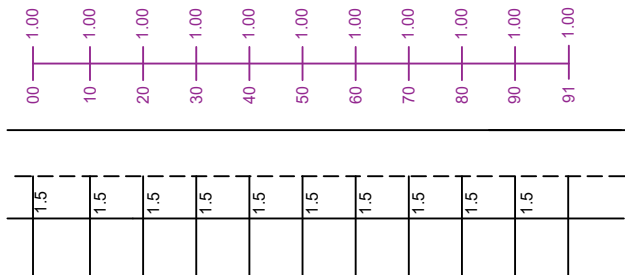


17.49466, 77.99240
Arbit R04

Length : 91 M

17.49455, 77.99270
Arbit R05

Arb : R05-R06

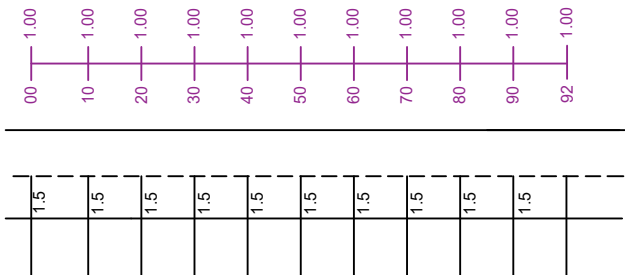


17.49455, 77.99270
Arbit R05

Length : 92 M

17.49445, 77.99300
Arbit R06

Arb : R05-R07

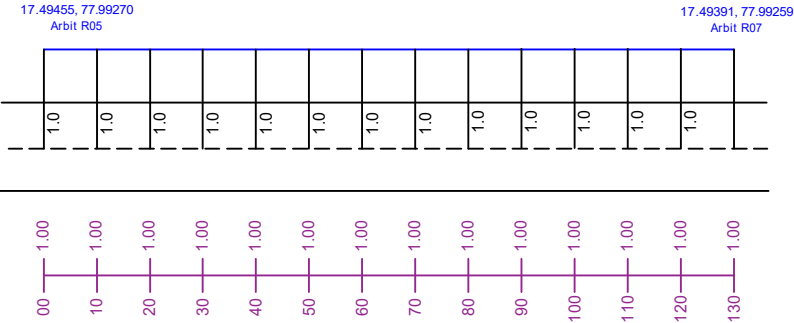


17.49455, 77.99270
Arbit R05

17.49391, 77.99259
Arbit R07

Length : 130 M

Arb : R07-R08

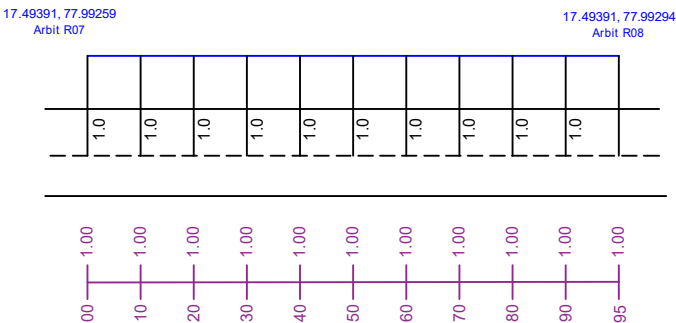



17.49391, 77.99259
Arbit R07

17.49391, 77.99294
Arbit R08

Length : 95 M

Checked	Designation	Signature


ROAD OFFSET DETAILING FOR CHAKRAMPALLE OHSR1 (MOMINPET)

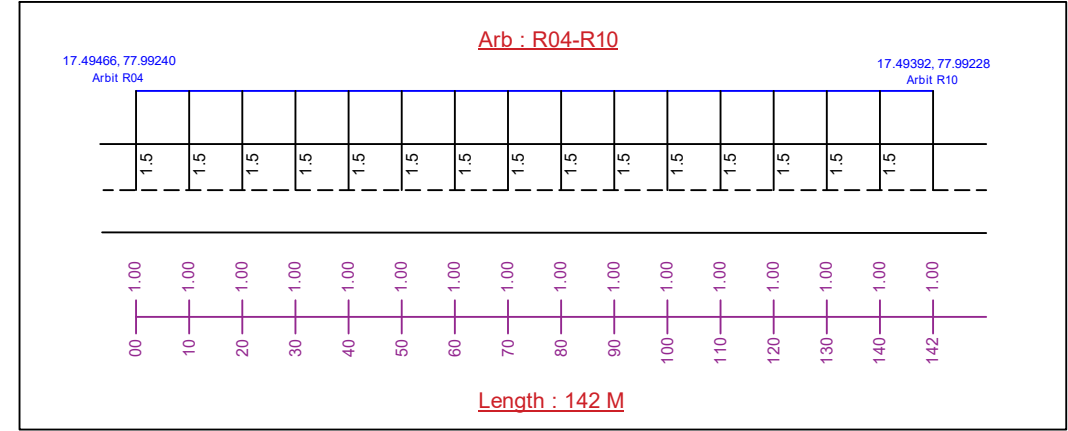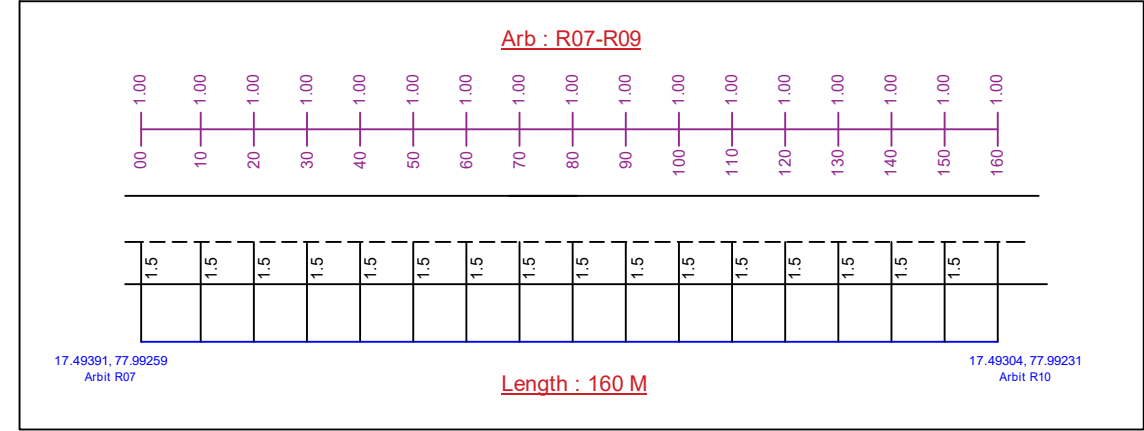


Checked	Designation	Signature

ROAD OFFSET DETAILING FOR CHAKRAMPALLE OHSR1 (MOMINPET)


Arb : R10-R11

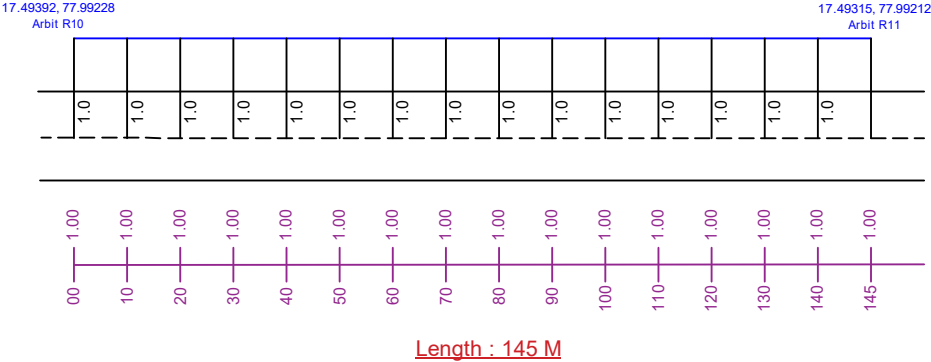

Arb : R07-R10


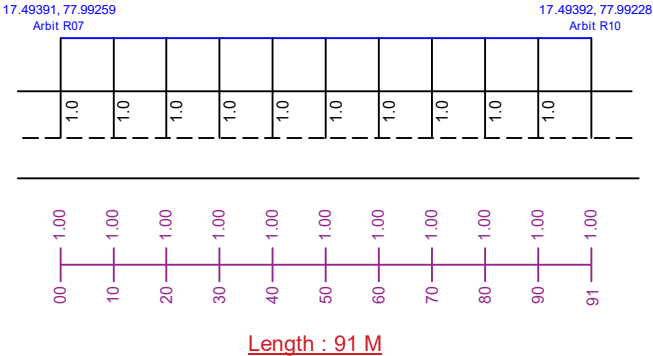


Arb : R05-R12

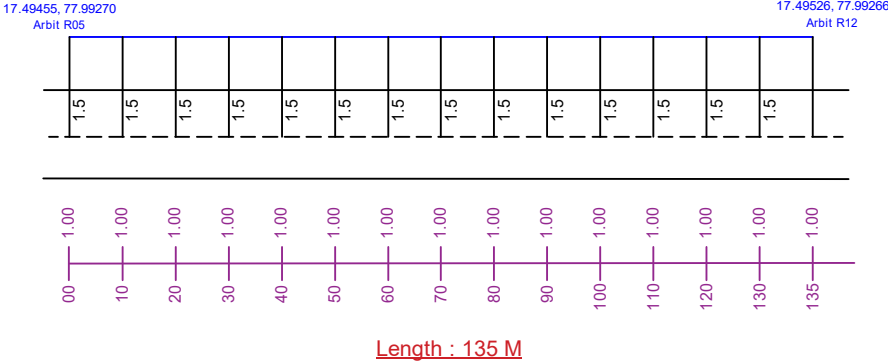



Checked	Designation	Signature

ROAD OFFSET DETAILING FOR CHAKRAMPALLE OHSR1 (MOMINPET)

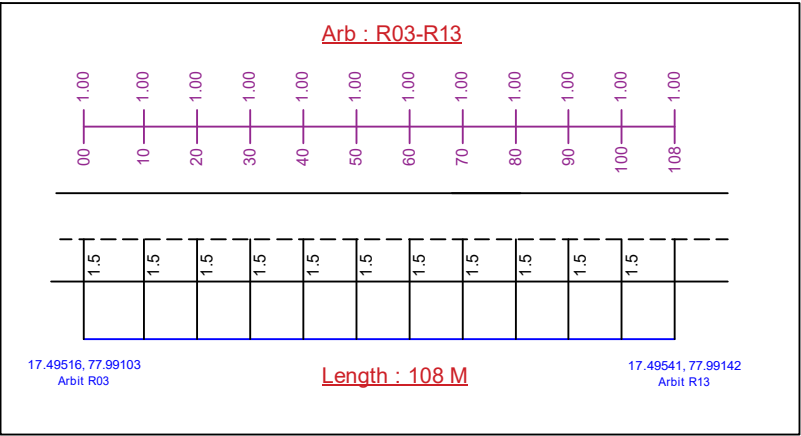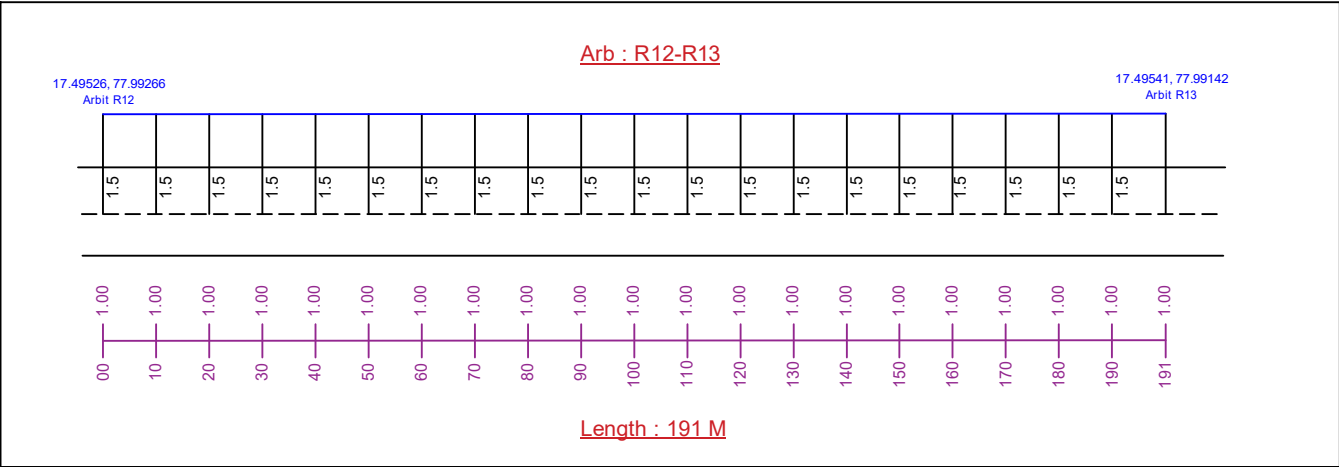

Checked	Designation	Signature



ROAD OFFSET DETAILING FOR CHAKRAMPALLE OHSR1 (MOMINPET)

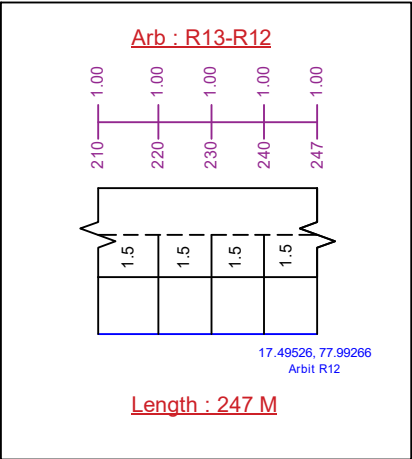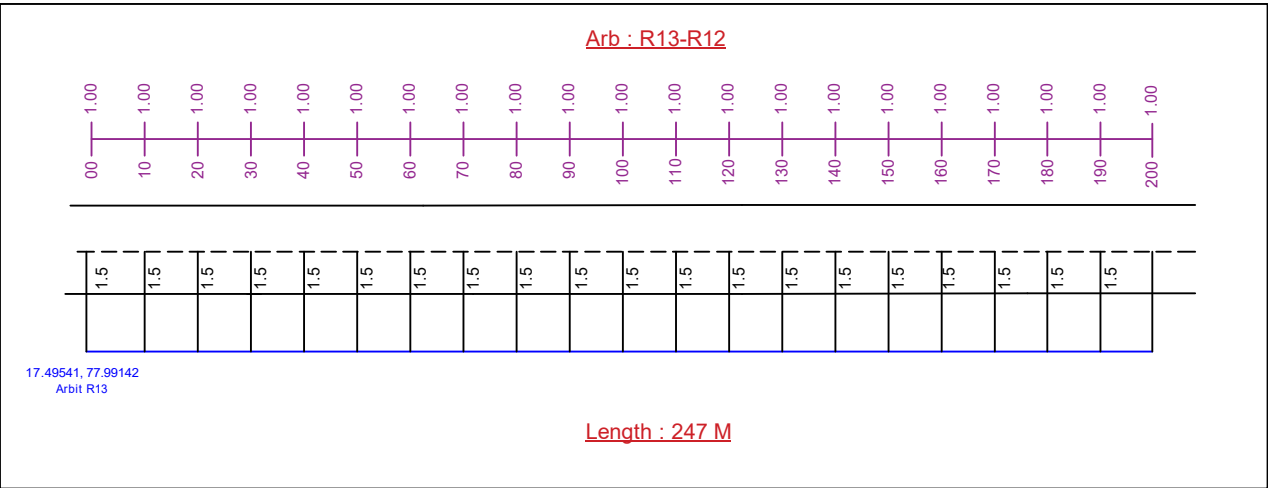
 






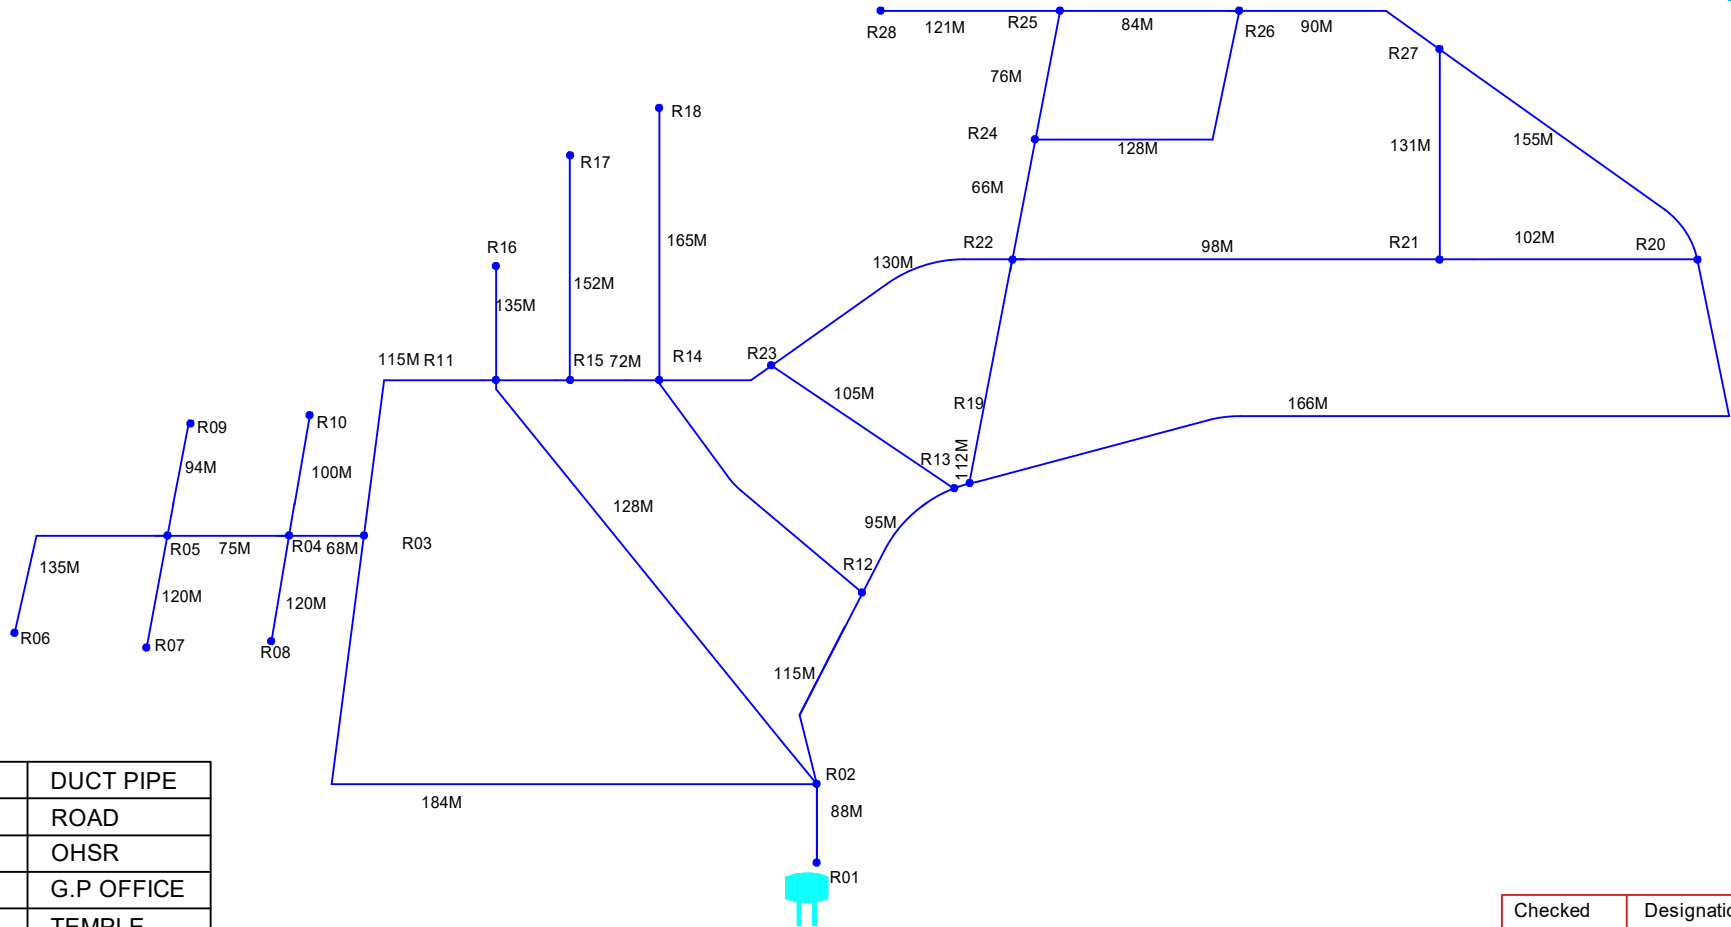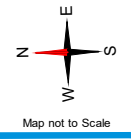

Sheet No. 06
Route Distance : 6092 M

Checked	Designation	Signature

SINGLELINE LOOP DIAGRAM FOR CHAKRAMPALLE OHSR2 (MOMINPET)






 






	DUCT PIPE
	ROAD
	OHSR
	G.P OFFICE
	TEMPLE
	HOSPITAL
	SCHOOL
	DUCT GAP

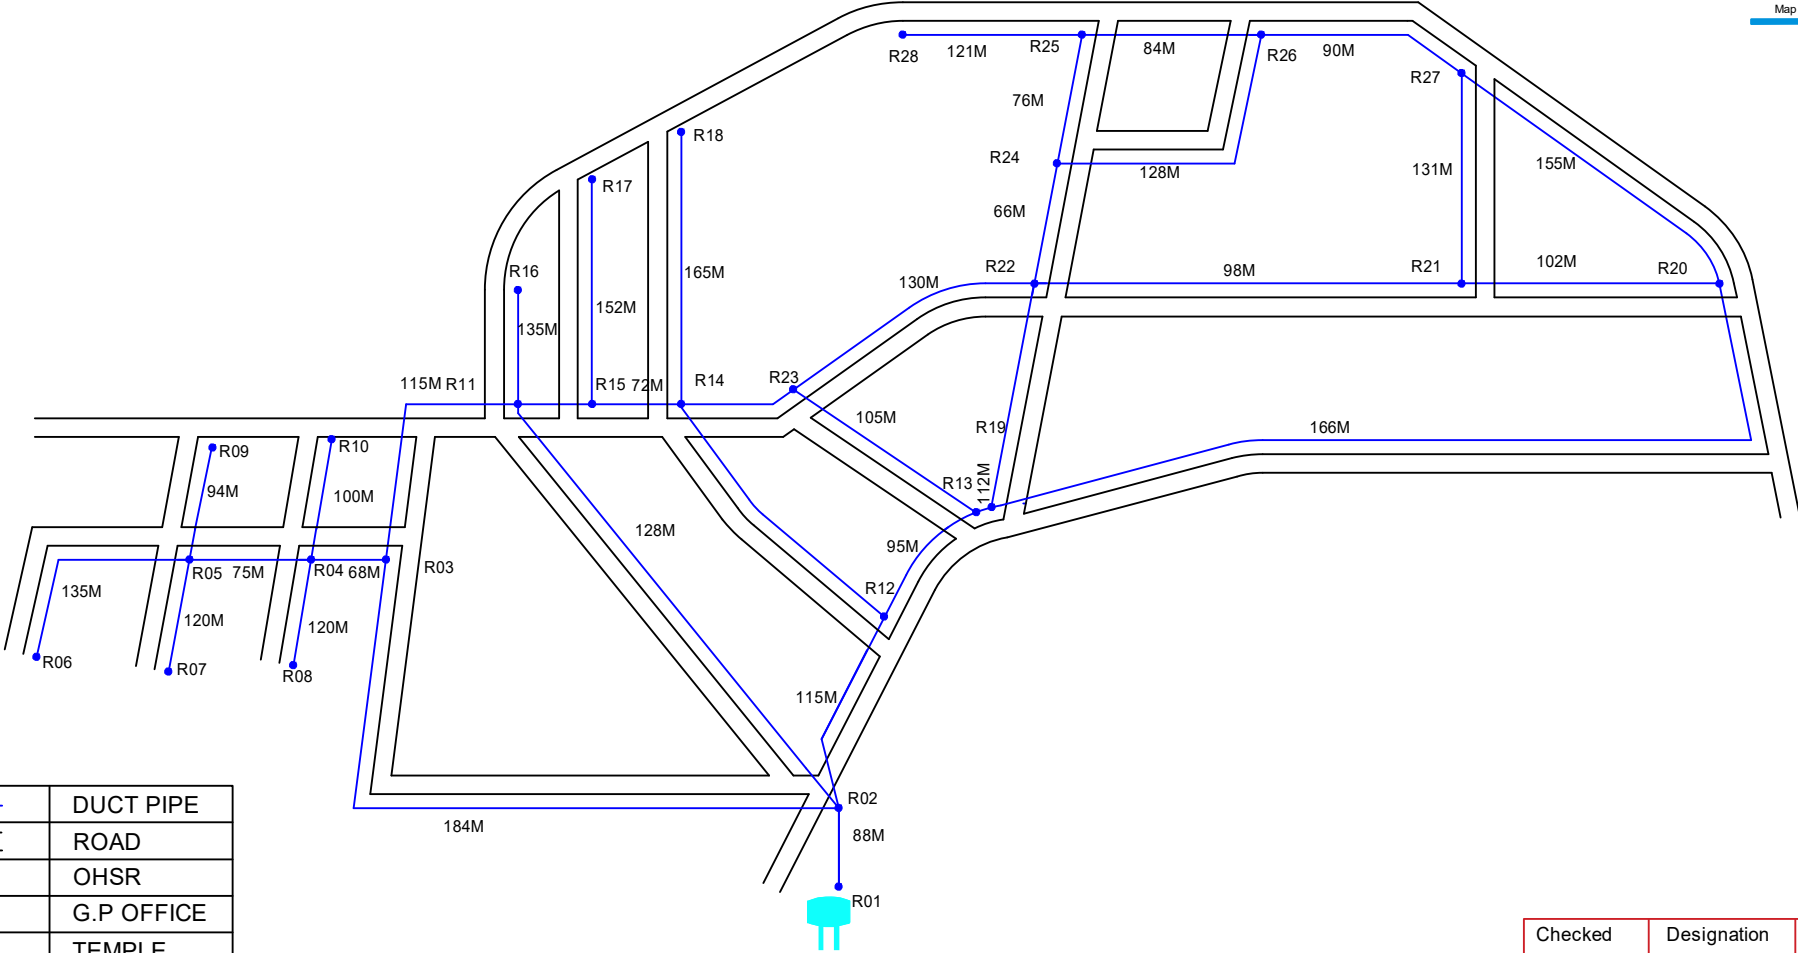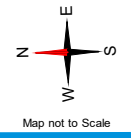Sheet No. 01
Route Distance : 6092 M

Checked	Designation	Signature

DUCTLAYING ROUTE DIAGRAM FOR CHAKRAMPALLY OHSR2 (MOMINPET)




	DUCT PIPE
	ROAD
	OHSR
	G.P OFFICE
	TEMPLE
	HOSPITAL
	SCHOOL
	DUCT GAP

Sheet No. 01
Route Distance : 6092 M


Checked	Designation	Signature

ROAD OFFSET DETAILING FOR CHAKRAMPALLE OHSR2 (MOMINPET)


Arb : R01-R02

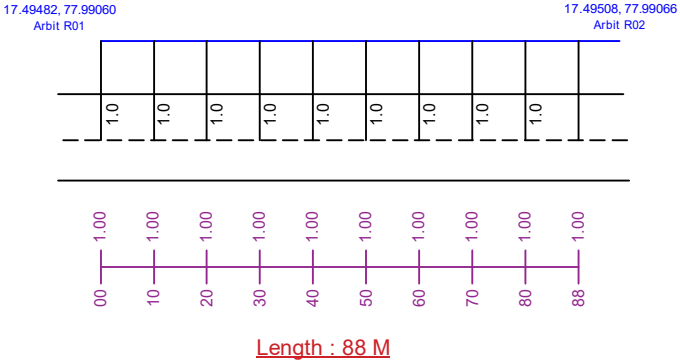


Arb : R02-R03

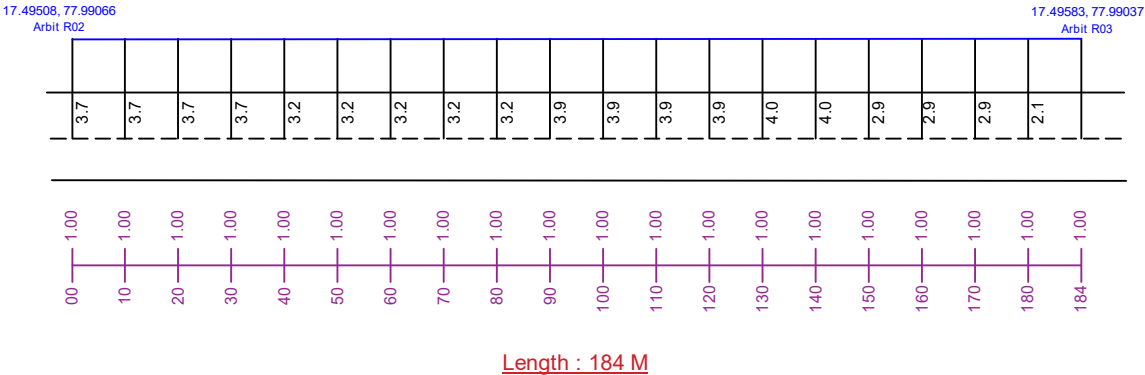

Arb : R03-R04




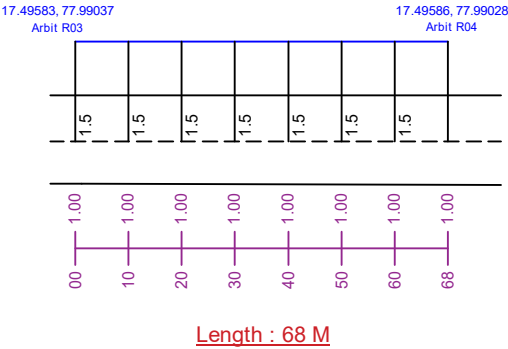


Arb : R04-R05

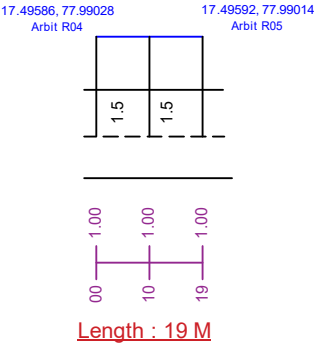




Checked	Designation	Signature

ROAD OFFSET DETAILING FOR CHAKRAMPALLE OHSR2 (MOMINPET)

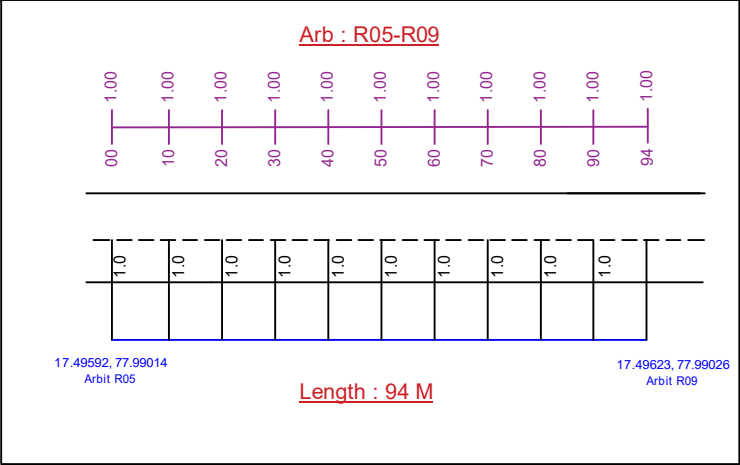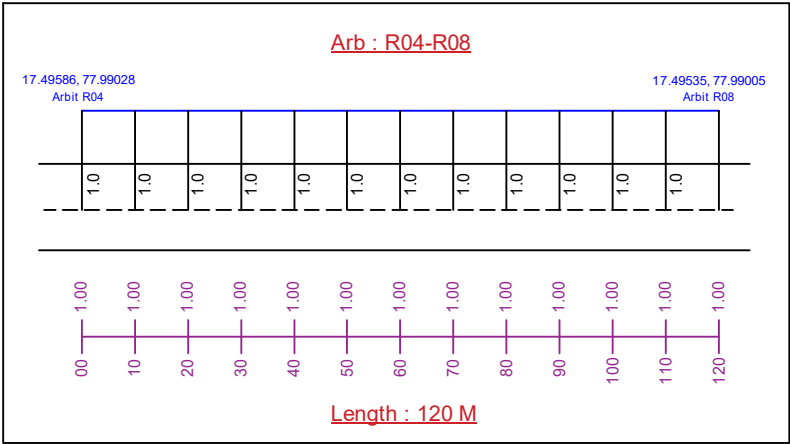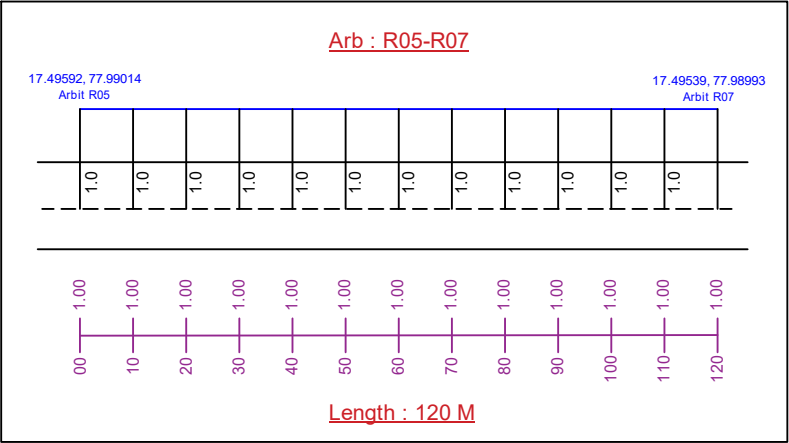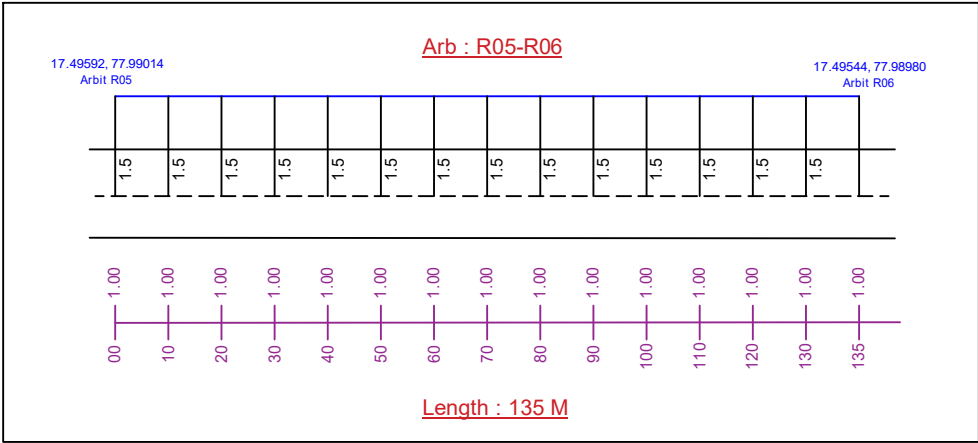





Checked	Designation	Signature

ROAD OFFSET DETAILING FOR CHAKRAMPALLE OHSR2 (MOMINPET)

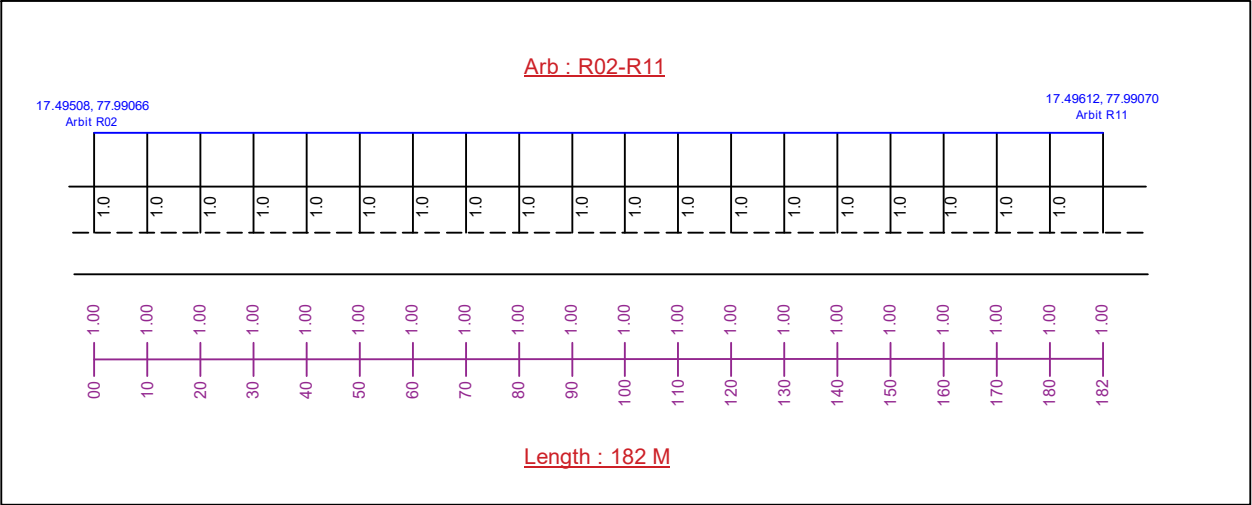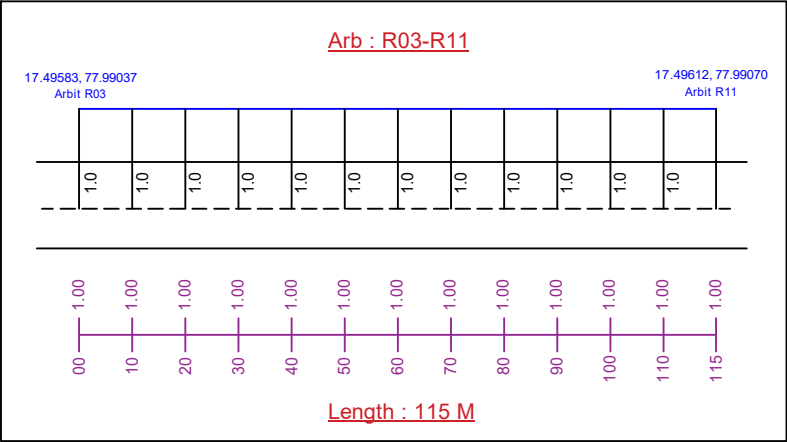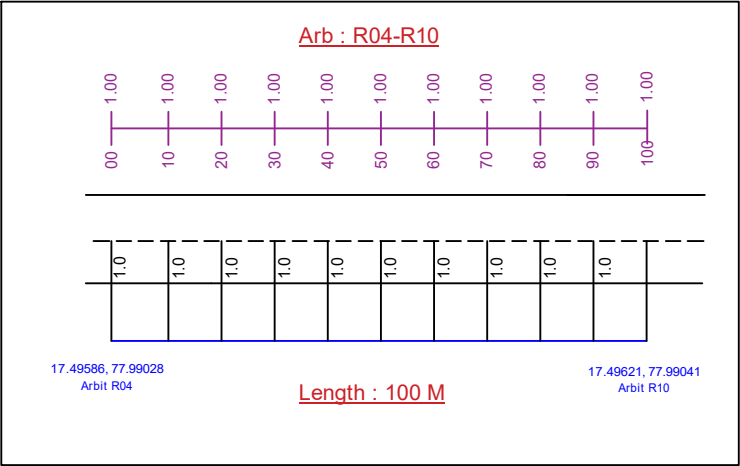

Checked	Designation	Signature


ROAD OFFSET DETAILING FOR CHAKRAMPALLE OHSR2 (MOMINPET)

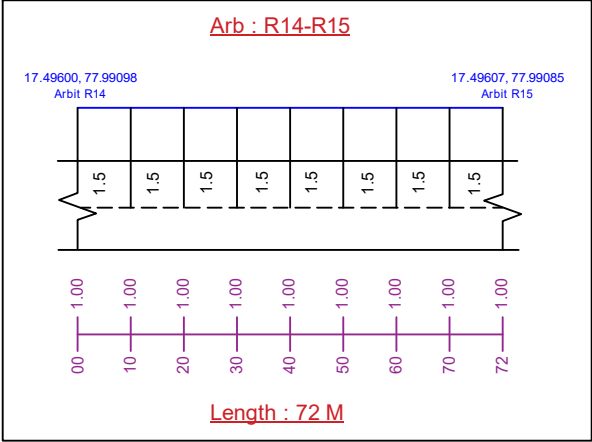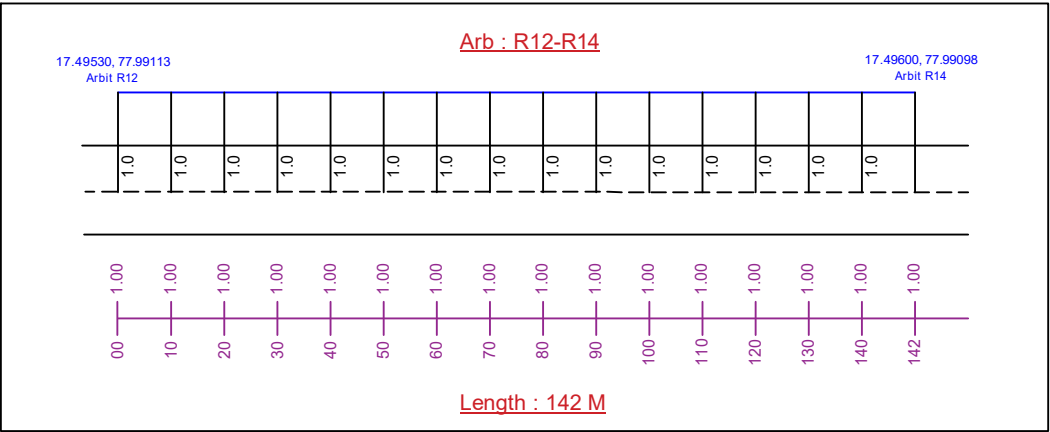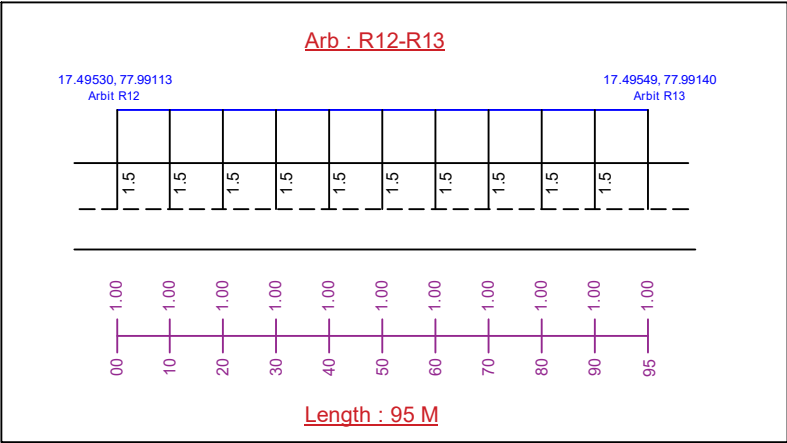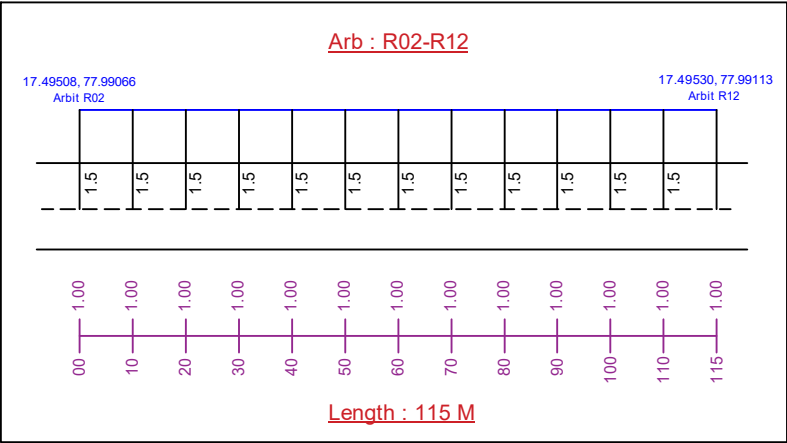


Checked	Designation	Signature

ROAD OFFSET DETAILING FOR CHAKRAMPALLE OHSR2 (MOMINPET)


Arb : R14-R15

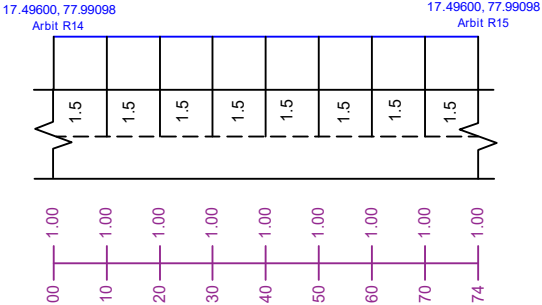

Arb : R11-R16

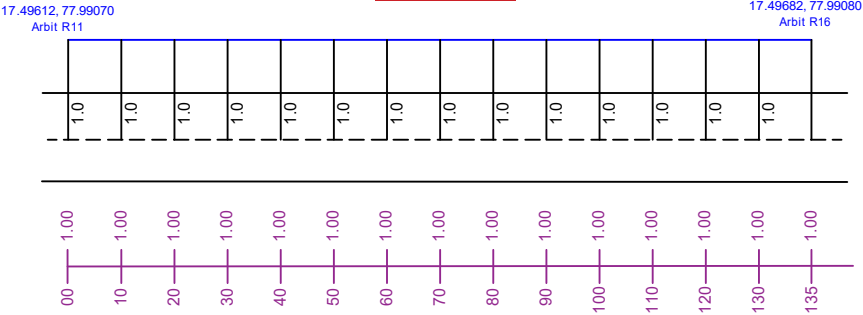


Arb : R15-R17

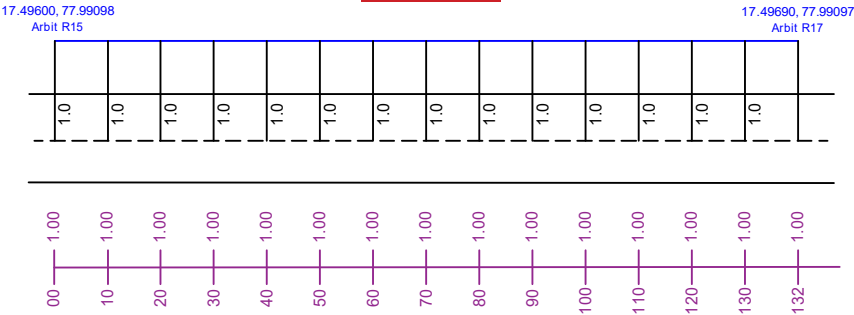


Checked	Designation	Signature

ROAD OFFSET DETAILING FOR CHAKRAMPALLE OHSR2 (MOMINPET)


Arb : R14-R18

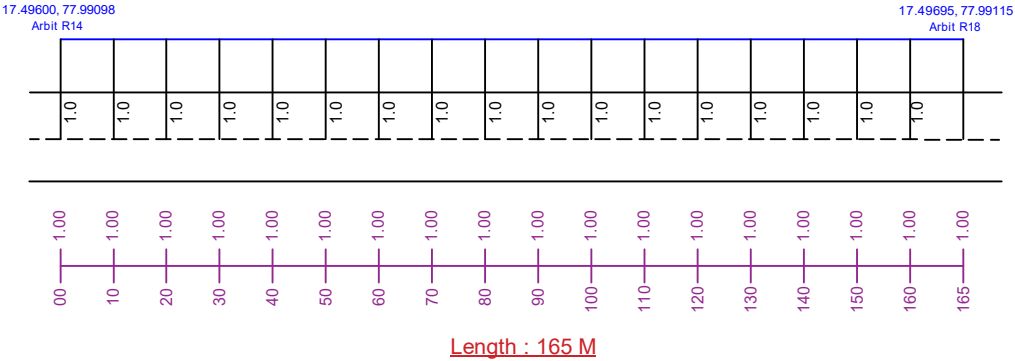


Arb : R13-R23

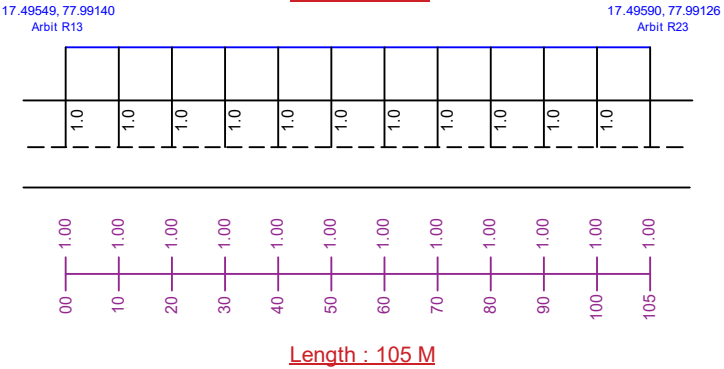

Arb : R14-R23

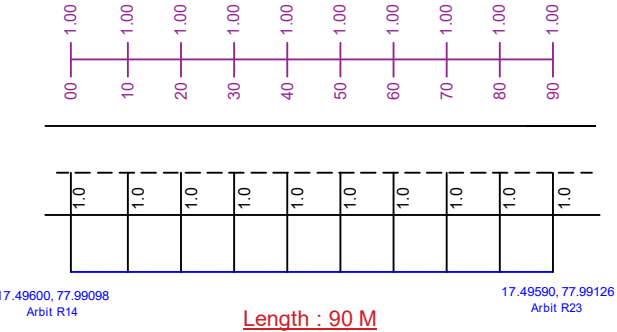


Arb : R13-R19

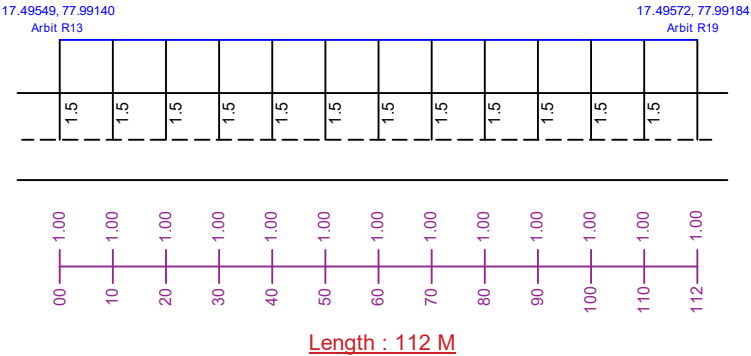


Checked	Designation	Signature

ROAD OFFSET DETAILING FOR CHAKRAMPALLE OHSR2 (MOMINPET)


Arb : R19-R20

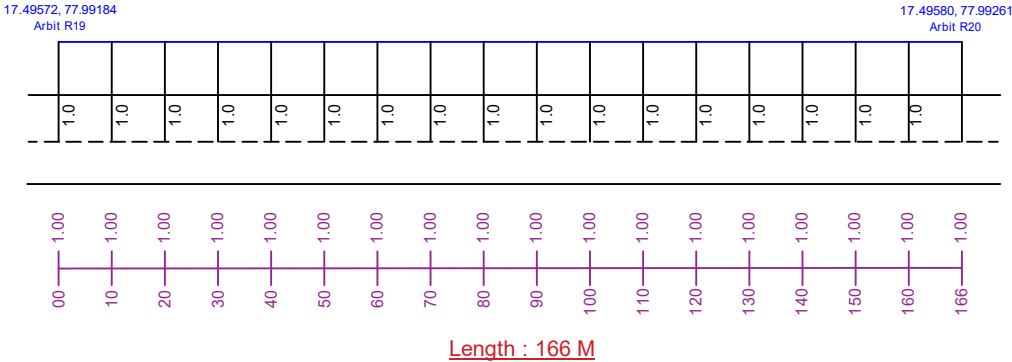


Arb : R20-R21

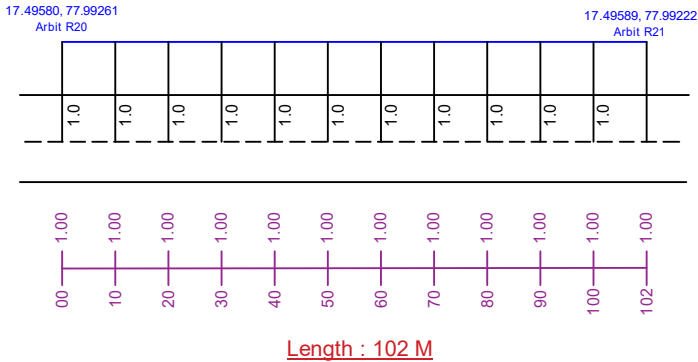

Arb : R21-R22

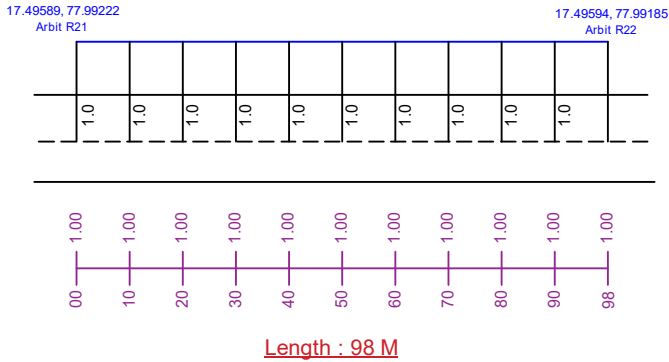


Arb : R22-R23

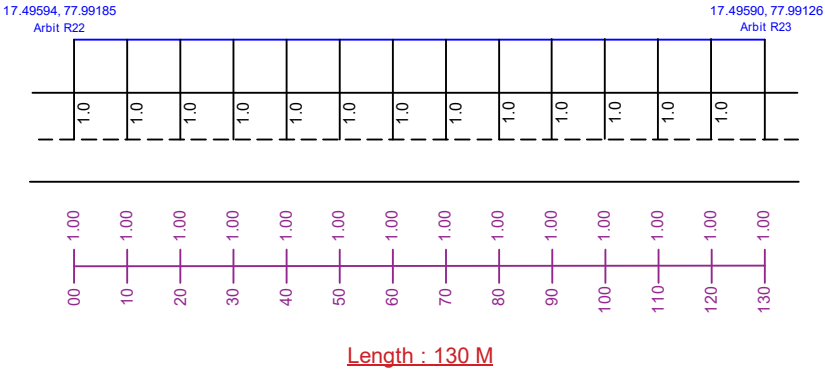

Checked	Designation	Signature


ROAD OFFSET DETAILING FOR CHAKRAMPALLE OHSR2 (MOMINPET)

Arb : R19-R22

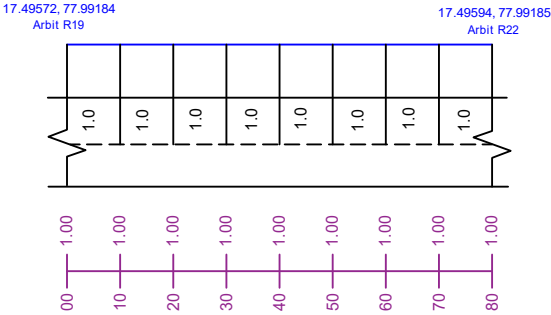


Length : 80 M

Arb : R22-R24

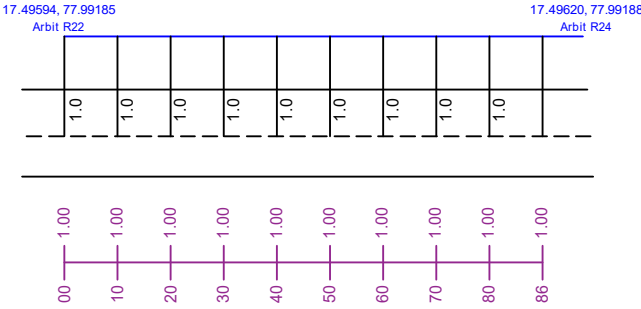


Length : 86 M

Arb : R24-R25

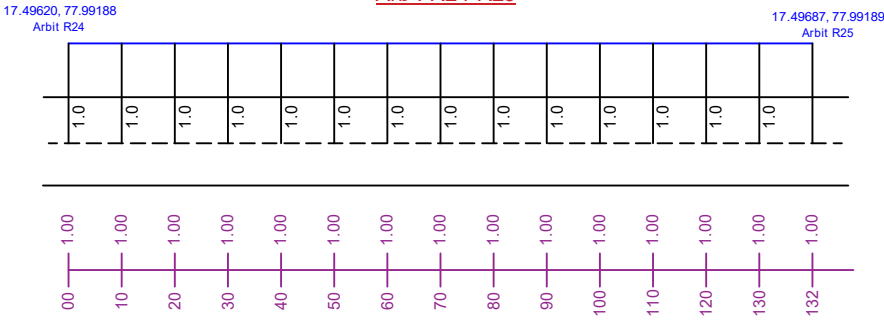

Length : 132 M





Arb : R24-R26

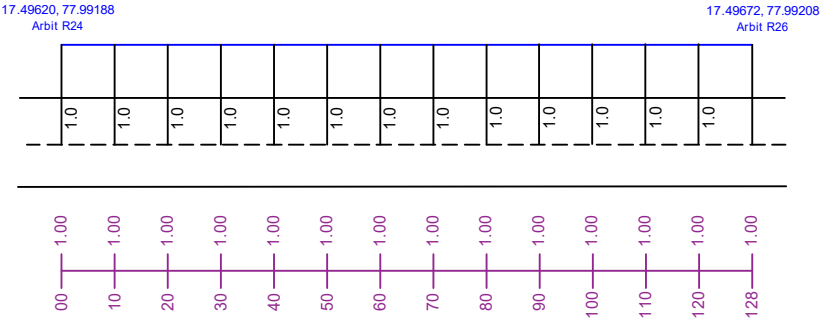

Length : 128 M


Checked	Designation	Signature

ROAD OFFSET DETAILING FOR CHAKRAMPALLE OHSR2 (MOMINPET)

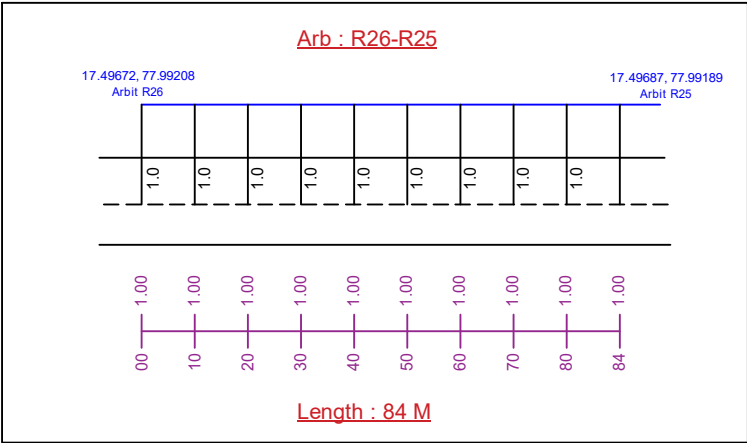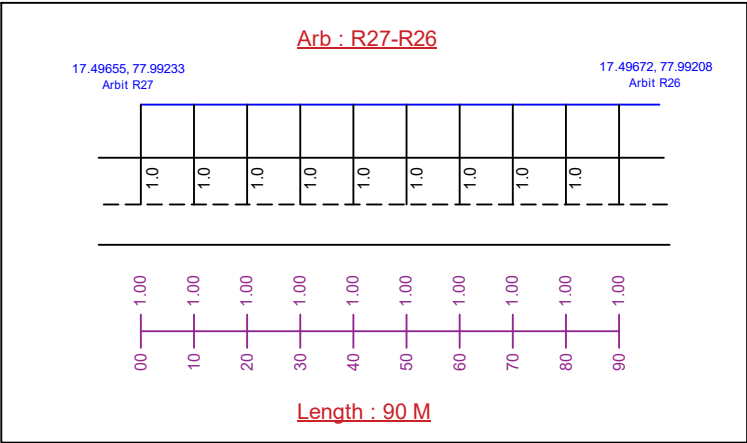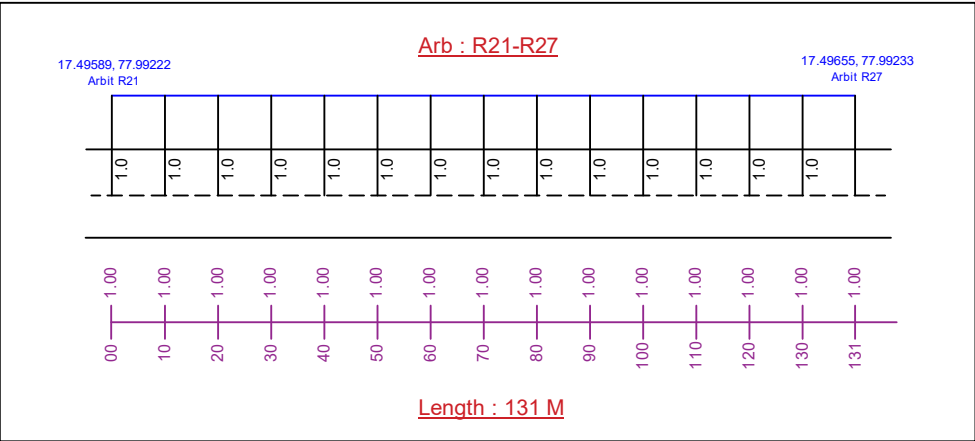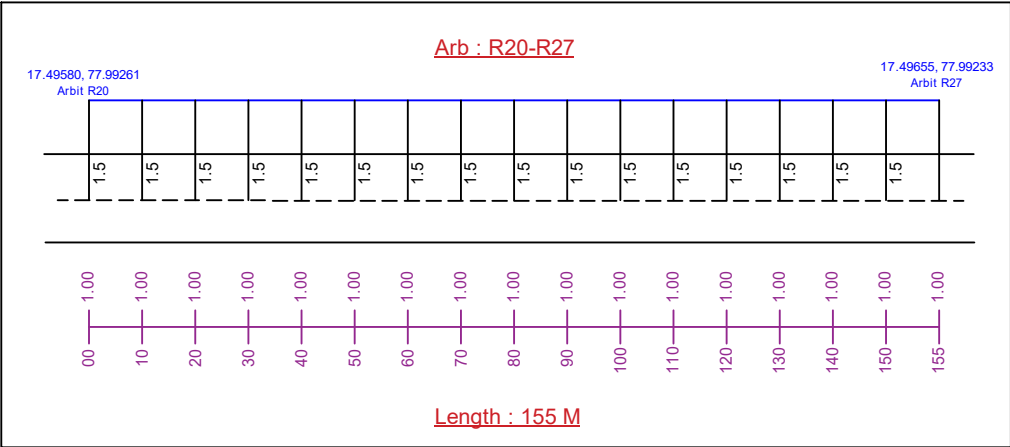

Checked	Designation	Signature

ROAD OFFSET DETAILING FOR CHAKRAMPALLE OHSR2 (MOMINPET)

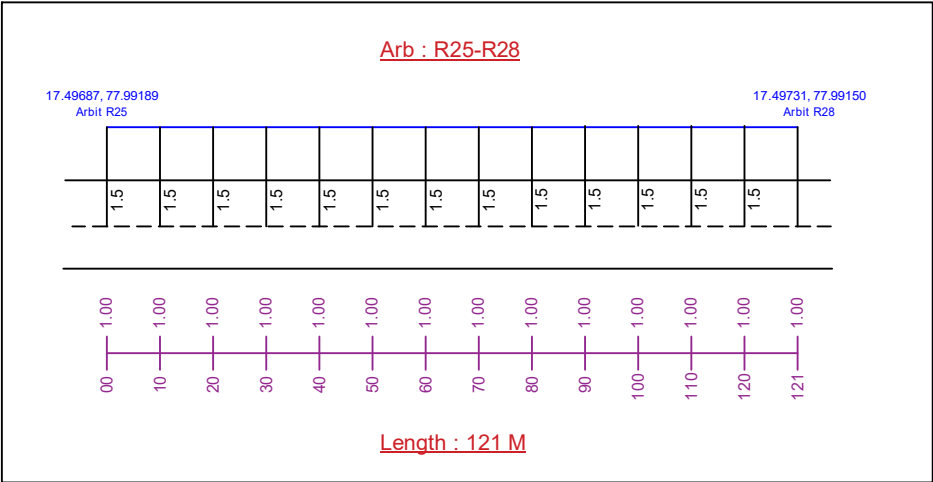

Checked	Designation	Signature



TELANGANA FIBER GRID

TELANGANA FIBER GRID

ITE & C GOVERNMENT OF TELANGANA

7th Floor, Splendid Towers, S.P. Road

Opp: Begumpet Police Station,



Begumpet, Hyderabad-500016.


 






AS - BUILT DRAWINGS (ABD)

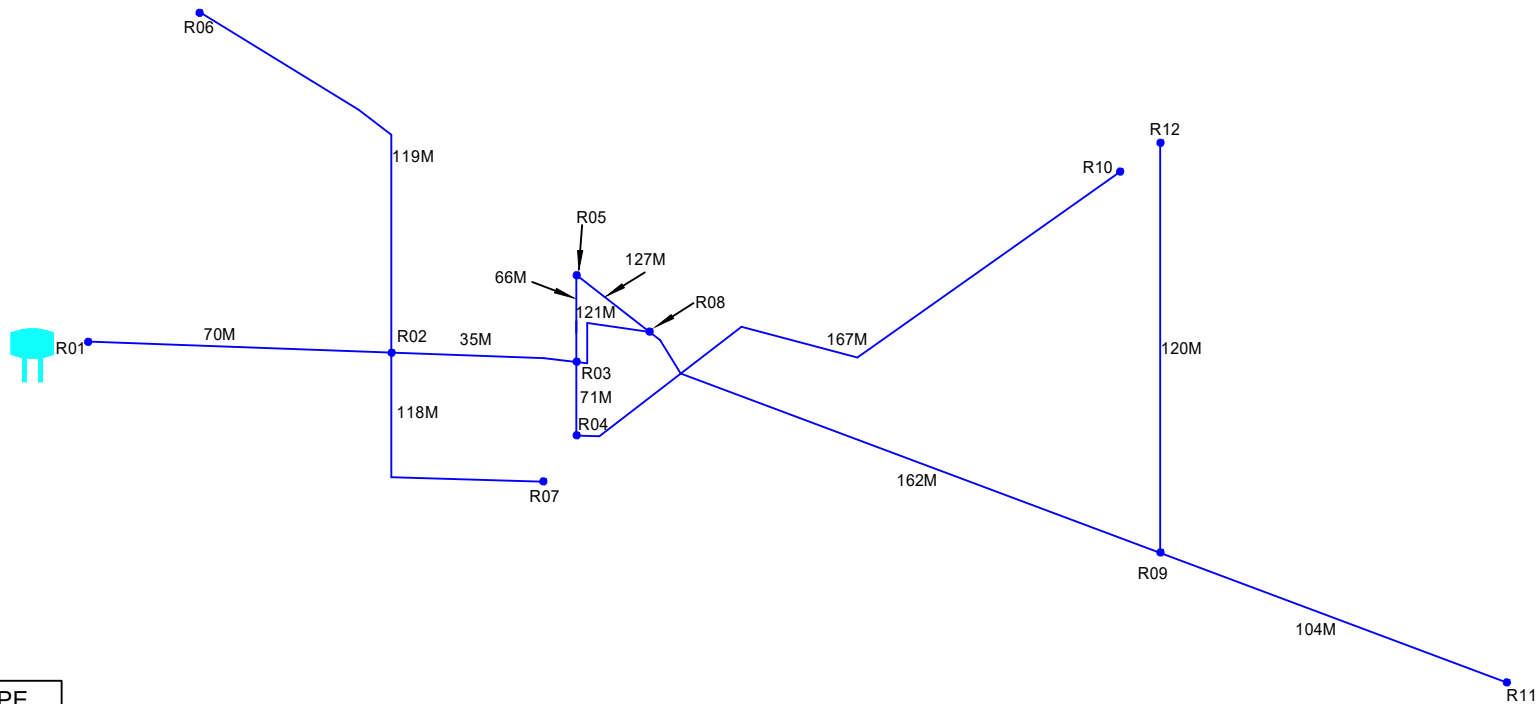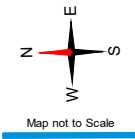CHANDRAYANPALLE

(MOMINPET MANDAL-VIKARABAD DIST.)

SINGLELINE LOOP DIAGRAM FOR CHANDRAYANPALLE OHSR1 (MOMINPET)





	DUCT PIPE
	ROAD
	OHSR
	G.P OFFICE
	TEMPLE
	HOSPITAL
	SCHOOL
	DUCT GAP

Sheet No. 01
Route Distance : 3261 M

Checked	Designation	Signature

DUCTLAYING ROUTE DIAGRAM FOR CHANDRAYANPALLE OHSR1 (MOMINPET)




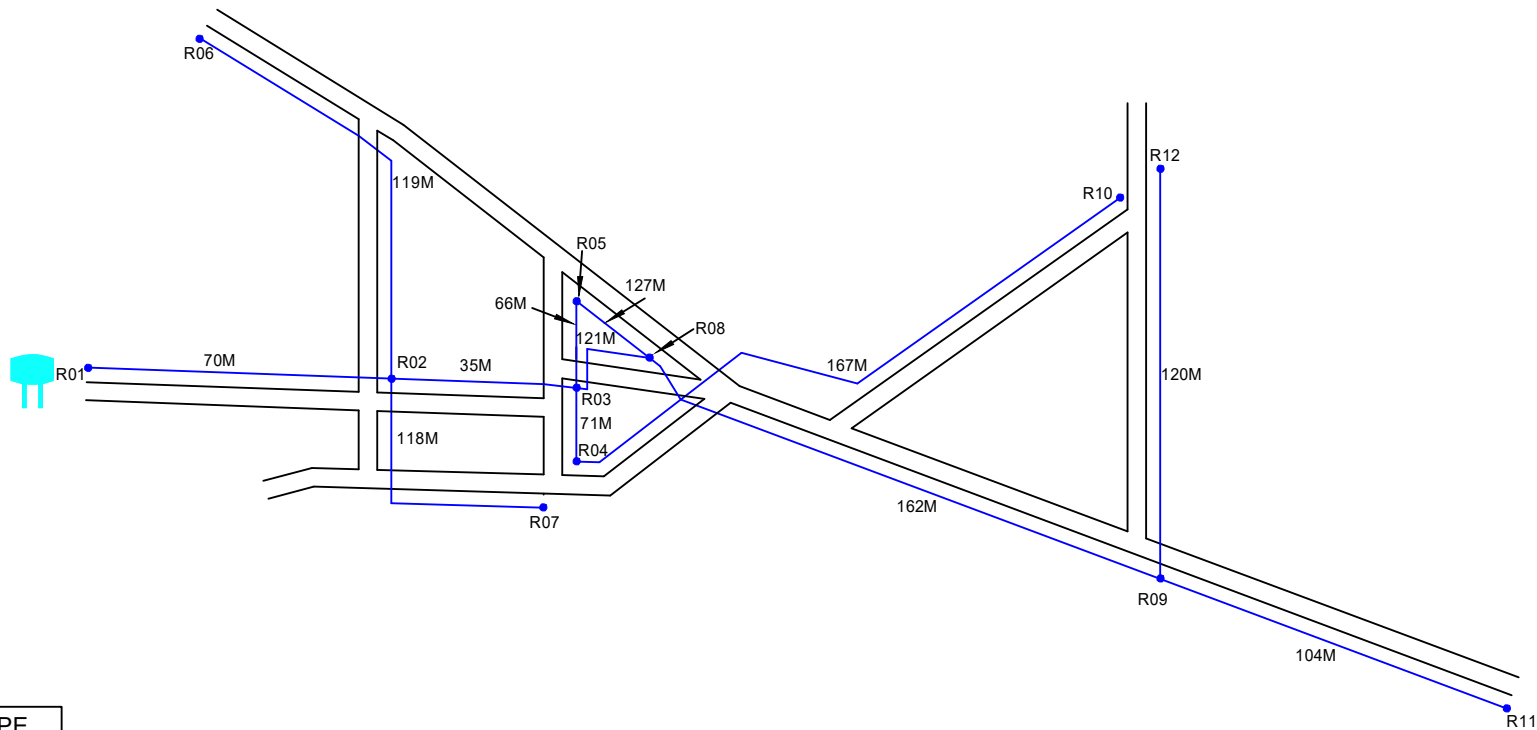
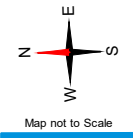


	DUCT PIPE
	ROAD
	OHSR
	G.P OFFICE
	TEMPLE
	HOSPITAL
	SCHOOL
	DUCT GAP

Sheet No. 01
Route Distance : 3261 M

Checked	Designation	Signature


ROAD OFFSET DETAILING FOR CHANDRAYANPALLE OHSR1 (MOMINPET)

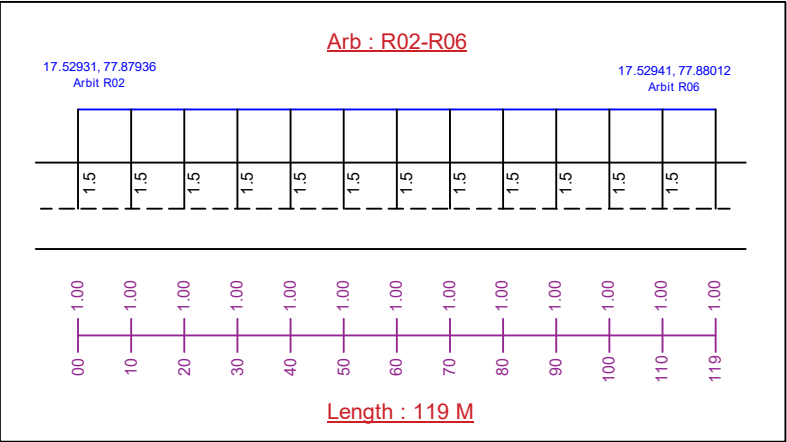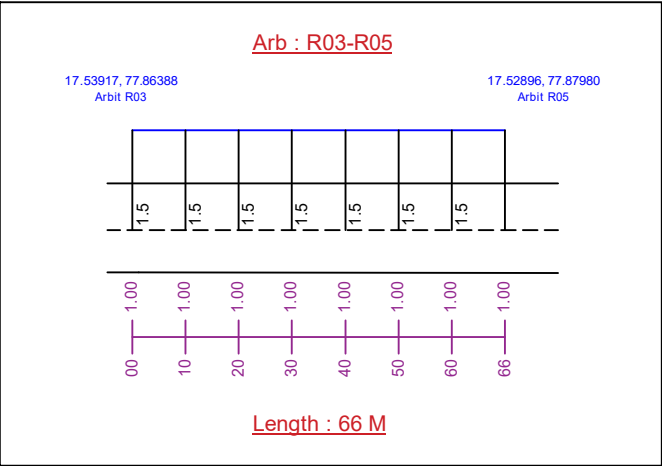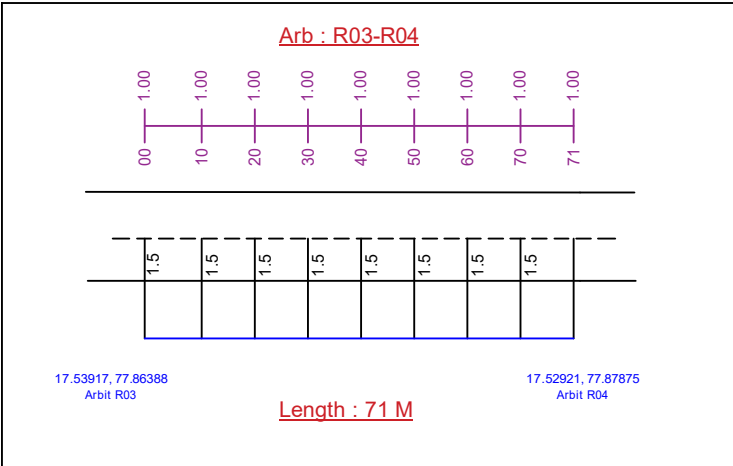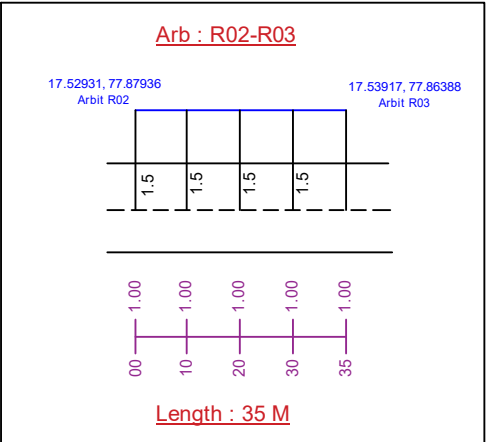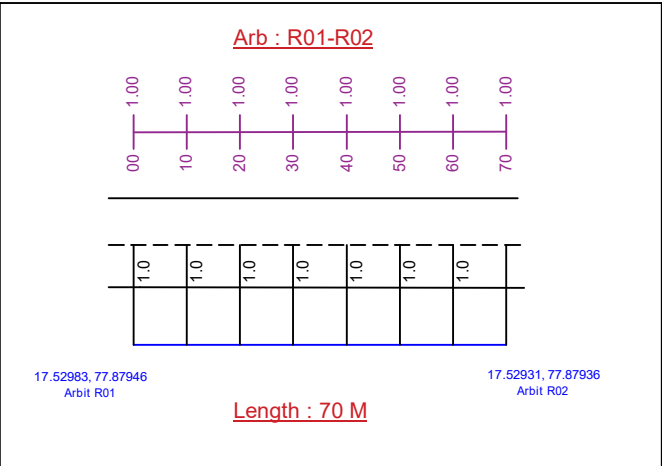


Checked	Designation	Signature

ROAD OFFSET DETAILING FOR CHANDRAYANPALLE OHSR1 (MOMINPET)


Arb : R02-R07

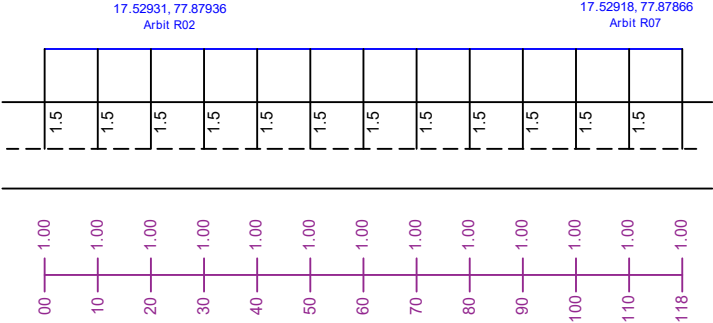


Arb : R05-R08

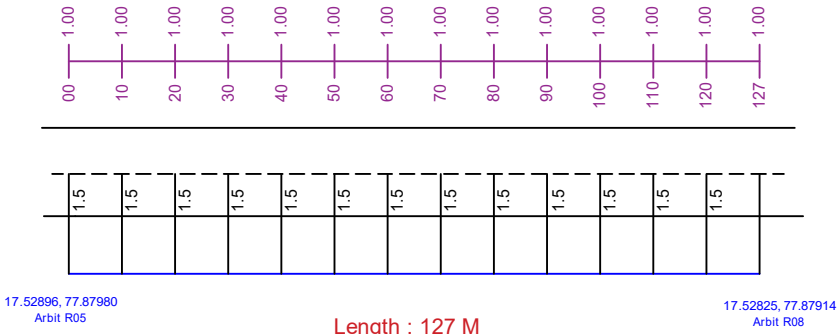

Arb : R03-R08

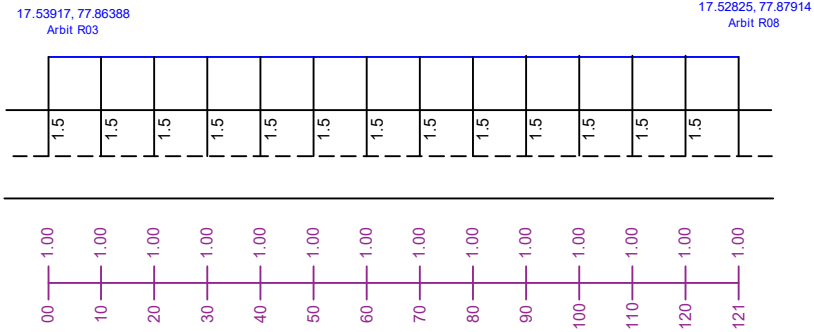



Arb : R04-R08

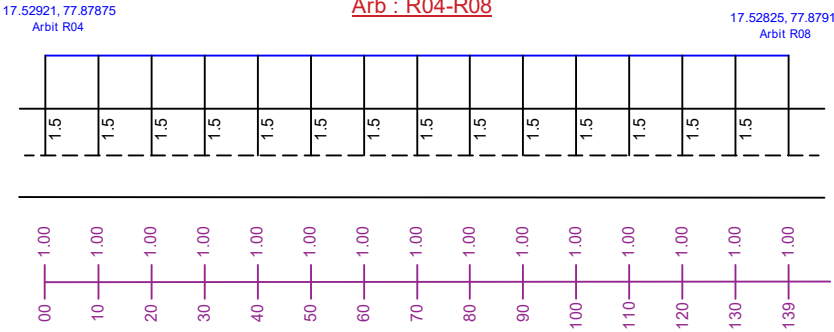

Sheet No. 02
Route Distance : 3261 M



Checked	Designation	Signature

ROAD OFFSET DETAILING FOR CHANDRAYANPALLE OHSR1 (MOMINPET)

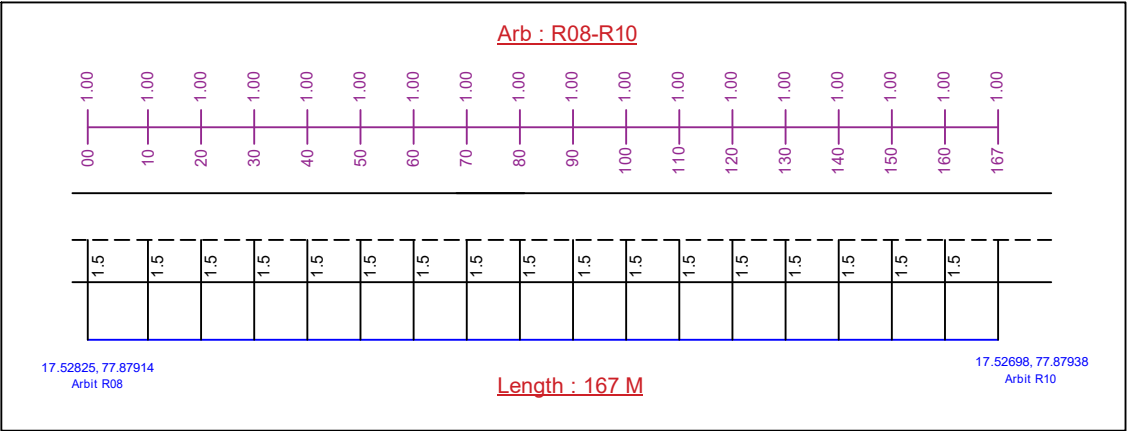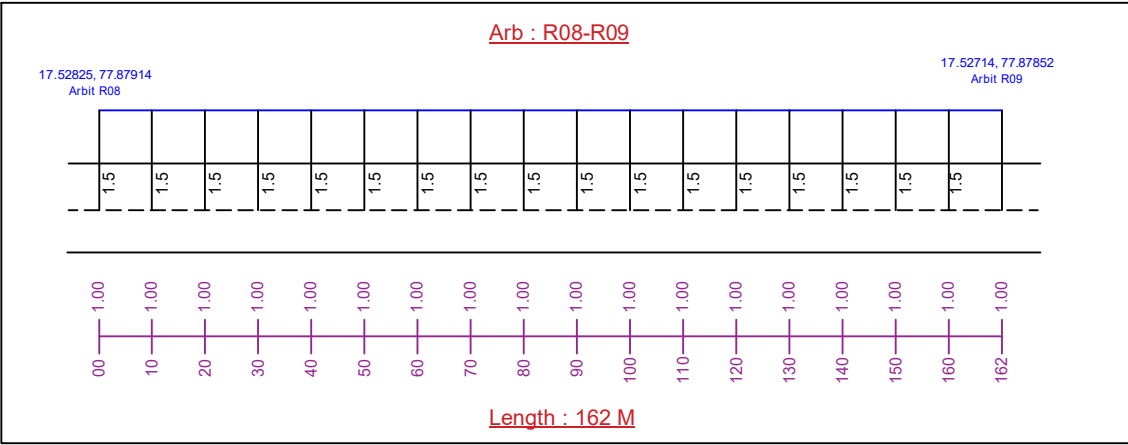



Checked	Designation	Signature



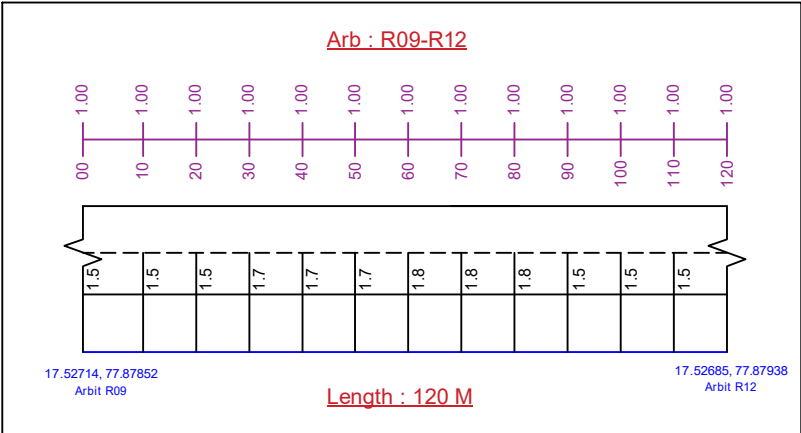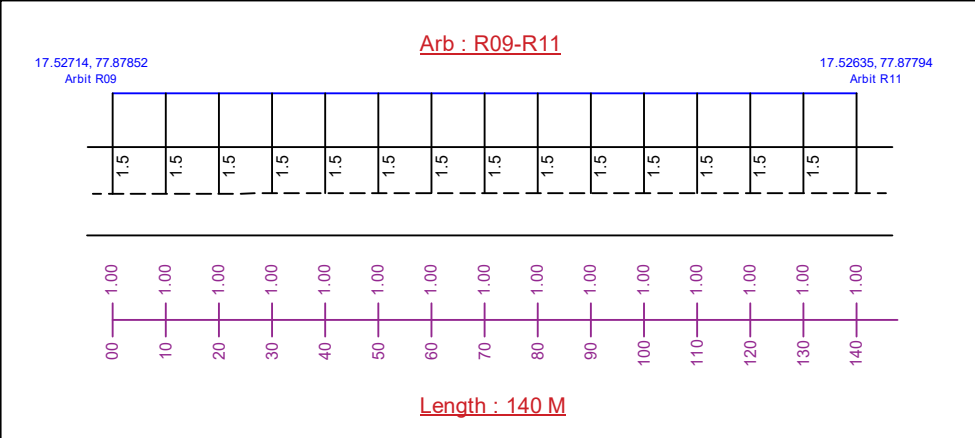



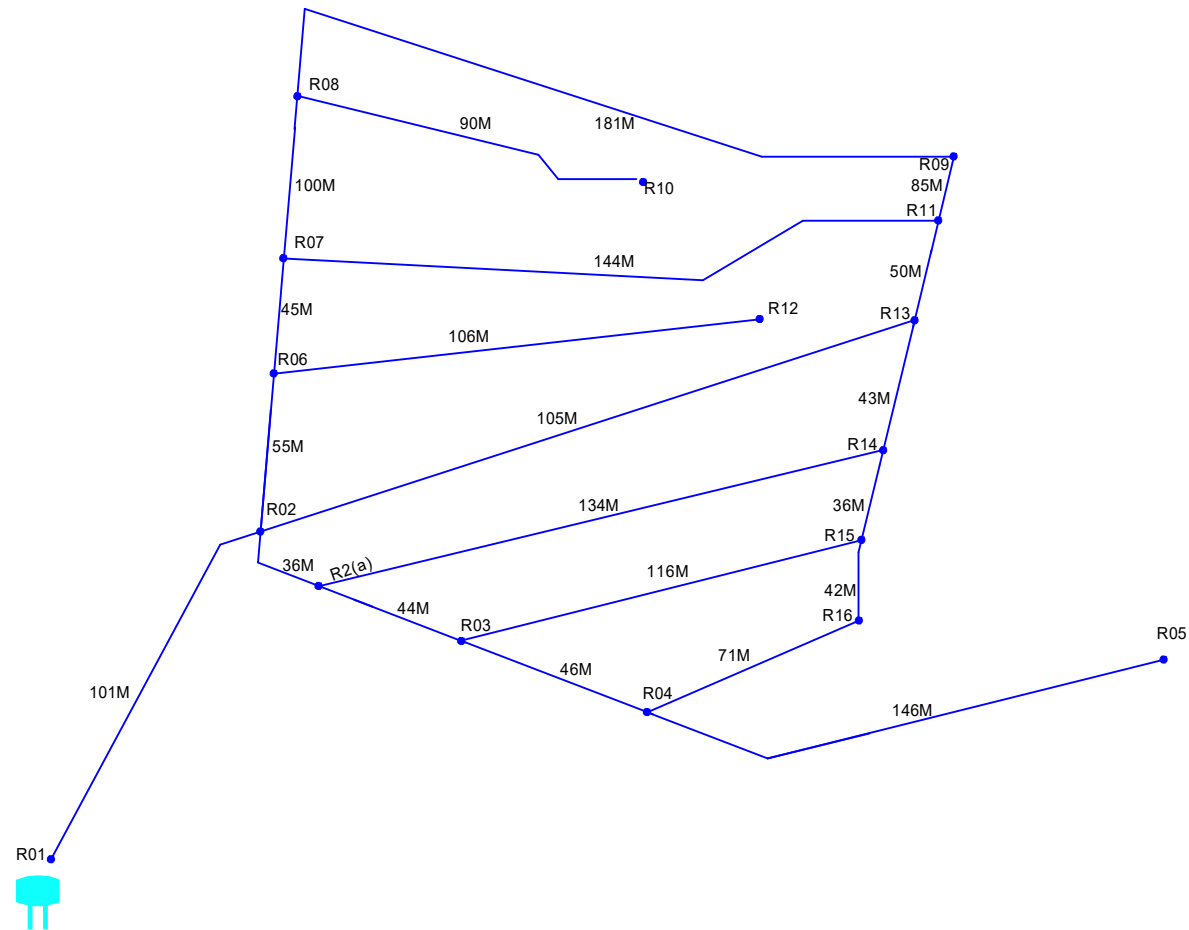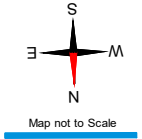

ROAD OFFSET DETAILING FOR CHANDRAYANPALLE OHSR1 (MOMINPET)



Checked	Designation	Signature

SINGLELINE LOOP DIAGRAM FOR CHANDRAYANPALLE OHSR2 (MOMINPET)






 






	DUCT PIPE
	ROAD
	OHSR
	G.P OFFICE
	TEMPLE
	HOSPITAL
	SCHOOL
	DUCT GAP

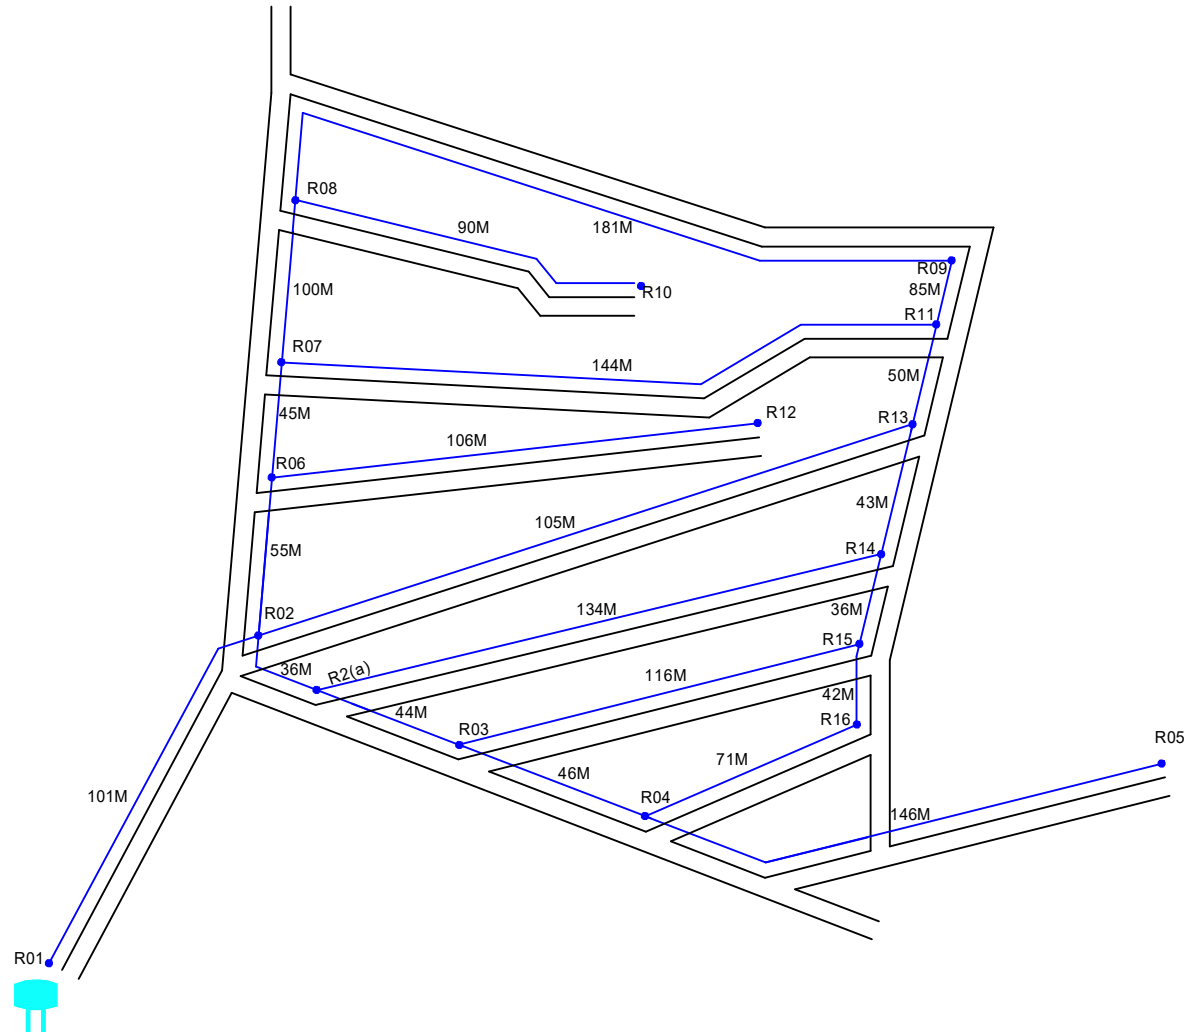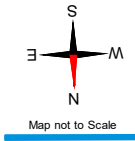Sheet No. 01
Route Distance : 3261 M

Checked	Designation	Signature

DUCTLAYING ROUTE DIAGRAM FOR CHANDRAYANPALLE OHSR2 (MOMINPET)








	DUCT PIPE
	ROAD
	OHSR
	G.P OFFICE
	TEMPLE
	HOSPITAL
	SCHOOL
	DUCT GAP

Sheet No. 01
Route Distance : 3261 M

Checked	Designation	Signature


ROAD OFFSET DETAILING FOR CHANDRAYANPALLE OHSR2 (MOMINPET)

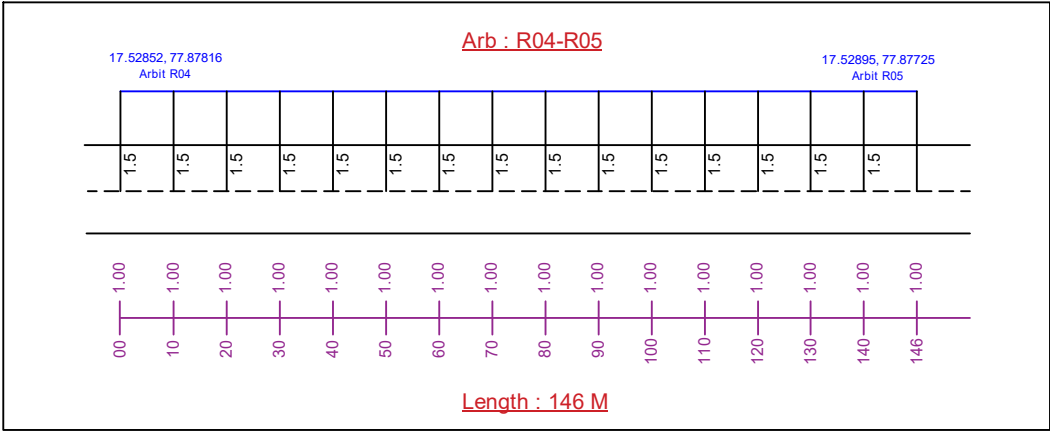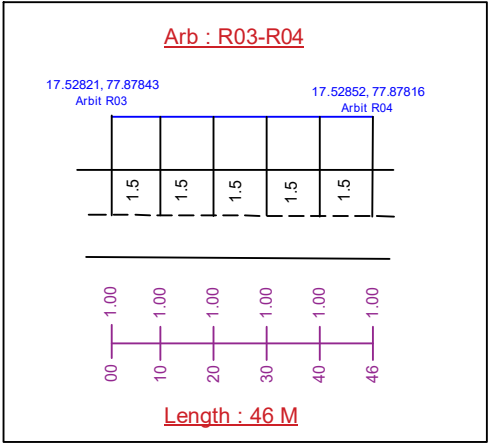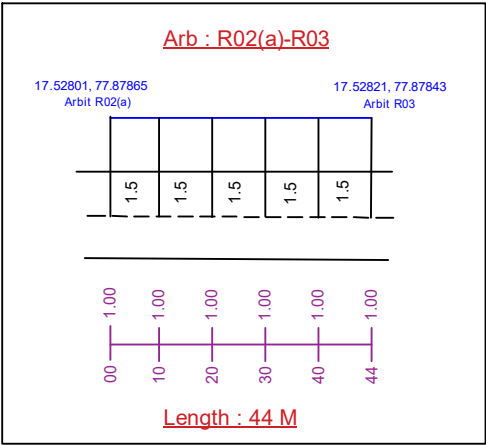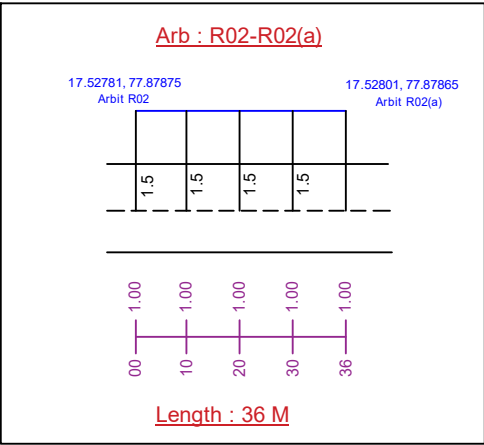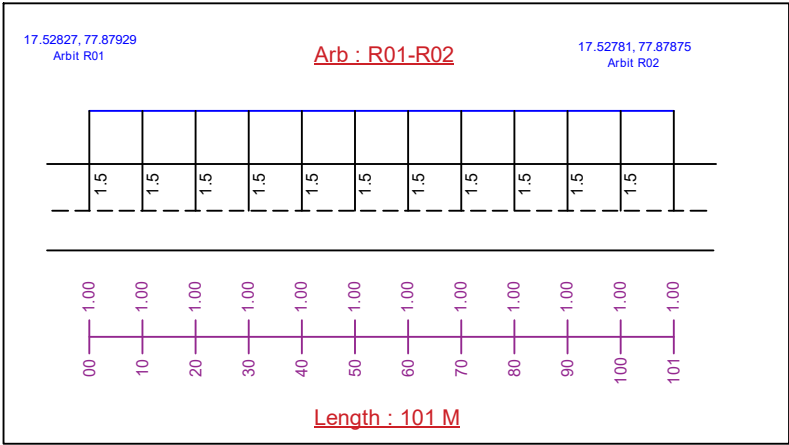

Checked	Designation	Signature

ROAD OFFSET DETAILING FOR CHANDRAYANPALLE OHSR2 (MOMINPET)

Arb : R02-R06

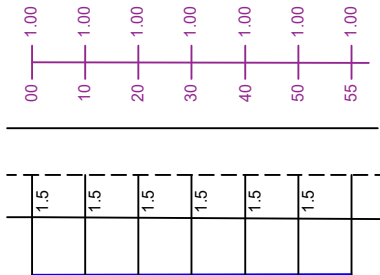


17.52781, 77.87875
Arbit R02

Length : 55 M

17.52747, 77.87853
Arbit R06

Arb : R06-R07

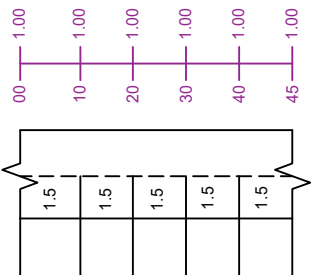


17.52747, 77.87853
Arbit R06

Length : 45 M

17.52718, 77.87845
Arbit R07

Arb : R07-R08

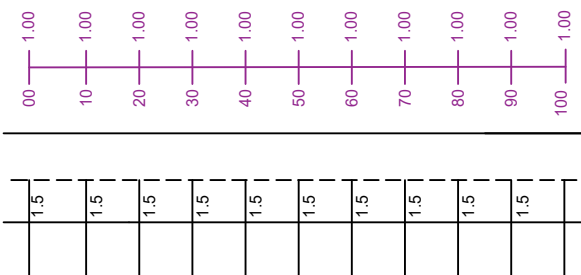


17.52718, 77.87845
Arbit R07

Length : 100 M

17.52662, 77.87805
Arbit R08

Arb : R08-R09

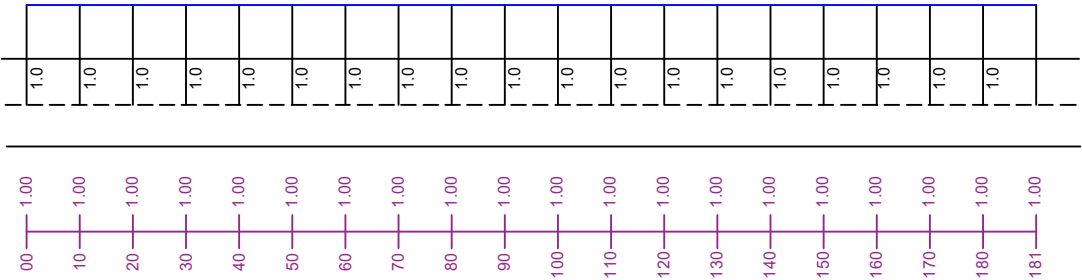





17.52662, 77.87805
Arbit R08

Length : 181 M

17.52682, 77.87715
Arbit R09






Checked	Designation	Signature

ROAD OFFSET DETAILING FOR CHANDRAYANPALLE OHSR2 (MOMINPET)

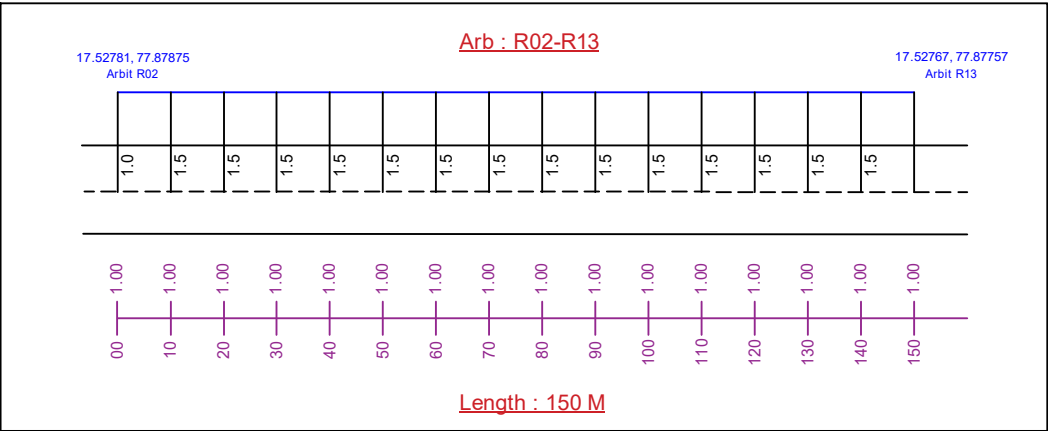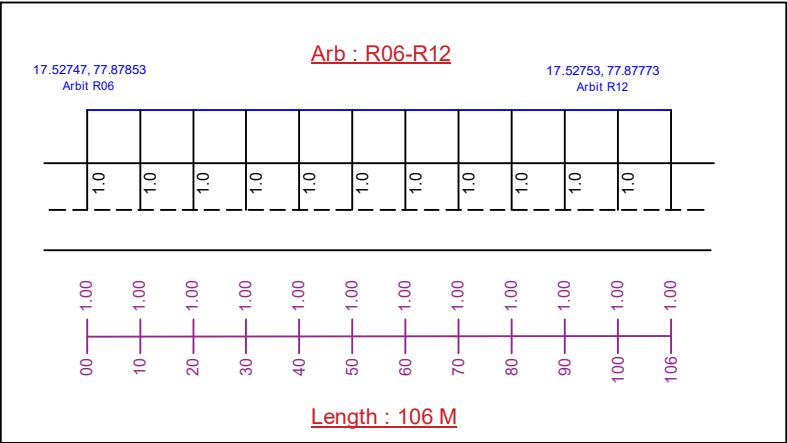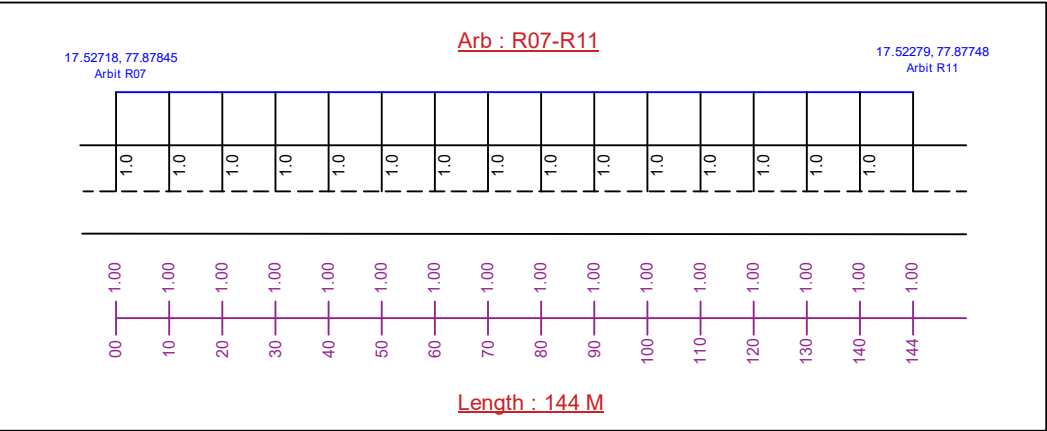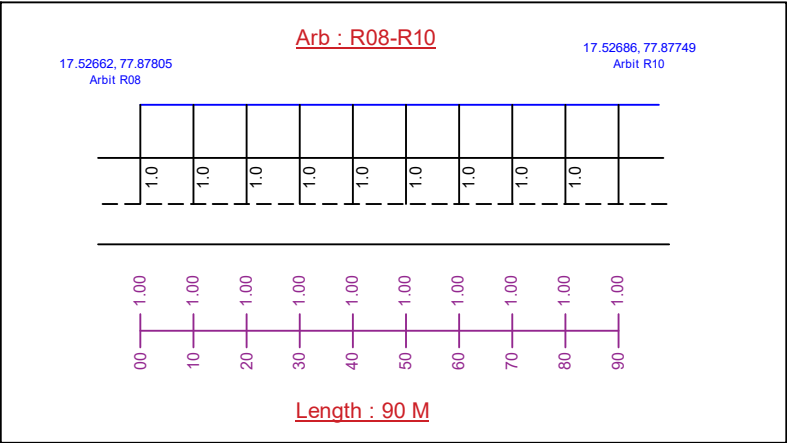




Checked	Designation	Signature

ROAD OFFSET DETAILING FOR CHANDRAYANPALLE OHSR2 (MOMINPET)

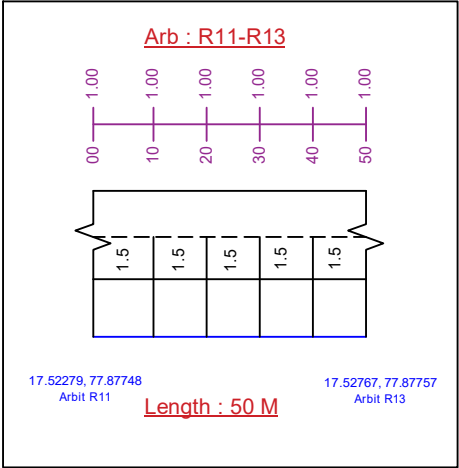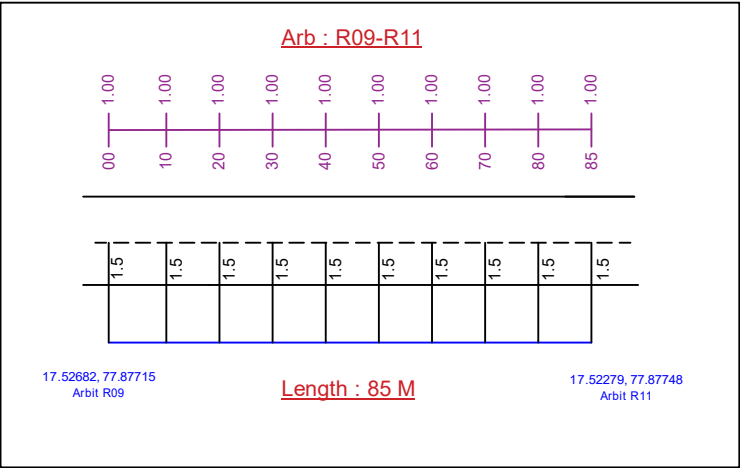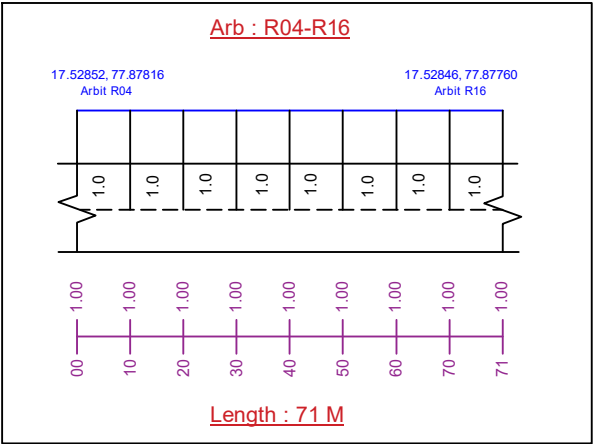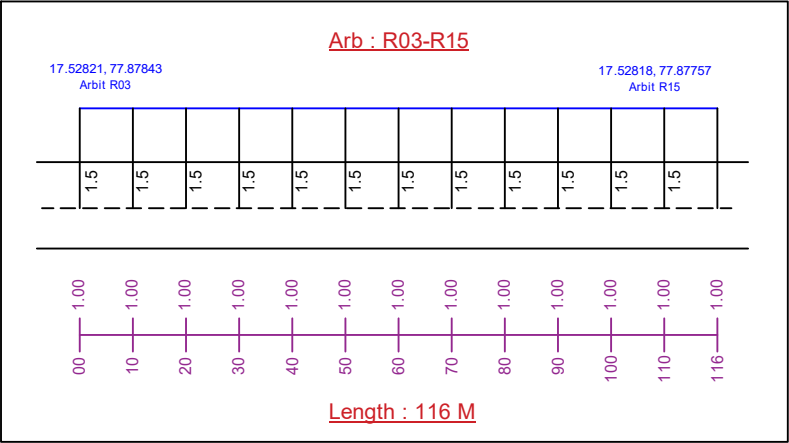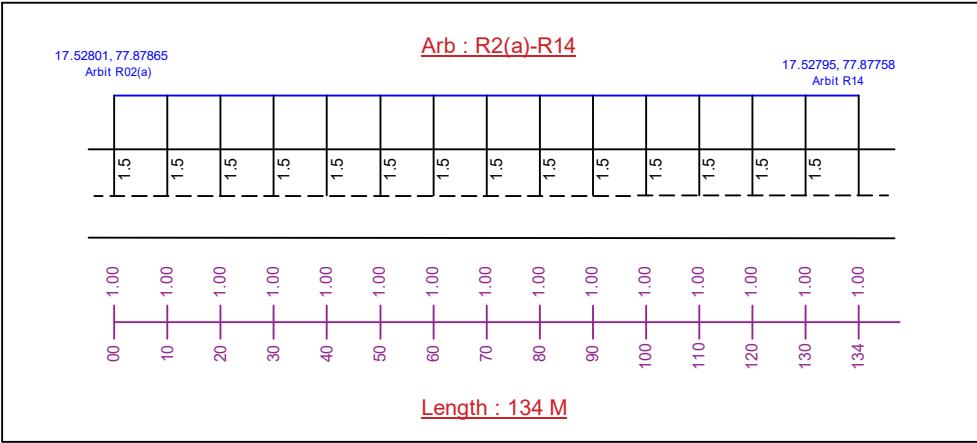

Checked	Designation	Signature

ROAD OFFSET DETAILING FOR CHANDRAYANPALLE OHSR2 (MOMINPET)

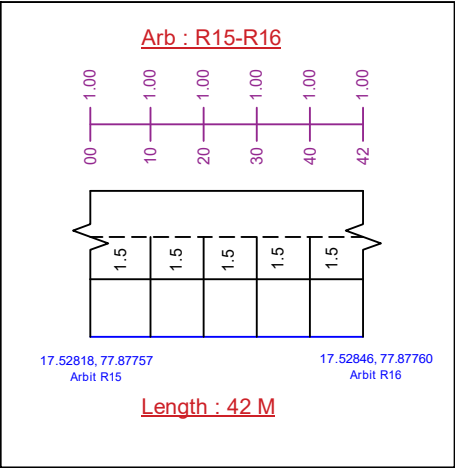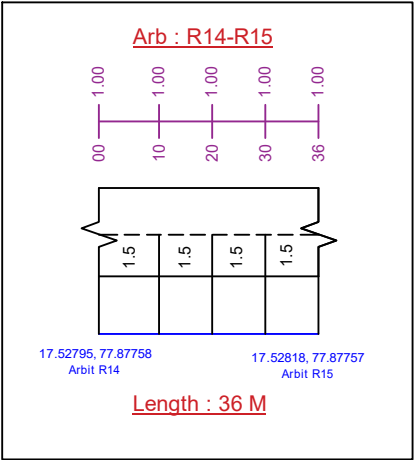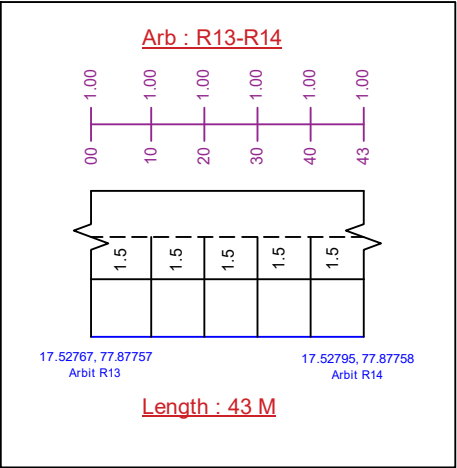

Checked	Designation	Signature



TELANGANA FIBER GRID

TELANGANA FIBER GRID

ITE & C GOVERNMENT OF TELANGANA

7th Floor, Splendid Towers, S.P. Road

Opp: Begumpet Police Station,



Begumpet, Hyderabad-500016.


 






AS - BUILT DRAWINGS (ABD)

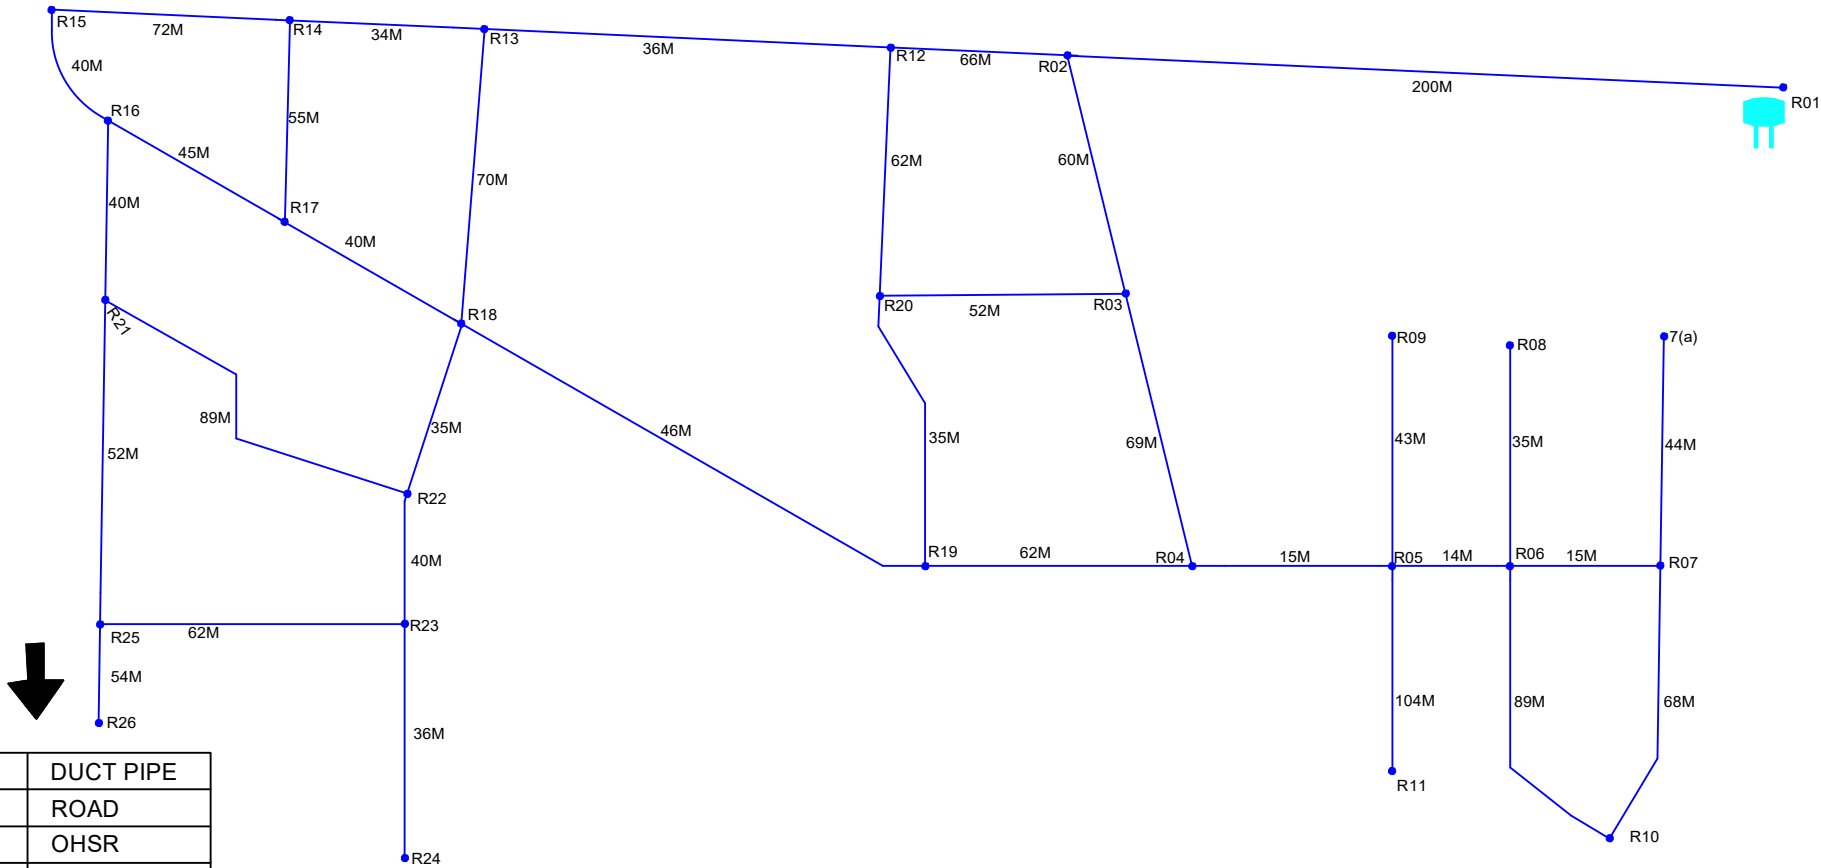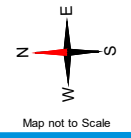CHEEMALADARI

(MOMINPET MANDAL-VIKARABAD DIST.)

SINGLELINE LOOP DIAGRAM FOR CHEEMALADARI OHSR1 (MOMINPET)





	DUCT PIPE
	ROAD
	OHSR
	G.P OFFICE
	TEMPLE
	HOSPITAL
	SCHOOL
	DUCT GAP

Sheet No. 01
Route Distance : 3430 M

Checked	Designation	Signature

DUCTLAYING ROUTE DIAGRAM FOR CHEEMALADARI OHSR1 (MOMINPET)

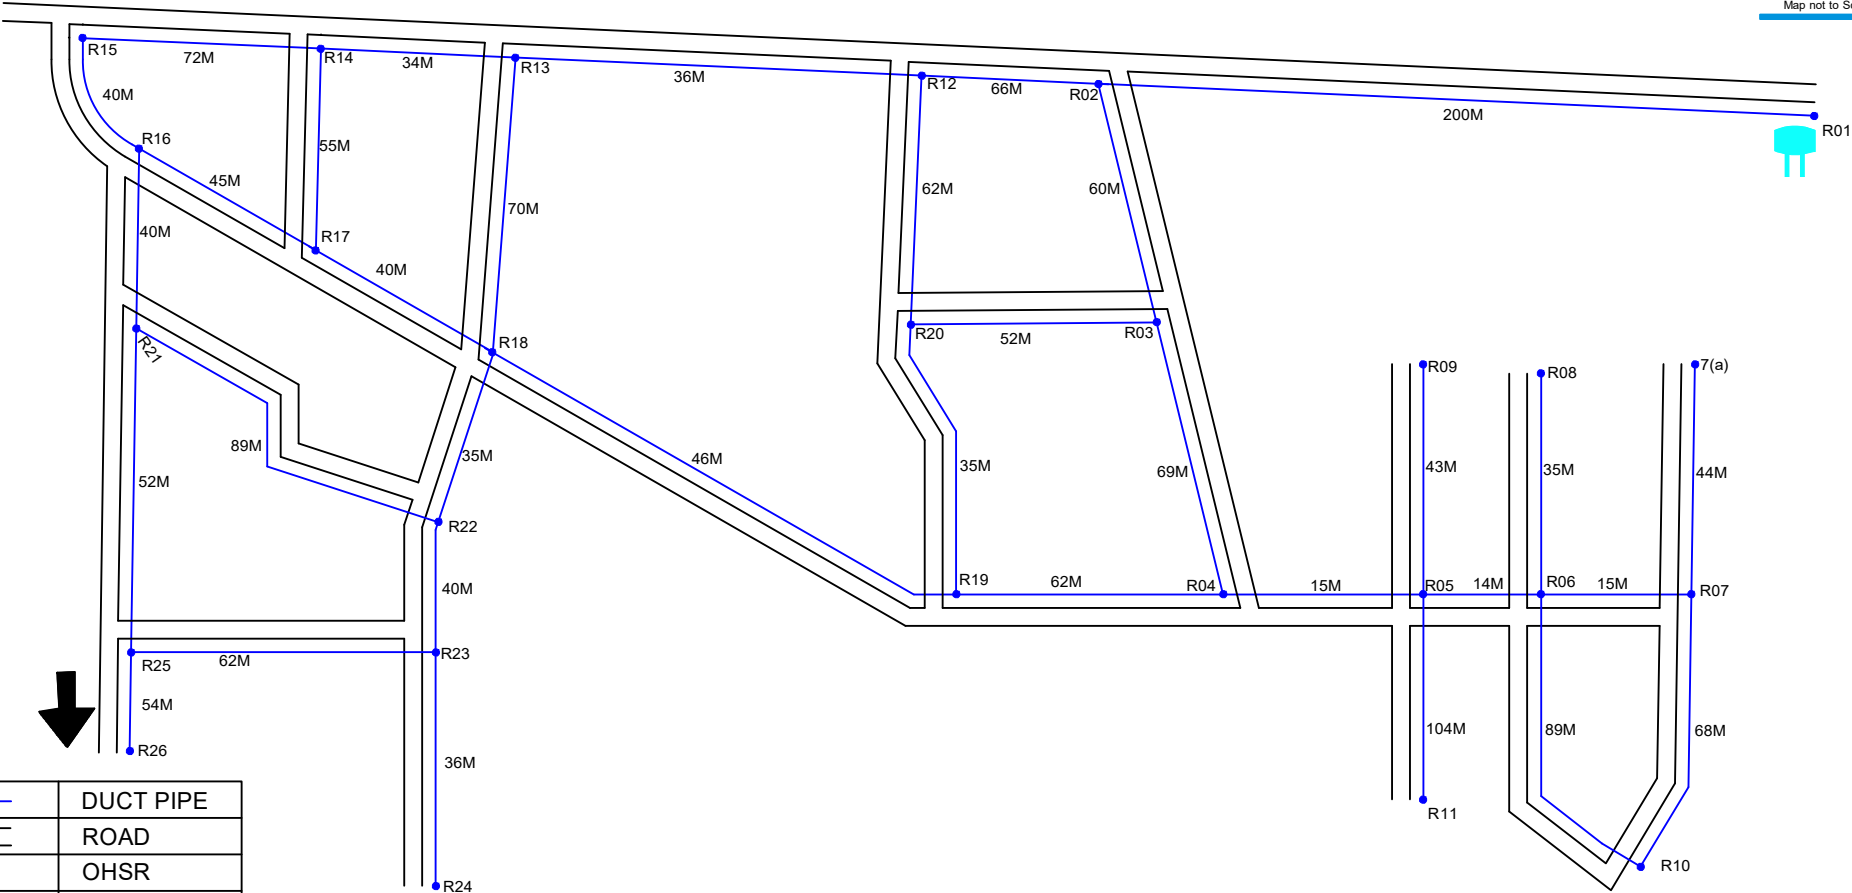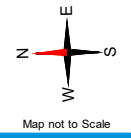


	DUCT PIPE
	ROAD
	OHSR
	G.P OFFICE
	TEMPLE
	HOSPITAL
	SCHOOL
	DUCT GAP

Sheet No. 01
Route Distance : 3430 M


Checked	Designation	Signature

ROAD OFFSET DETAILING FOR CHEEMALADARI OHSR1 (MOMINPET)


Arb : R01-R02

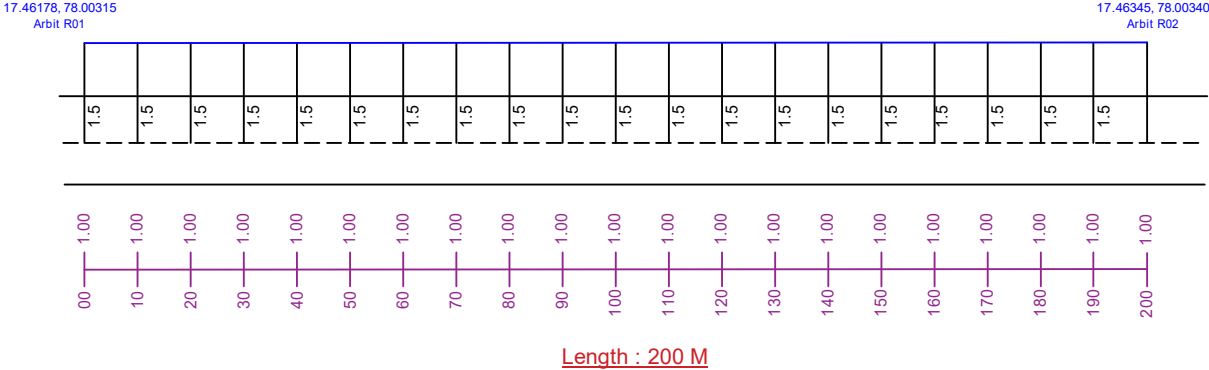


Arb : R02-R03

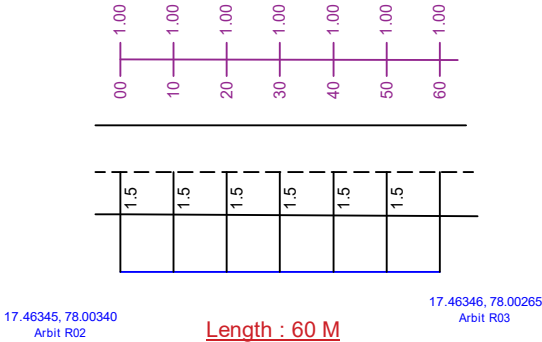


Arb : R03-R04

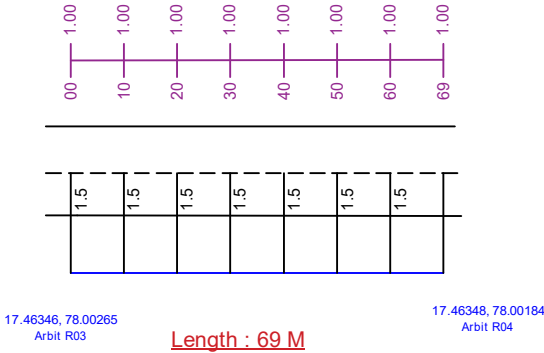


Arb : R04-R05

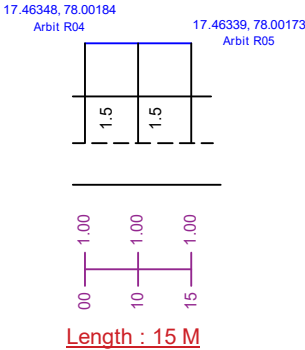

Arb : R05-R06

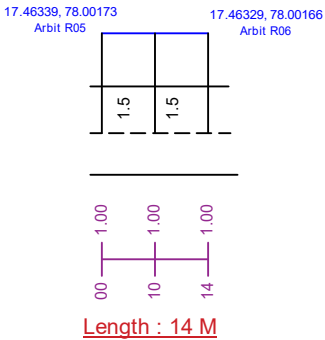


Arb : R06-R07

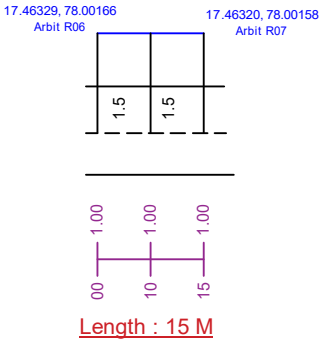


Checked	Designation	Signature

ROAD OFFSET DETAILING FOR CHEEMALADARI OHSR1 (MOMINPET)


Arb : R07-R7(a)

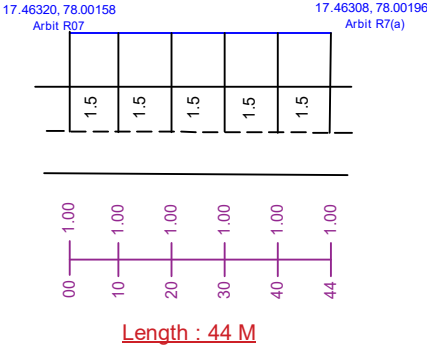


Arb : R06-R08

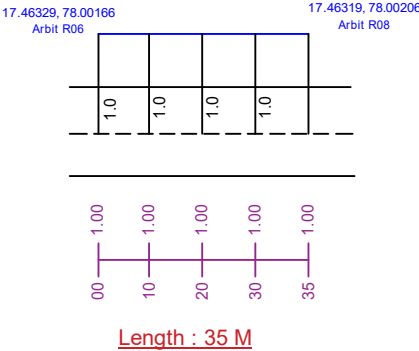


Arb : R05-R09

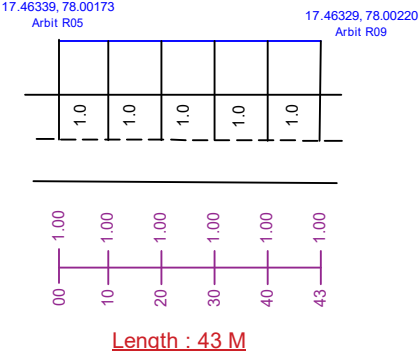

Arb : R07-R10





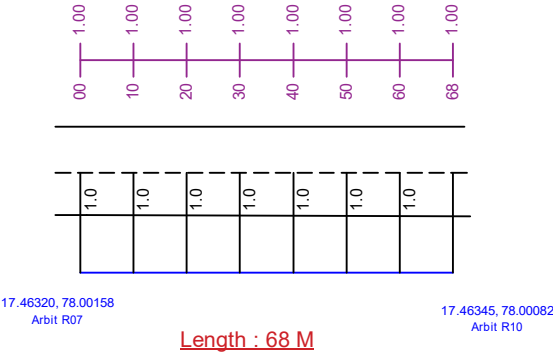


Arb : R06-R10

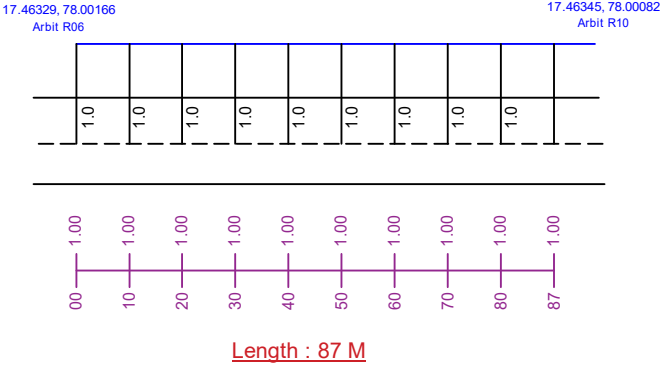

Checked	Designation	Signature

ROAD OFFSET DETAILING FOR CHEEMALADARI OHSR1 (MOMINPET)

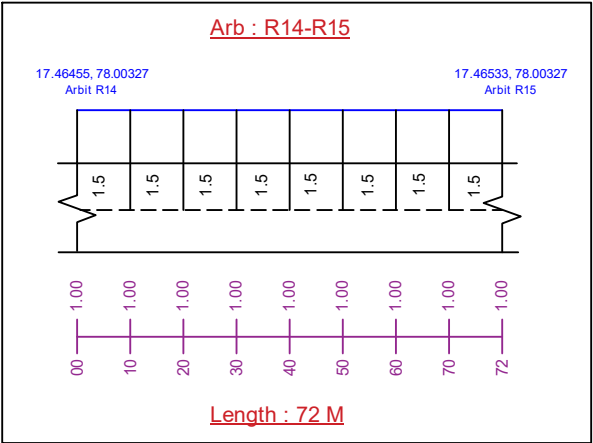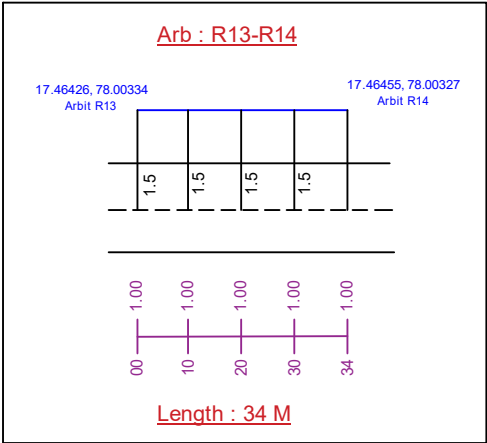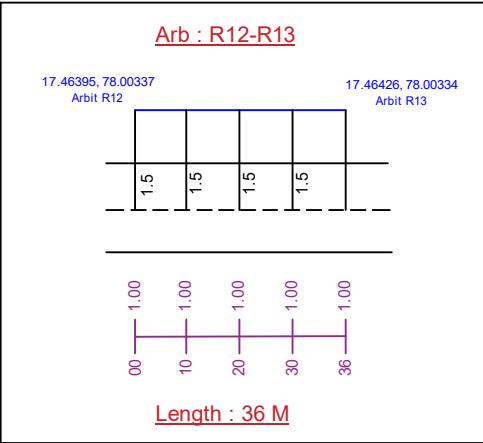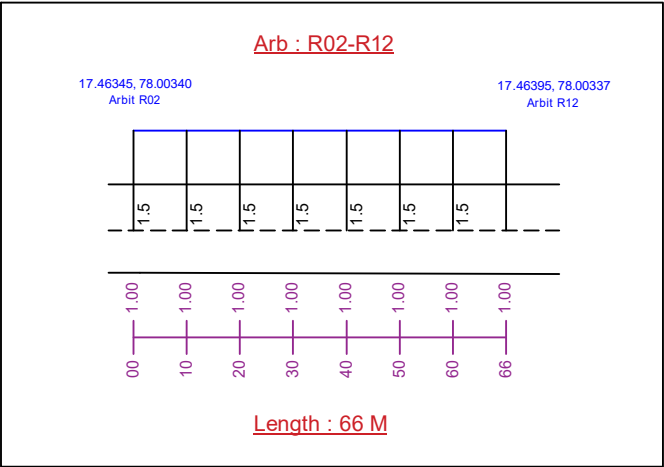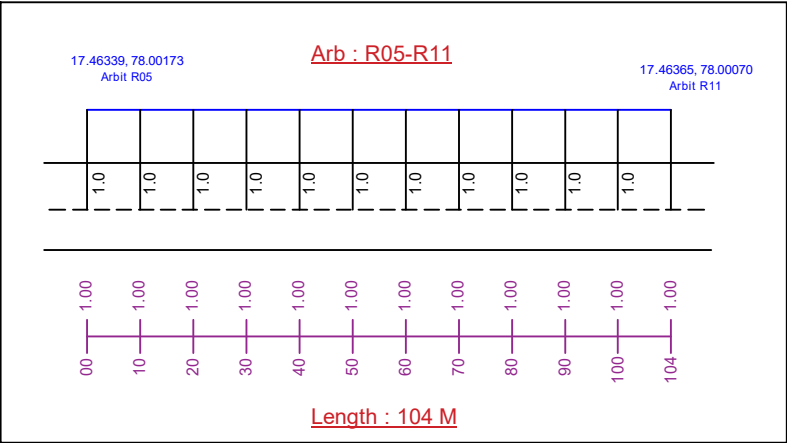


Checked	Designation	Signature

ROAD OFFSET DETAILING FOR CHEEMALADARI OHSR1 (MOMINPET)

Arb : R15-R16

17.46533, 78.00327
Arbit R15

17.46597, 78.00279
Arbit R16

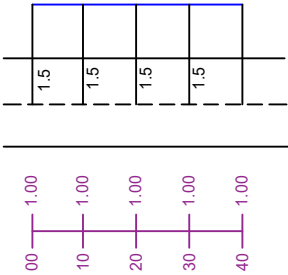


Length : 40 M

Arb : R16-R17

17.46597, 78.00279
Arbit R16

17.46464, 78.00279
Arbit R17

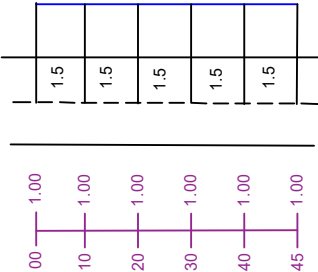


Length : 45 M

Arb : R17-R18

17.46464, 78.00279
Arbit R17

17.46439, 78.00252
Arbit R18

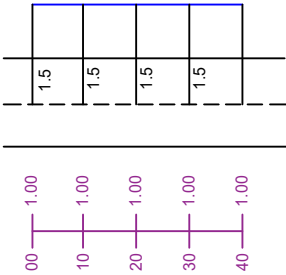


Length : 40 M

Arb : R18-R19

17.46439, 78.00252
Arbit R18

17.46404, 78.00230
Arbit R19

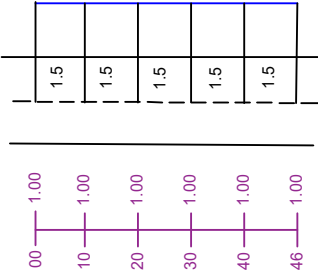


Length : 46 M

Arb : R19-R04

17.46404, 78.00230
Arbit R19

17.46348, 78.00184
Arbit R04

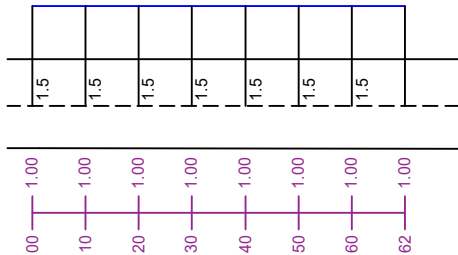


Length : 62 M

Arb : R03-R20

17.46346, 78.00265
Arbit R03

17.46399, 78.00262
Arbit R20

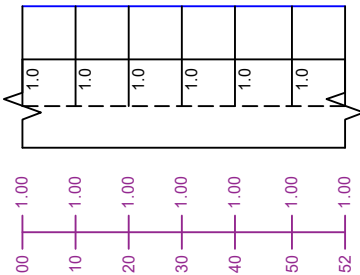


Length : 52 M


Checked	Designation	Signature

ROAD OFFSET DETAILING FOR CHEEMALADARI OHSR1 (MOMINPET)


Arb : R12-R20

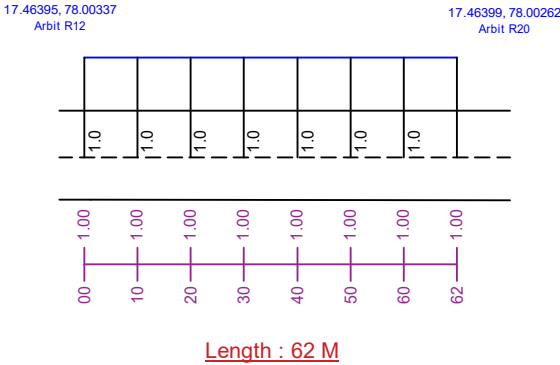


Arb : R20-R19

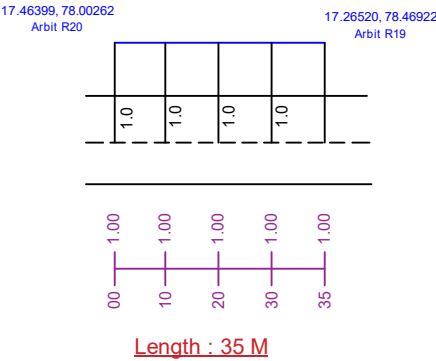


Arb : R13-R18

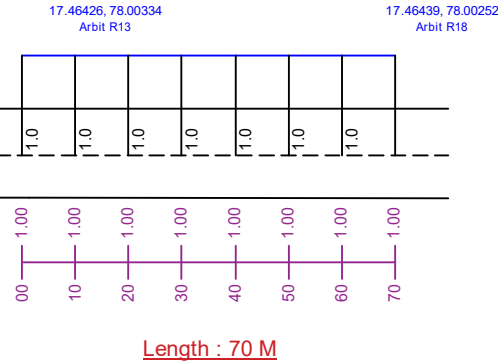


Arb : R14-R17

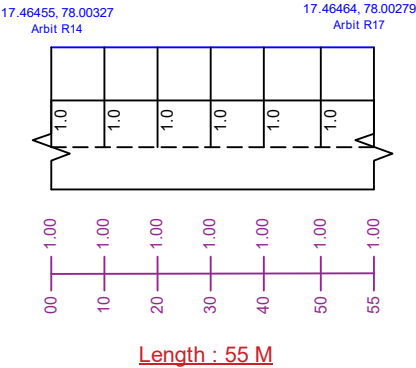

Arb : R16-R21

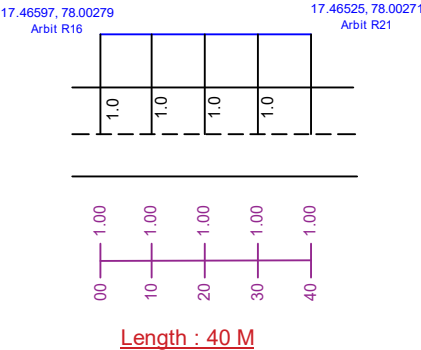


Arb : R18-R22

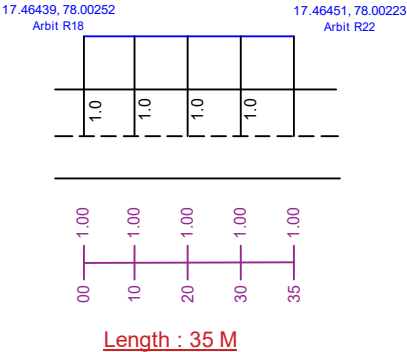


Checked	Designation	Signature

ROAD OFFSET DETAILING FOR CHEEMALADARI OHSR1 (MOMINPET)


Arb : R21-R22

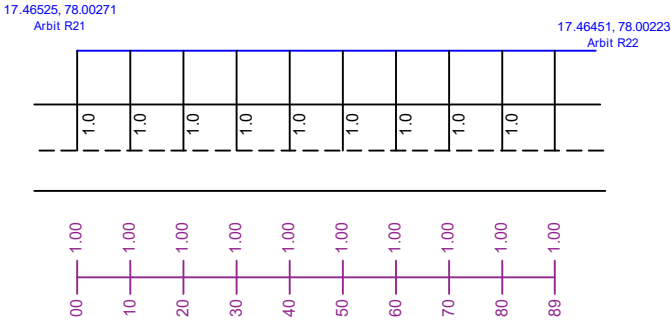


Arb : R22-R23

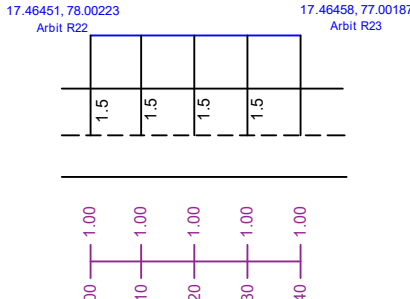


Arb : R23-R24

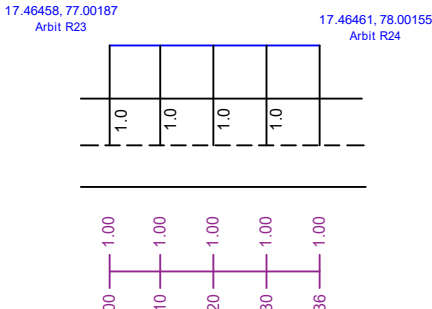


Arb : R21-R25

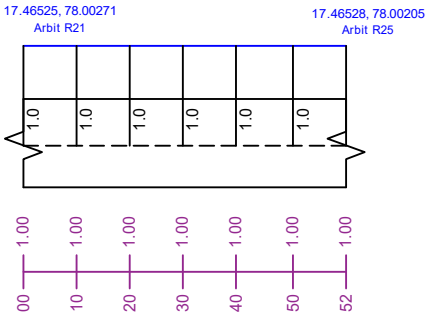

Arb : R23-R25


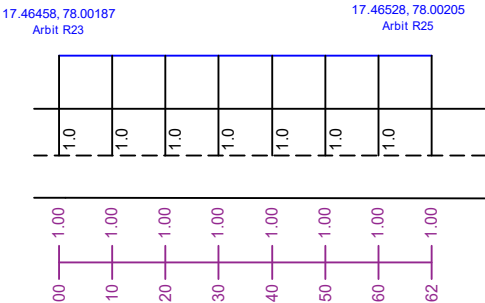


Arb : R25-R26

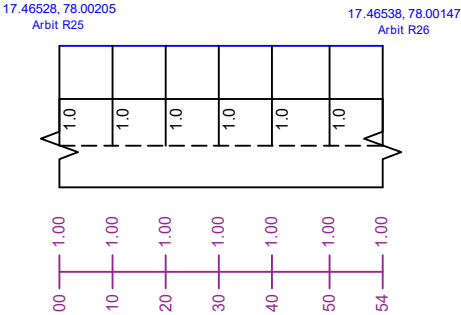

Checked	Designation	Signature

SINGLELINE LOOP DIAGRAM FOR CHEEMALADARI OHSR2 (MOMINPET)

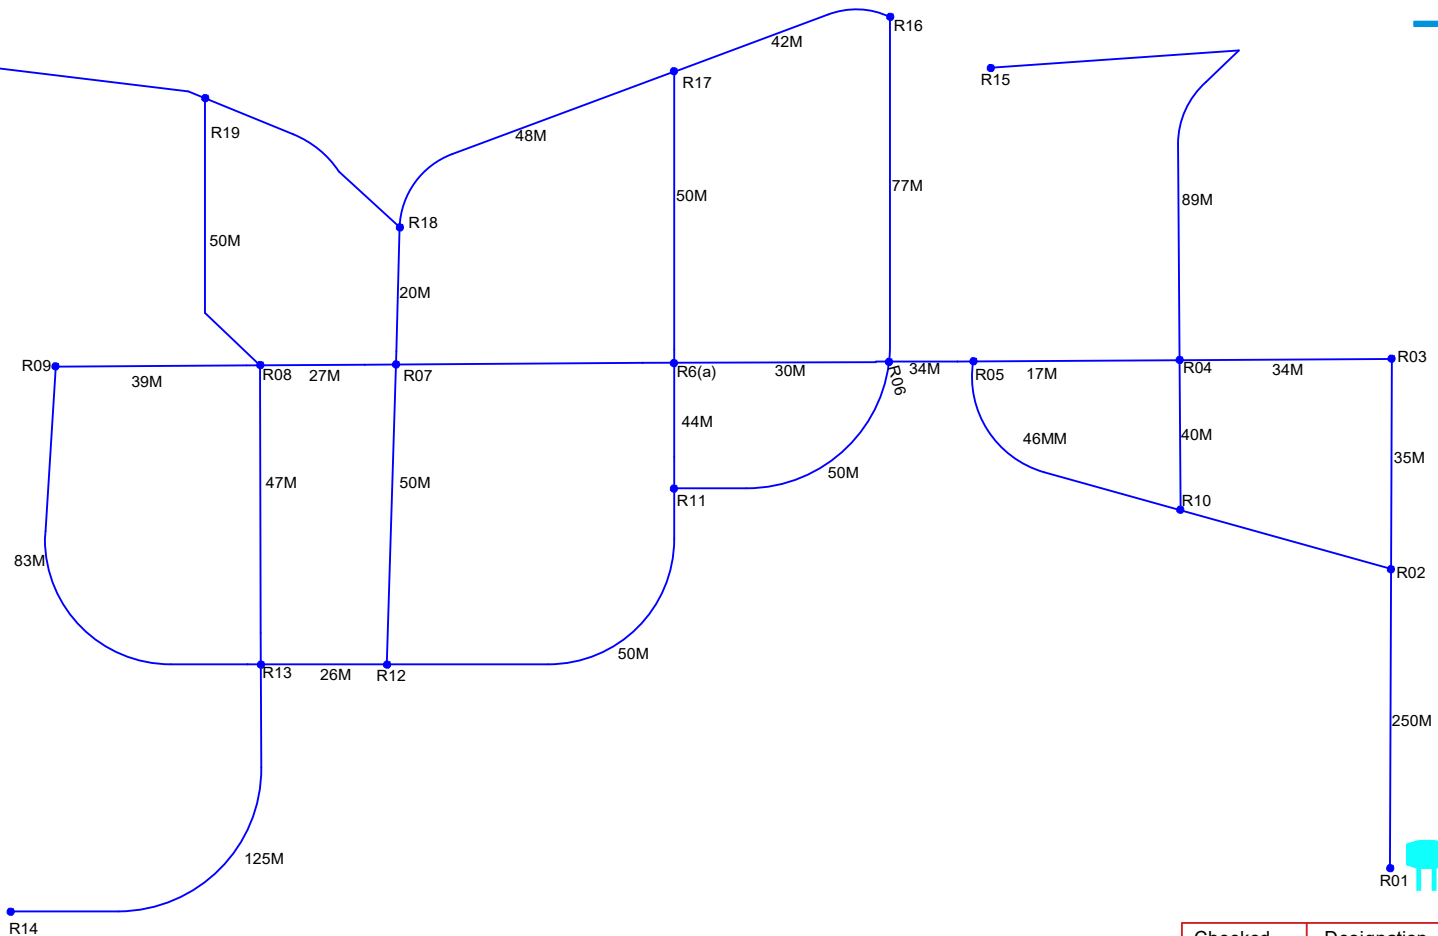
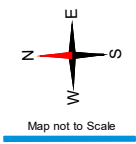



 






	DUCT PIPE
	ROAD
	OHSR
	G.P OFFICE
	TEMPLE
	HOSPITAL
	SCHOOL
	DUCT GAP

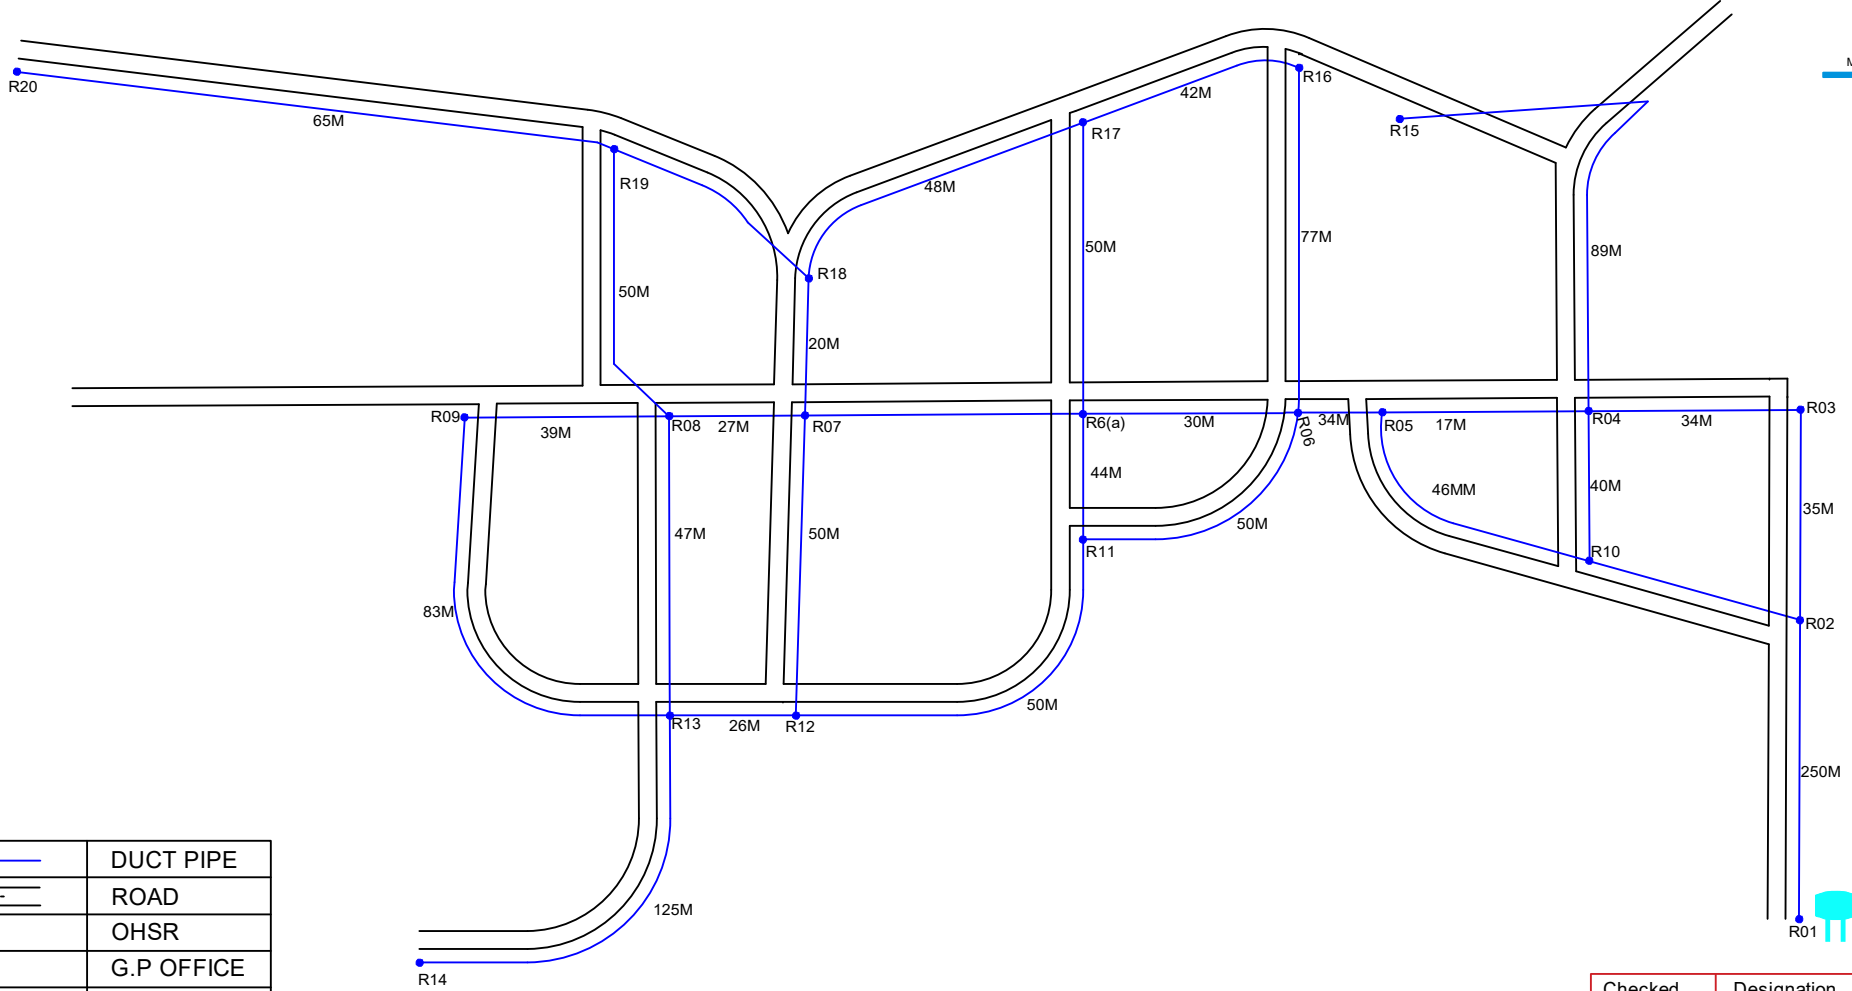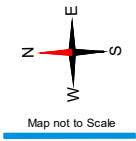Sheet No. 01
Route Distance : 3430 M

Checked	Designation	Signature

DUCTLAYING ROUTE DIAGRAM FOR CHEEMALADARI OHSR2 (MOMINPET)




	DUCT PIPE
	ROAD
	OHSR
	G.P OFFICE
	TEMPLE
	HOSPITAL
	SCHOOL
	DUCT GAP

Sheet No. 01
Route Distance : 3430 M


Checked	Designation	Signature

ROAD OFFSET DETAILING FOR CHEEMALADARI OHSR2 (MOMINPET)


Arb : R01-R02

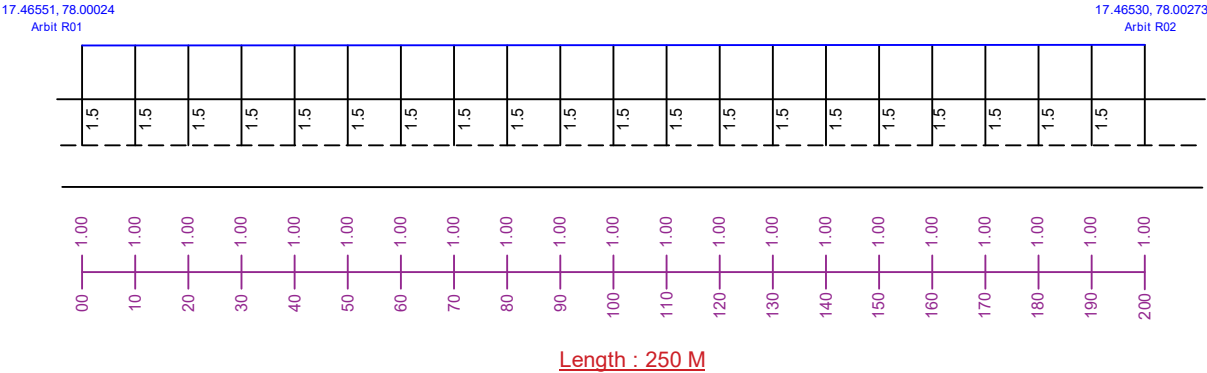


Arb : R01-R02

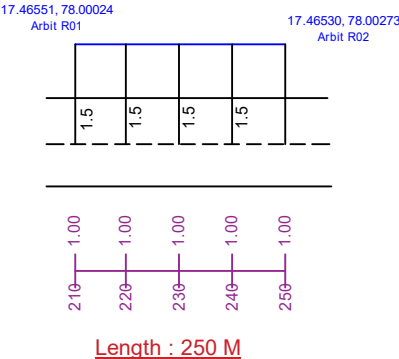


Arb : R02-R03

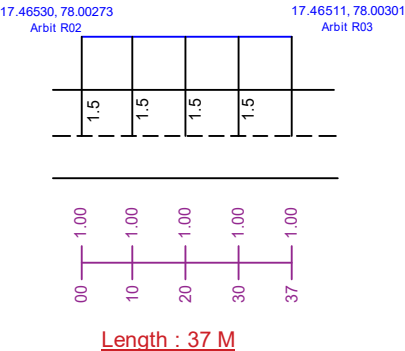


Arb : R03-R04

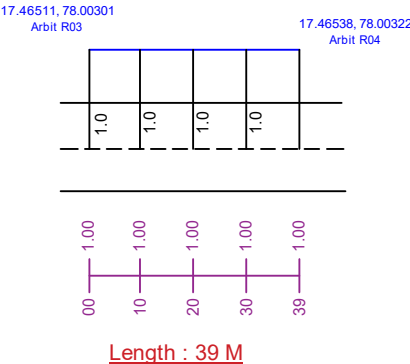

Arb : R04-R05

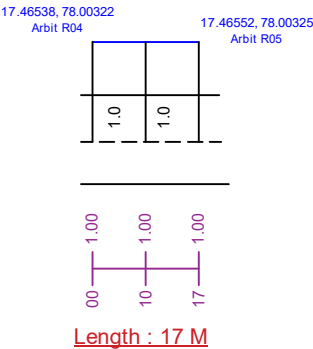


Arb : R05-R06

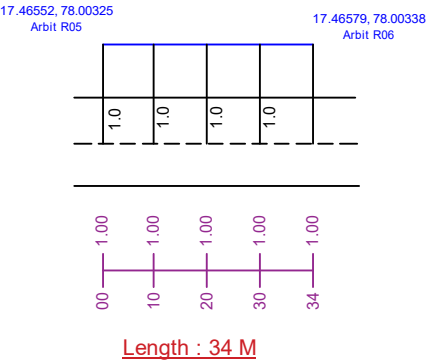


Checked	Designation	Signature

ROAD OFFSET DETAILING FOR CHEEMALADARI OHSR2 (MOMINPET)


Arb : R06-R6(a)

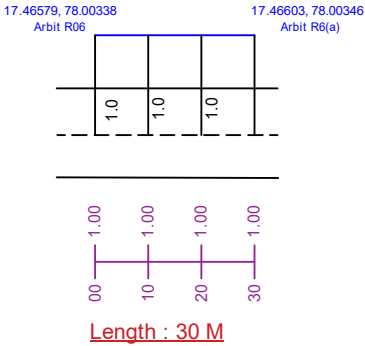


Arb : R6(a)-R07

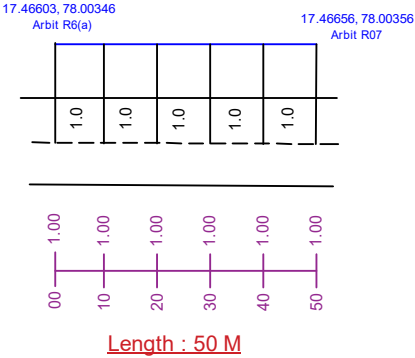


Arb : R07-R08

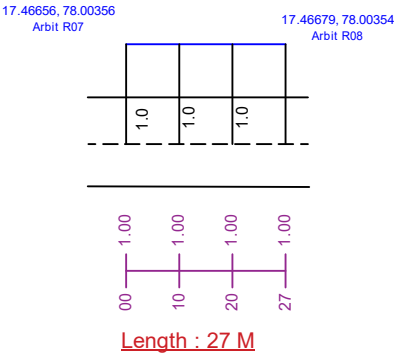


Arb : R08-R09

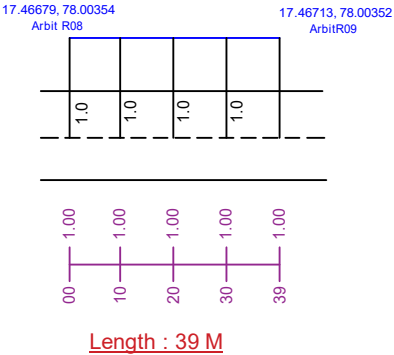


Arb : R02-R10

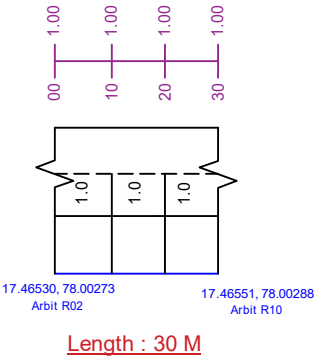

Arb : R04-R10

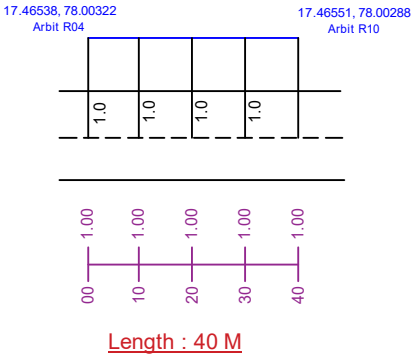


Arb : R05-R10

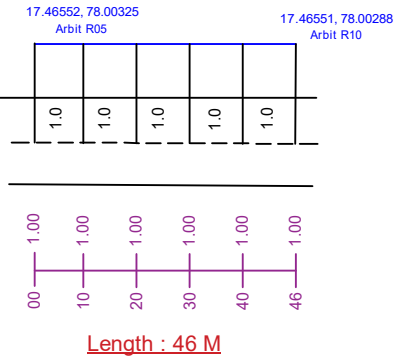


Checked	Designation	Signature

ROAD OFFSET DETAILING FOR CHEEMALADARI OHSR2 (MOMINPET)


Arb : R11-R12

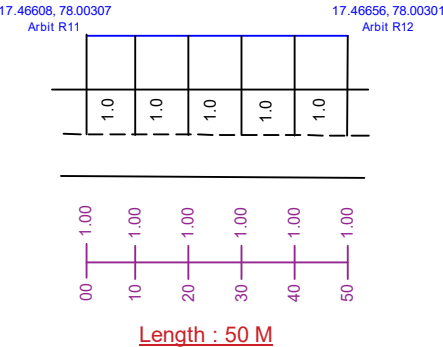


Arb : R07-R12

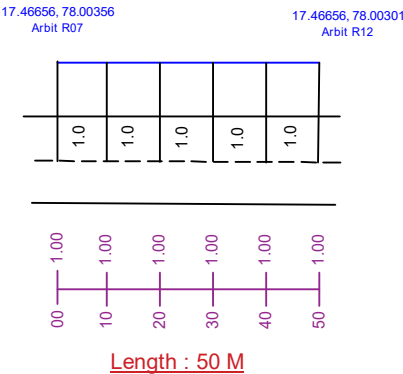


Arb : R12-R13

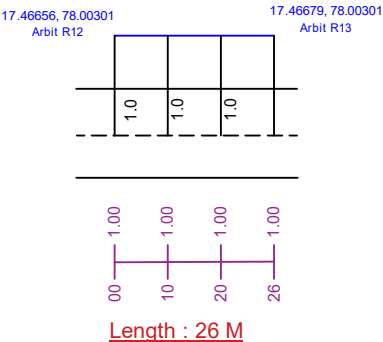

Arb : R08-R13






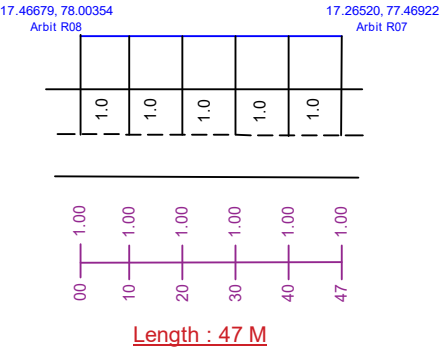


Arb : R13-R14

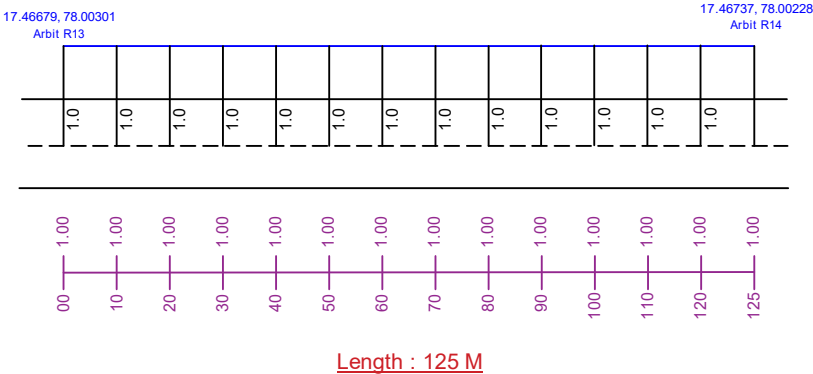

Checked	Designation	Signature

ROAD OFFSET DETAILING FOR CHEEMALADARI OHSR2 (MOMINPET)

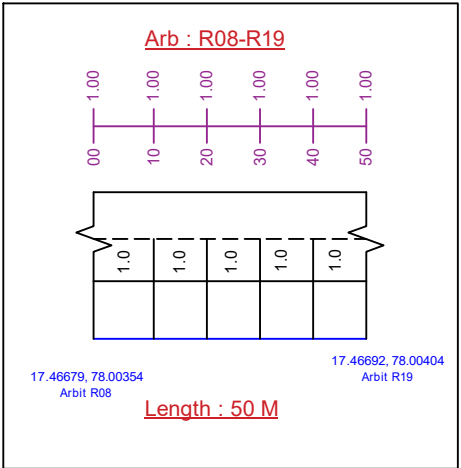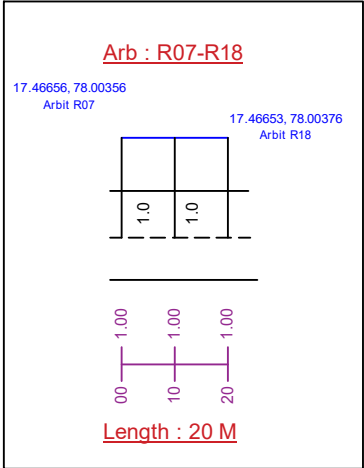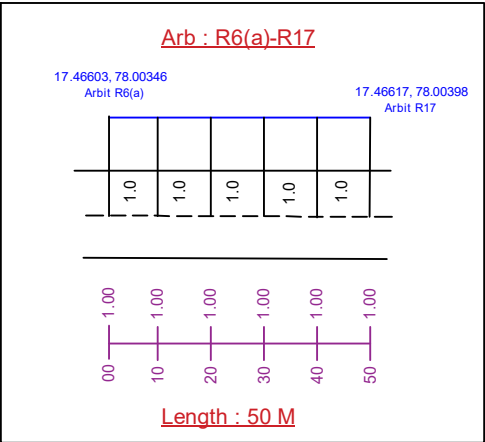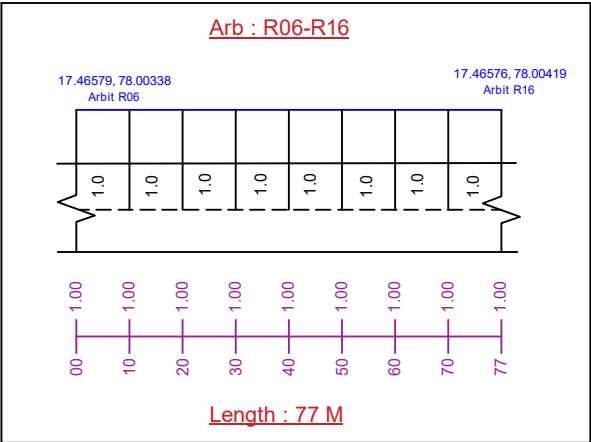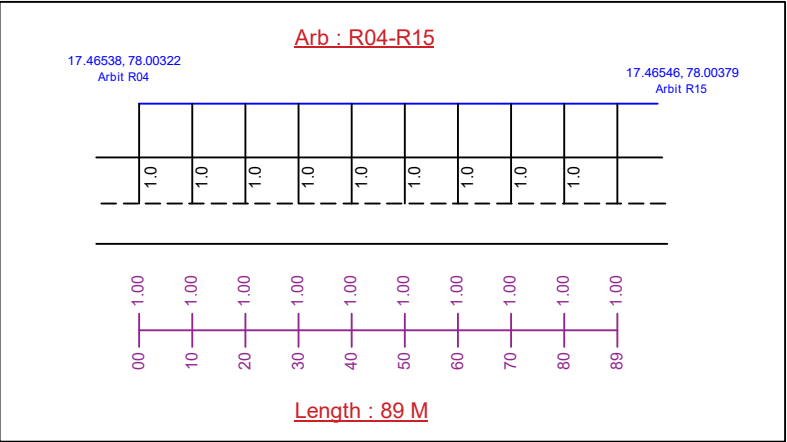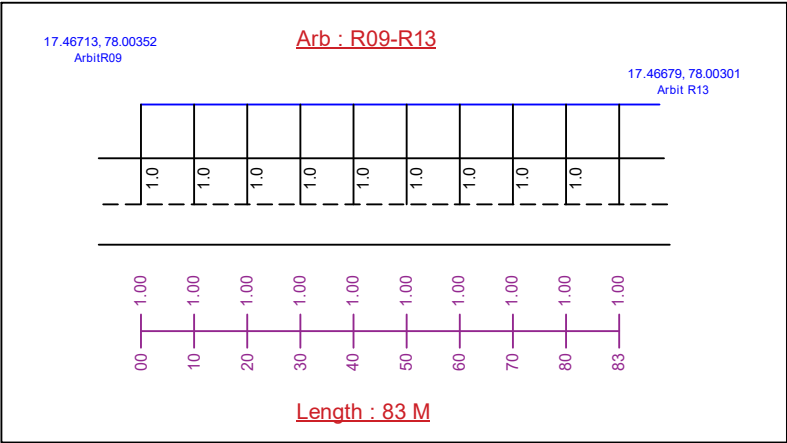



Checked	Designation	Signature

ROAD OFFSET DETAILING FOR CHEEMALADARI OHSR2 (MOMINPET)

Arb : R16-R17

17.46576, 78.00419
Arbit R16

17.46617, 78.00398
Arbit R17

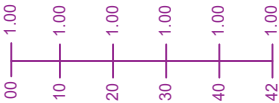
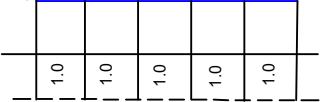


Length : 42 M

Arb : R17-R18

17.46617, 78.00398
Arbit R17

17.46653, 78.00376
Arbit R18

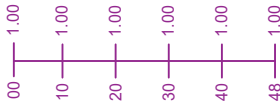
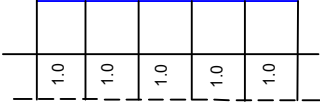


Length : 48 M

Arb : R18-R19

17.46653, 78.00376
Arbit R18

17.46692, 78.00404
Arbit R19

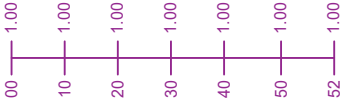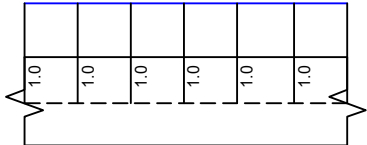


Length : 52 M

Arb : R19-R20

17.46692, 78.00404
Arbit R19

17.46765, 78.0040
Arbit R20

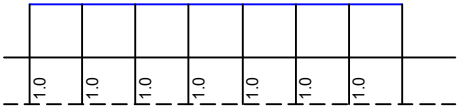

Length : 65 M

Checked	Designation	Signature



TELANGANA FIBER GRID

TELANGANA FIBER GRID

ITE & C GOVERNMENT OF TELANGANA

7th Floor, Splendid Towers, S.P. Road

Opp: Begumpet Police Station,



Begumpet, Hyderabad-500016.

AS - BUILT DRAWINGS (ABD)

DEVARAMPALLE

(MOMINPET MANDAL-VIKARABAD DIST.)

SINGLELINE LOOP DIAGRAM FOR DEVARAMPALLE OHSR1 (MOMINPET)

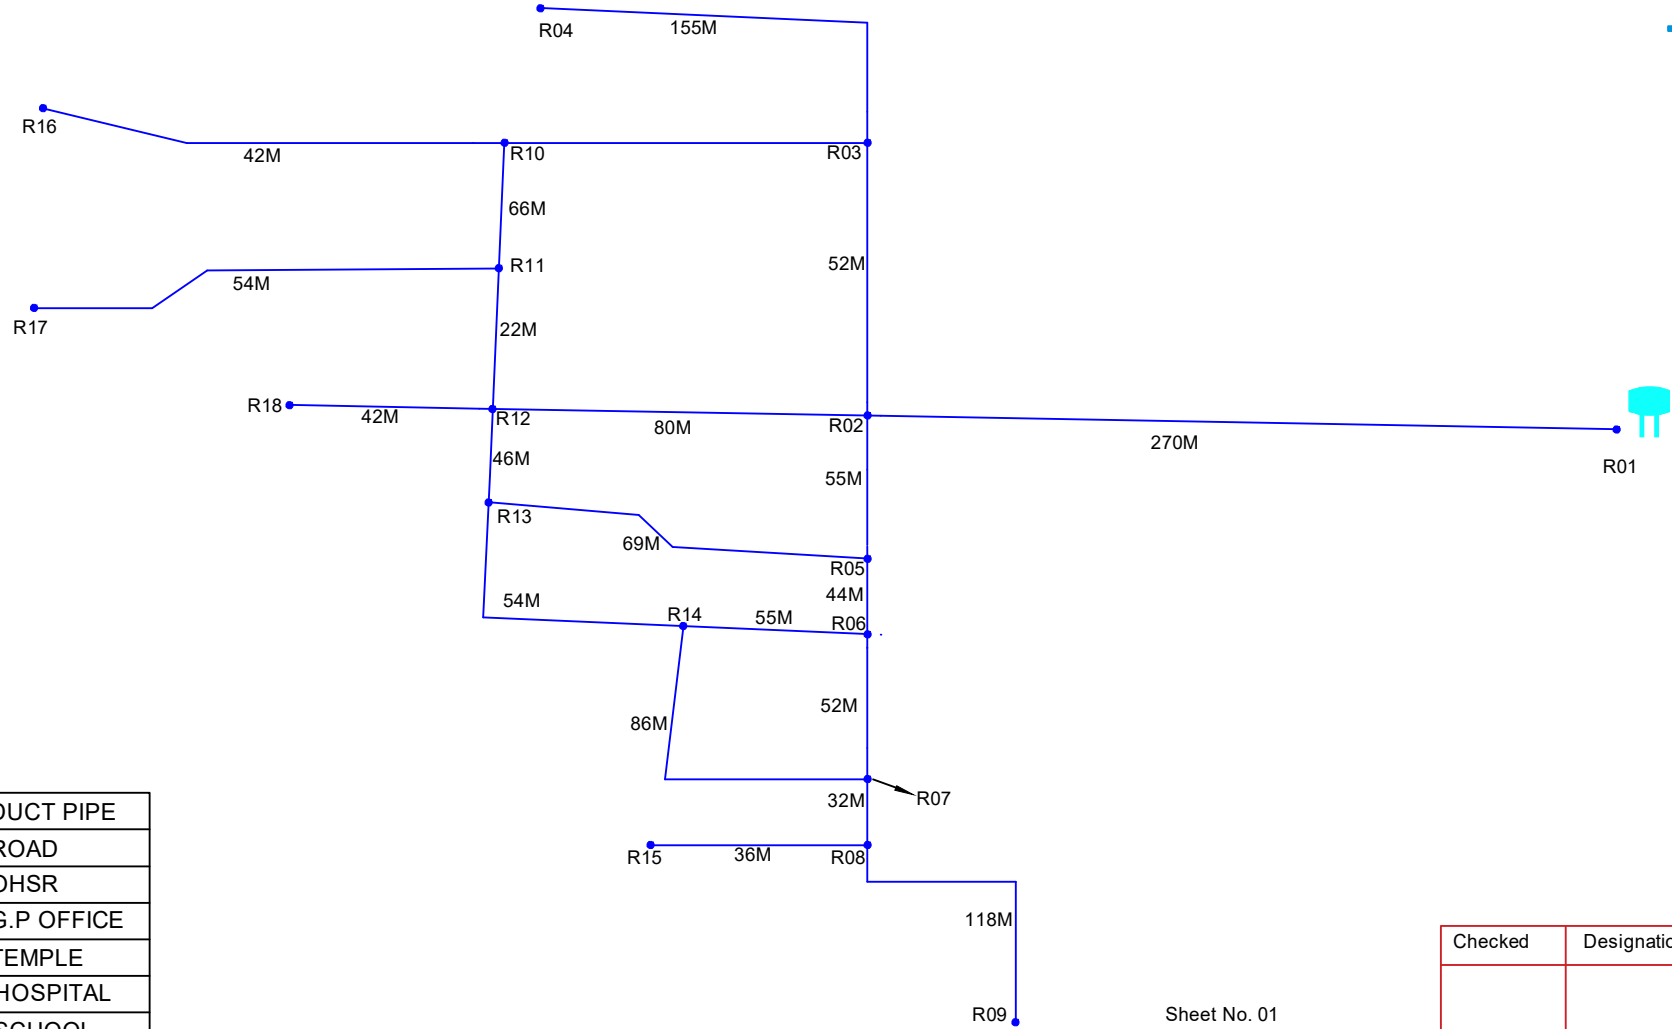
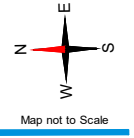








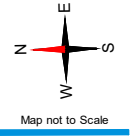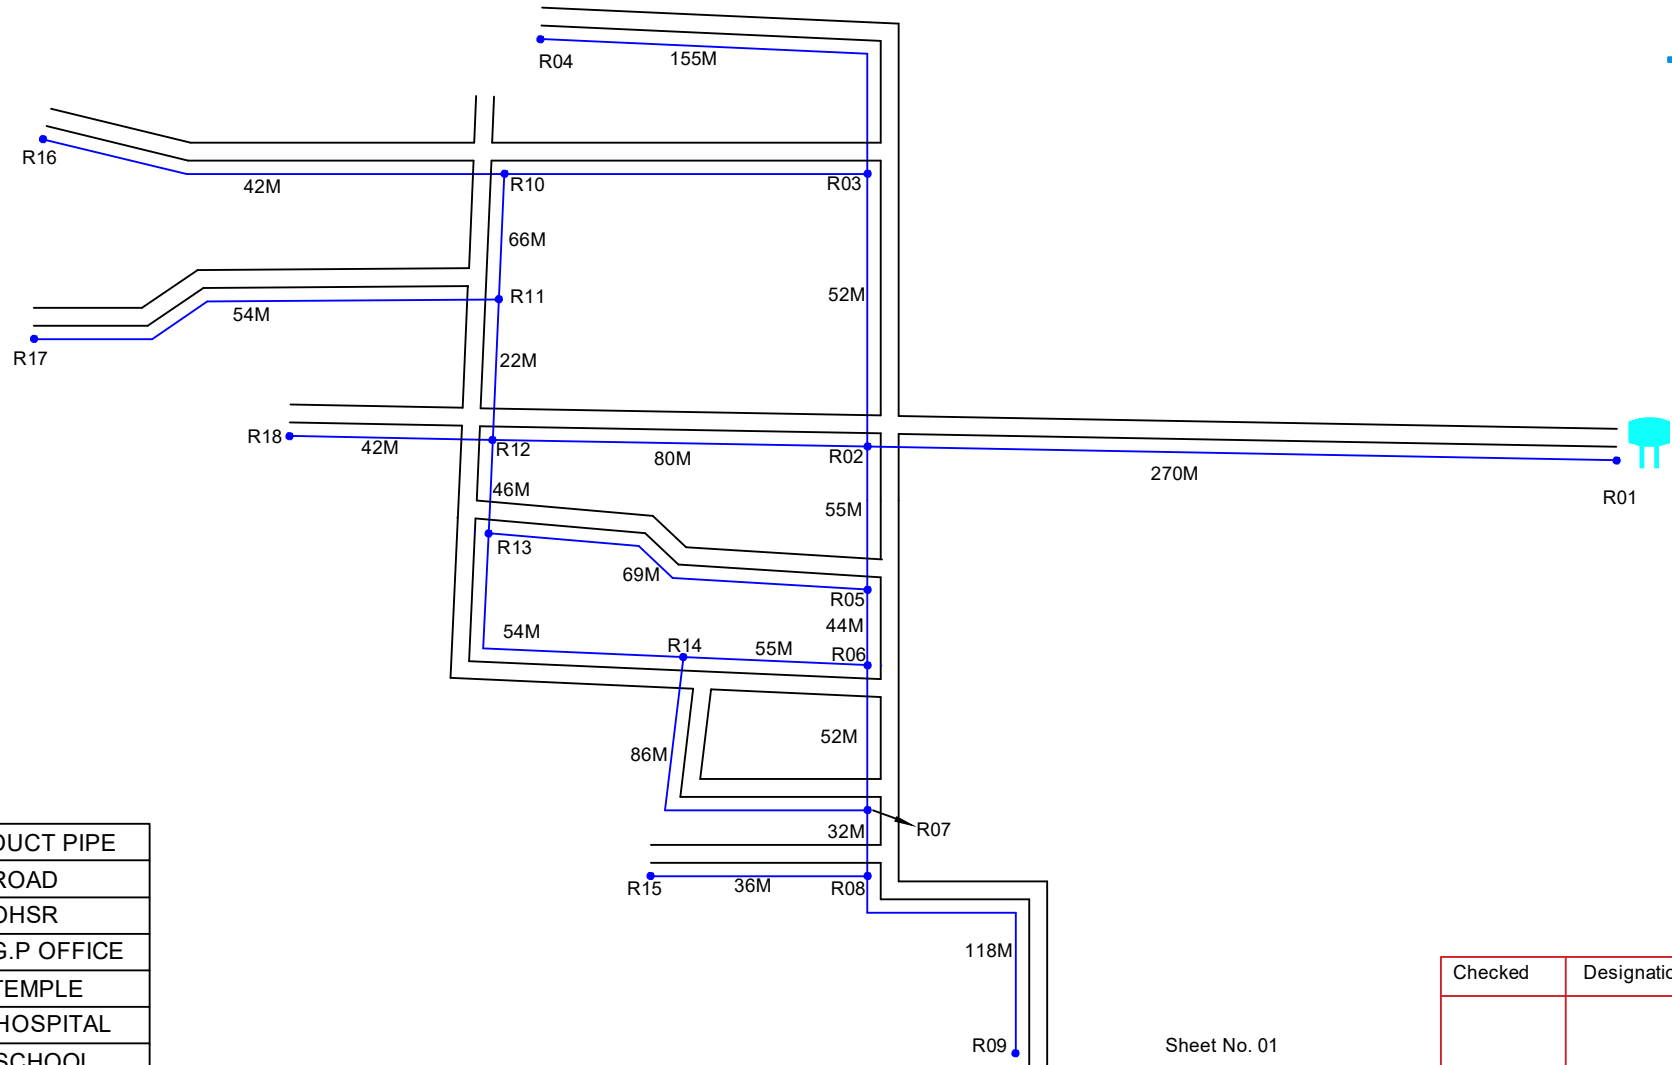

	DUCT PIPE
	ROAD
	OHSR
	G.P OFFICE
	TEMPLE
	HOSPITAL
	SCHOOL
	DUCT GAP

Sheet No. 01
Route Distance : 3133 M

Checked	Designation	Signature

DUCTLAYING ROUTE DIAGRAM FOR DEVARAMPALLE OHSR1 (MOMINPET)







	DUCT PIPE
	ROAD
	OHSR
	G.P OFFICE
	TEMPLE
	HOSPITAL
	SCHOOL
	DUCT GAP

Sheet No. 01
Route Distance : 3133 M

Checked	Designation	Signature


ROAD OFFSET DETAILING FOR DEVARAMPALLY OHSR 1 (MOMINPET)

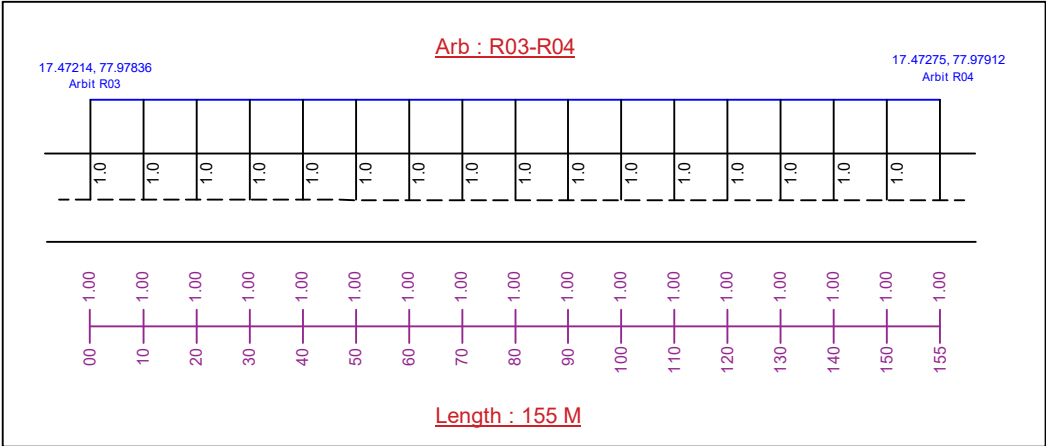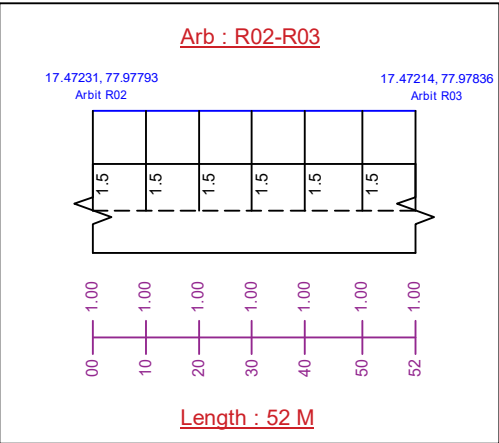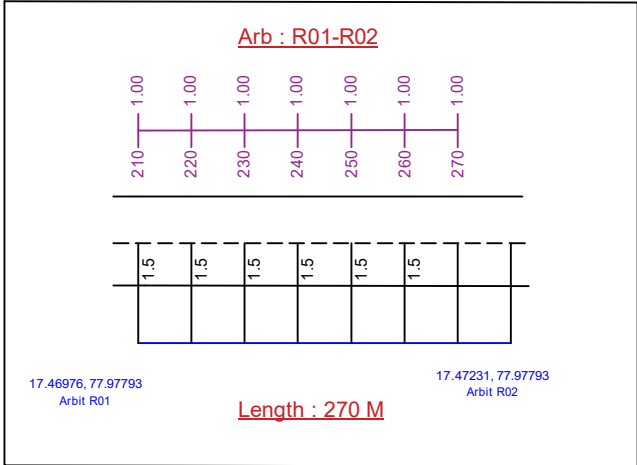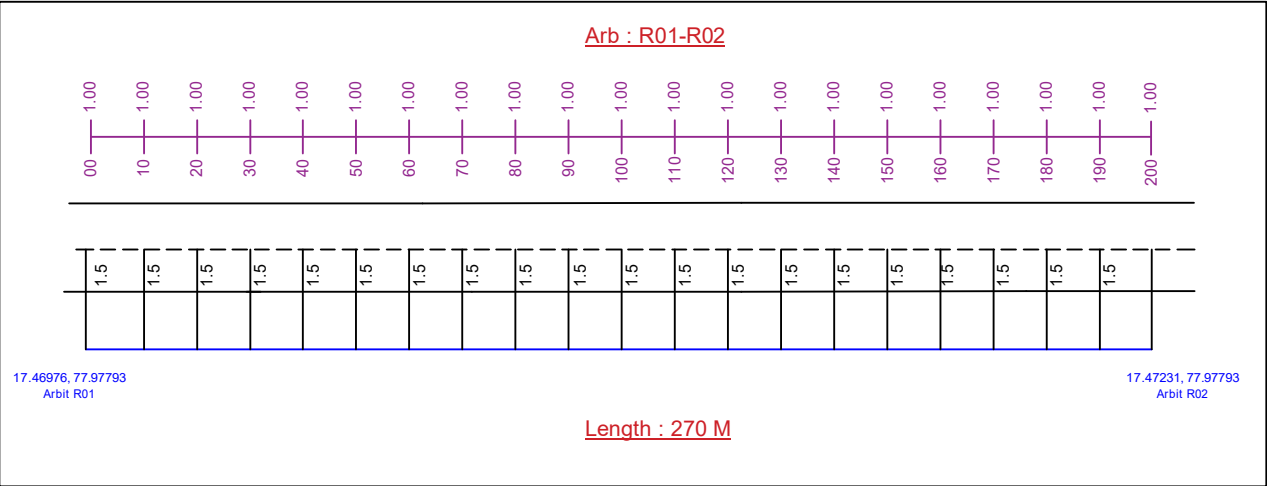

Checked	Designation	Signature

ROAD OFFSET DETAILING FOR DEVARAMPALLY OHSR 1 (MOMINPET)

Arb : R02-R05

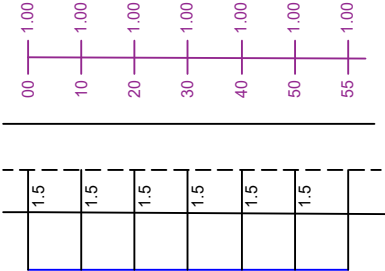


17.47231, 77.97793
Arbit R02

17.47248, 77.97746
Arbit R05

Length : 55 M

Arb : R05-R06

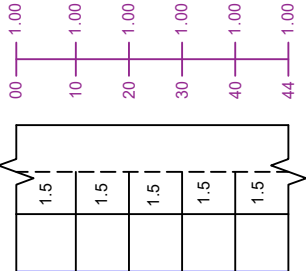


17.47248, 77.97746
Arbit R05

17.47259, 77.97708
Arbit R06

Length : 44 M

Arb : R06-R07

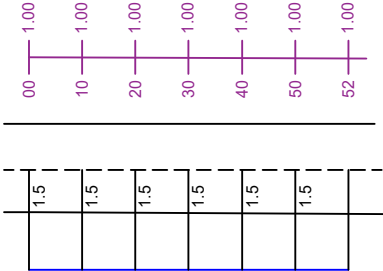


17.47259, 77.97708
Arbit R06

17.47263, 77.97661
Arbit R07

Length : 52 M

Arb : R07-R08

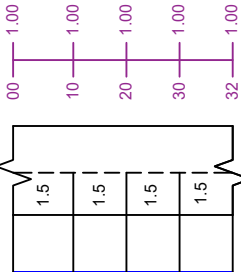


17.47263, 77.97661
Arbit R07

17.47266, 77.97632
Arbit R08

Length : 32 M

Arb : R08-R09

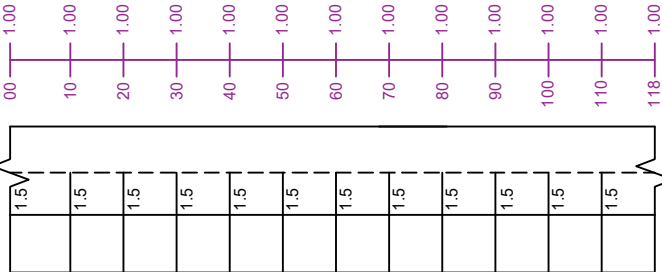

17.47266, 77.97632
Arbit R08


17.47244, 77.97544
Arbit R09

Length : 118 M


Checked	Designation	Signature

ROAD OFFSET DETAILING FOR DEVARAMPALLY OHSR 1 (MOMINPET)


Arb : R03-R10

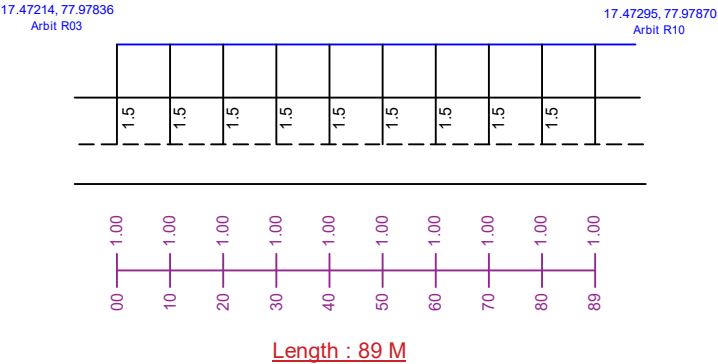


Arb : R10-R11

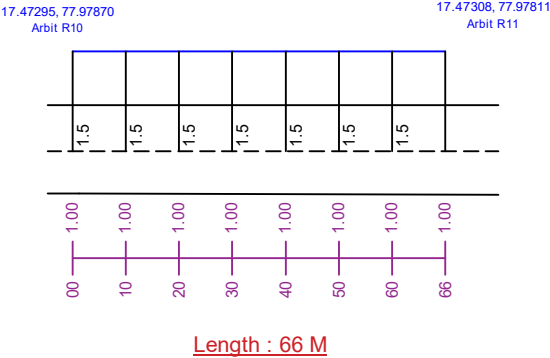


Arb : R11-R12

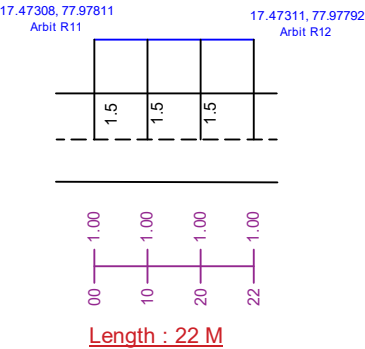


Arb : R12-R13

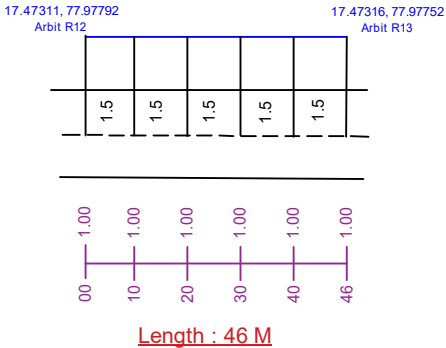

Arb : R13-R14

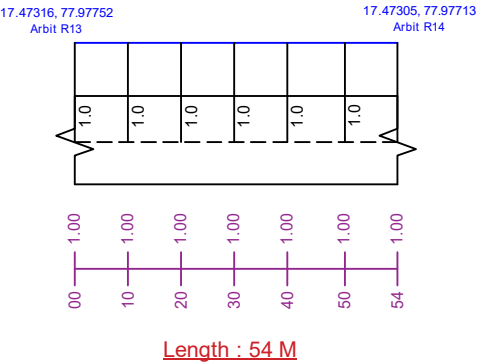


Arb : R14-R07

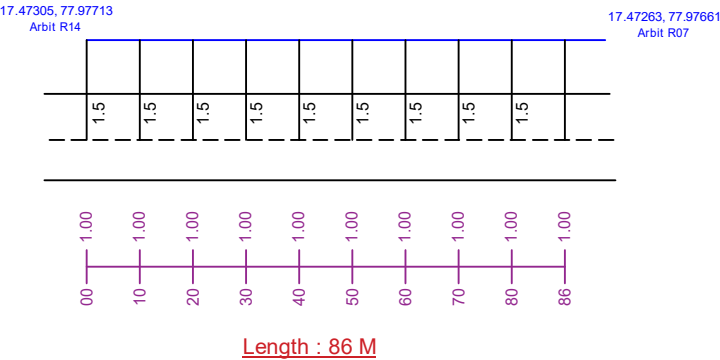

Checked	Designation	Signature


ROAD OFFSET DETAILING FOR DEVARAMPALLY OHSR 1 (MOMINPET)

Arb : R02-R12

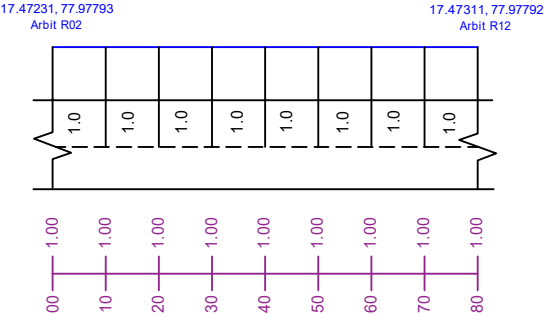


Length : 80 M

Arb : R05-R13

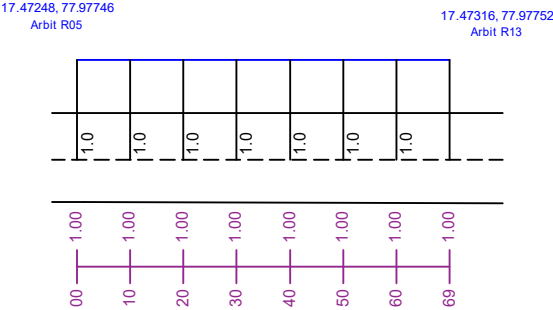


Length : 69 M

Arb : R06-R14

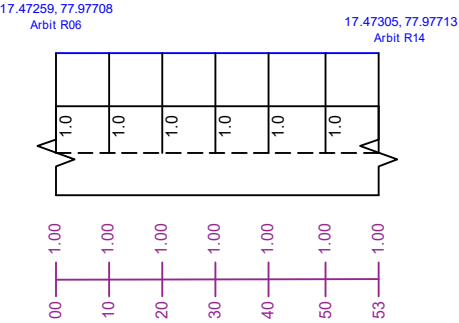


Length : 53 M

Arb : R08-R15

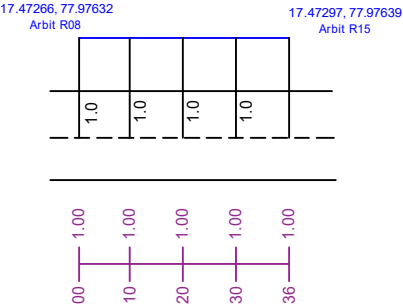


Length : 36 M

Arb : R10-R16

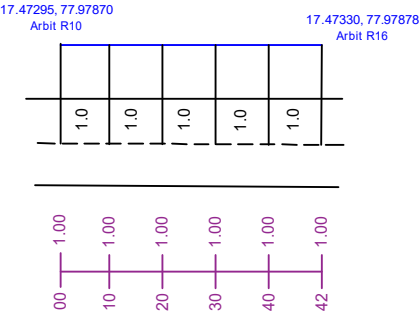

Length : 42 M


Arb : R11-R17

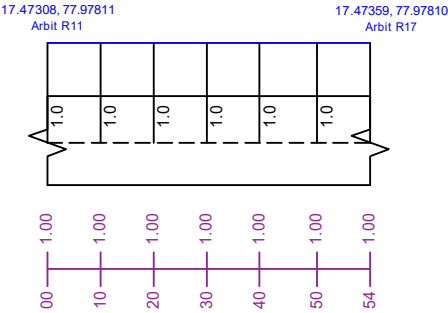

Length : 54 M

Checked	Designation	Signature



ROAD OFFSET DETAILING FOR DEVARAMPALLY OHSR 1 (MOMINPET)

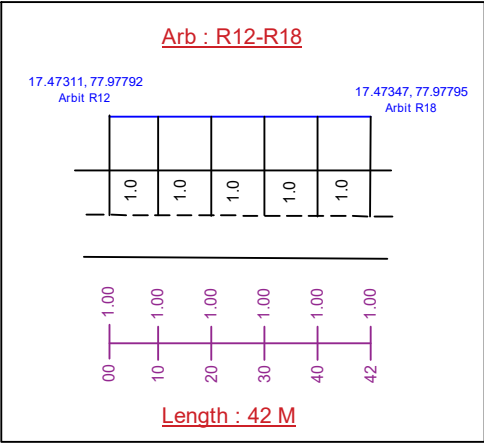

Sheet No. 05
Route Distance : 3133 M

Checked	Designation	Signature

SINGLELINE LOOP DIAGRAM FOR DEVARAMPALLE OHSR2 (MOMINPET)

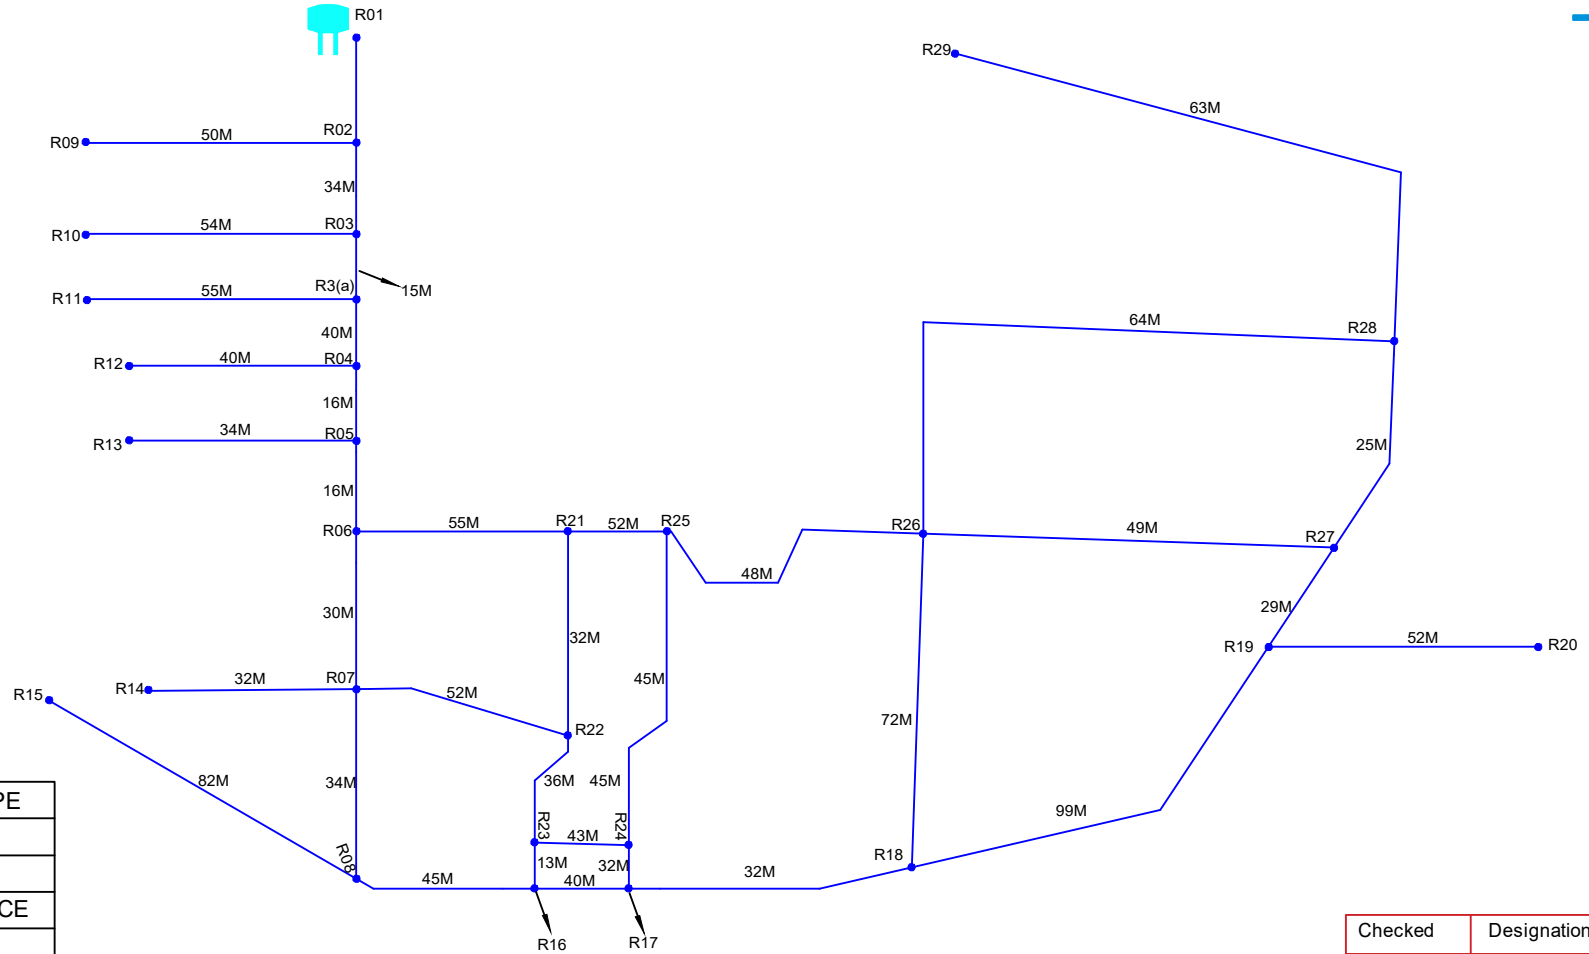
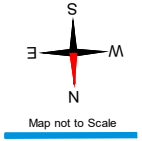


	DUCT PIPE
	ROAD
	OHSR
	G.P. OFFICE
	TEMPLE
	HOSPITAL
	SCHOOL
	DUCT GAP

Sheet No. 01
Route Distance : 3133 M

Checked	Designation	Signature

DUCTLAYING ROUTE DIAGRAM FOR DEVARAMPALLE OHSR2 (MOMINPET)






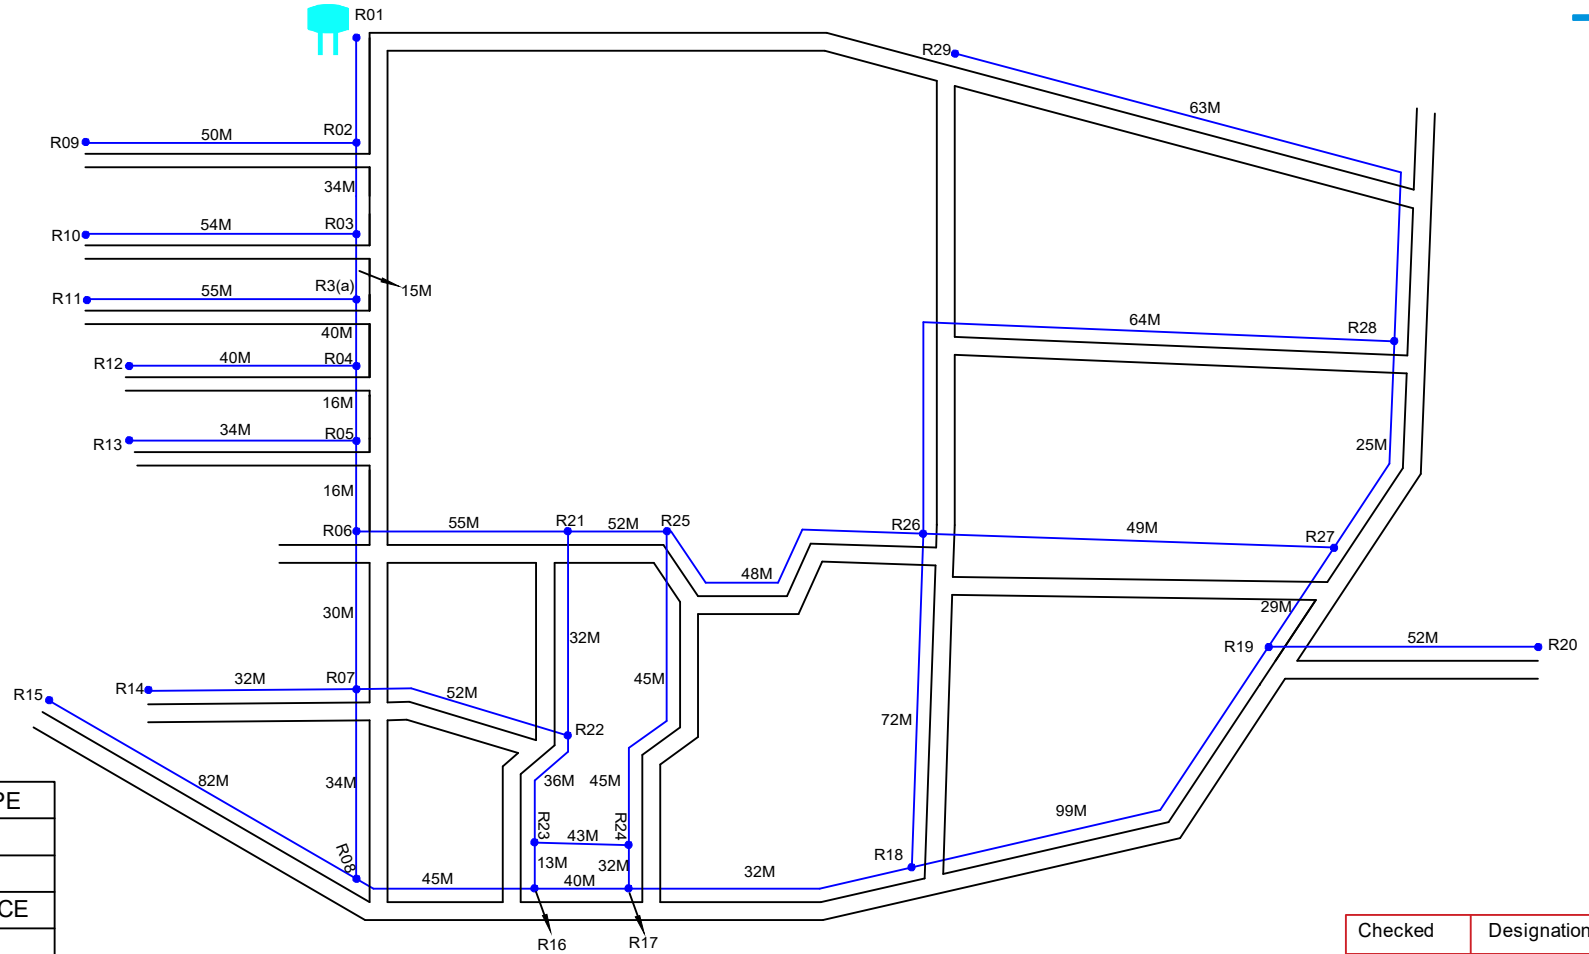
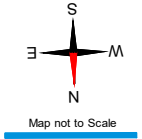


	DUCT PIPE
	ROAD
	OHSR
	G.P OFFICE
	TEMPLE
	HOSPITAL
	SCHOOL
	DUCT GAP

Sheet No. 01
Route Distance : 3133 M

Checked	Designation	Signature


ROAD OFFSET DETAILING FOR DEVARAMPALLY OHSR 2 (MOMINPET)

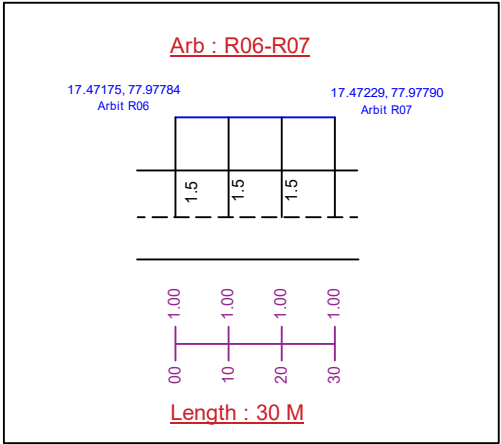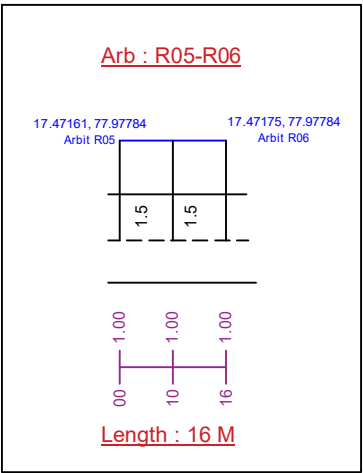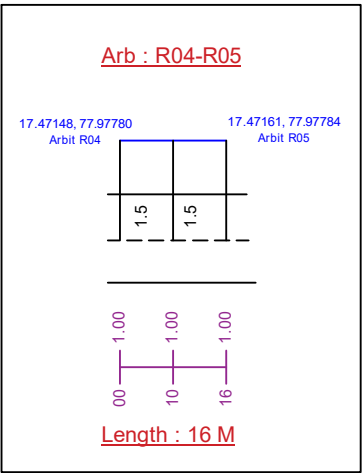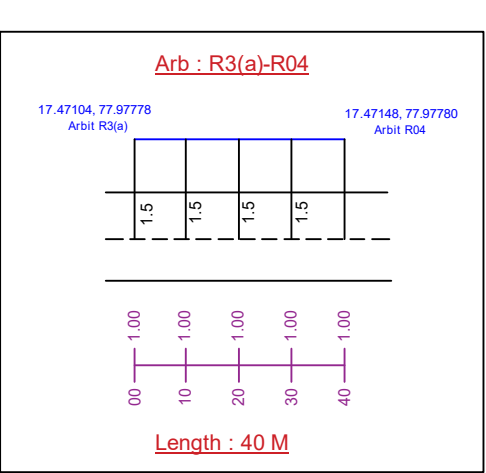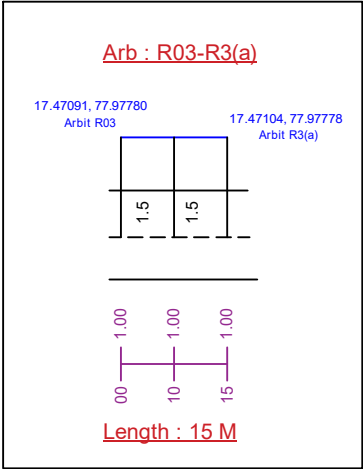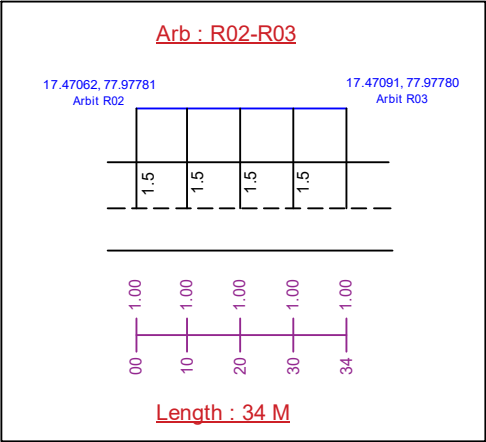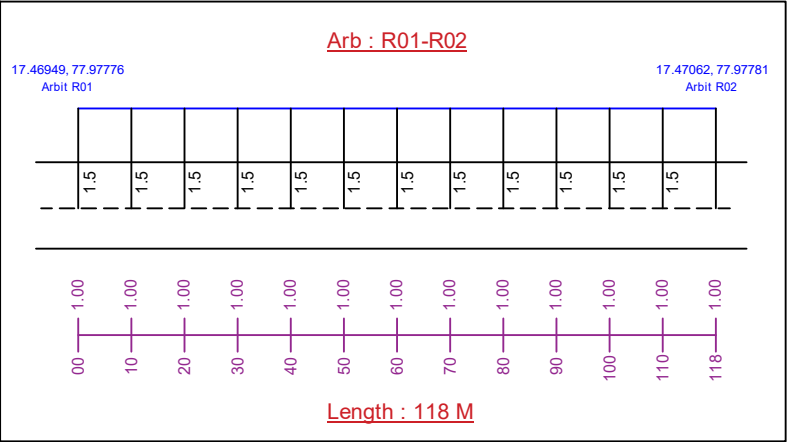

Checked	Designation	Signature


ROAD OFFSET DETAILING FOR DEVARAMPALLY OHSR 2 (MOMINPET)

Arb : R07-R08

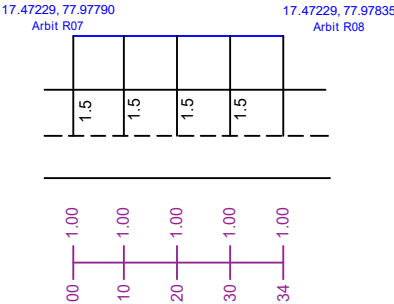


Length : 34 M

Arb : R02-R09

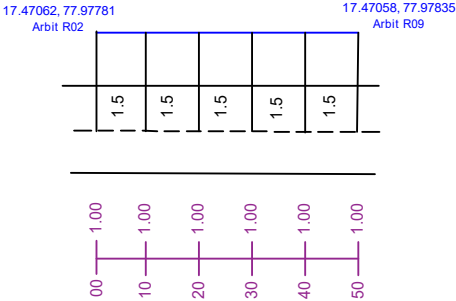


Length : 50 M

Arb : R03-R10

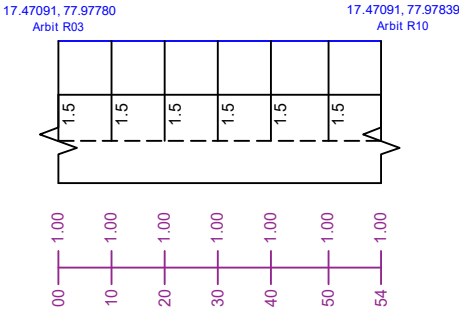


Length : 54 M

Arb : R3(a)-R11

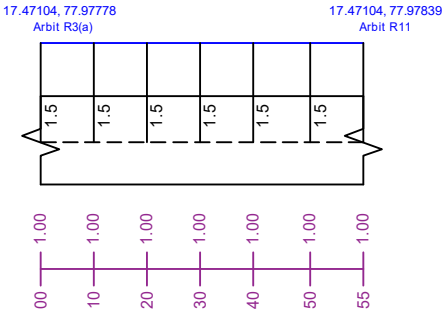


Length : 55 M

Arb : R04-R12

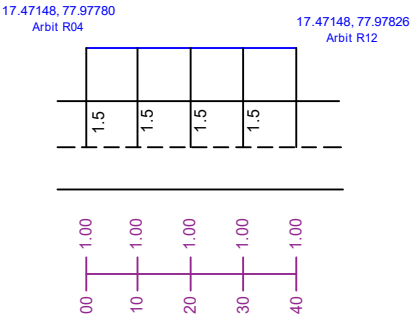

Length : 40 M

Arb : R05-R13

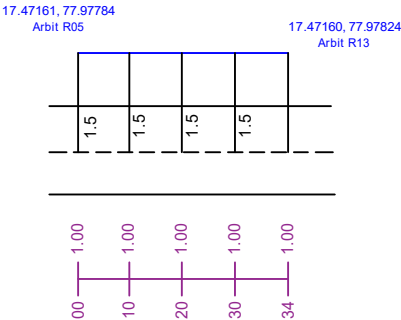


Length : 34 M


Checked	Designation	Signature

ROAD OFFSET DETAILING FOR DEVARAMPALLY OHSR 2 (MOMINPET)


Arb : R07-R14

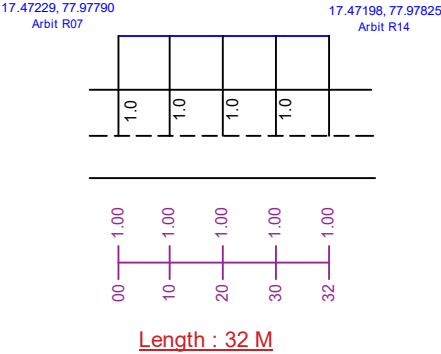


Arb : R08-R15

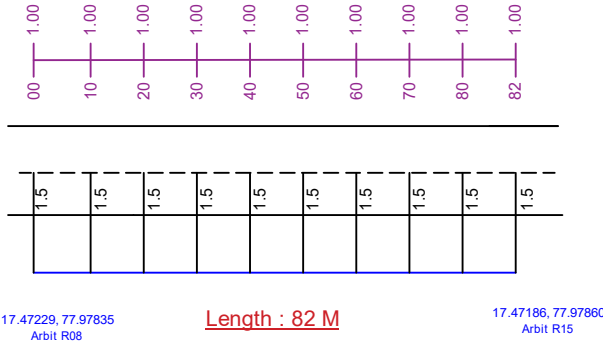


Arb : R08-R16

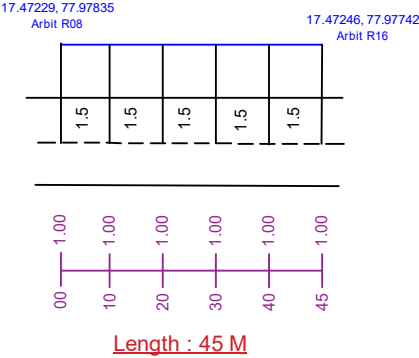


Arb : R16-R17

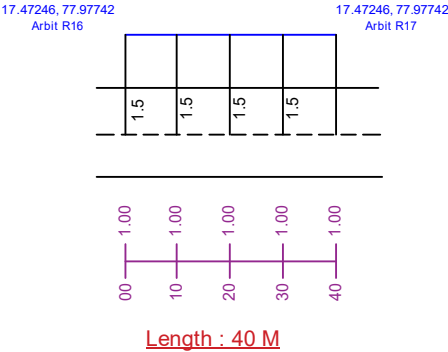

Arb : R17-R18

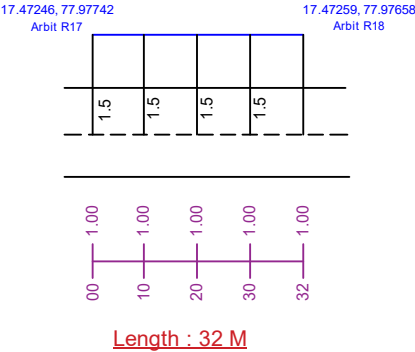


Arb : R18-R19

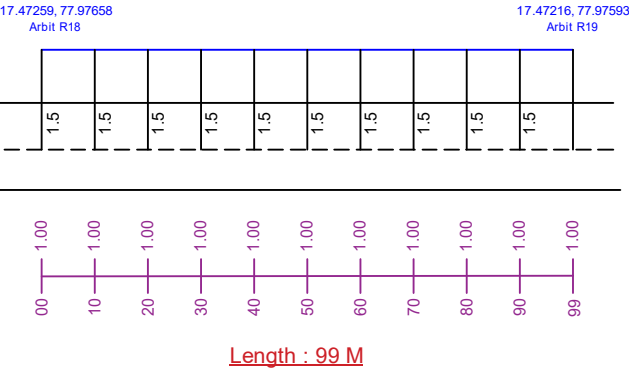


Checked	Designation	Signature

ROAD OFFSET DETAILING FOR DEVARAMPALLY OHSR 2 (MOMINPET)


Arb : R06-R21

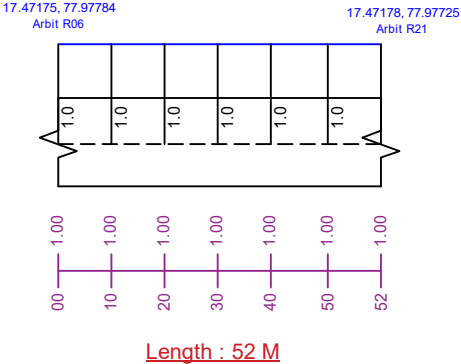


Arb : R07-R22

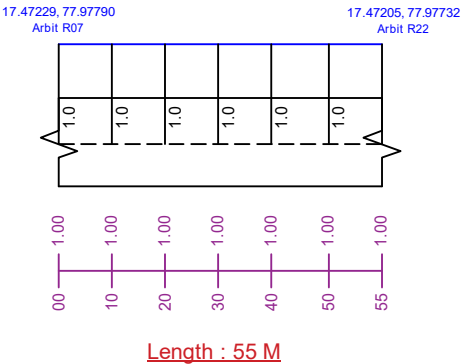


Arb : R16-R23

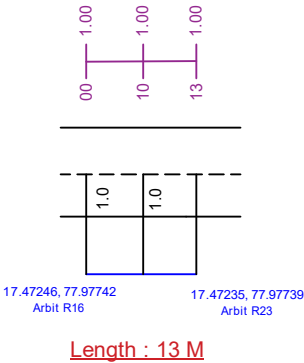


Arb : R21-R22

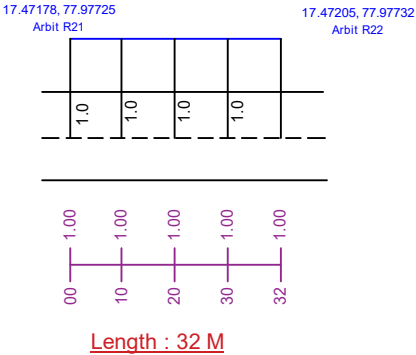


Arb : R22-R23

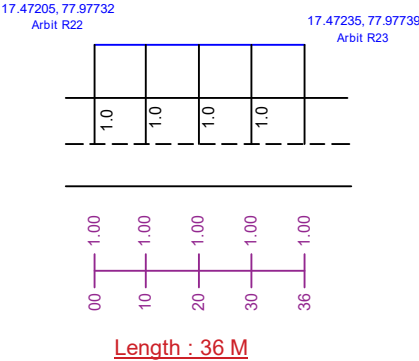

Arb : R17-R24

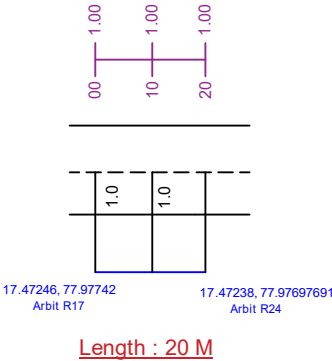


Arb : R23-R24

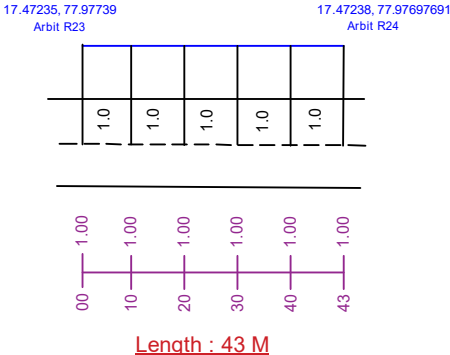


Checked	Designation	Signature

ROAD OFFSET DETAILING FOR DEVARAMPALLY OHSR 2 (MOMINPET)


Arb : R24-R25

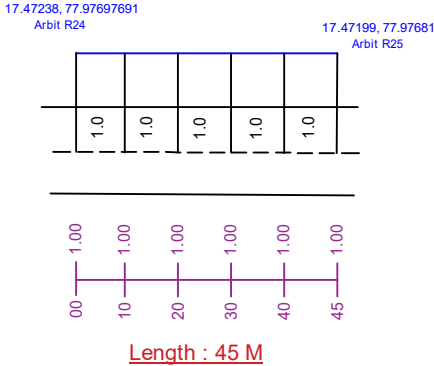


Arb : R21-R25

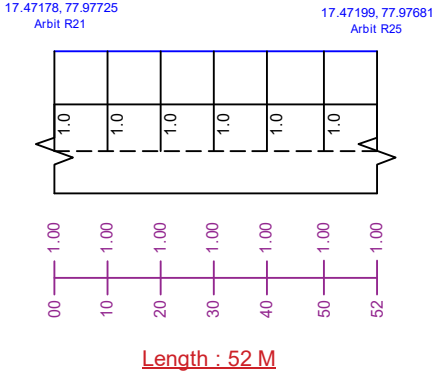


Arb : R25-R26

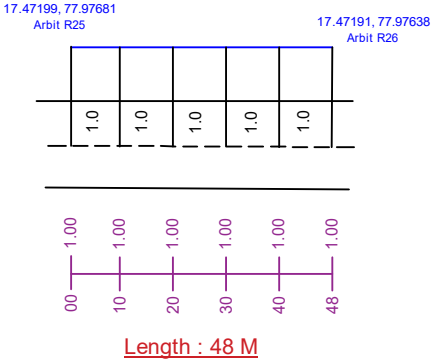


Arb : R18-R26

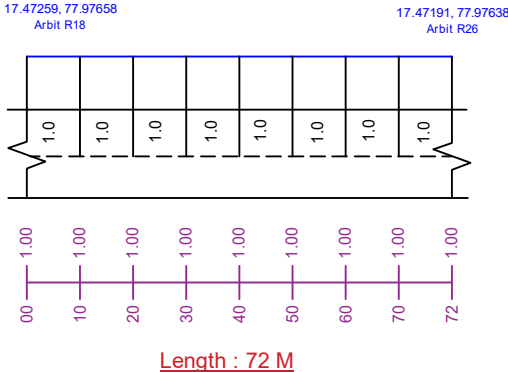

Arb : R26-R27

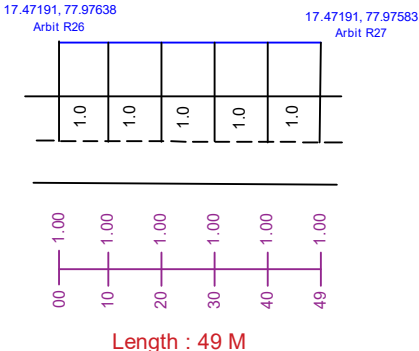

Arb : R27-R19

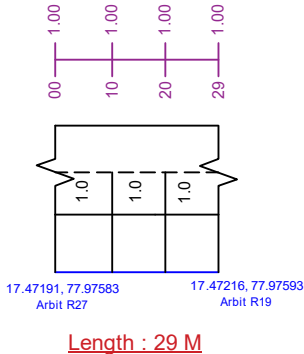


Checked	Designation	Signature

ROAD OFFSET DETAILING FOR DEVARAMPALLY OHSR 2 (MOMINPET)

Arb : R27-R28

17.47191, 77.97583
Arbit R27

17.47169, 77.97577
Arbit R28

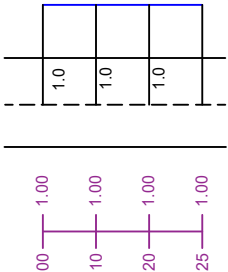


Length : 25 M

Arb : R26-R28

17.47191, 77.97638
Arbit R26

17.47169, 77.97577
Arbit R28

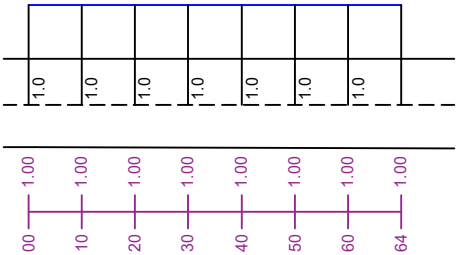


Length : 64 M

Arb : R28-R29

17.47169, 77.97577
Arbit R28

17.47155, 77.97631
Arbit R29

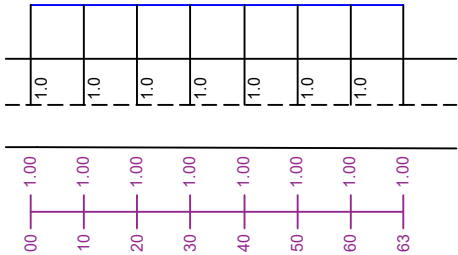

Length : 63 M

Checked	Designation	Signature



TELANGANA FIBER GRID

TELANGANA FIBER GRID

ITE & C GOVERNMENT OF TELANGANA

7th Floor, Splendid Towers, S.P. Road

Opp: Begumpet Police Station,



Begumpet, Hyderabad-500016.


 






AS - BUILT DRAWINGS (ABD)

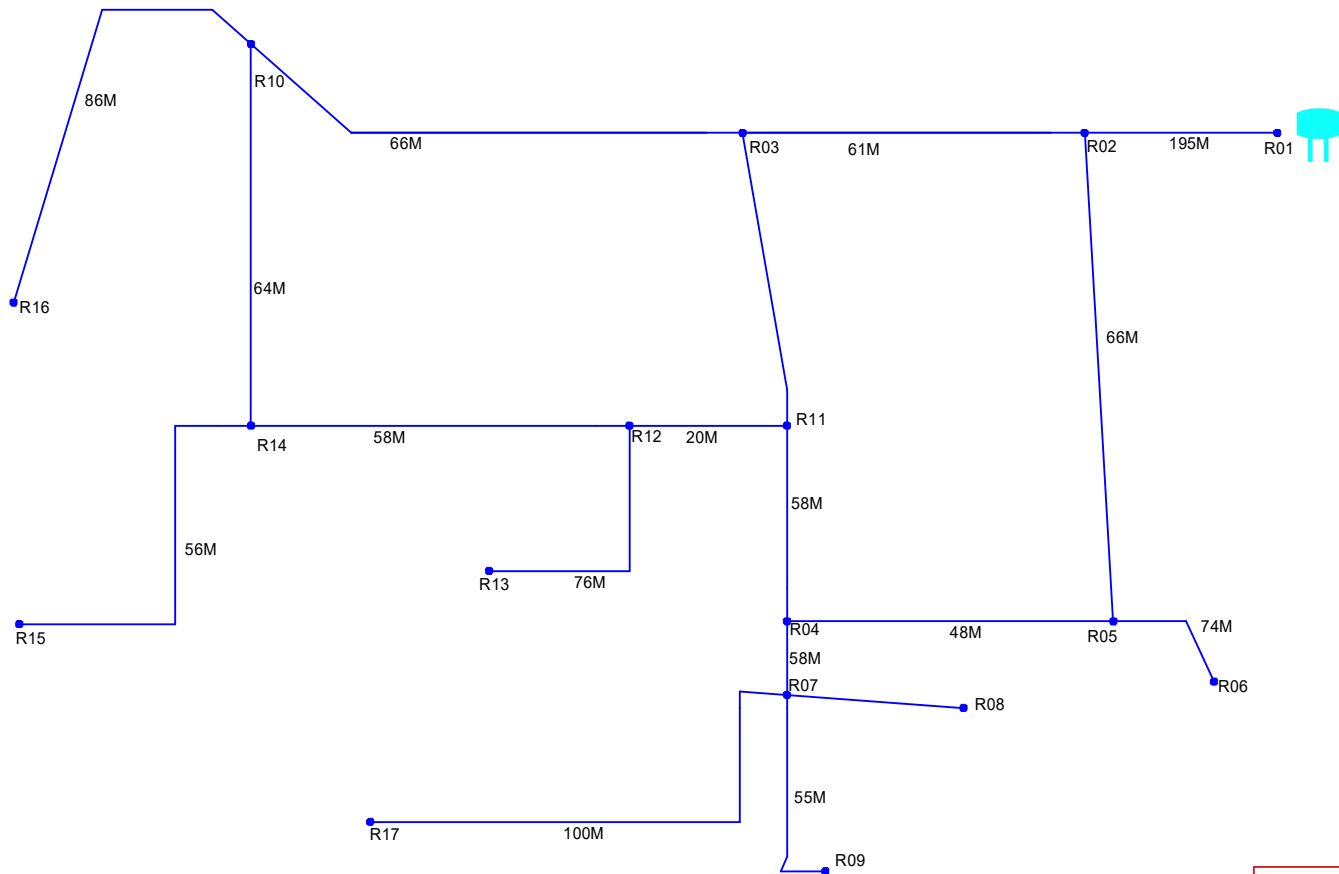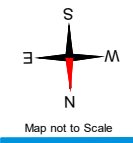DURGAMCHERUVU

(MOMINPET MANDAL-VIKARABAD DIST.)

SINGLELINE LOOP DIAGRAM FOR DURGAMCHERUVU OHSR1 (MOMINPET)






 






	DUCT PIPE
	ROAD
	OHSR
	G.P OFFICE
	TEMPLE
	HOSPITAL
	SCHOOL
	DUCT GAP

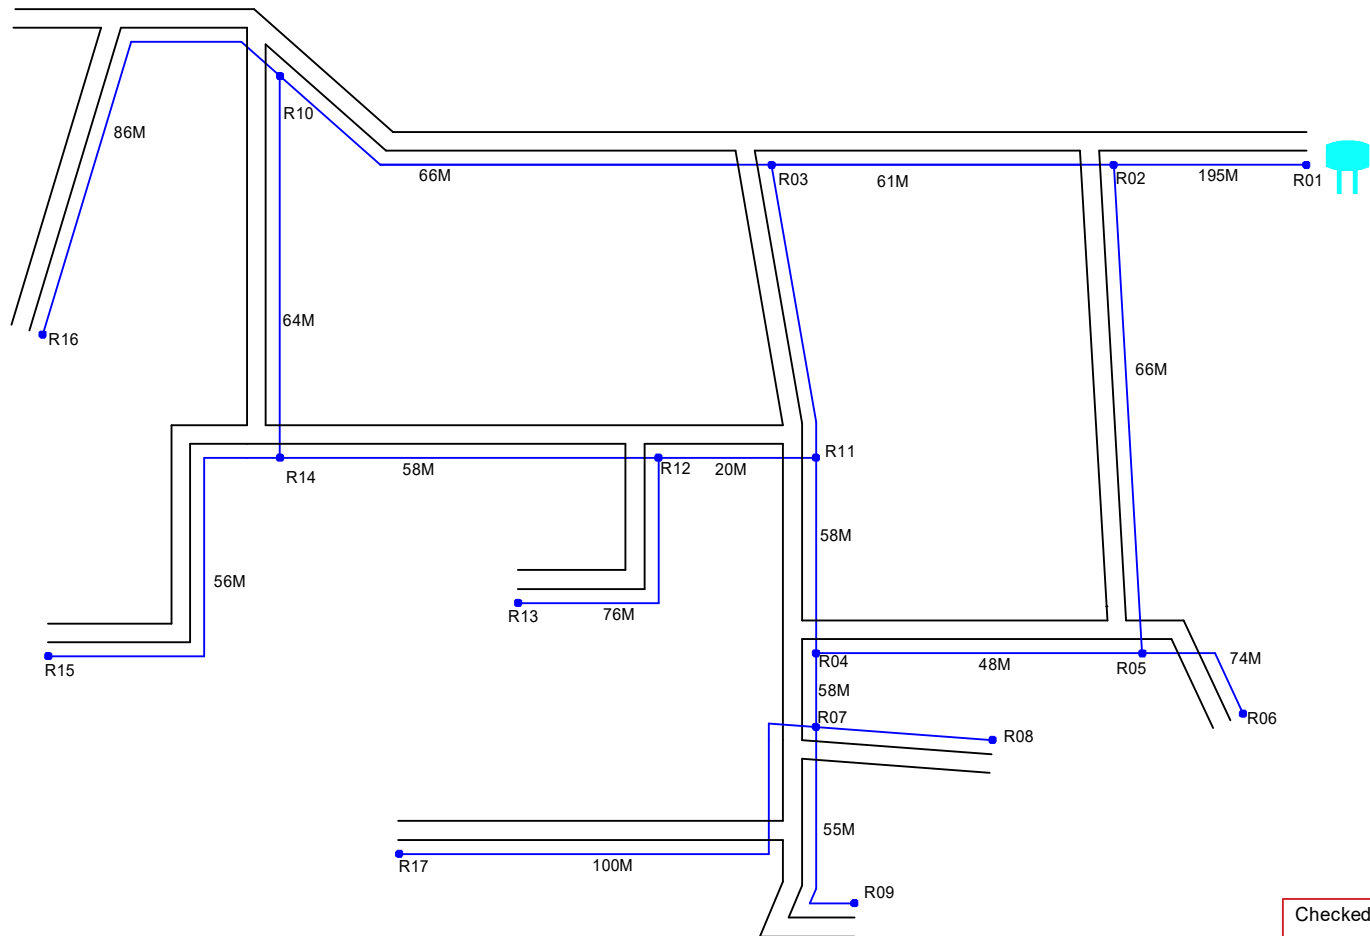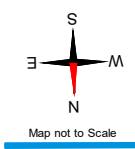Sheet No. 01
Route Distance : 3261 M

Checked	Designation	Signature

DUCTLAYING ROUTE DIAGRAM FOR DURGAMCHERUVU OHSR1 (MOMINPET)




	DUCT PIPE
	ROAD
	OHSR
	G.P OFFICE
	TEMPLE
	HOSPITAL
	SCHOOL
	DUCT GAP

Sheet No. 01
Route Distance : 3261 M


Checked	Designation	Signature

ROAD OFFSET DETAILING FOR DURGACHERUVU OHSR1 (MOMINPET)


Arb : R01-R02

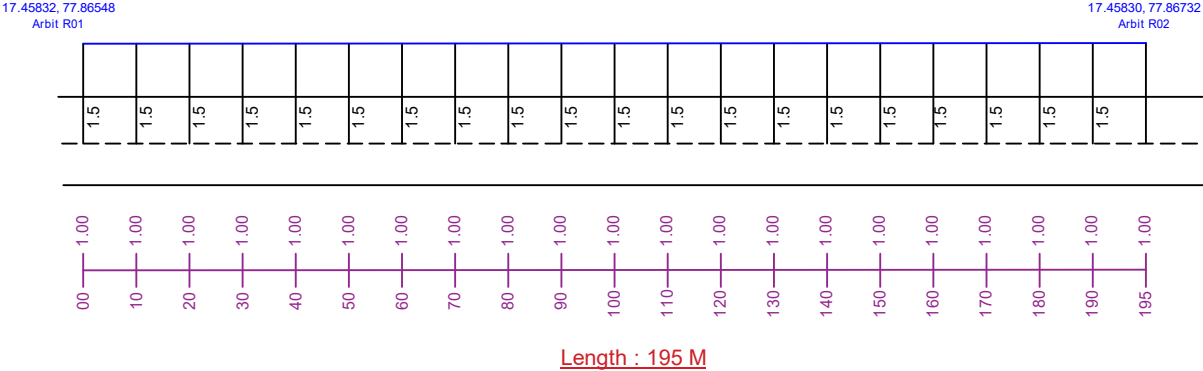


Arb : R02-R03

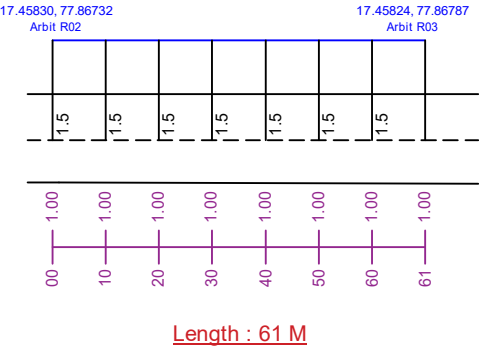


Arb : R03-R11

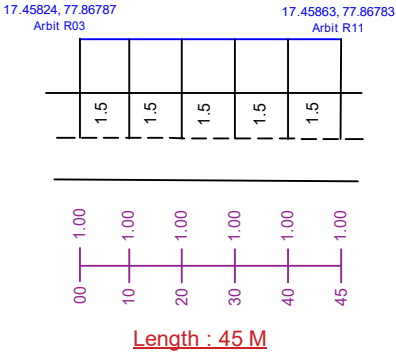

Arb : R11-R04

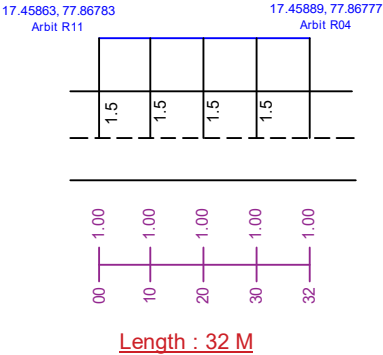


Arb : R04-R05

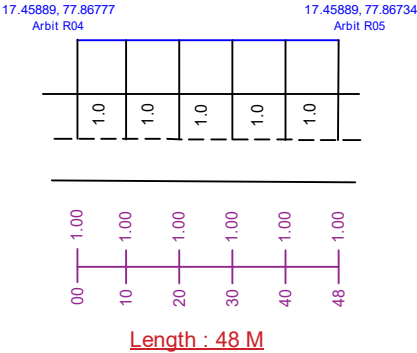

Checked	Designation	Signature


ROAD OFFSET DETAILING FOR DURGACHERUVU OHSR1 (MOMINPET)

Arb : R02-R05

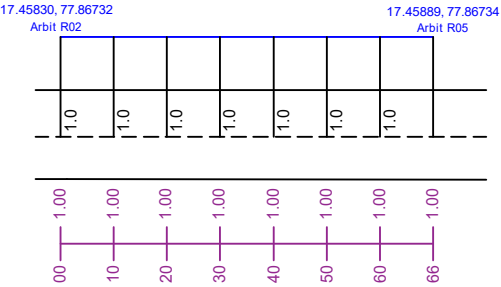


Length : 66 M

Arb : R05-R06

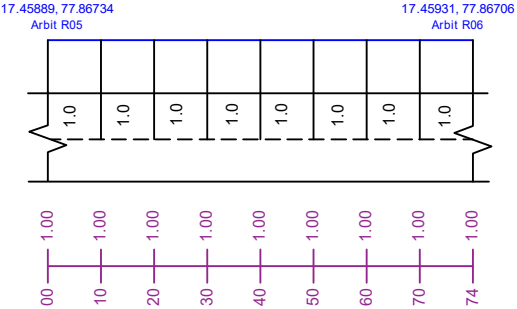


Length : 74 M

Arb : R04-R07

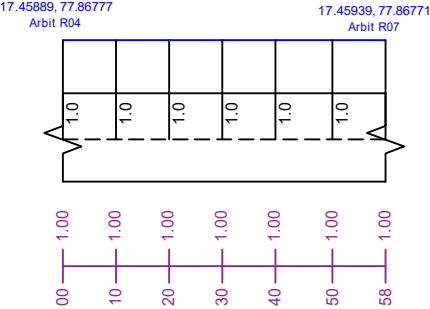


Length : 58 M

Arb : R07-R08

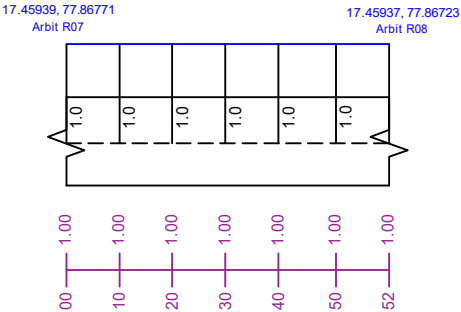


Length : 52 M

Arb : R03-R10

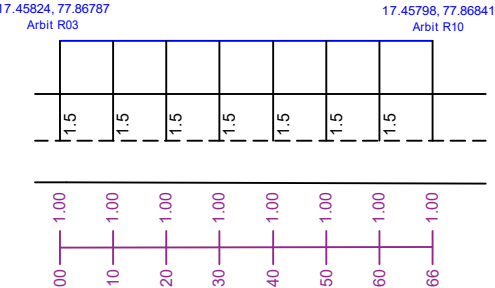

Length : 66 M

Arb : R11-R12

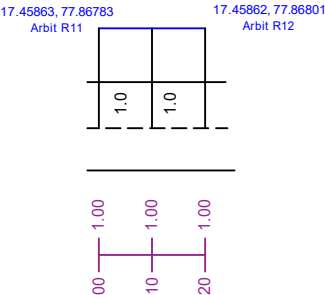


Length : 20 M

Sheet No. 02
Route Distance: 3261 M


Checked	Designation	Signature

ROAD OFFSET DETAILING FOR DURGACHERUVU OHSR1 (MOMINPET)


Arb : R12-R13

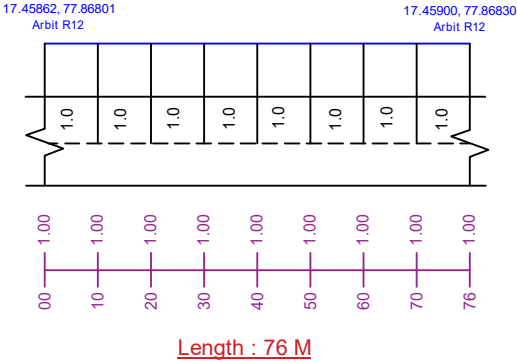


Arb : R12-R14

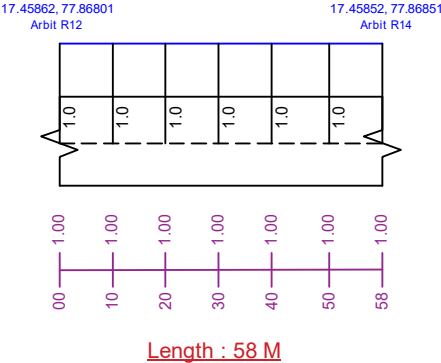


Arb : R10-R14

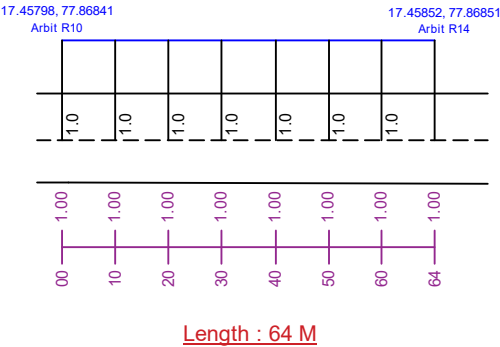

Arb : R14-R15

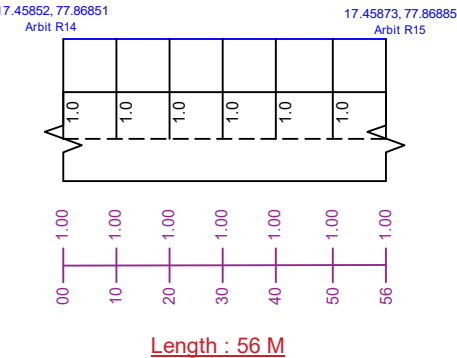


Arb : R10-R11

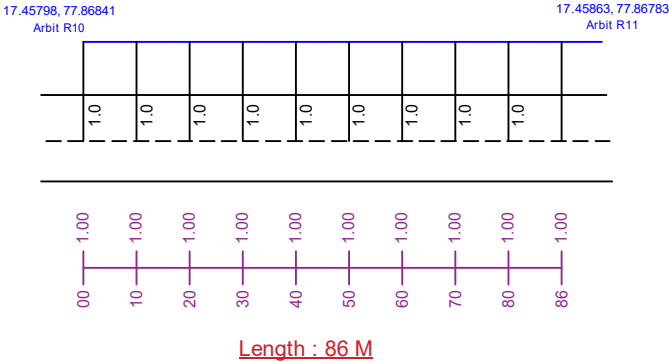

Checked	Designation	Signature



ROAD OFFSET DETAILING FOR DURGACHERUVU OHSR1 (MOMINPET)

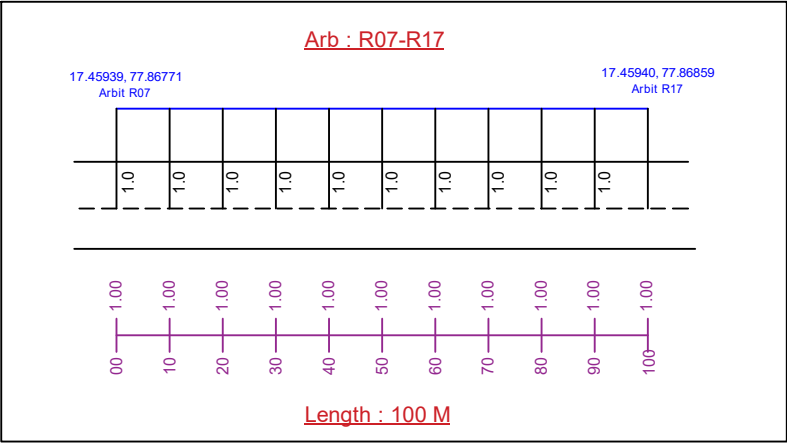
 






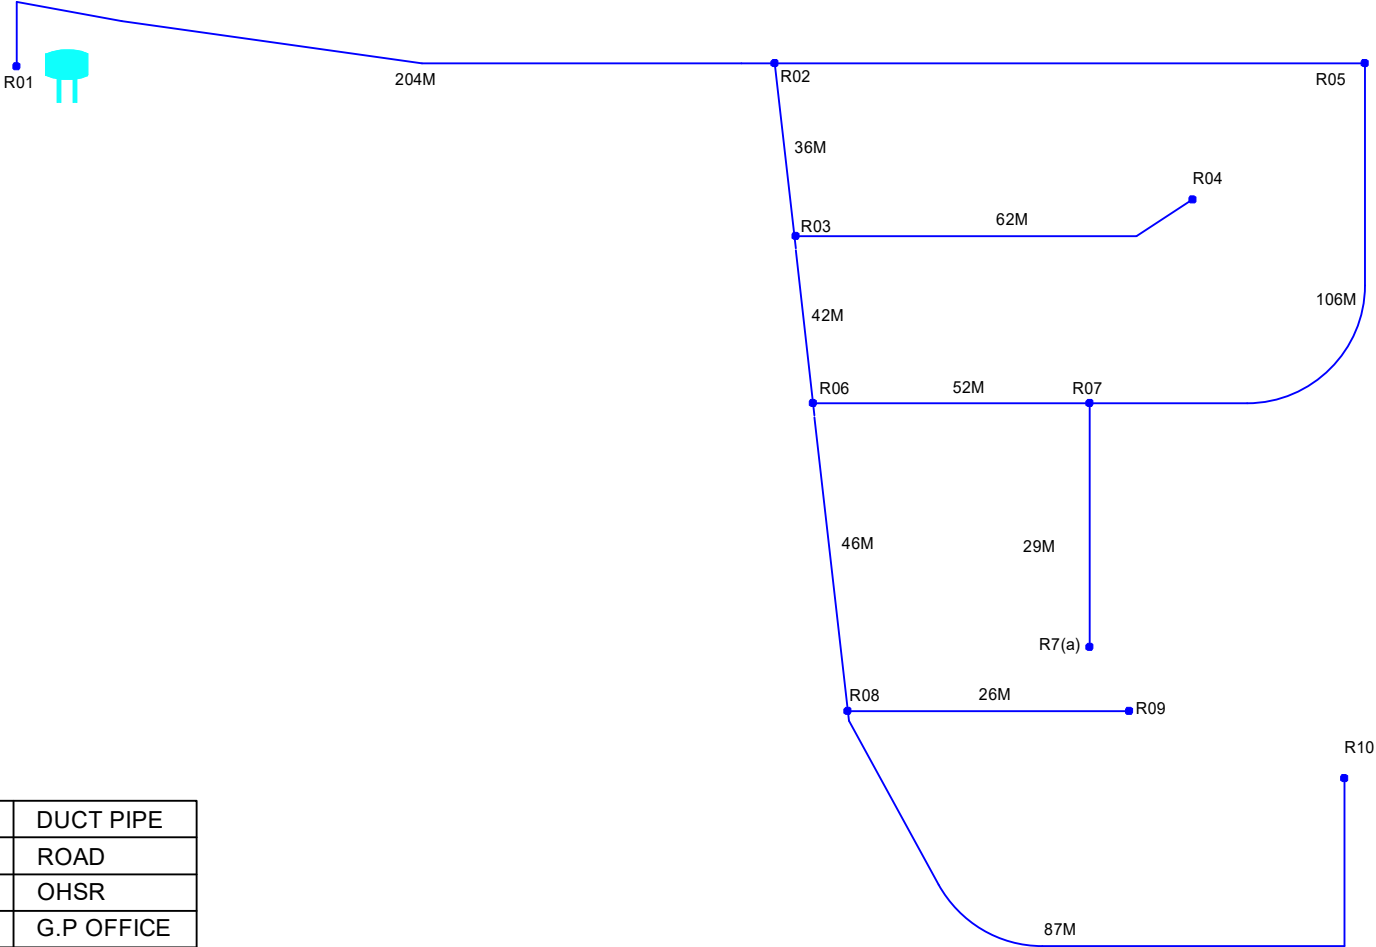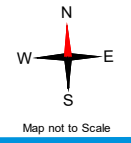

Sheet No. 04
Route Distance: 3261 M

Checked	Designation	Signature

SINGLELINE LOOP DIAGRAM FOR DURGAMCHERUVU OHSR2 (MOMINPET)





	DUCT PIPE
	ROAD
	OHSR
	G.P OFFICE
	TEMPLE
	HOSPITAL
	SCHOOL
	DUCT GAP

Sheet No. 01
Route Distance : 3261 M

Checked	Designation	Signature

DUCTLAYING ROUTE DIAGRAM FOR DURGAMCHERUVU OHSR2 (MOMINPET)



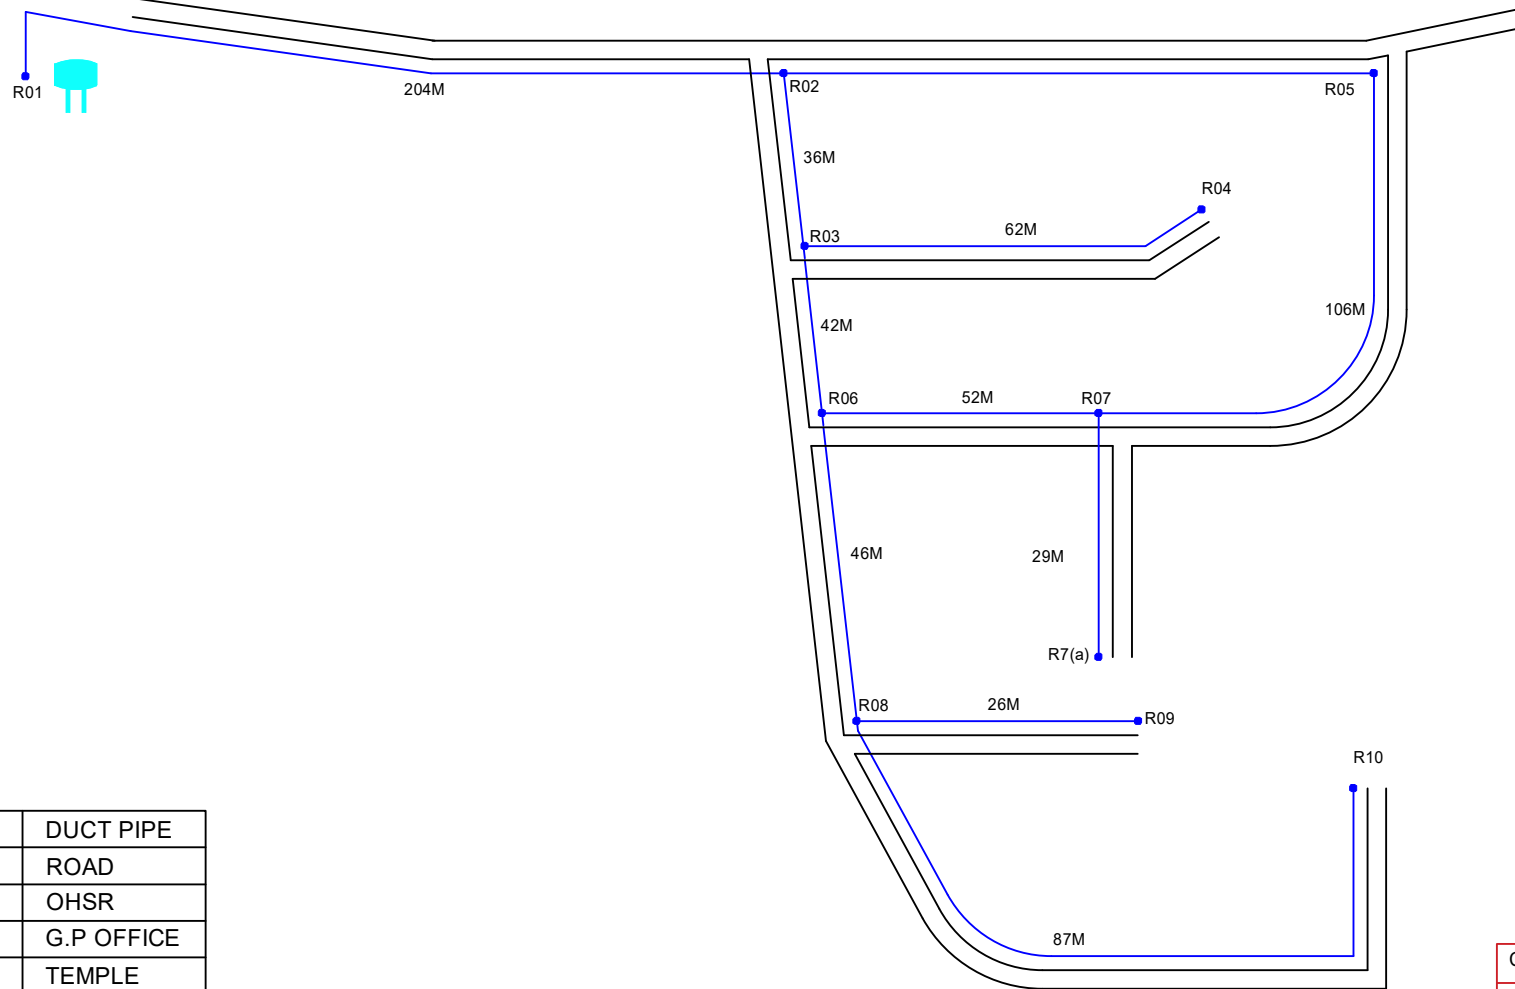
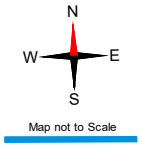


	DUCT PIPE
	ROAD
	OHSR
	G.P OFFICE
	TEMPLE
	HOSPITAL
	SCHOOL
	DUCT GAP

Sheet No. 01
Route Distance : 3261 M

Checked	Designation	Signature


ROAD OFFSET DETAILING FOR DURGAMCHERUVU OHSR2 (MOMINPET)

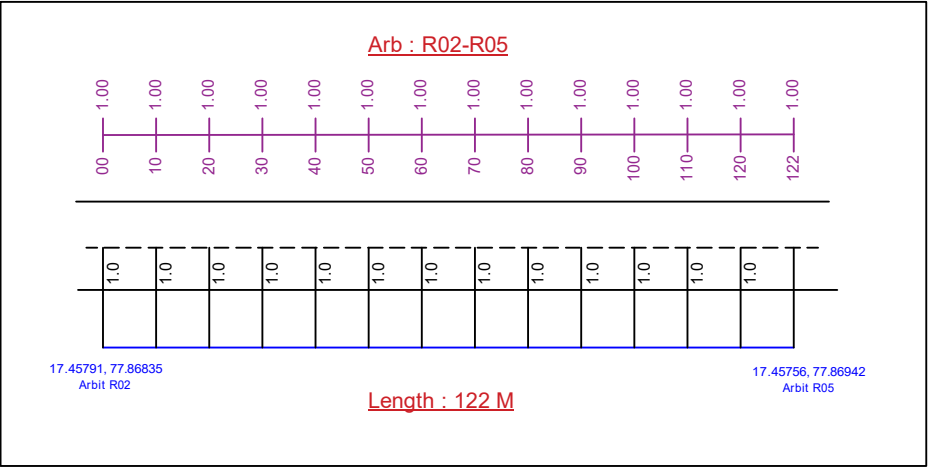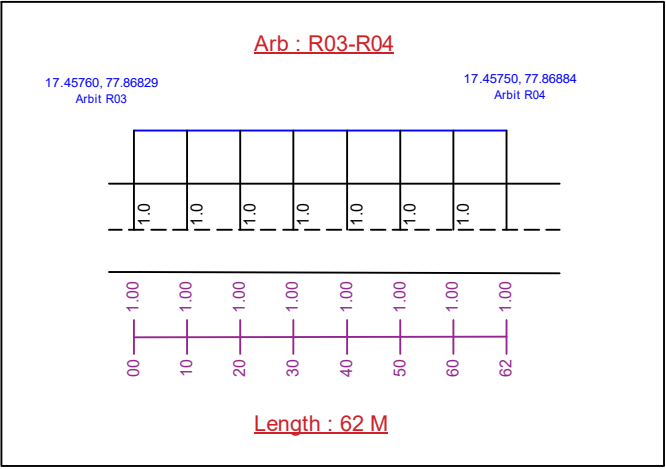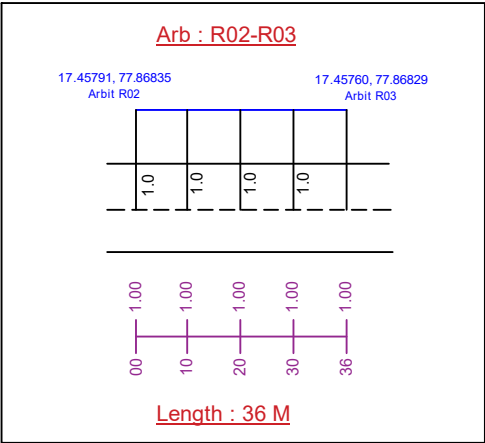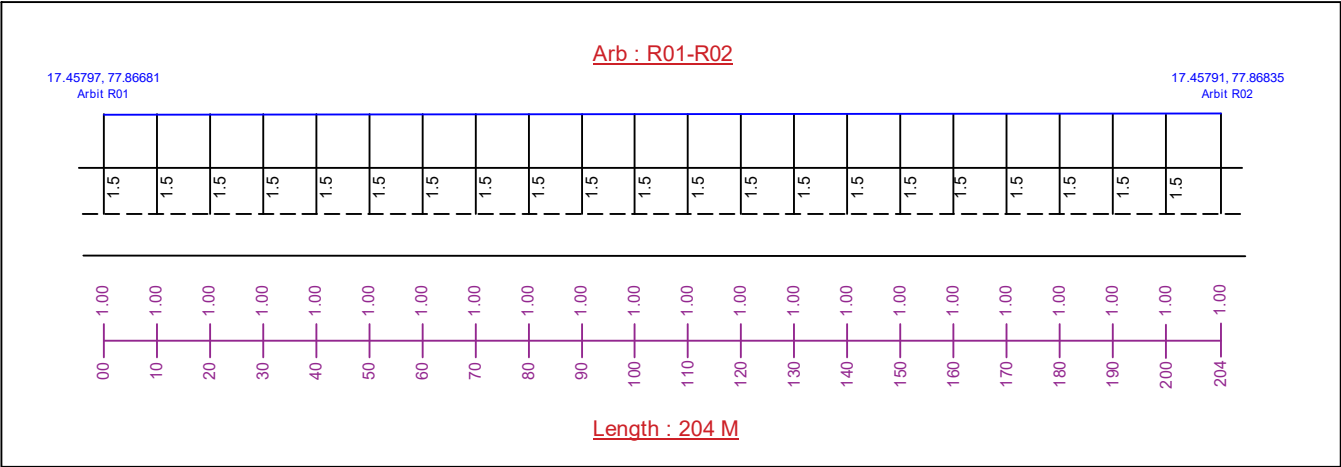

Checked	Designation	Signature


ROAD OFFSET DETAILING FOR DURGAMCHERUVU OHSR2 (MOMINPET)

Arb : R03-R06

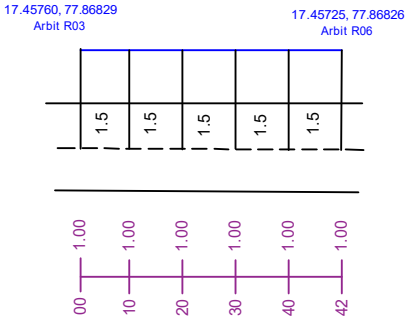


Length : 42 M

Arb : R06-R07

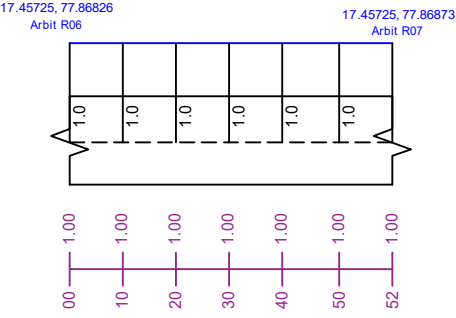


Length : 52 M

Arb : R07-R07(a)

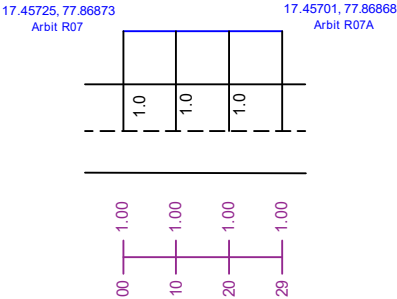


Length : 29 M

Arb : R07-R05

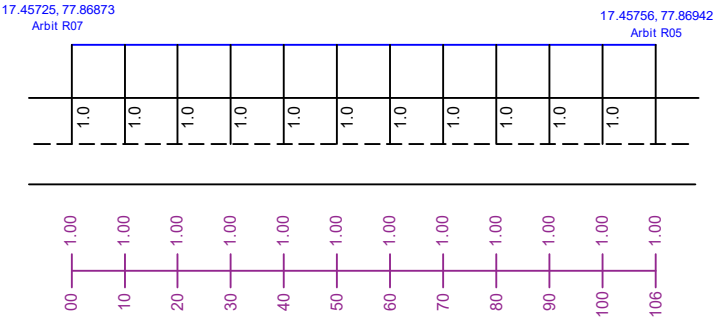


Length : 106 M

Arb : R06-R08

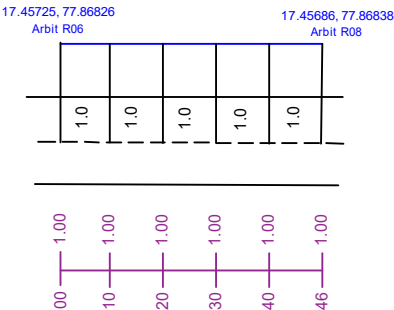

Length : 46 M


Arb : R08-R09

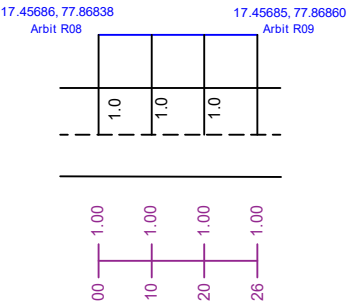

Length : 26 M

Checked	Designation	Signature



ROAD OFFSET DETAILING FOR DURGAMCHERUVU OHSR2 (MOMINPET)

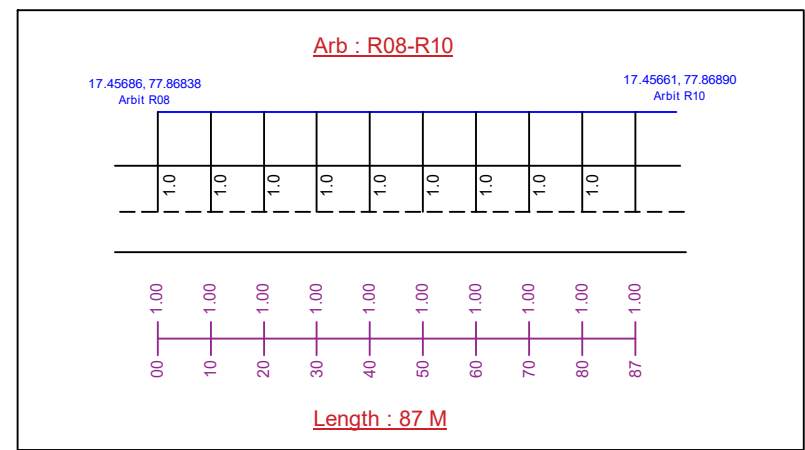

Sheet No. 03
Route Distance: 3261 M

Checked	Designation	Signature

SINGLELINE LOOP DIAGRAM FOR DURGAMCHERUVU OHSR3 (MOMINPET)

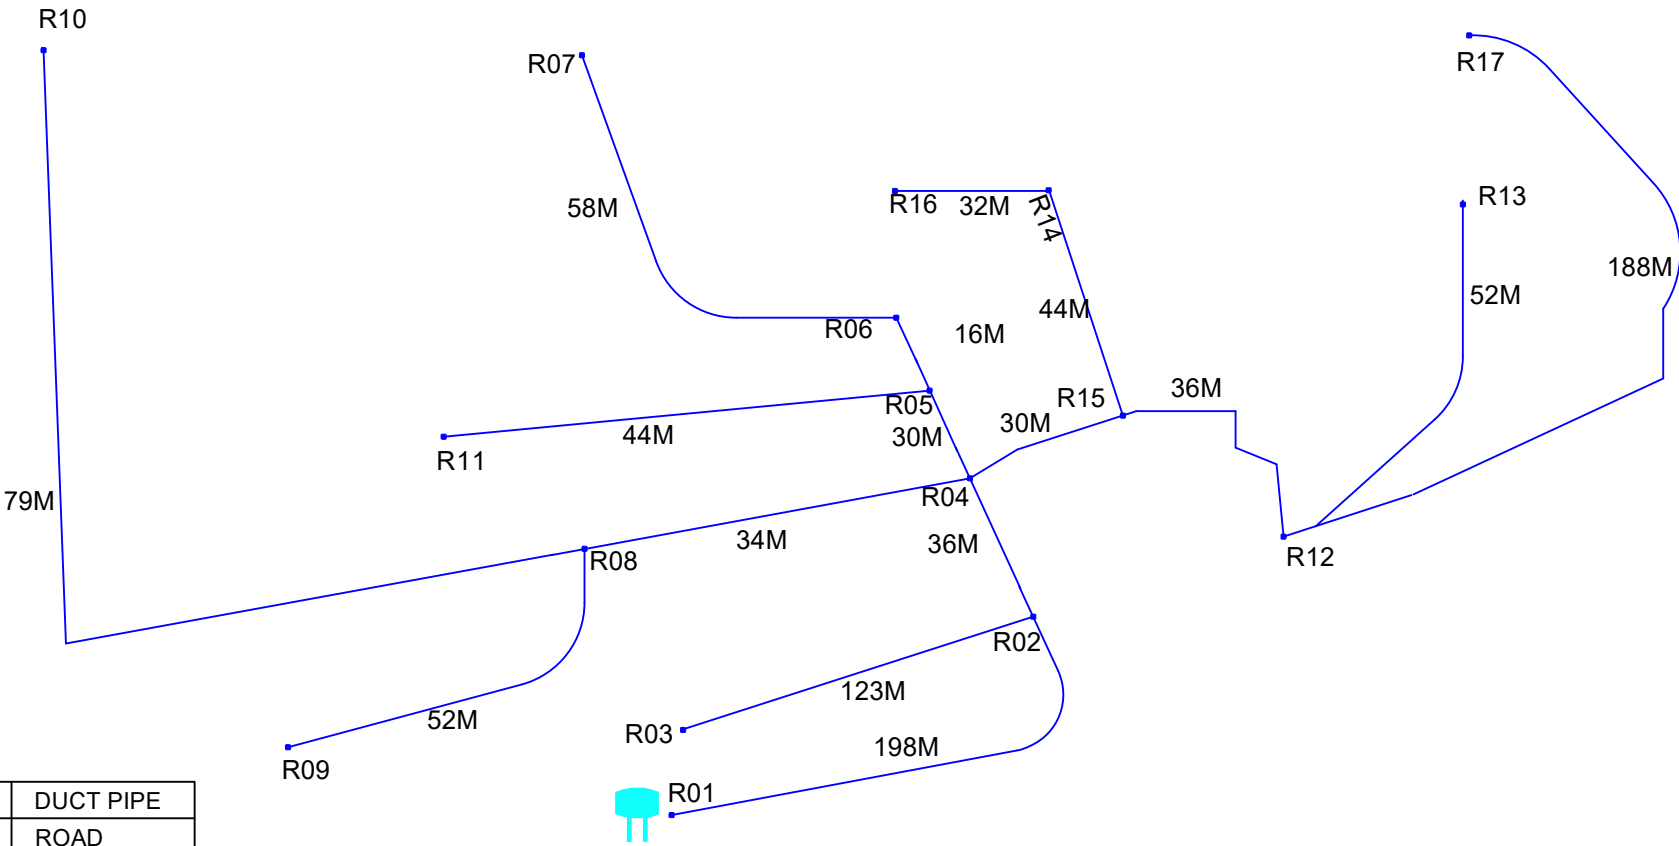
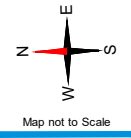








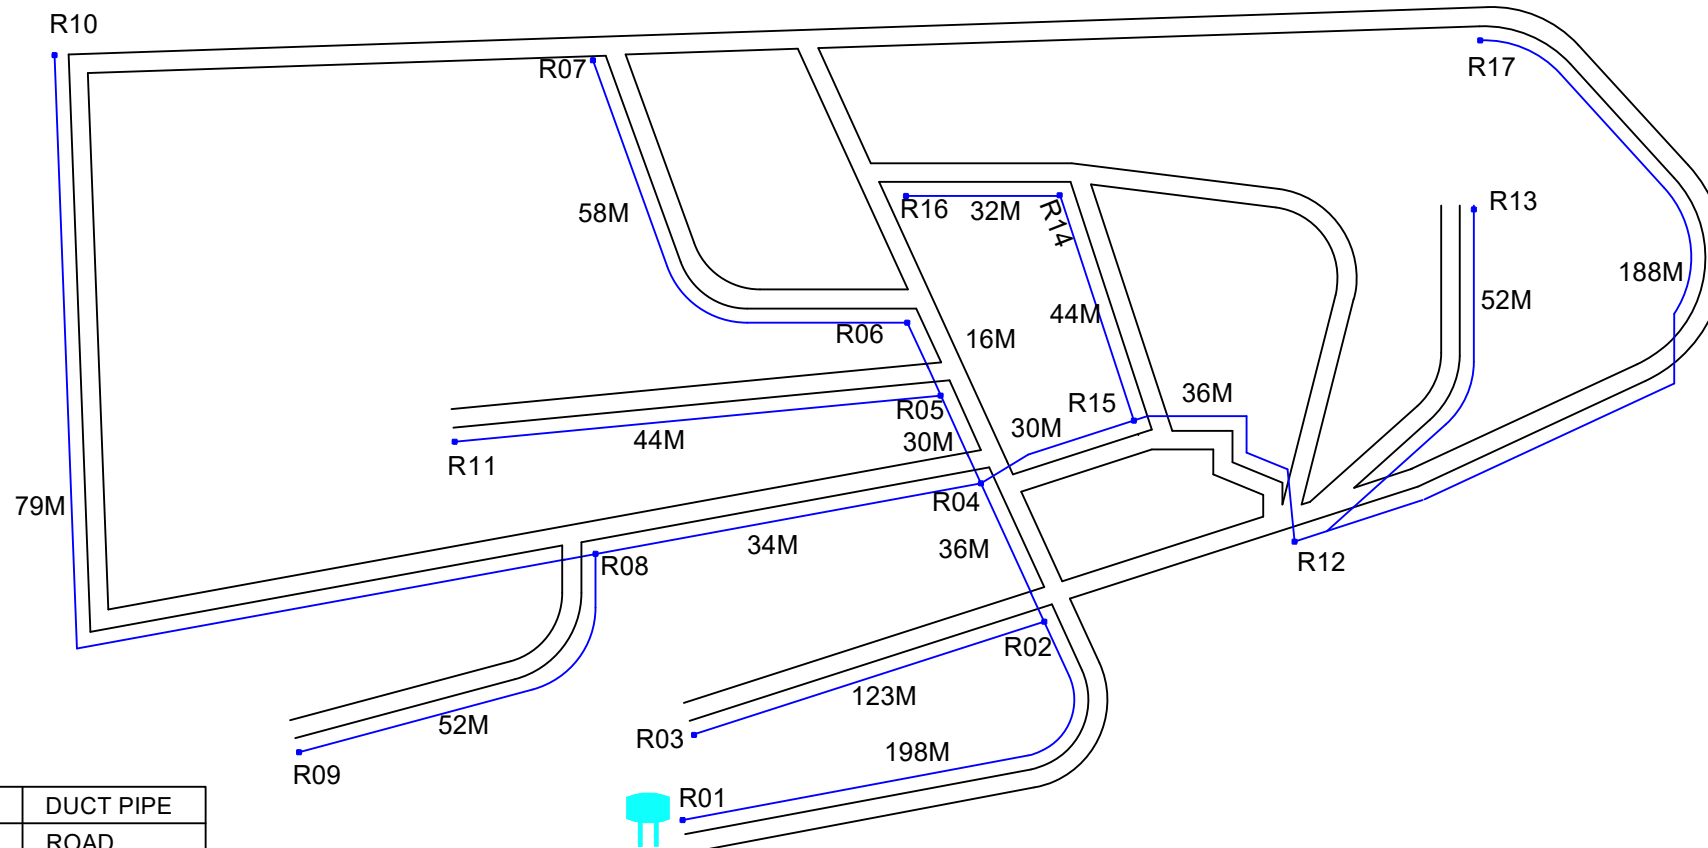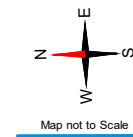

	DUCT PIPE
	ROAD
	OHSR
	G.P OFFICE
	TEMPLE
	HOSPITAL
	SCHOOL
	DUCT GAP

Sheet No. 01
Route Distance : 3261 M

Checked	Designation	Signature

DUCTLAYING ROUTE DIAGRAM FOR DURGAMCHERUVU OHSR3 (MOMINPET)







	DUCT PIPE
	ROAD
	OHSR
	G.P OFFICE
	TEMPLE
	HOSPITAL
	SCHOOL
	DUCT GAP

Sheet No. 01
Route Distance : 3261 M

Checked	Designation	Signature


ROAD OFFSET DETAILING FOR DURGAMCHERUVU OHSR3 (MOMINPET)

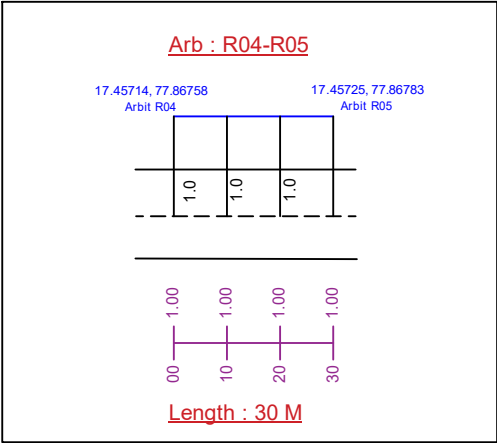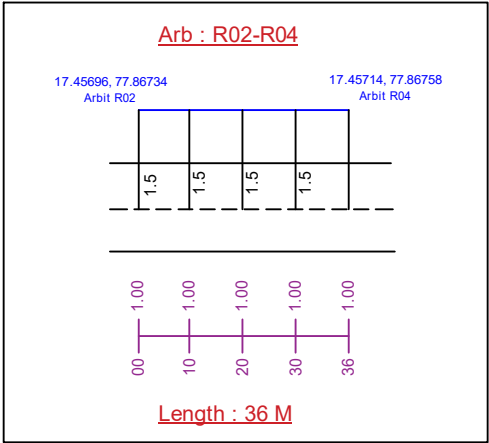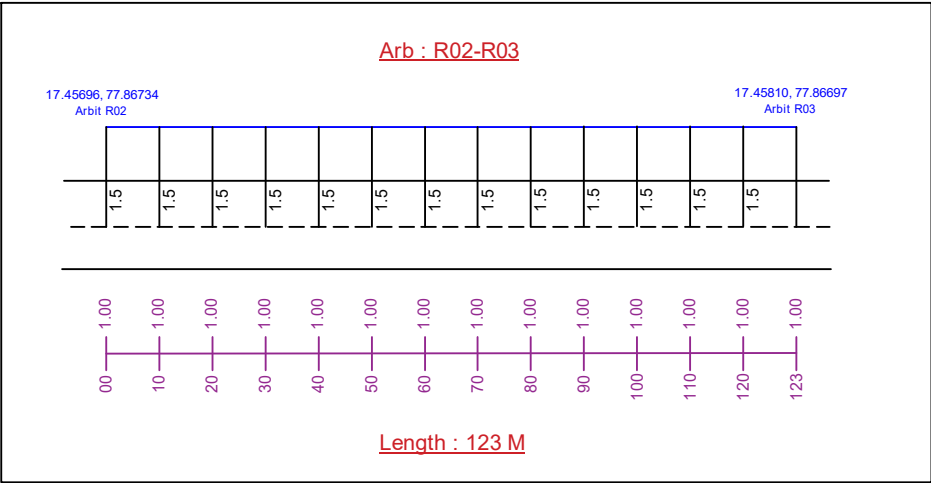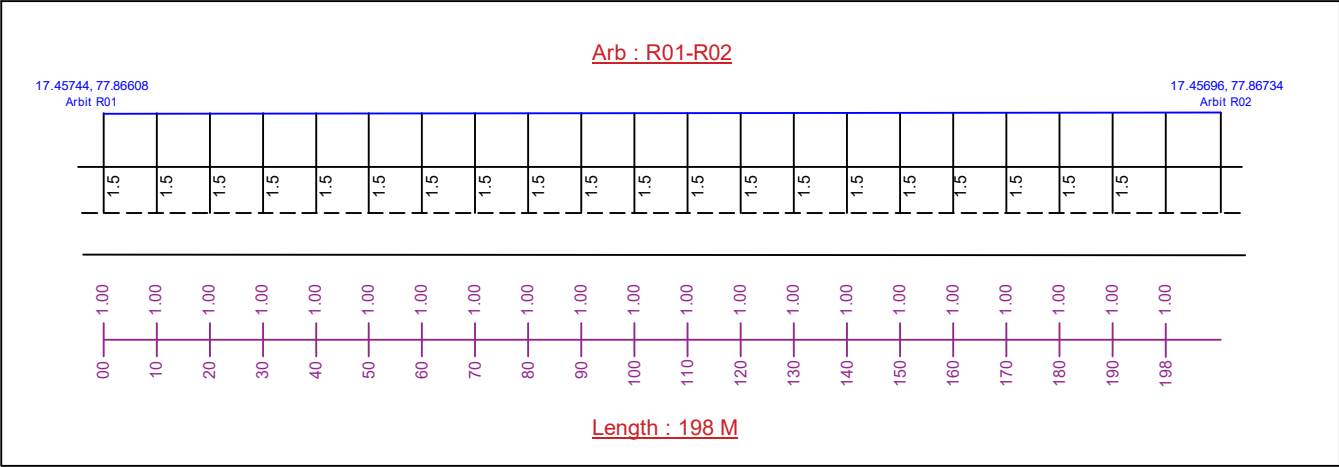


Checked	Designation	Signature

ROAD OFFSET DETAILING FOR DURGAMCHERUVU OHSR3 (MOMINPET)


Arb : R05-R06

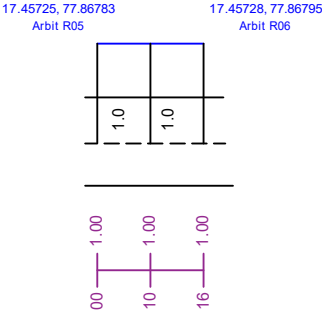


Arb : R06-R07

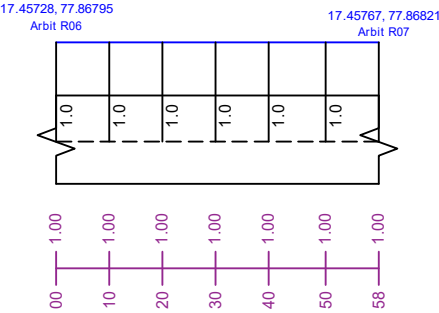


Arb : R04-R08

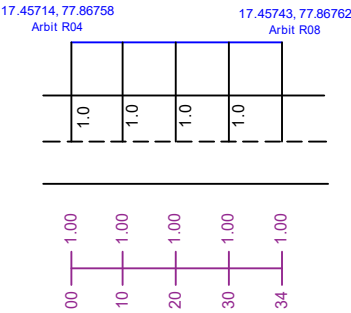


Arb : R08-R09

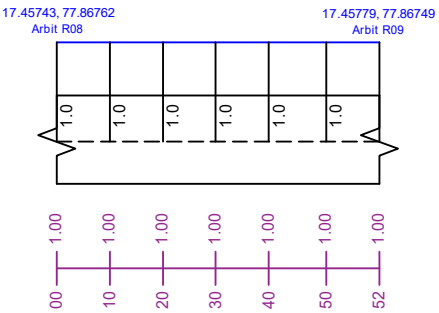


Arb : R08-R10

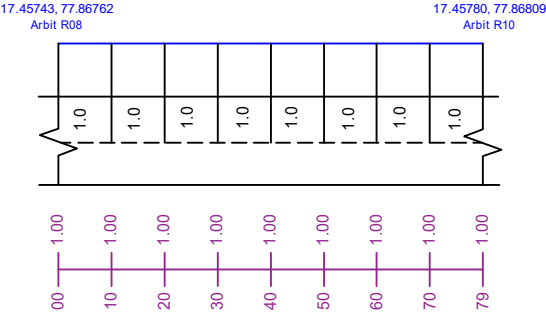

Arb : R05-R11

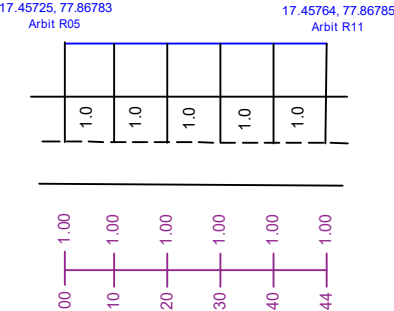


Arb : R06-R07

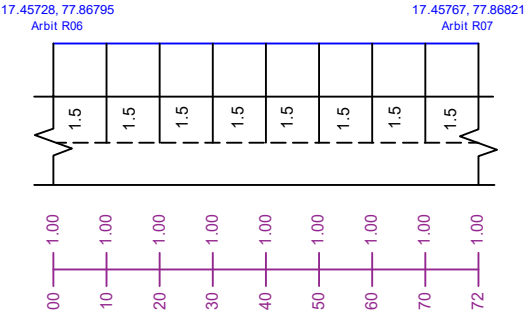


Checked	Designation	Signature

ROAD OFFSET DETAILING FOR DURGAMCHERUVU OHSR3 (MOMINPET)


Arb : R02-R12

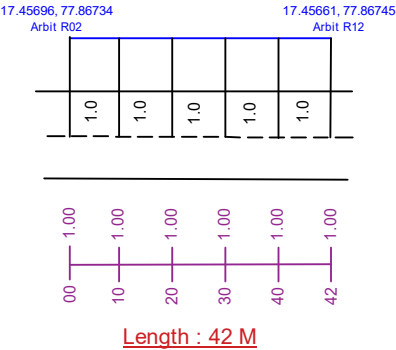


Arb : R12-R13

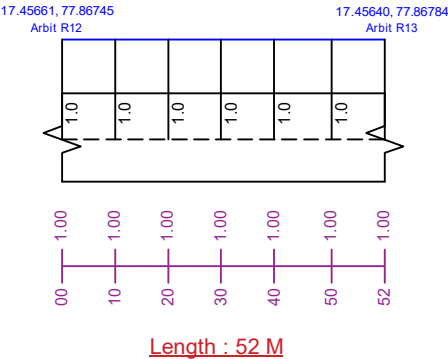


Arb : R12-R15

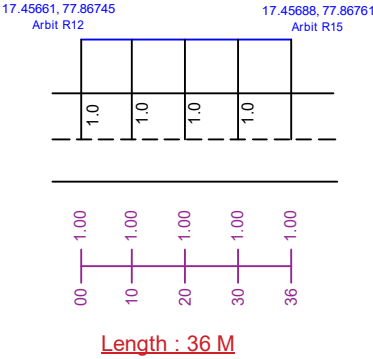


Arb : R04-R15

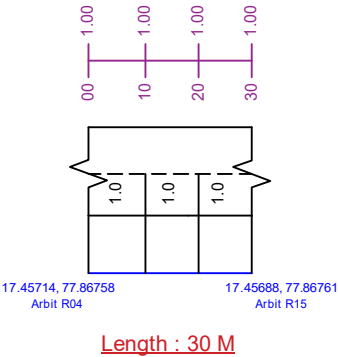

Arb : R14-R15

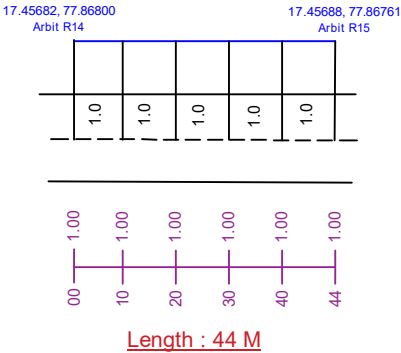

Arb : R12-R14

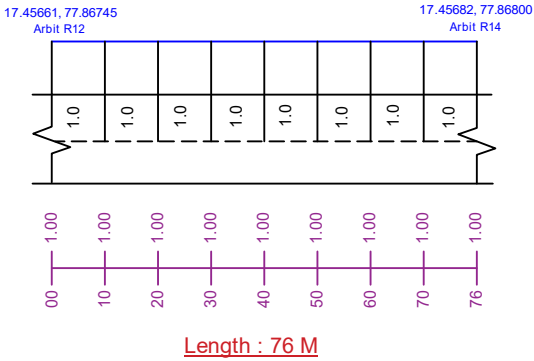


Checked	Designation	Signature

ROAD OFFSET DETAILING FOR DURGAMCHERUVU OHSR3 (MOMINPET)

Arb : R14-R16

17.45682, 77.86800
Arbit R14

17.45706, 77.86808
Arbit R16

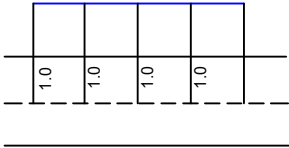


Length : 32 M

Arb : R12-R17

17.45661, 77.86745
Arbit R12

17.45649, 77.86835
Arbit R17

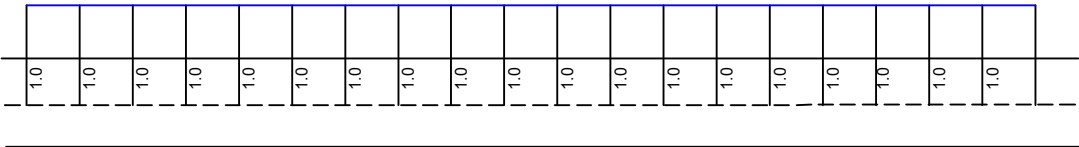

Length : 188 M

Checked	Designation	Signature



TELANGANA FIBER GRID

TELANGANA FIBER GRID

ITE & C GOVERNMENT OF TELANGANA

7th Floor, Splendid Towers, S.P. Road

Opp: Begumpet Police Station,



Begumpet, Hyderabad-500016.







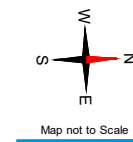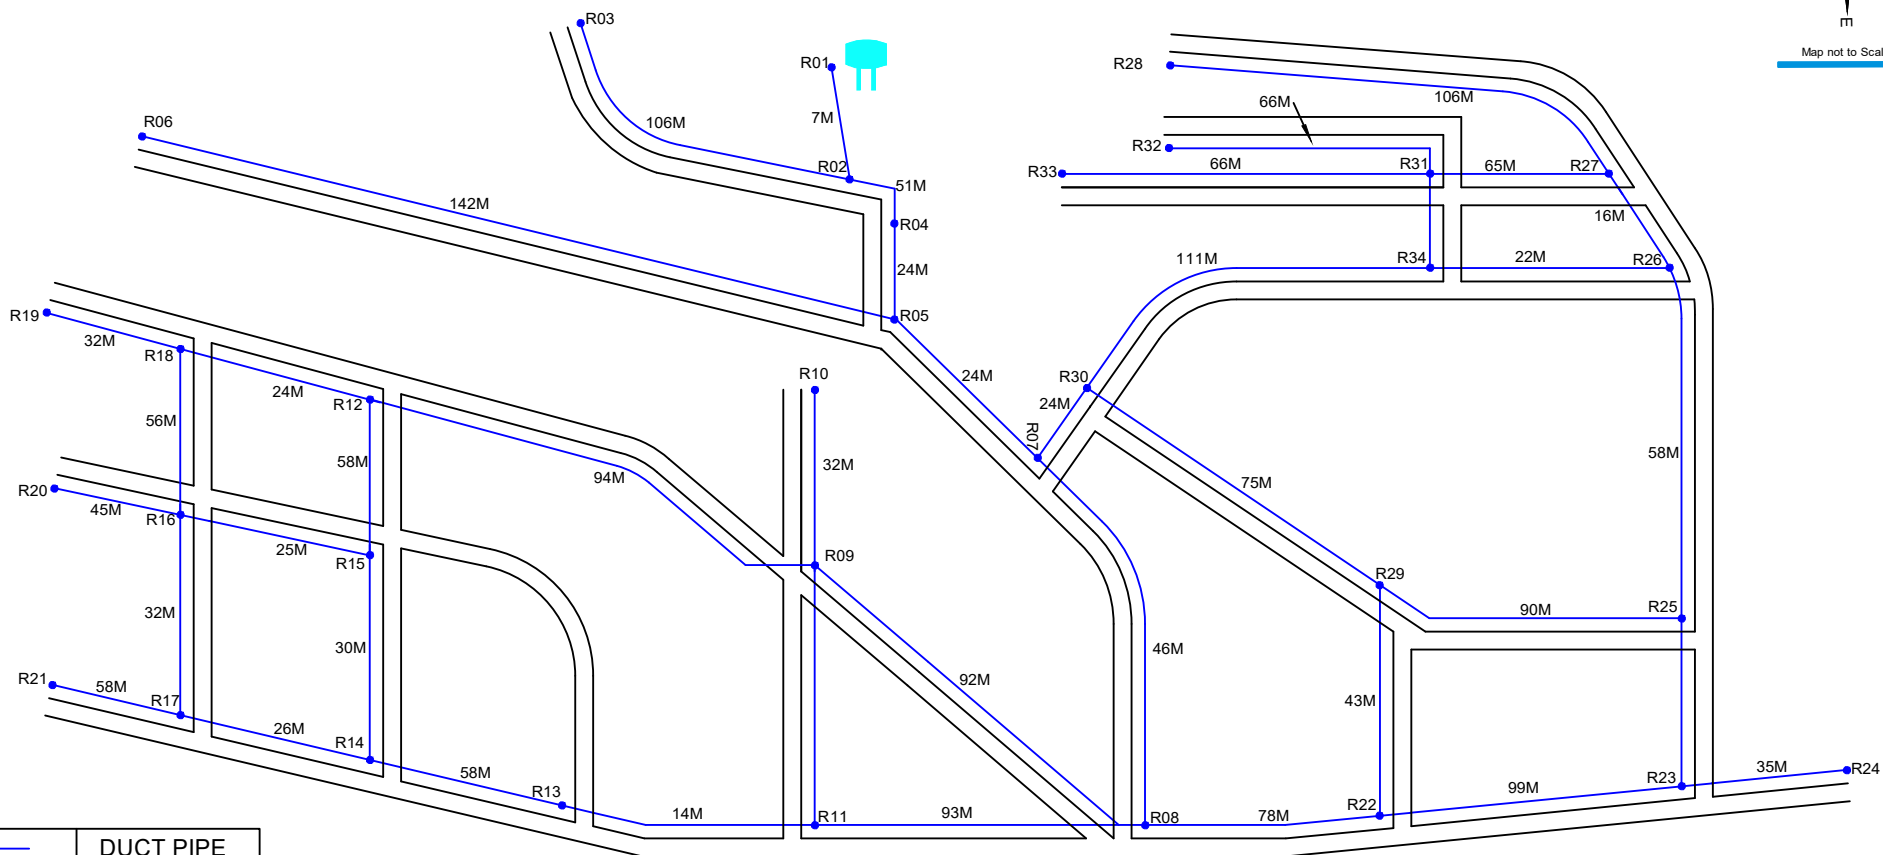

AS - BUILT DRAWINGS (ABD)

GOVINDHAPUR

(MOMINPET MANDAL-VIKARABAD DIST.)

SINGLELINE LOOP DIAGRAM FOR GOVINDHAPUR (MOMINPET)





	DUCT PIPE
	ROAD
	OHSR
	G.P OFFICE
	TEMPLE
	HOSPITAL
	SCHOOL
	DUCT GAP

Checked	Designation	Signature

Sheet No. 01
Route Distance : 2310 M

DUCTLAYING ROUTE DIAGRAM FOR GOVINDHAPUR (MOMINPET)

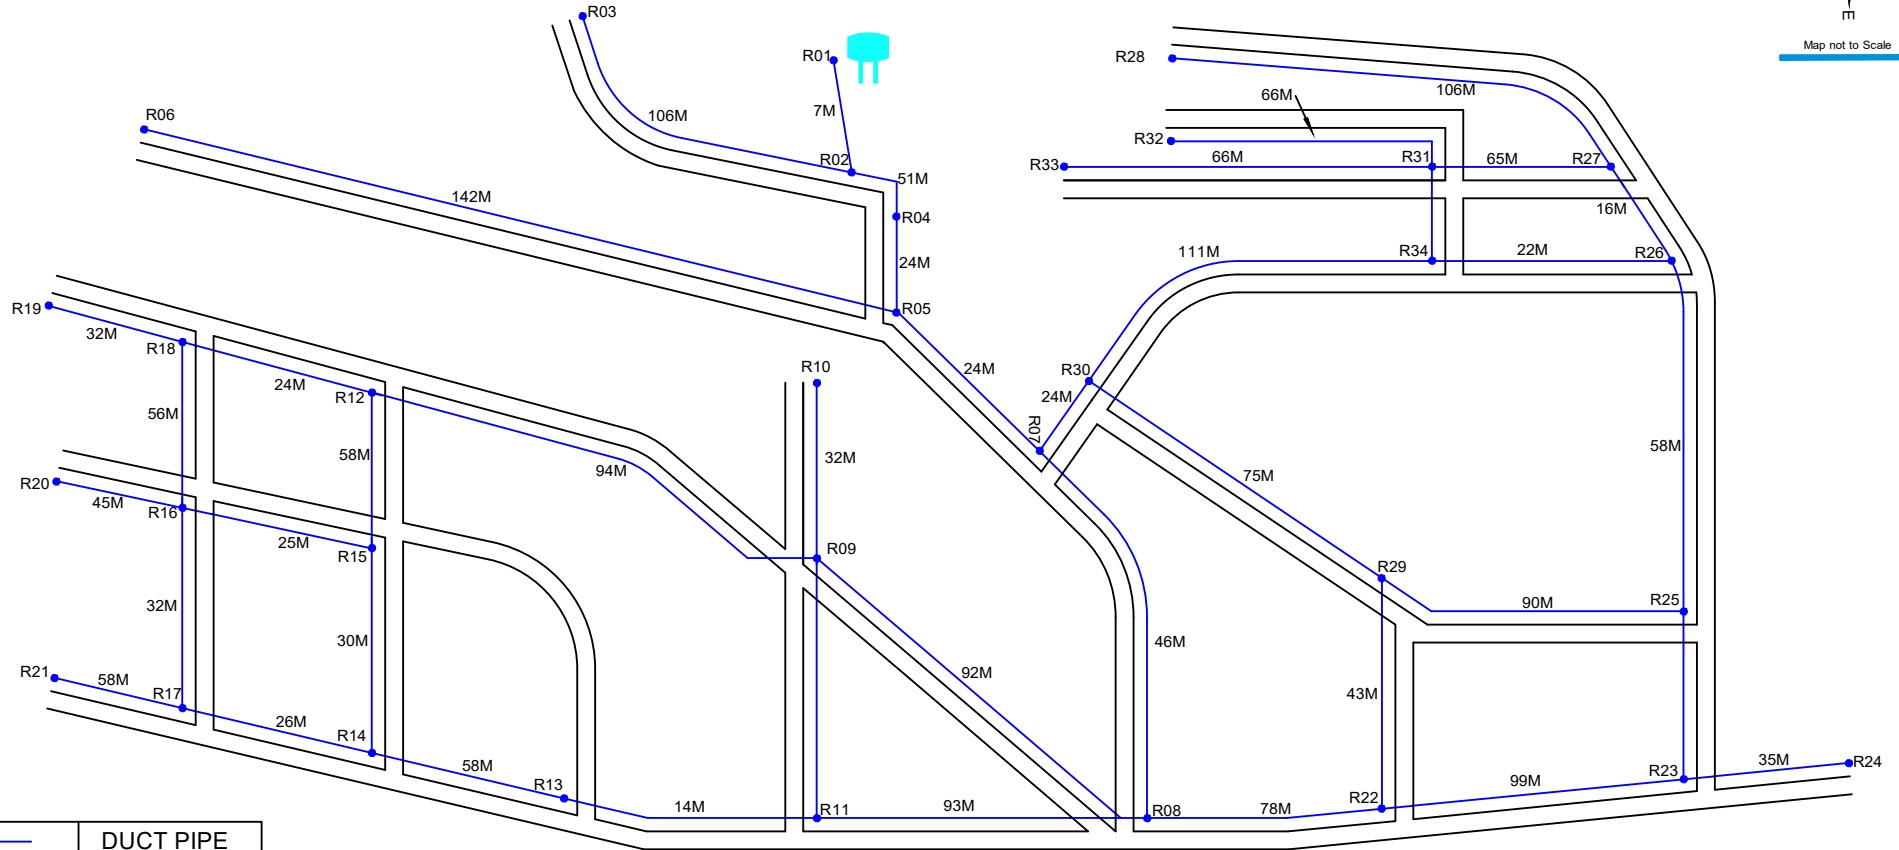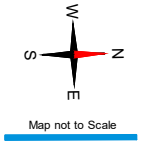


	DUCT PIPE
	ROAD
	OHSR
	G.P OFFICE
	TEMPLE
	HOSPITAL
	SCHOOL
	DUCT GAP

Checked	Designation	Signature


Sheet No. 01
Route Distance : 2310 M

ROAD OFFSET DETAILING FOR GOVINDHAPUR (MOMINPET)


Arb : R01-R02

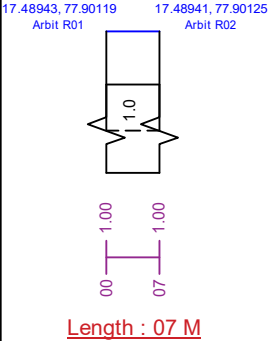


Arb : R02-R03

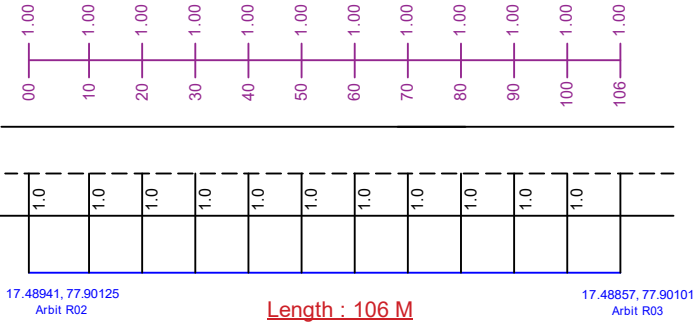


Arb : R02-R04

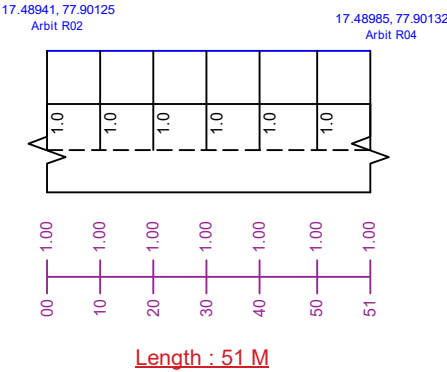

Arb : R04-R05

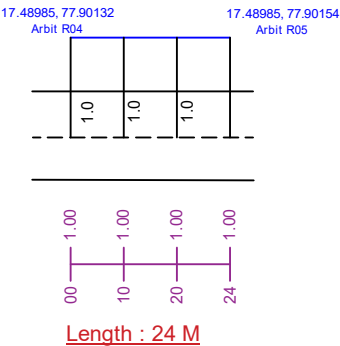


Arb : R05-R06

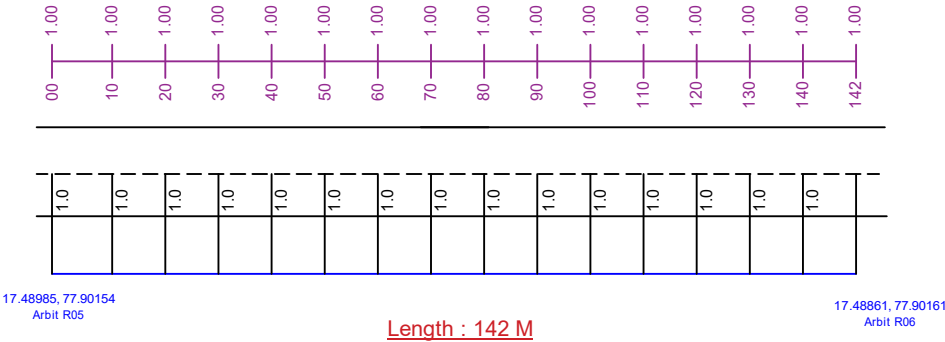


Checked	Designation	Signature

ROAD OFFSET DETAILING FOR GOVINDHAPUR (MOMINPET)


Arb : R05-R07

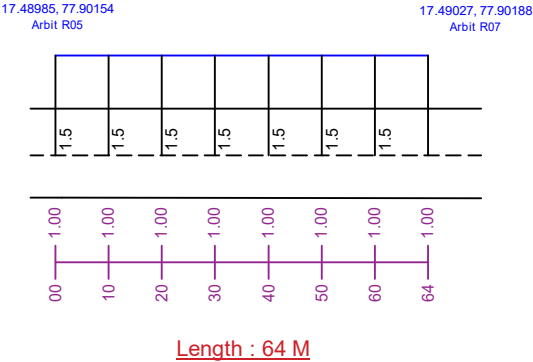


Arb : R07-R08

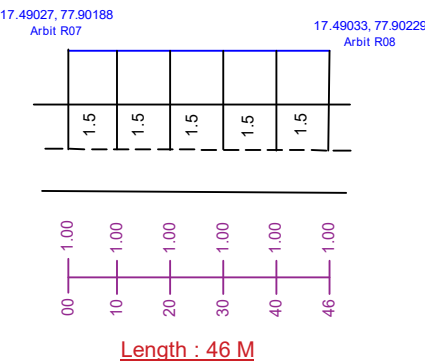


Arb : R08-R09

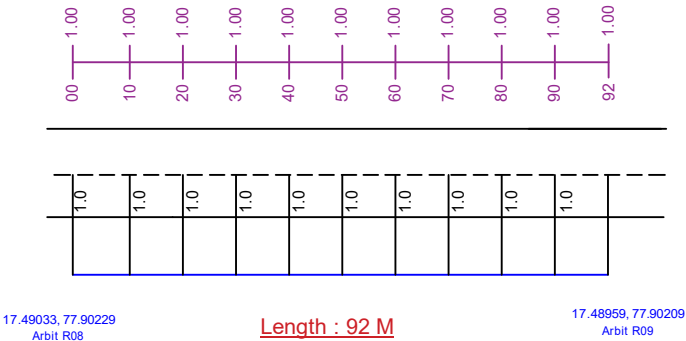


Arb : R09-R10

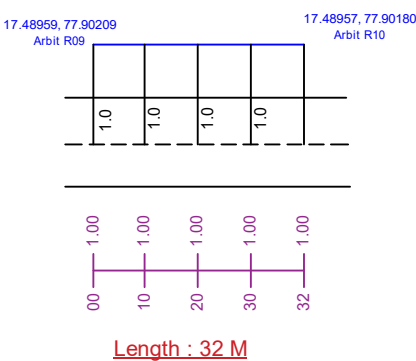

Arb : R09-R11

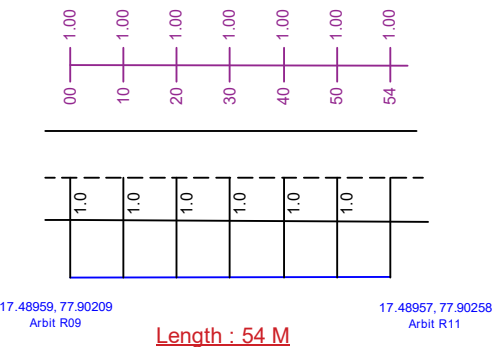


Arb : R08-R11

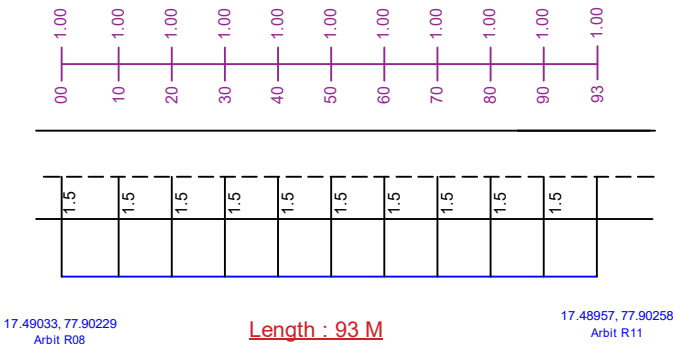


Checked	Designation	Signature

ROAD OFFSET DETAILING FOR GOVINDHAPUR (MOMINPET)


Arb : R09-R12

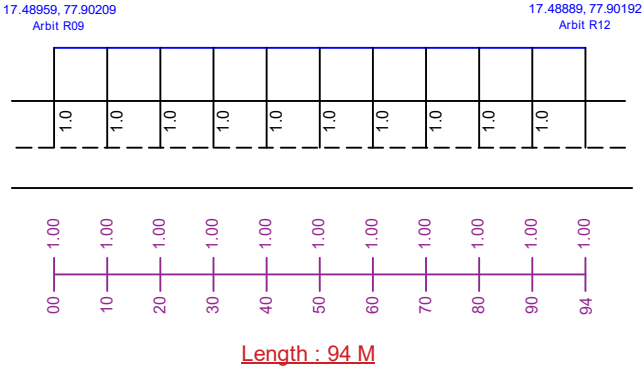


Arb : R11-R14

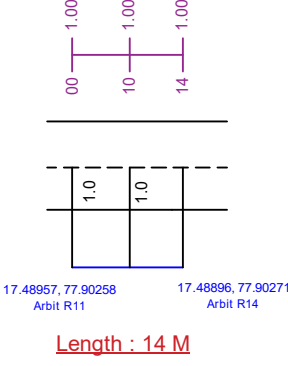


Arb : R13-R14

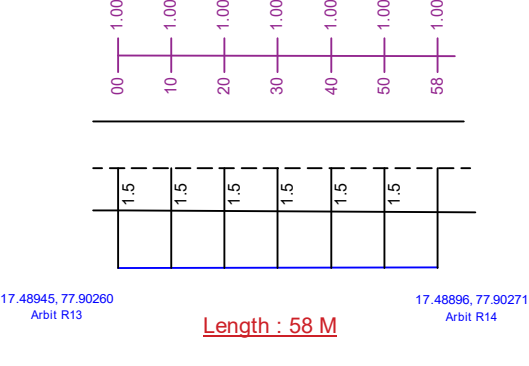


Arb : R14-R15

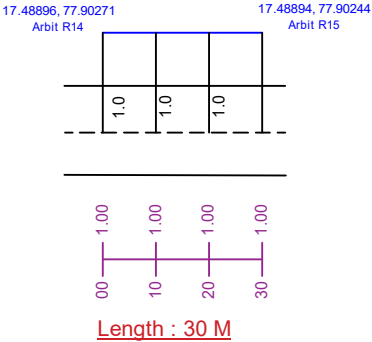


Arb : R15-R12

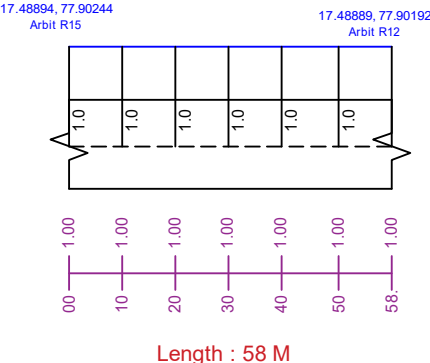

Arb : R15-R16

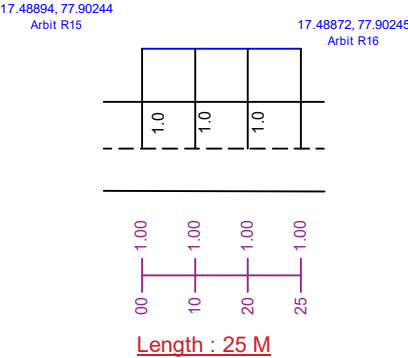

Arb : R16-R17

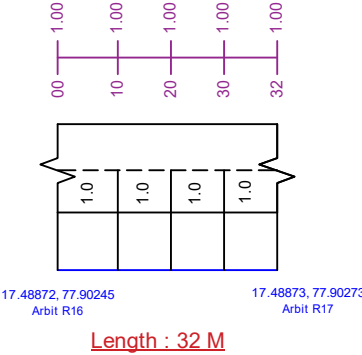


Checked	Designation	Signature

ROAD OFFSET DETAILING FOR GOVINDHAPUR (MOMINPET)

Arb : R16-R18

17.48872, 77.90245
Arbit R16

17.48869, 77.90193
Arbit R18

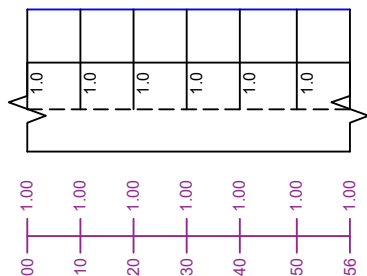


Length : 56 M

Arb : R12-R18

17.48889, 77.90192
Arbit R12

17.48869, 77.90193
Arbit R18

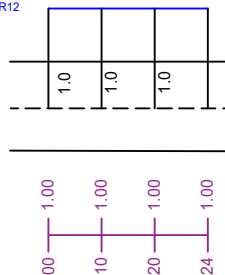


Length : 24 M

Arb : R18-R19

17.26520, 77.46922
Arbit R07

17.26520, 77.46922
Arbit R07

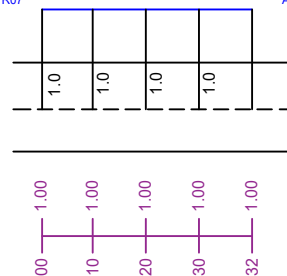


Length : 32 M

Arb : R16-R20


17.48872, 77.90245
Arbit R16

17.48833, 77.90247
Arbit R20

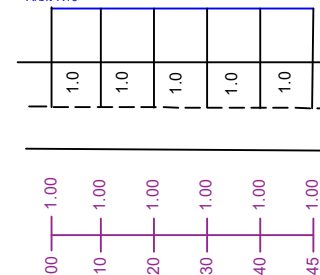

Length : 45 M

Arb : R14-R17

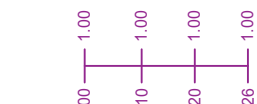


17.48896, 77.90271
Arbit R14

17.48873, 77.90273
Arbit R17

Length : 26 M

Arb : R17-R21

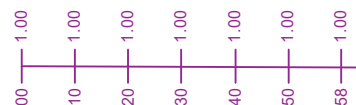

17.48873, 77.90273
Arbit R17


17.48823, 77.90273
Arbit R21

Length : 58 M

Arb : R23-R25

17.49187, 77.90201
Arbit R23

17.49182, 77.90178
Arbit R25

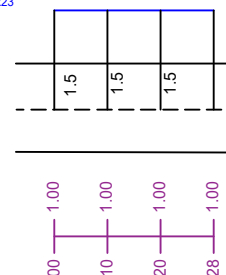


Length : 28 M

Arb : R23-R24

17.49187, 77.90201
Arbit R23

17.49219, 77.90203
Arbit R24

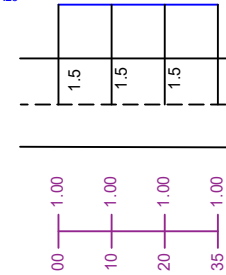


Length : 35 M

Sheet No. 04
Route Distance : 2310 M


Checked	Designation	Signature

ROAD OFFSET DETAILING FOR GOVINDHAPUR (MOMINPET)


Arb : R25-R26

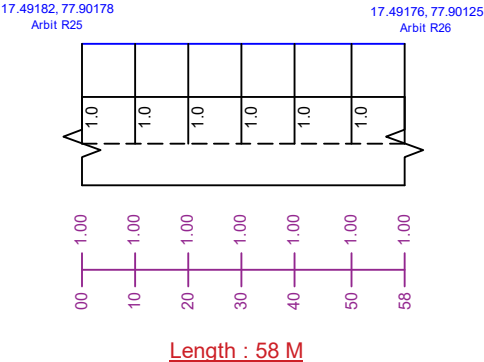


Arb : R26-R27

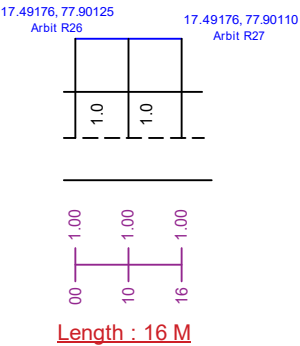


Arb : R27-R28

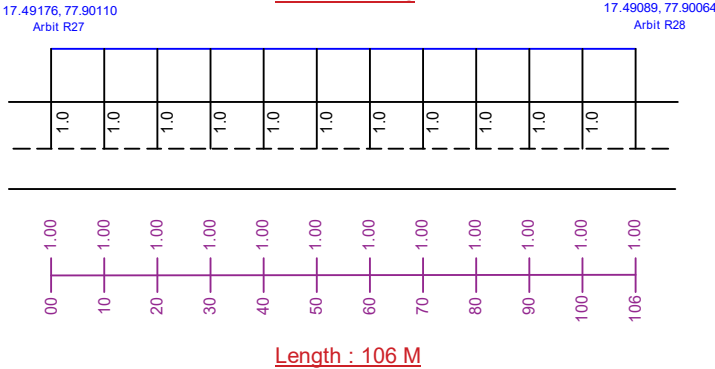


Arb : R27-R28

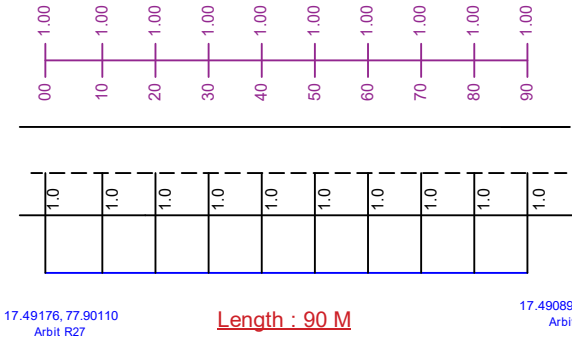

Arb : R22-R29

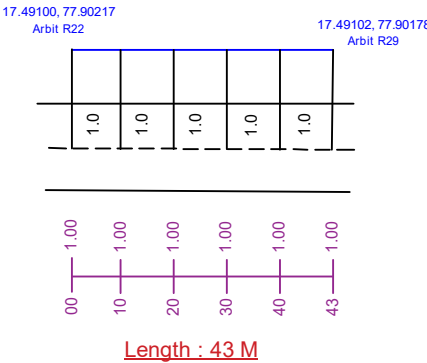


Arb : R29-R30

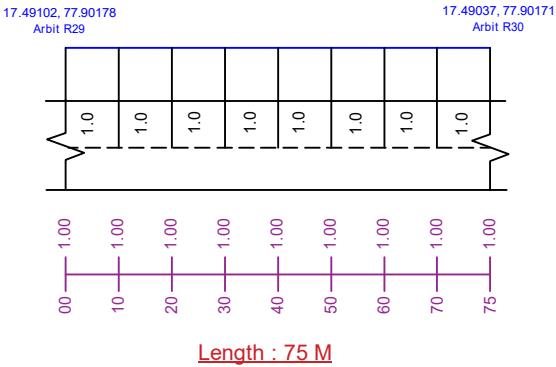


Checked	Designation	Signature

ROAD OFFSET DETAILING FOR GOVINDHAPUR (MOMINPET)


Arb : R07-R30

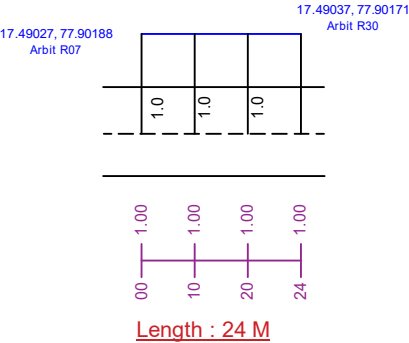


Arb : R27-R31

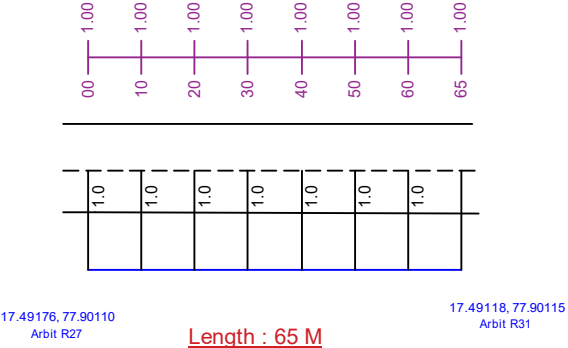


Arb : R31-R32

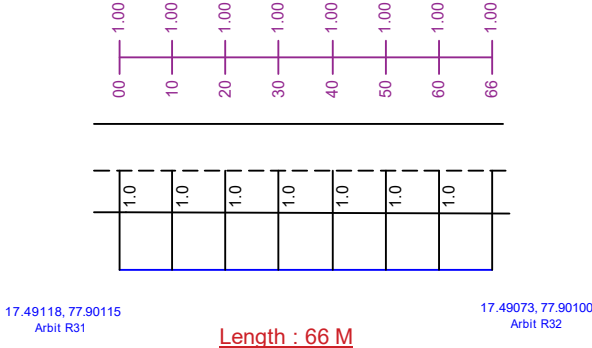


Arb : R31-R33

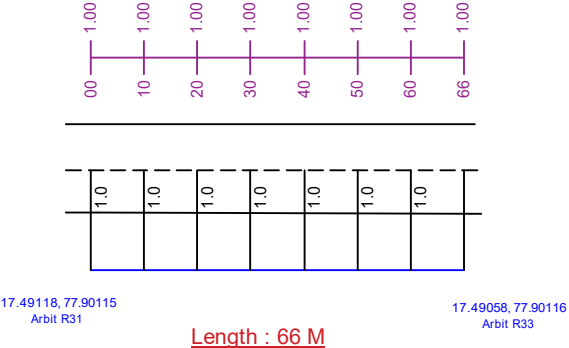

Arb : R26-R34

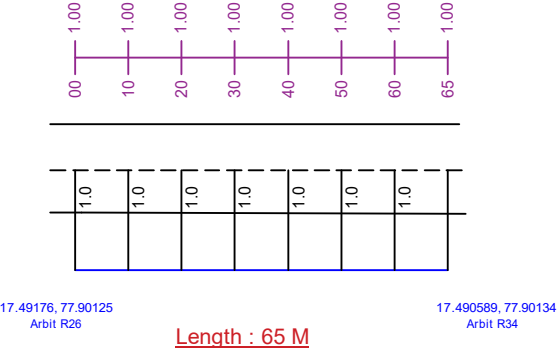


Arb : R31-R34

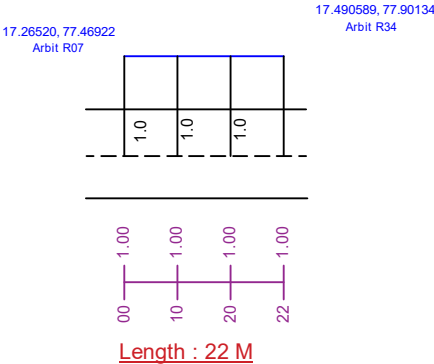

Checked	Designation	Signature

ROAD OFFSET DETAILING FOR GOVINDHAPUR (MOMINPET)

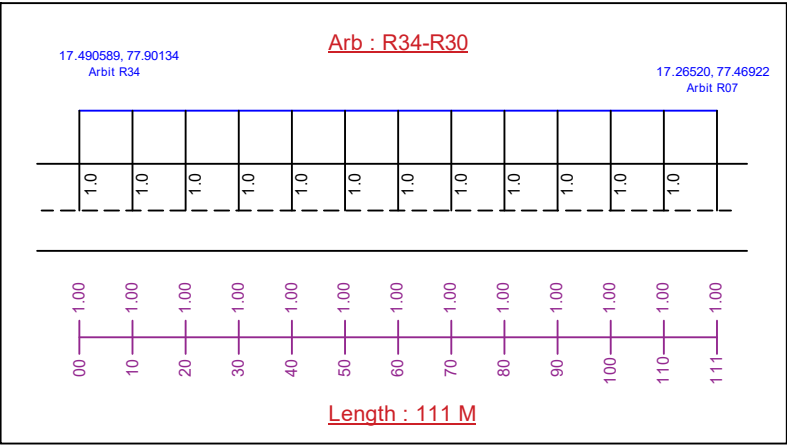

Sheet No. 07
Route Distance : 2310 M

Checked	Designation	Signature



TELANGANA FIBER GRID

TELANGANA FIBER GRID

ITE & C GOVERNMENT OF TELANGANA

7th Floor, Splendid Towers, S.P. Road

Opp: Begumpet Police Station,



Begumpet, Hyderabad-500016.

AS - BUILT DRAWINGS (ABD)

IZRACHITTAMPALLE

(MOMINPET MANDAL-VIKARABAD DIST.)

SINGLELINE LOOP DIAGRAM FOR IZRACHITTAMPALLE (MOMINPET)

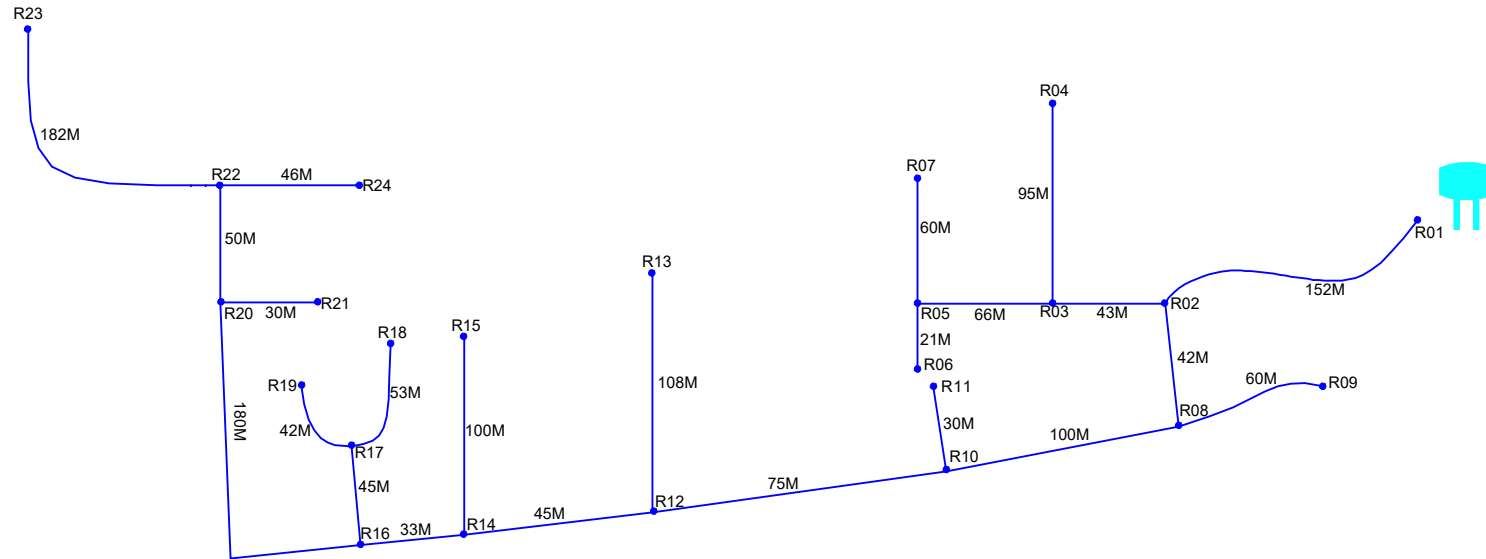
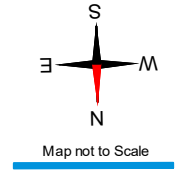










	DUCT PIPE
	ROAD
	OHSR
	G.P OFFICE
	TEMPLE
	HOSPITAL
	SCHOOL
	DUCT GAP

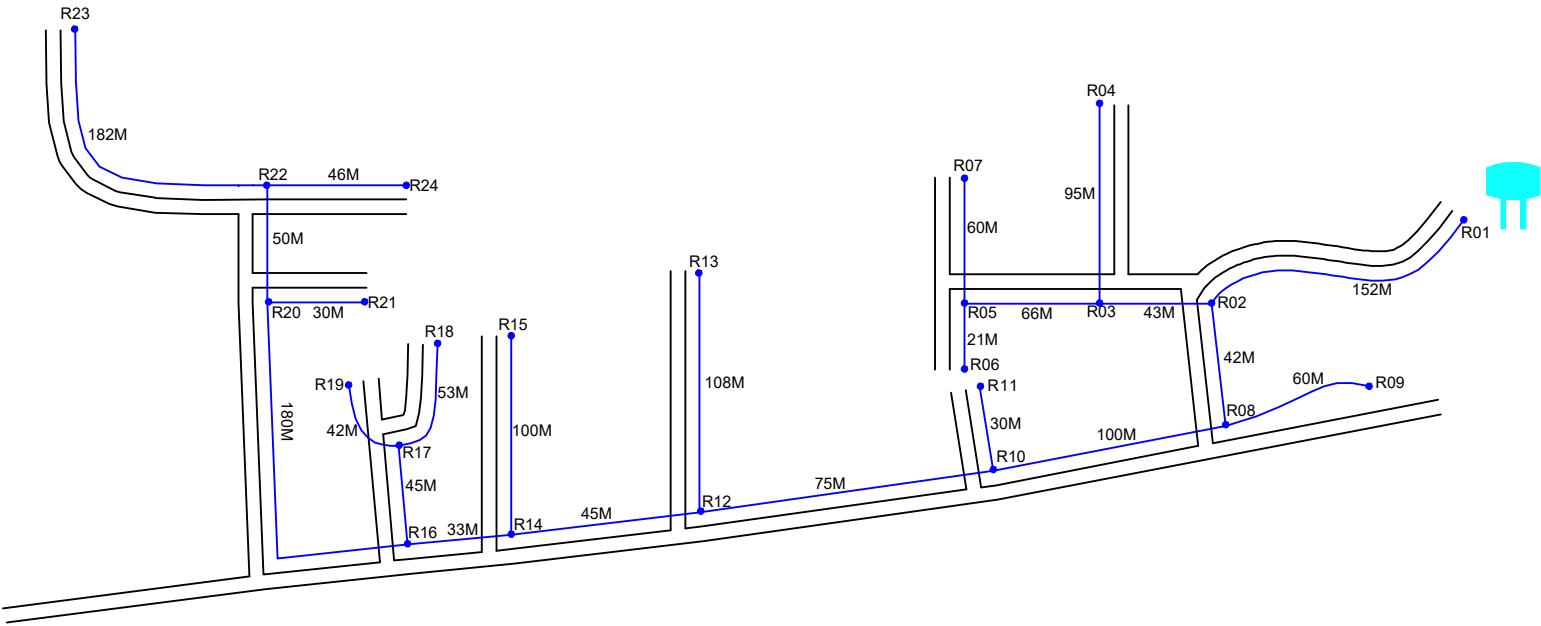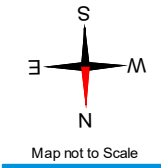Sheet No. 01
Route Distance : 1657 M

  Checked	Designation	Signature

DUCTLAYING ROUTE DIAGRAM FOR IZRACHITTAMPALLE (MOMINPET)








	DUCT PIPE
	ROAD
	OHSR
	G.P OFFICE
	TEMPLE
	HOSPITAL
	SCHOOL
	DUCT GAP

Sheet No. 01
Route Distance : 1657 M

Checked	Designation	Signature


ROAD OFFSET DETAILING FOR IZRACHITTAMPALLE (MOMINPET)

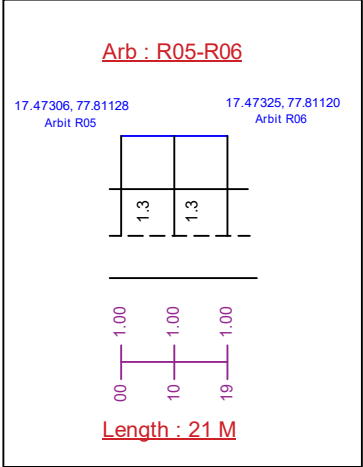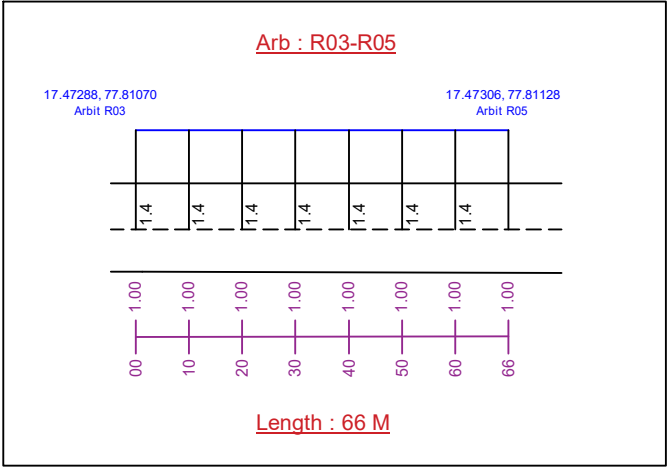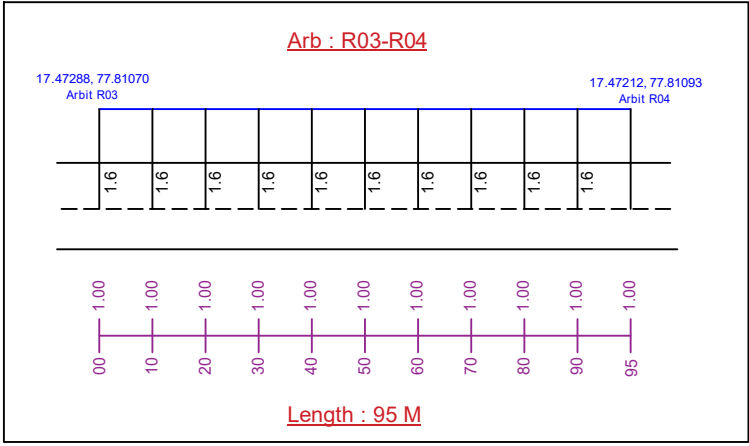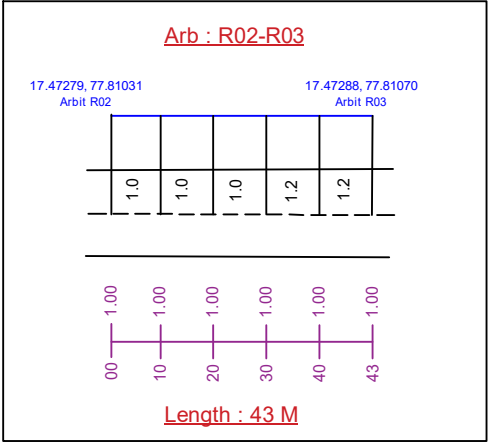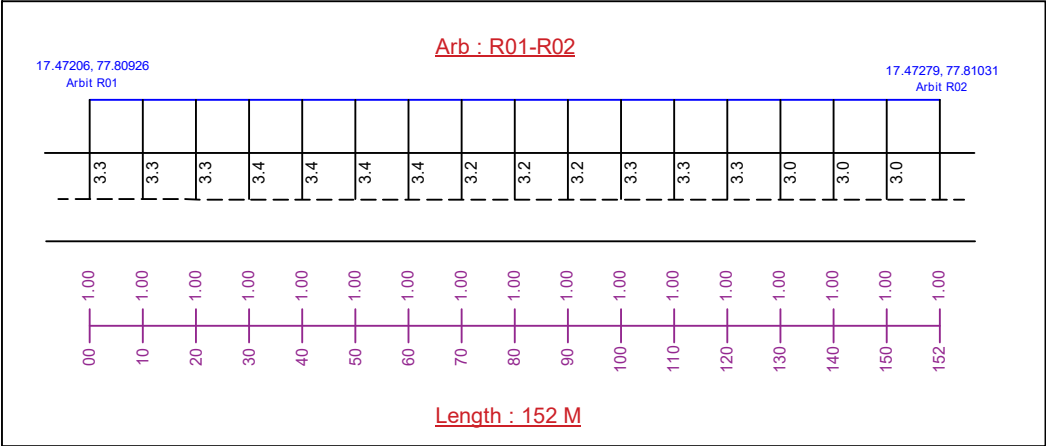

Checked	Designation	Signature


ROAD OFFSET DETAILING FOR IZRACHITTAMPALLE (MOMINPET)

Arb : R05-R07

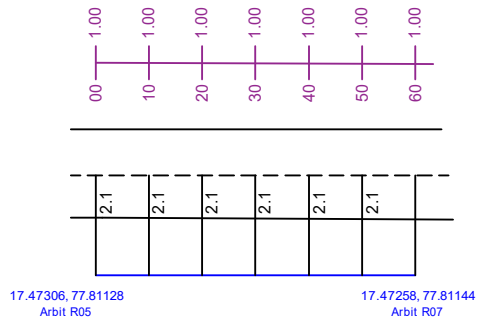


Length : 60 M

Arb : R02-R08

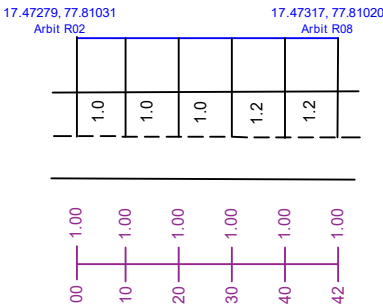


Length : 42 M

Arb : R08-R09

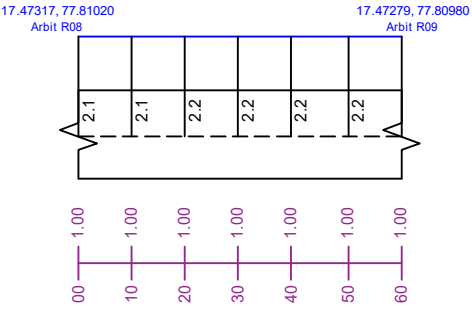


Length : 60 M

Arb : R08-R10

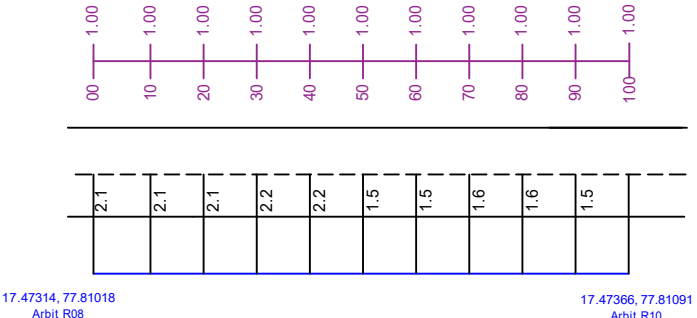


Length : 100 M

Arb : R10-R11

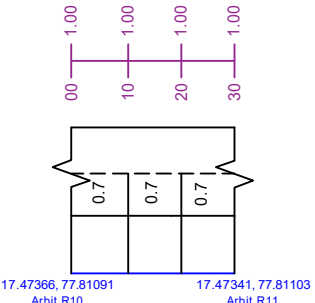

Length : 30 M

Arb : R10-R12






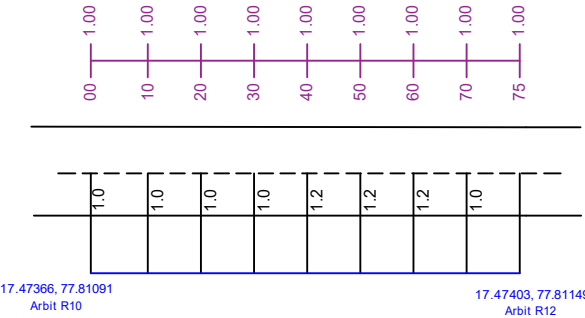


Length : 75 M

Sheet No. 02
Route Distance : 1657 M

Checked	Designation	Signature


ROAD OFFSET DETAILING FOR IZRACHITTAMPALLE (MOMINPET)

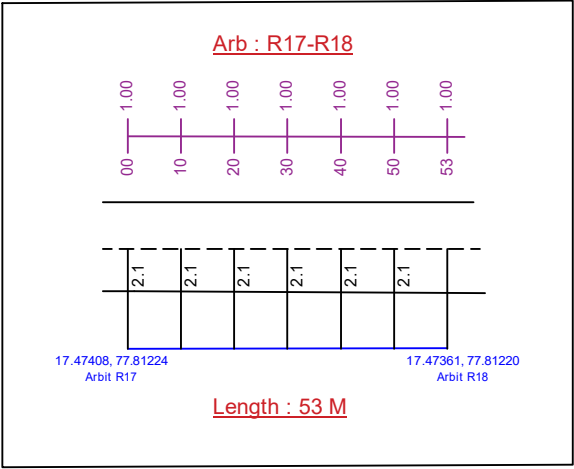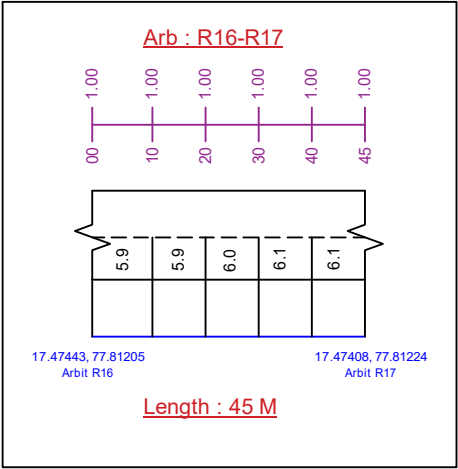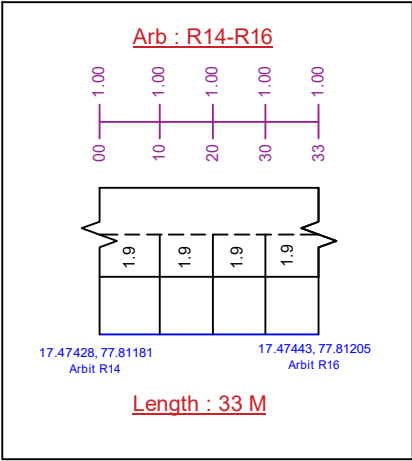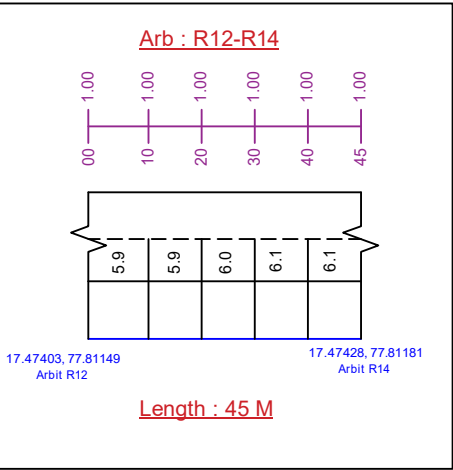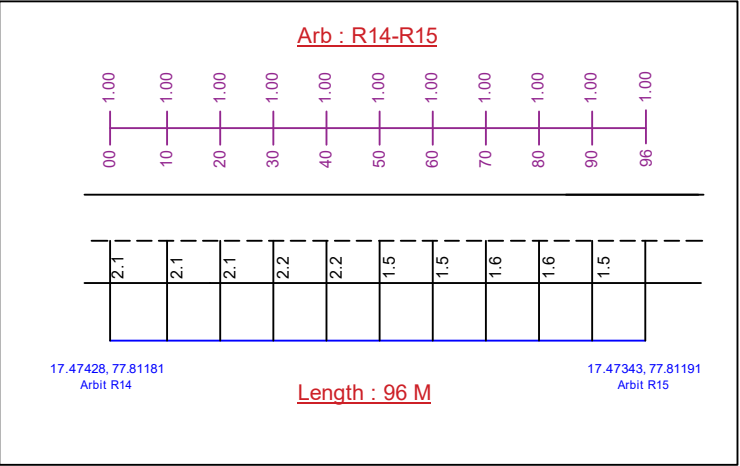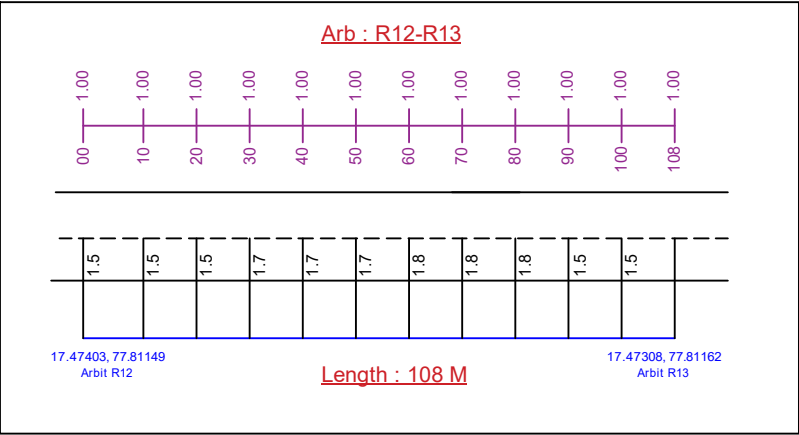


Checked	Designation	Signature

ROAD OFFSET DETAILING FOR IZRACHITTAMPALLE (MOMINPET)


Arb : R17-R19

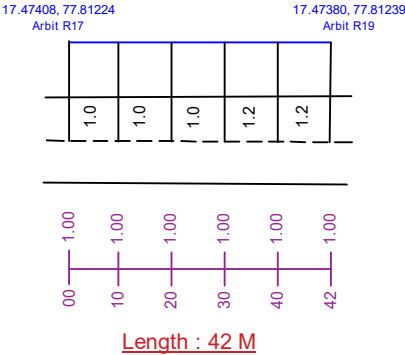


Arb : R16-R20

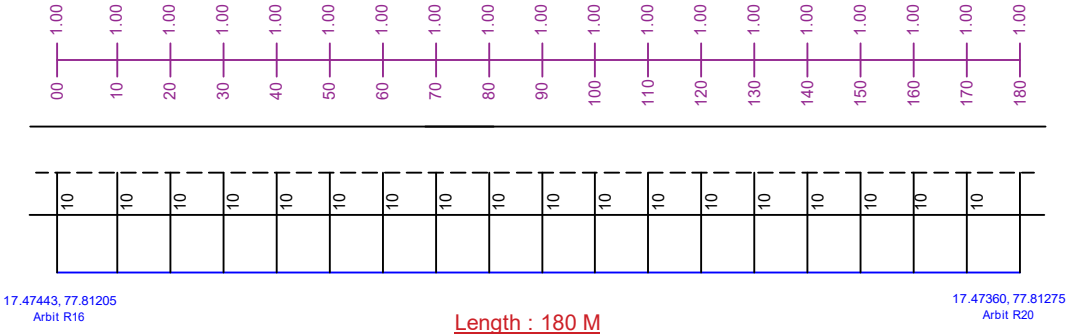


Arb : R20-R21

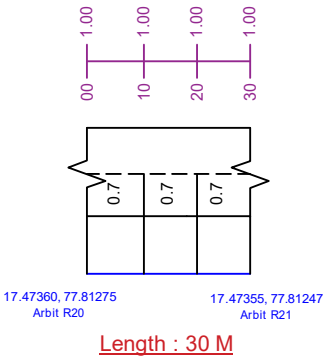

Arb : R20-R22

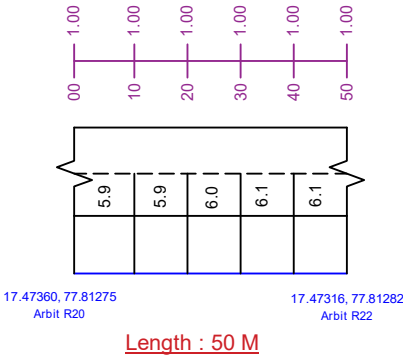


Arb : R22-R23

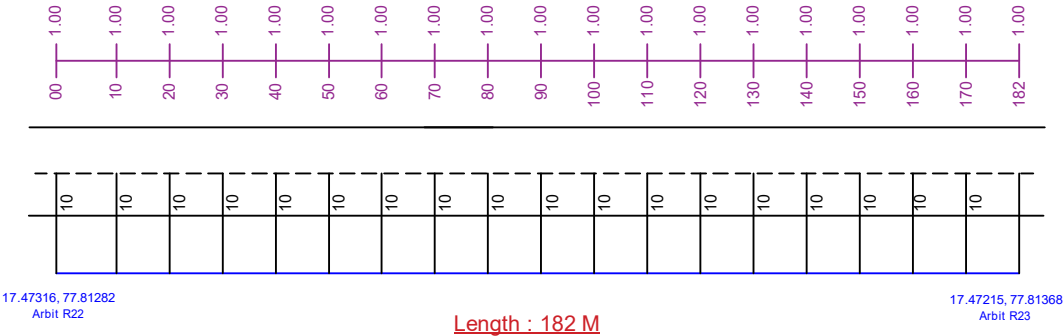

Checked	Designation	Signature

ROAD OFFSET DETAILING FOR IZRACHITTAMPALLE (MOMINPET)

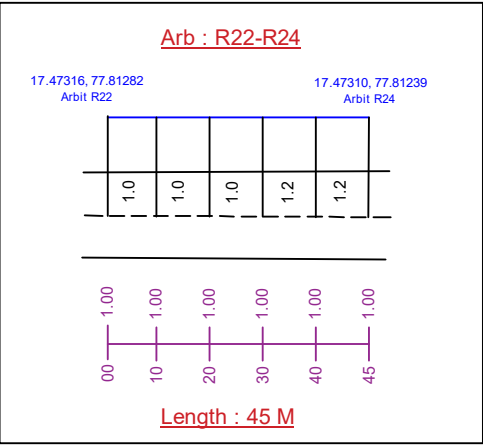

Sheet No. 05
Route Distance : 1657 M

Checked	Designation	Signature



TELANGANA FIBER GRID

TELANGANA FIBER GRID

ITE & C GOVERNMENT OF TELANGANA

7th Floor, Splendid Towers, S.P. Road

Opp: Begumpet Police Station,



Begumpet, Hyderabad-500016.

AS - BUILT DRAWINGS (ABD)

KASALABAD

(MOMINPET MANDAL-VIKARABAD DIST.)

SINGLELINE LOOP DIAGRAM FOR KASALABAD (MOMINPET)

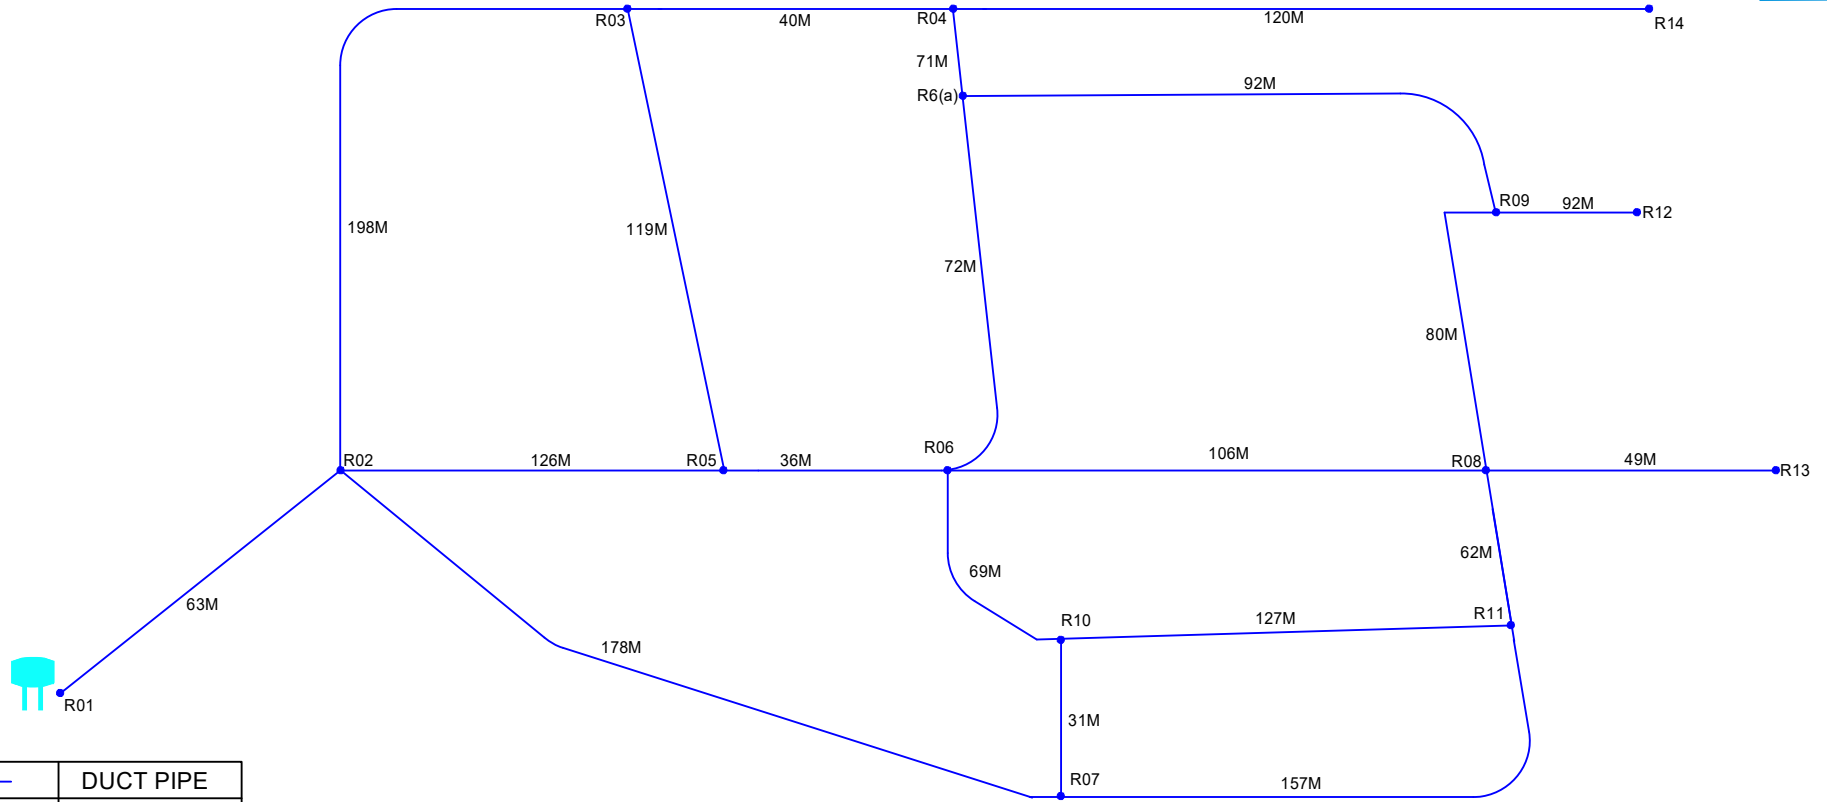
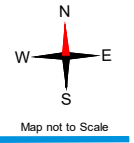


	DUCT PIPE
	ROAD
	OHSR
	G.P OFFICE
	TEMPLE
	HOSPITAL
	SCHOOL
	DUCT GAP

Sheet No. 01
Route Distance : 1872 M

Checked	Designation	Signature

DUCTLAYING ROUTE DIAGRAM FOR KASALABAD (MOMINPET)

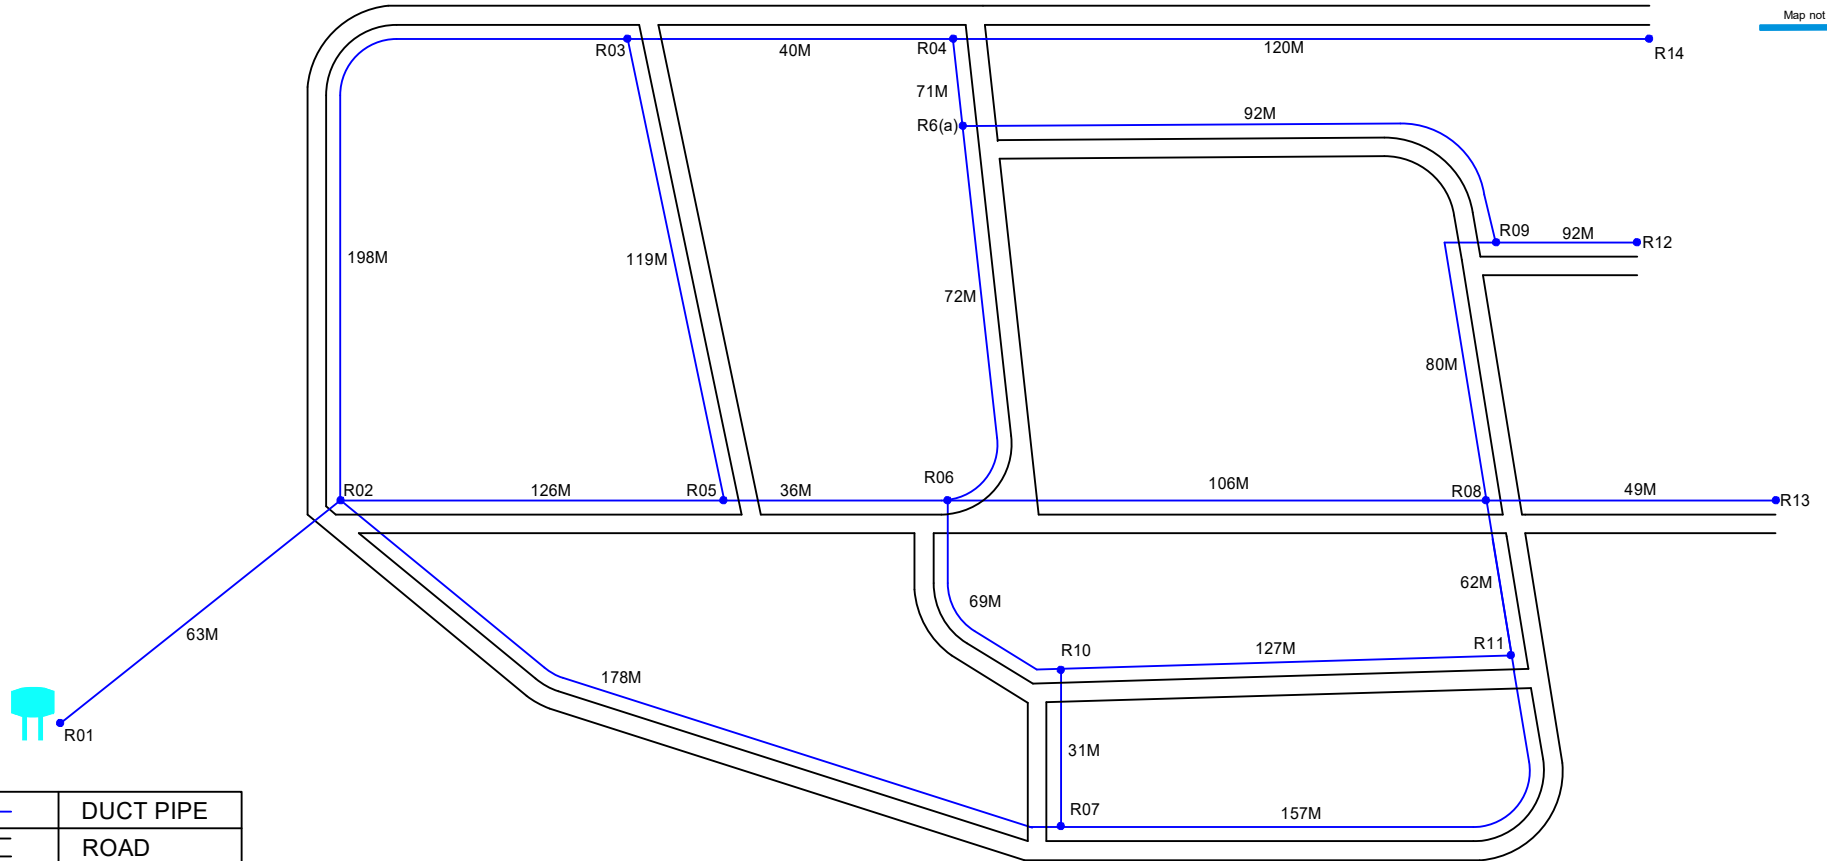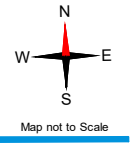


	DUCT PIPE
	ROAD
	OHSR
	G.P OFFICE
	TEMPLE
	HOSPITAL
	SCHOOL
	DUCT GAP

Sheet No. 01
Route Distance : 1872 M

Checked	Designation	Signature


ROAD OFFSET DETAILING FOR KASALABAD (MOMINPET)

Arb : R01-R02

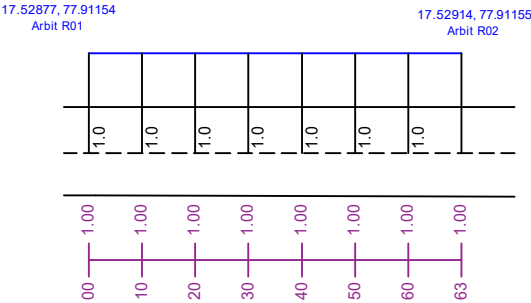

Length : 63 M

Arb : R02-R03

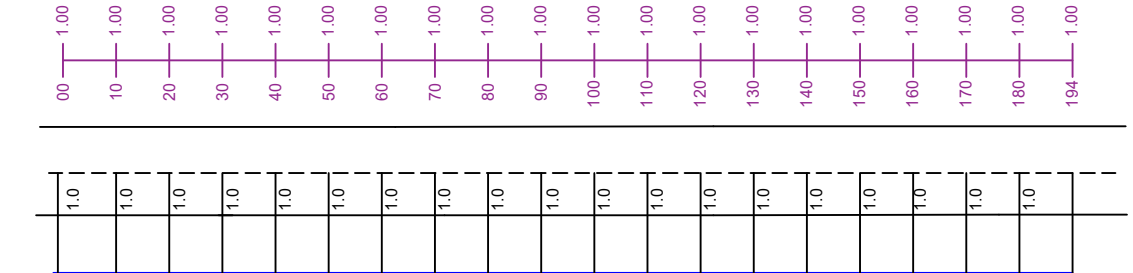


17.52914, 77.91155
Arbit R02

Length : 194 M


17.52999, 77.91230
Arbit R03

Arb : R03-R04

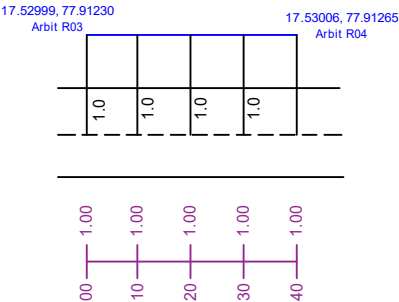


Length : 40 M

Arb : R02-R05

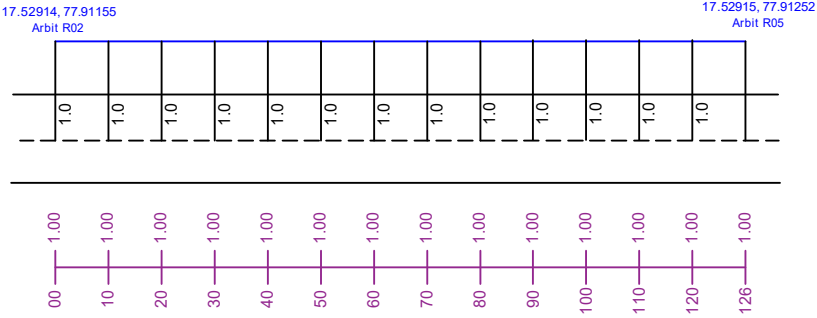

Length : 126 M

Arb : R05-R06

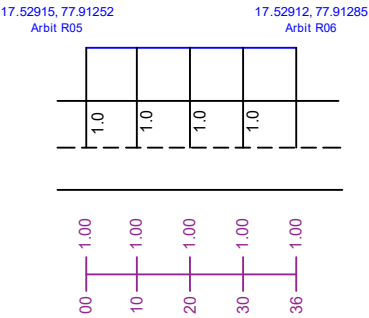


Length : 36 M


Checked	Designation	Signature

ROAD OFFSET DETAILING FOR KASALABAD (MOMINPET)


Arb : R03-R05

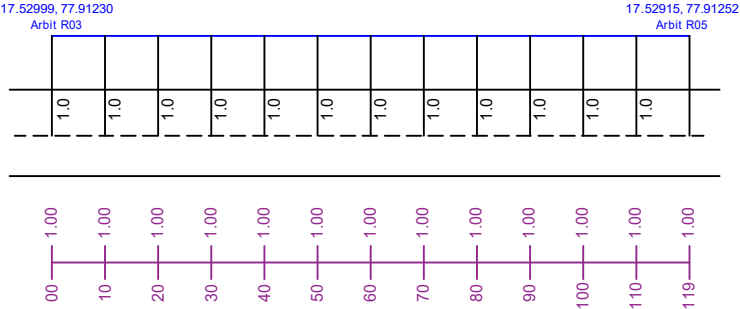


Arb : R04-R6(a)

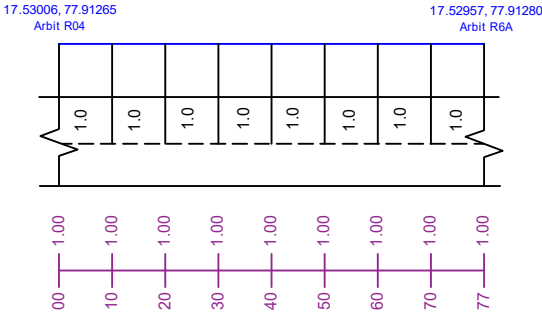


Arb : R6(a)-R06

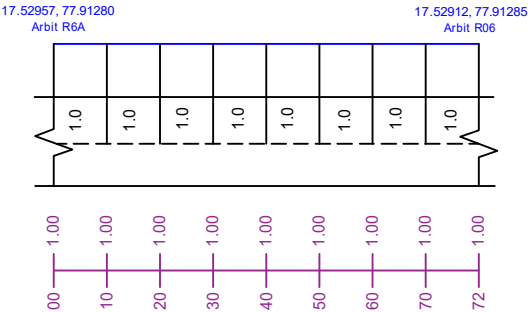

Arb : R02-R07

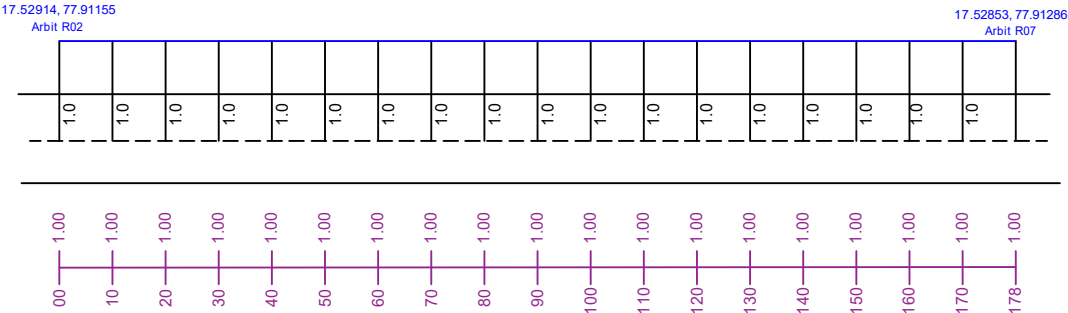





Arb : R06-R08

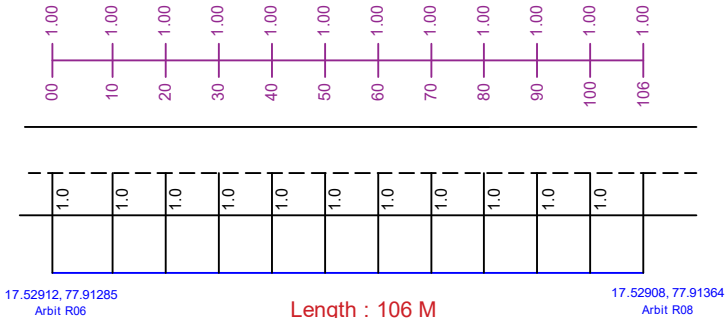

Sheet No. 02
Route Distance : 1872 M

Checked	Designation	Signature


ROAD OFFSET DETAILING FOR KASALABAD (MOMINPET)

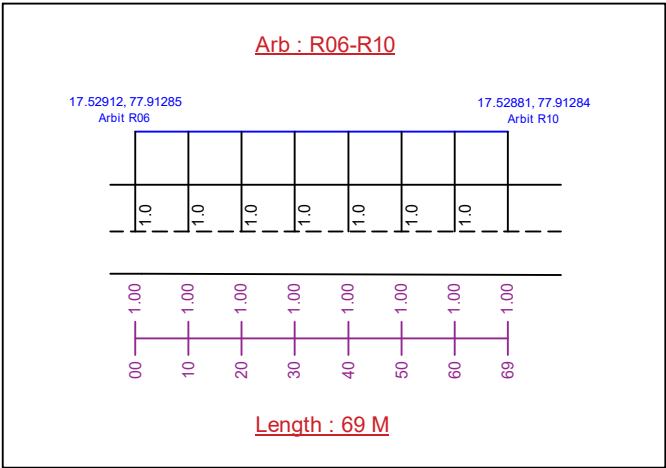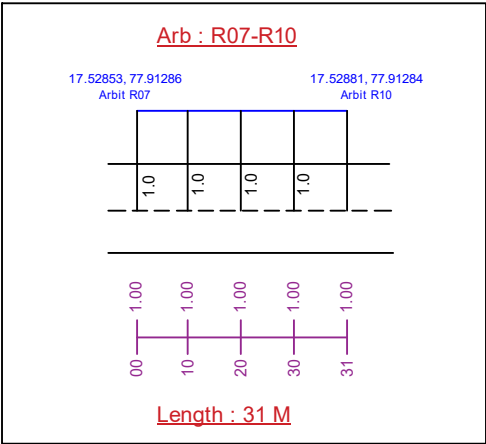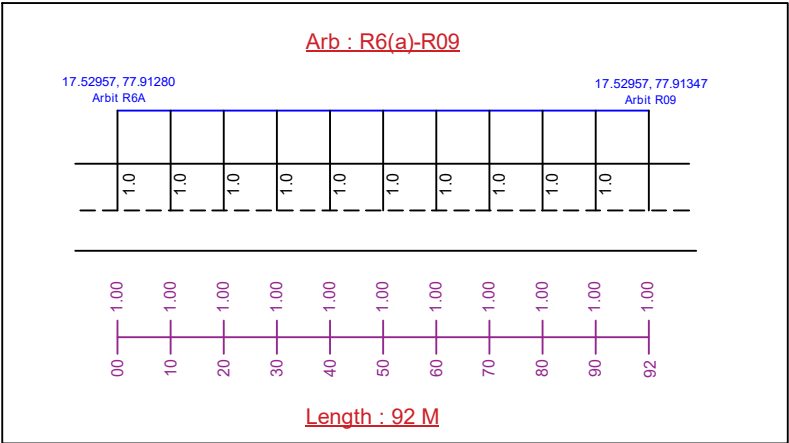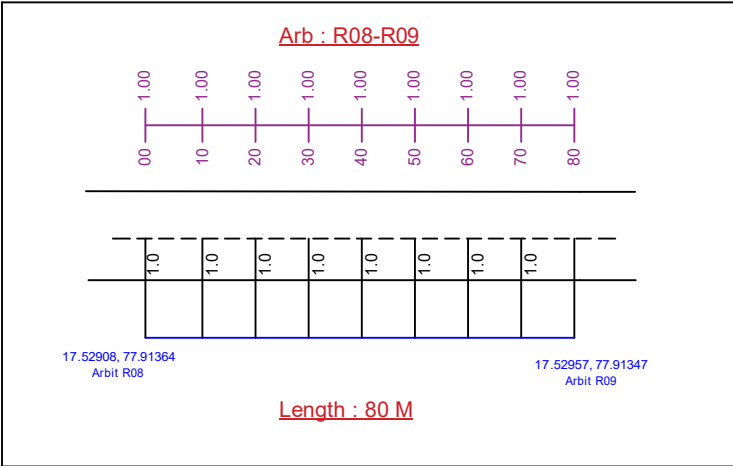

Checked	Designation	Signature


ROAD OFFSET DETAILING FOR KASALABAD (MOMINPET)

Arb : R10-R11

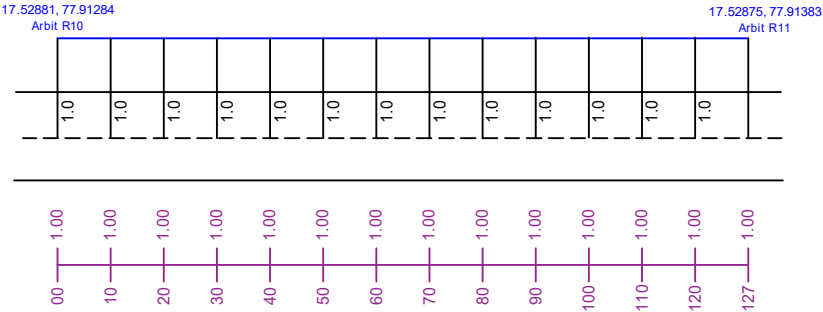


Length : 127 M

Arb : R07-R11

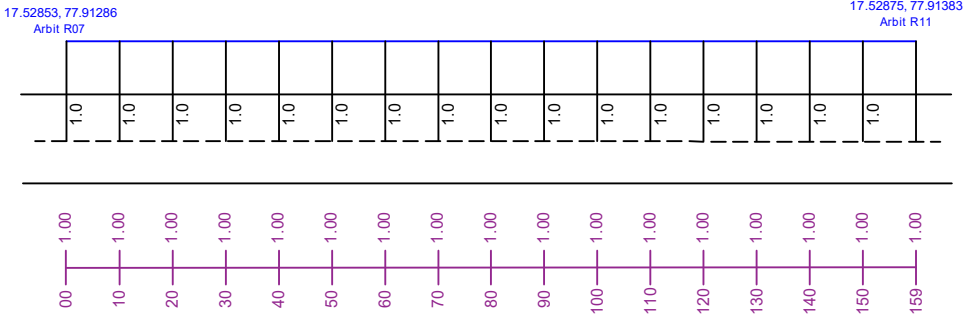


Length : 159 M

Arb : R11-R08

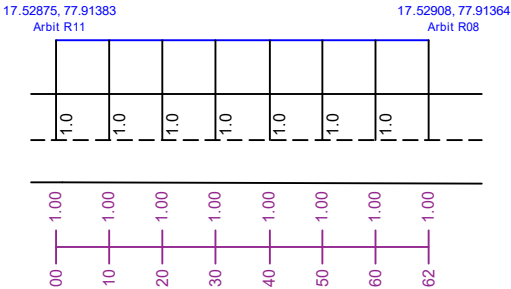


Length : 62 M

Arb : R09-R12

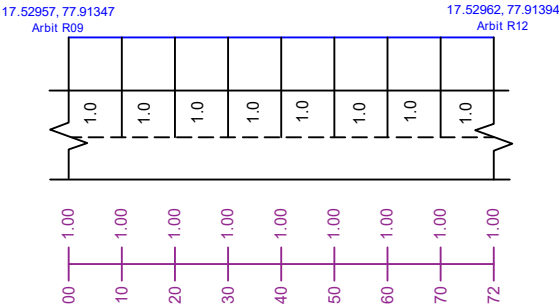

Length : 72 M


Arb : R08-R13

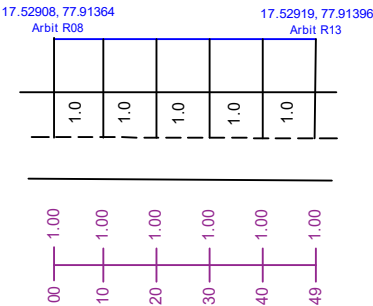

Length : 49 M

Checked	Designation	Signature

ROAD OFFSET DETAILING FOR KASALABAD (MOMINPET)

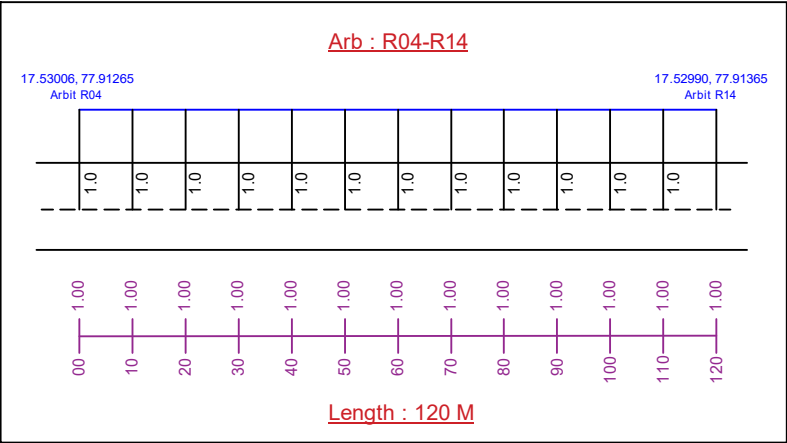

Sheet No. 05
Route Distance : 1872 M

Checked	Designation	Signature



TELANGANA FIBER GRID

TELANGANA FIBER GRID

ITE & C GOVERNMENT OF TELANGANA

7th Floor, Splendid Towers, S.P. Road

Opp: Begumpet Police Station,



Begumpet, Hyderabad-500016.

AS - BUILT DRAWINGS (ABD)

KESARAM

(MOMINPET MANDAL-VIKARABAD DIST.)

SINGLELINE LOOP DIAGRAM FOR KESARAM OHSR1 (MOMINPET)

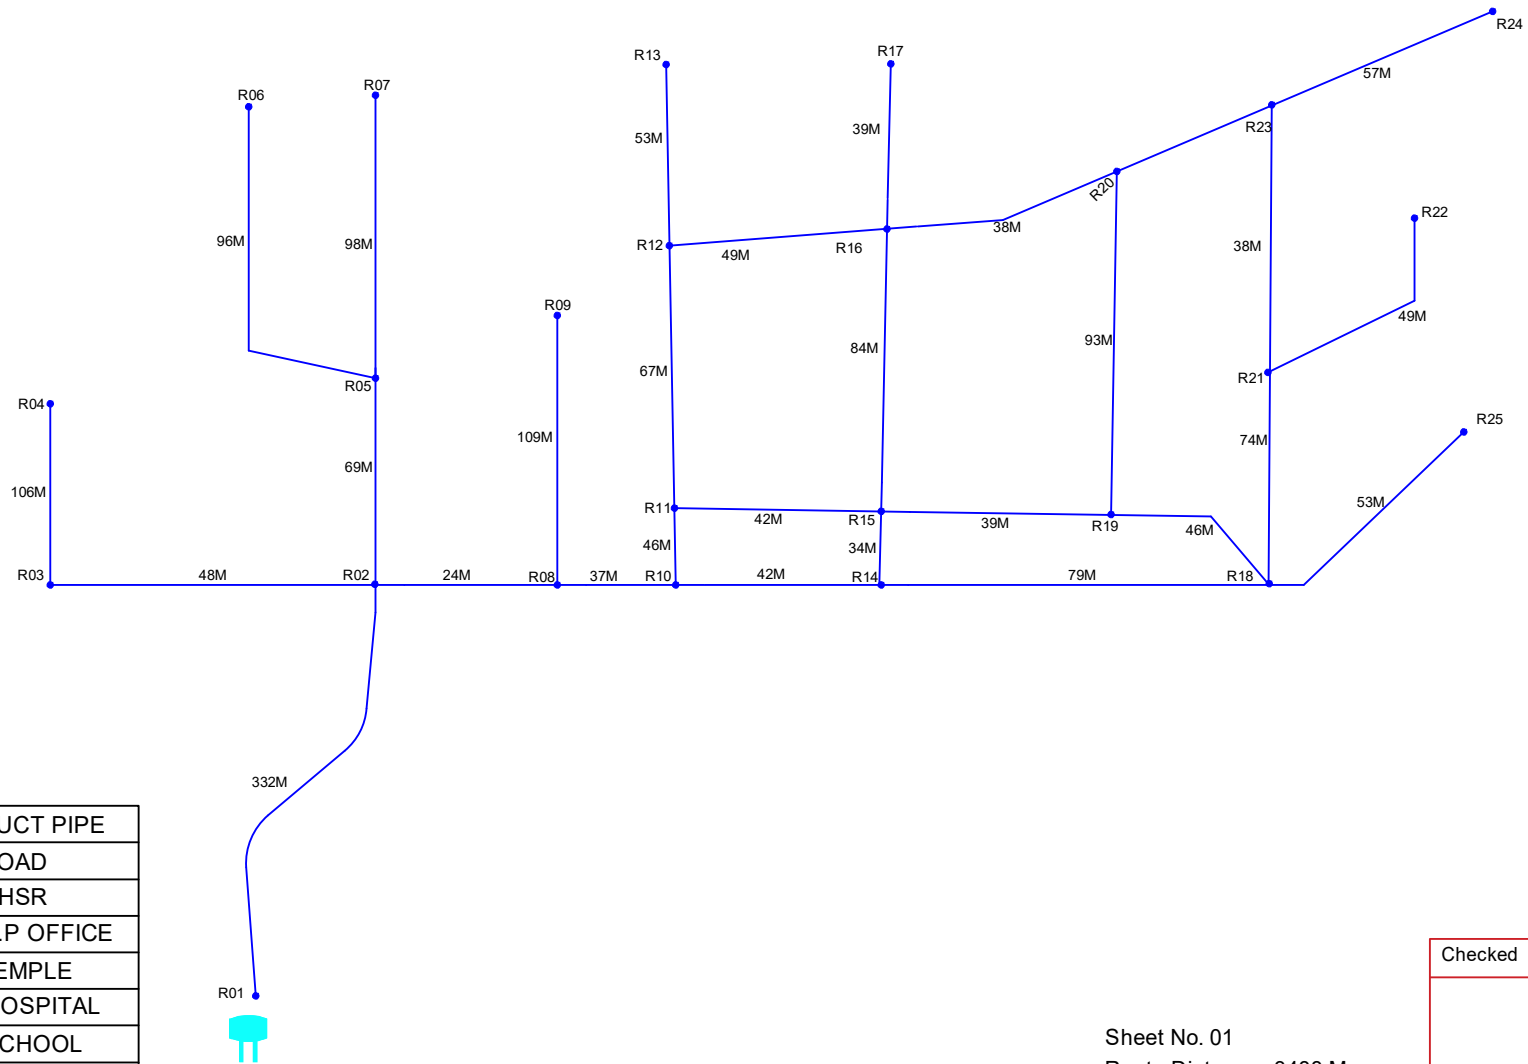
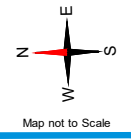


	DUCT PIPE
	ROAD
	OHSR
	G.P OFFICE
	TEMPLE
	HOSPITAL
	SCHOOL
	DUCT GAP

Checked	Designation	Signature

Sheet No. 01
Route Distance : 3488 M




DUCTLAYING ROUTE DIAGRAM FOR KESARAM OHSR1 (MOMINPET)

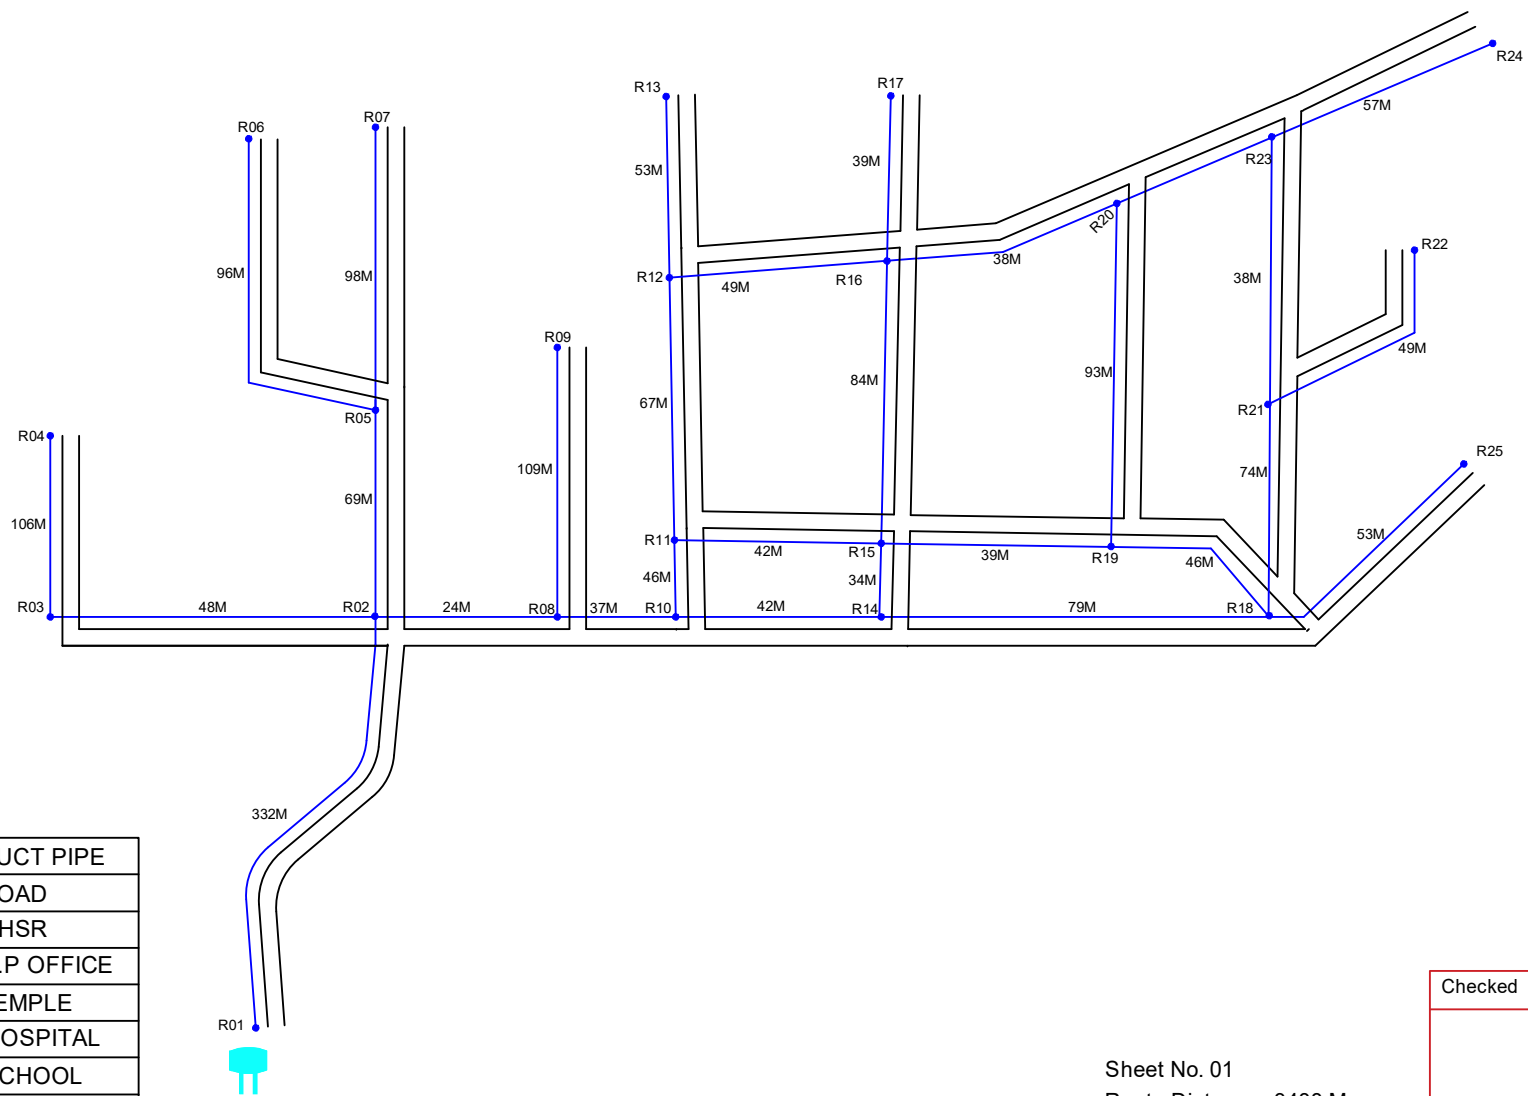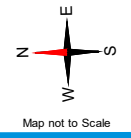

	DUCT PIPE
	ROAD
	OHSR
	G.P OFFICE
	TEMPLE
	HOSPITAL
	SCHOOL
	DUCT GAP

Checked	Designation	Signature


ROAD OFFSET DETAILING FOR KASARAM OHSR1 (MOMINPET)

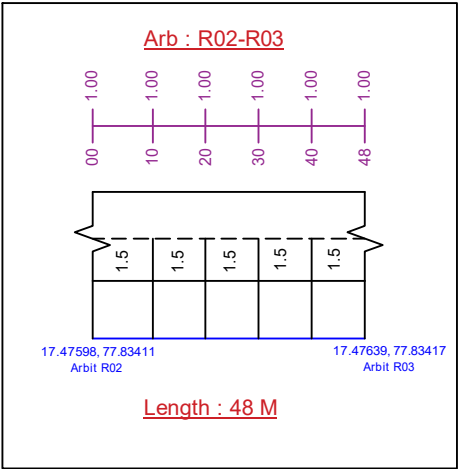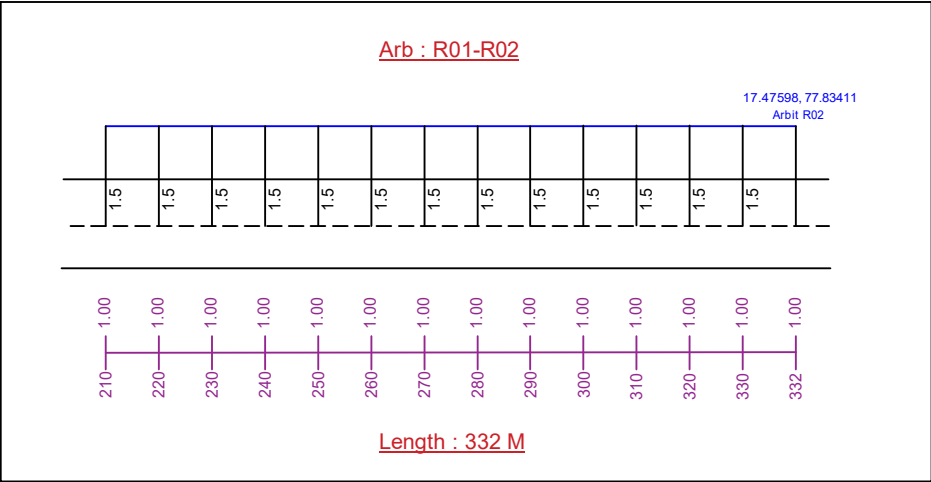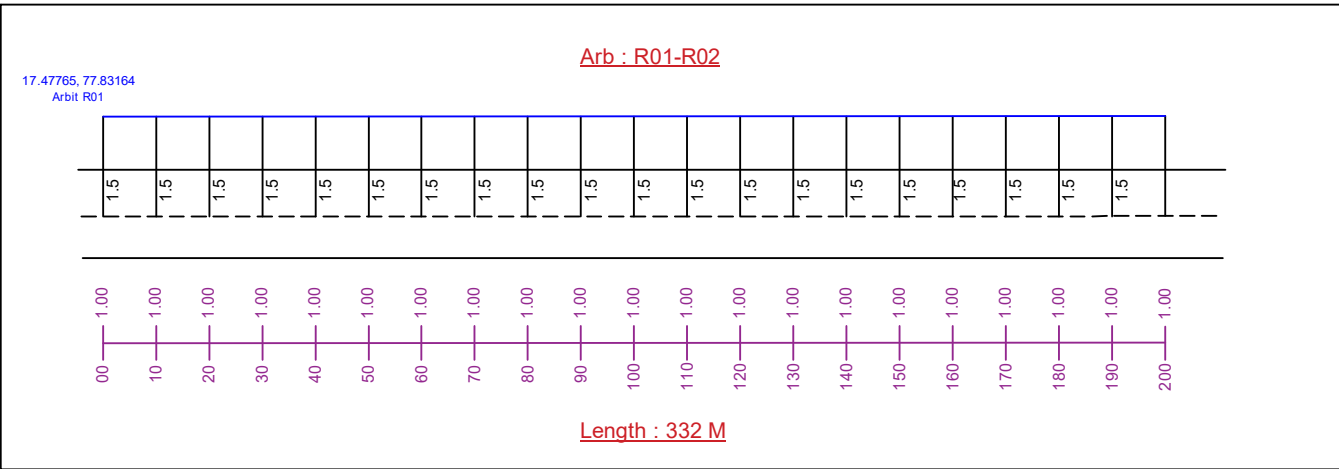


Checked	Designation	Signature

ROAD OFFSET DETAILING FOR KASARAM OHSR1 (MOMINPET)


Arb : R03-R04

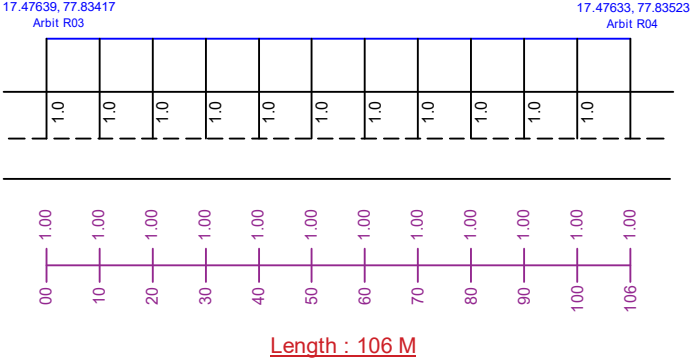


Arb : R02-R05

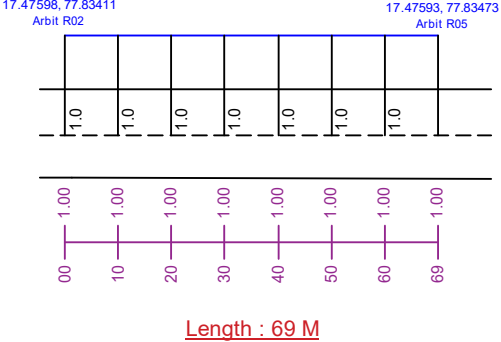

Arb : R05-R06

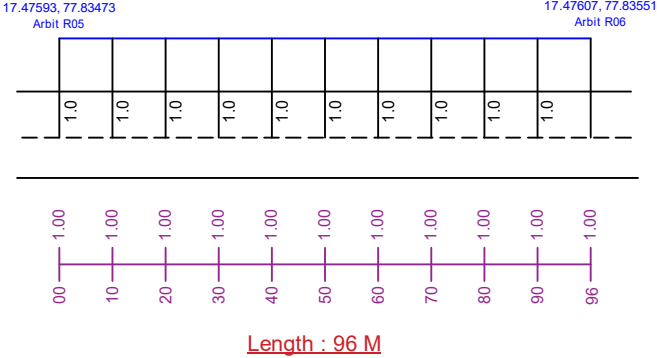


Arb : R05-R07

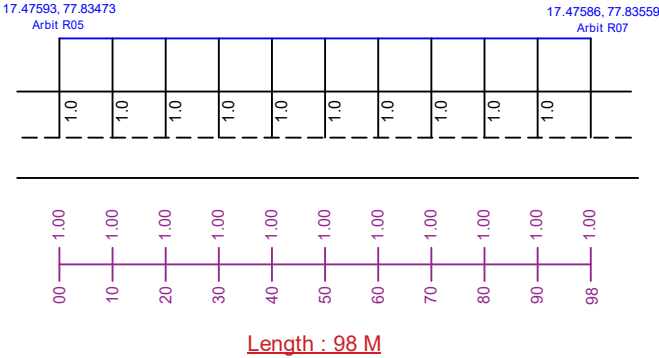


Checked	Designation	Signature

ROAD OFFSET DETAILING FOR KASARAM OHSR1 (MOMINPET)


Arb : R02-R08

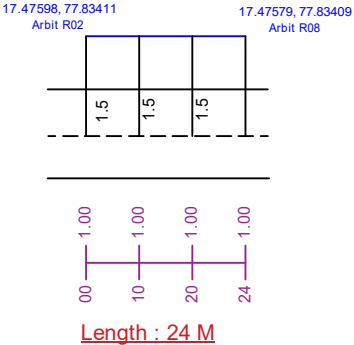


Arb : R08-R09

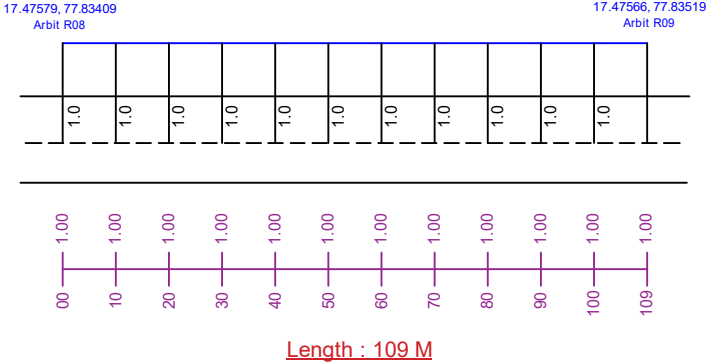


Arb : R08-R10

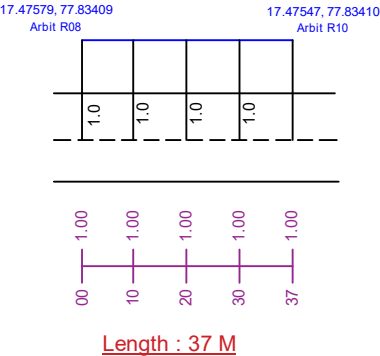


Arb : R10-R11

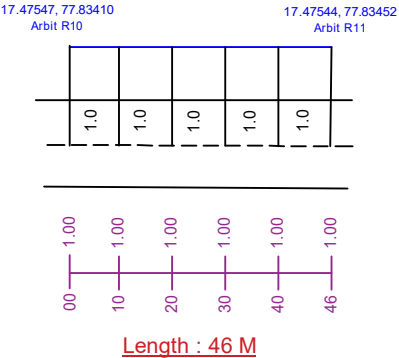

Arb : R11-R12

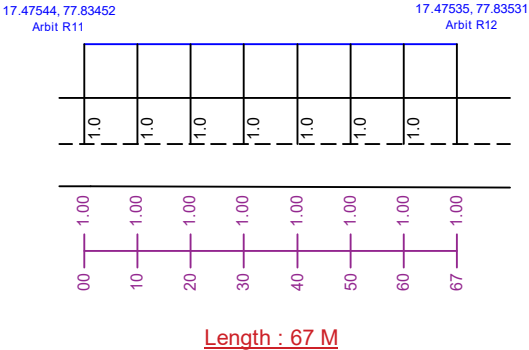


Arb : R12-R13

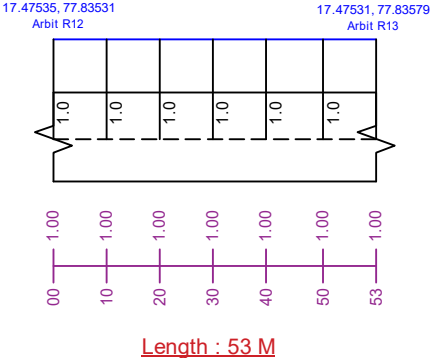


Checked	Designation	Signature

ROAD OFFSET DETAILING FOR KASARAM OHSR1 (MOMINPET)


Arb : R10-R14

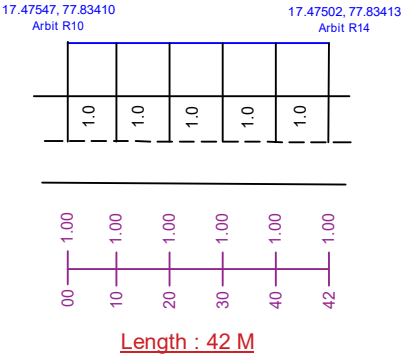


Arb : R14-R15

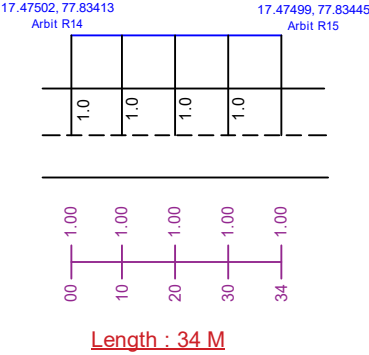


Arb : R15-R16

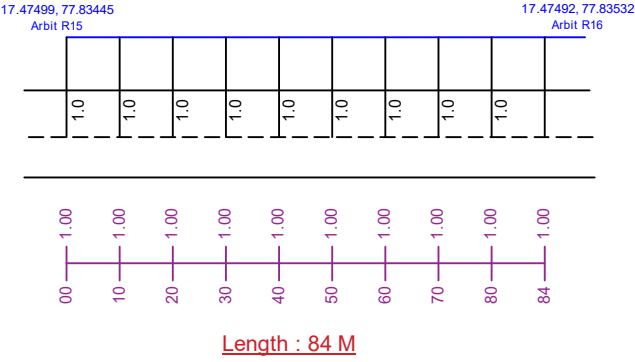


Arb : R16-R19

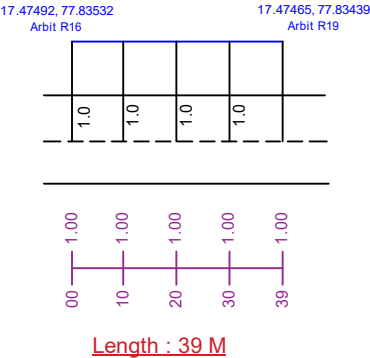

Arb : R11-R15

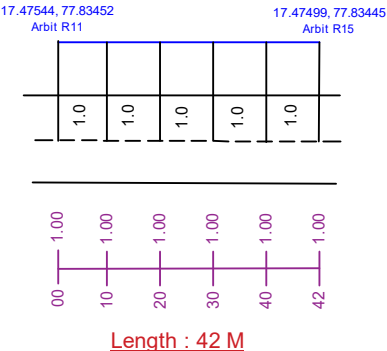


Arb : R12-R16

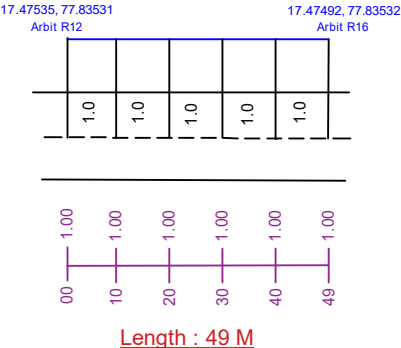

Checked	Designation	Signature


ROAD OFFSET DETAILING FOR KASARAM OHSR1 (MOMINPET)

Arb : R14-R18

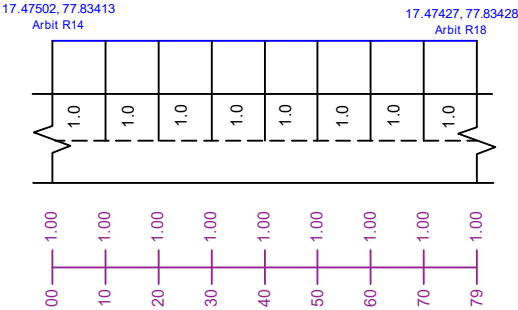


Length : 79 M

Arb : R18-R19

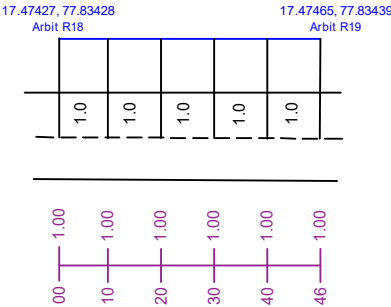


Length : 46 M

Arb : R15-R19

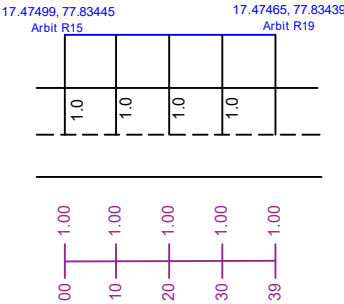


Length : 39 M

Arb : R19-R20

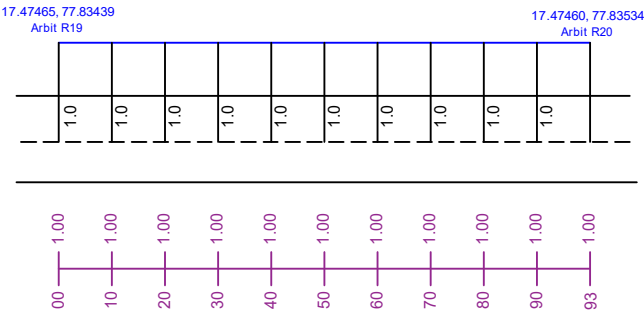


Length : 93 M

Arb : R16-R20

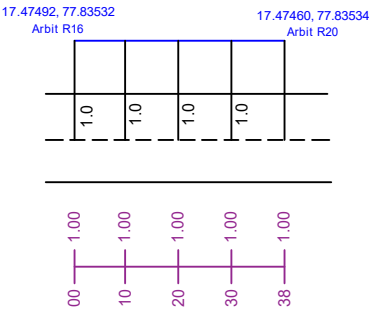

Length : 38 M

Arb : R18-R21

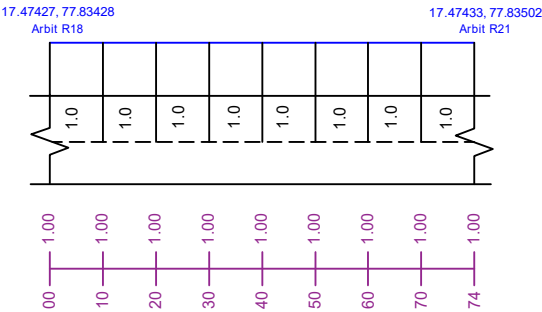


Length : 74 M


Checked	Designation	Signature

ROAD OFFSET DETAILING FOR KASARAM OHSR1 (MOMINPET)


Arb : R21-R22

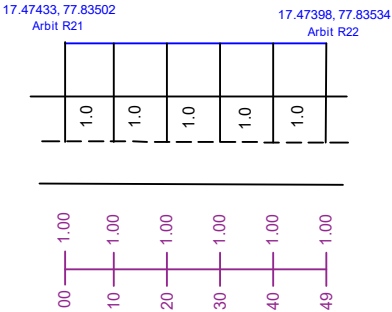


Arb : R21-R23

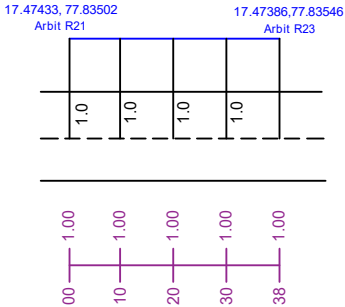


Arb : R20-R23

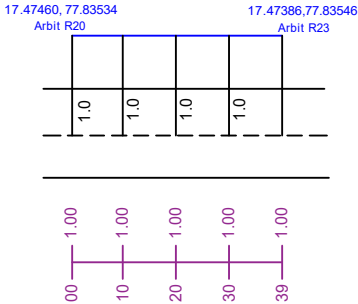

Arb : R23-R24


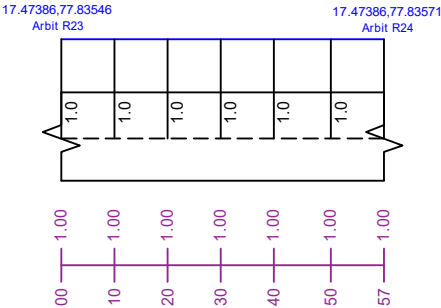


Arb : R18-R25

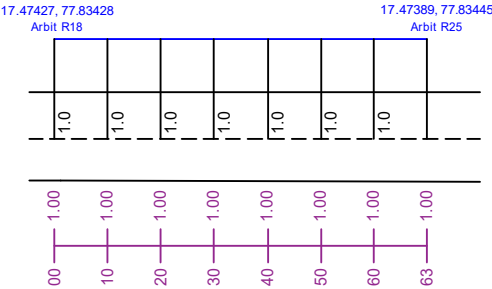

Checked	Designation	Signature

SINGLELINE LOOP DIAGRAM FOR KESARAM OHSR2 (MOMINPET)

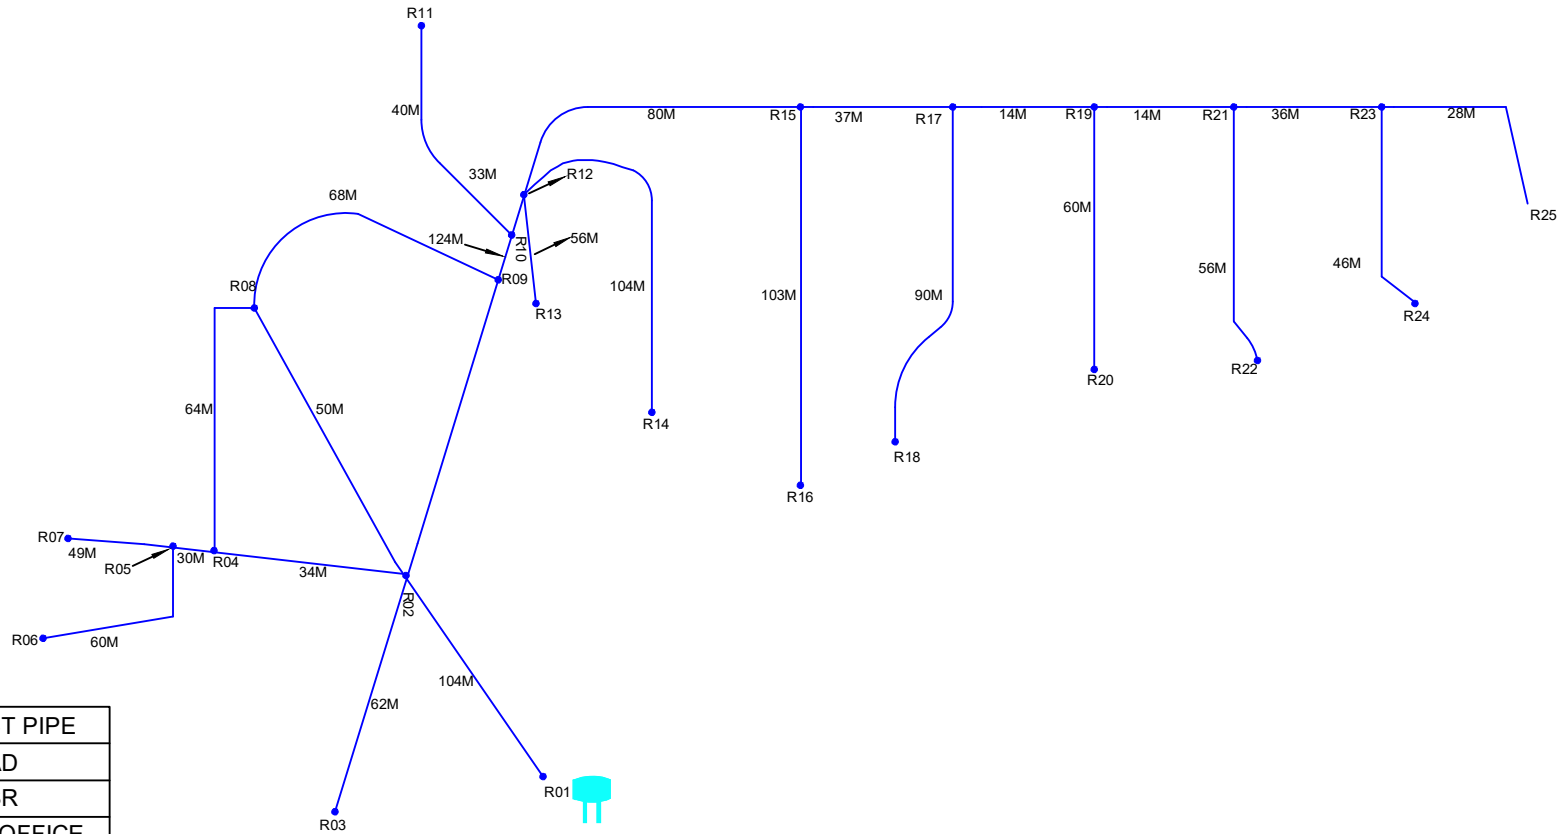
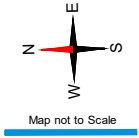


	DUCT PIPE
	ROAD
	OHHSR
	G.P. OFFICE
	TEMPLE
	HOSPITAL
	SCHOOL
	DUCT GAP

Sheet No. 01
Route Distance : 3488 M

Checked	Designation	Signature

DUCTLAYING ROUTE DIAGRAM FOR KESARAM OHSR2 (MOMINPET)

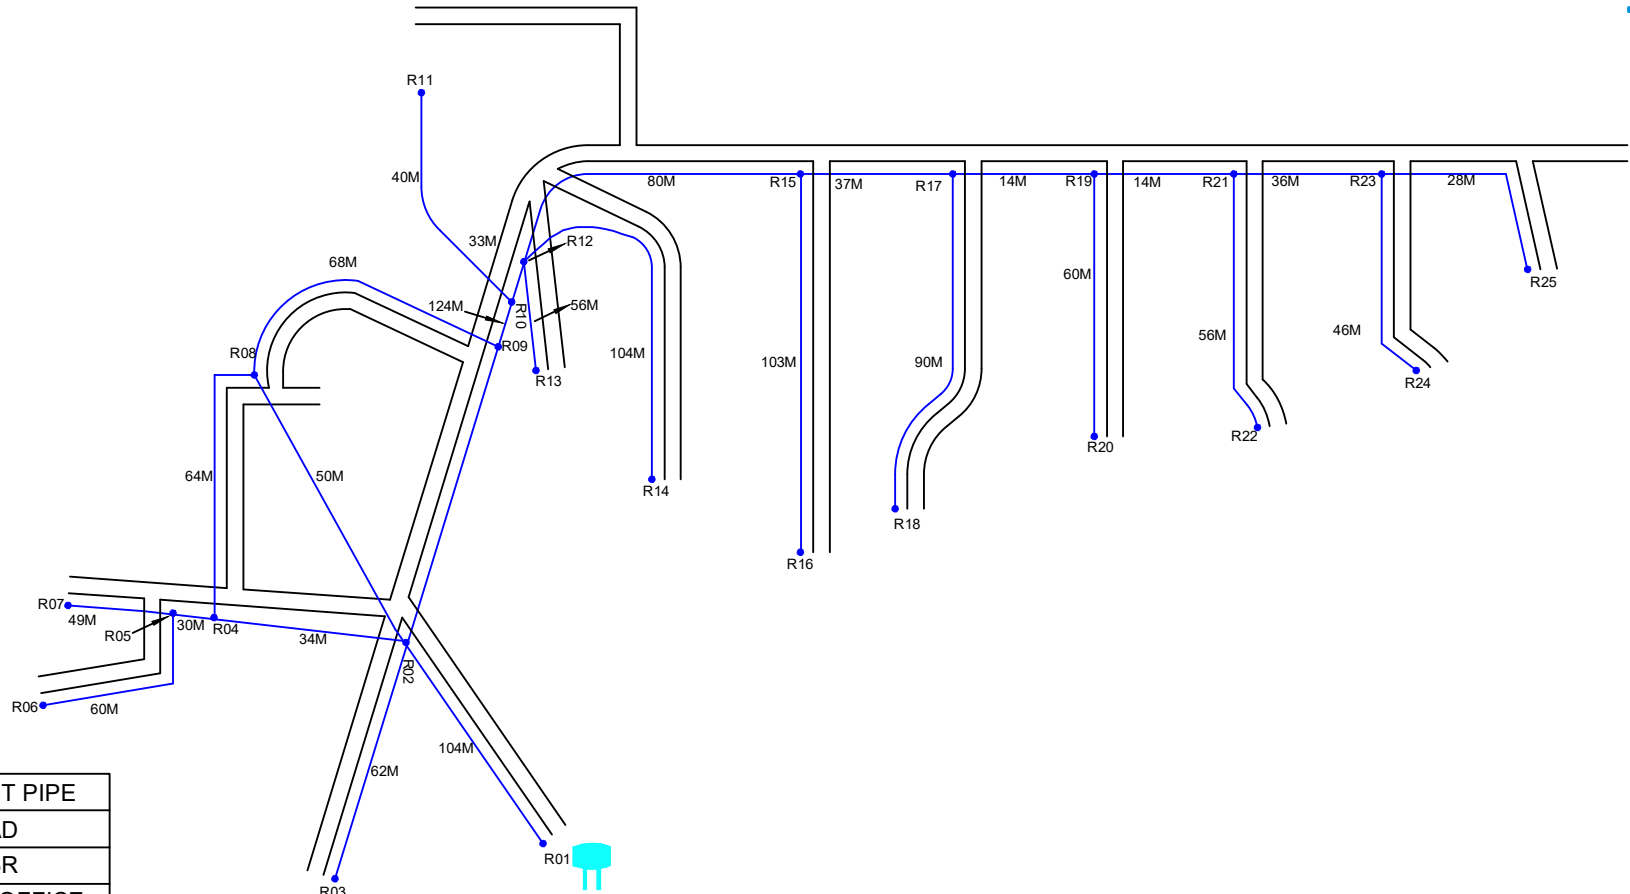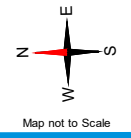


	DUCT PIPE
	ROAD
	OHSR
	G.P OFFICE
	TEMPLE
	HOSPITAL
	SCHOOL
	DUCT GAP


Checked	Designation	Signature

ROAD OFFSET DETAILING FOR KASARAM OHSR2 (MOMINPET)


Arb : R01-R02

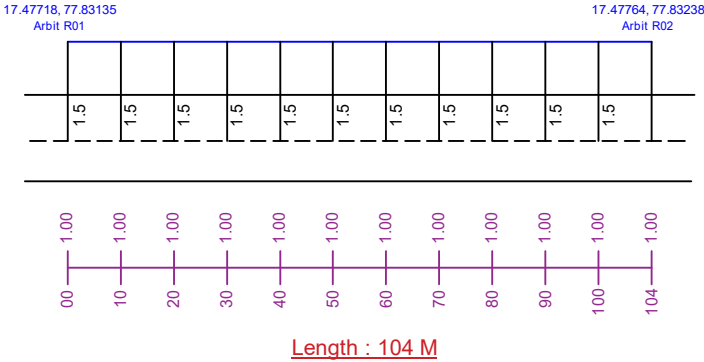


Arb : R02-R03

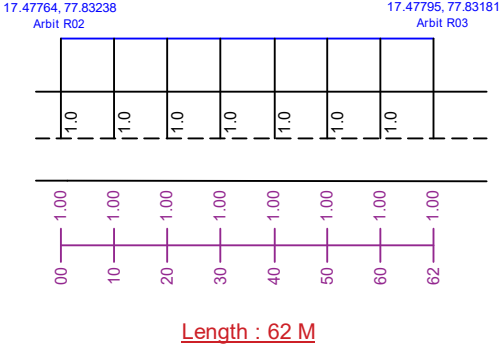


Arb : R02-R04

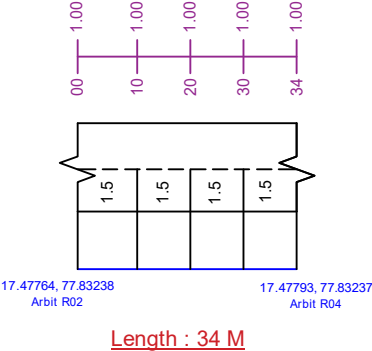


Arb : R04-R05

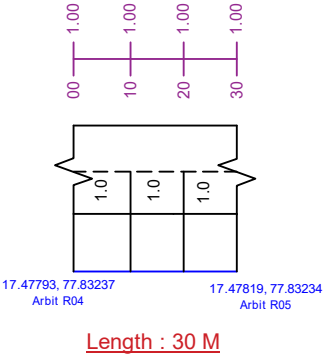

Arb : R05-R06

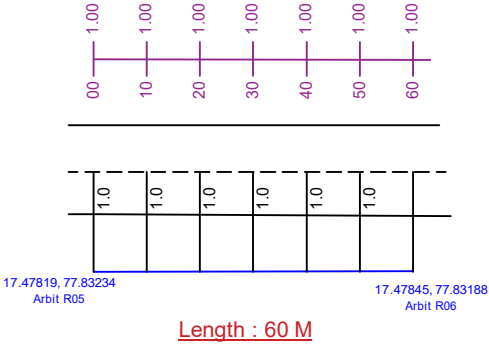


Arb : R05-R07

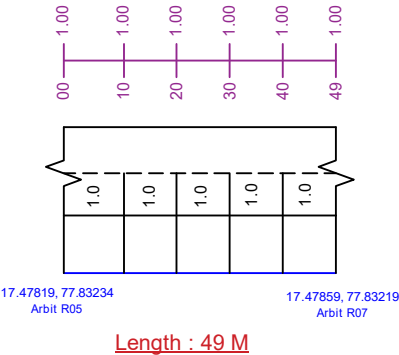


Checked	Designation	Signature

ROAD OFFSET DETAILING FOR KASARAM OHSR2 (MOMINPET)


Arb : R04-R08

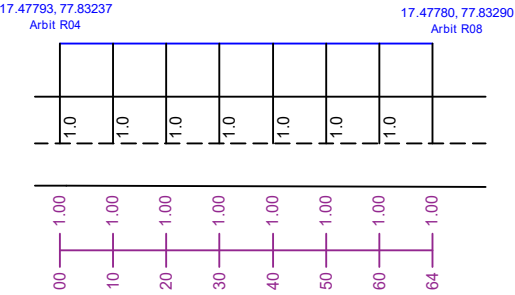


Arb : R02-R08

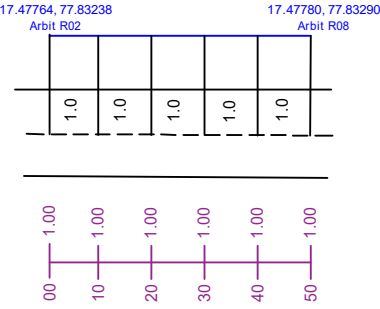


Arb : R02-R09

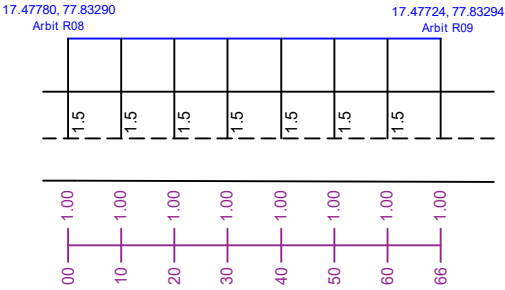

Arb : R08-R09

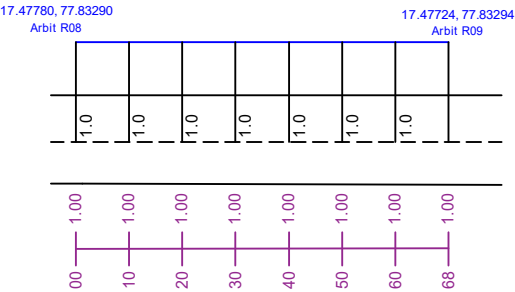


Arb : R09-R10

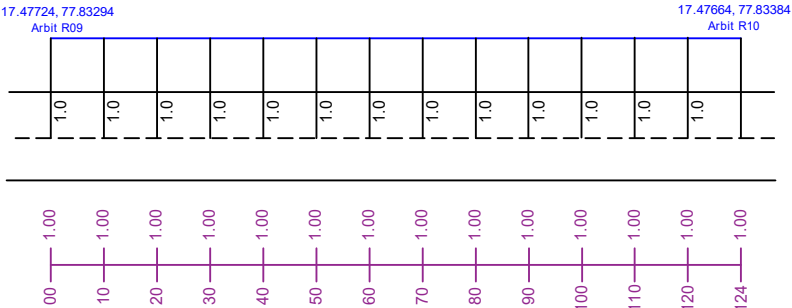

Checked	Designation	Signature


ROAD OFFSET DETAILING FOR KASARAM OHSR2 (MOMINPET)

Arb : R10-R11

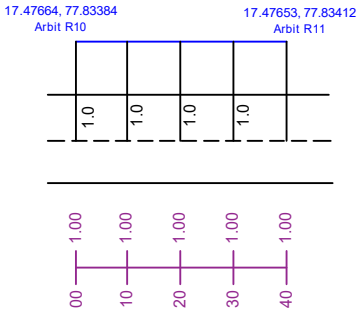


Length : 40 M

Arb : R10-R12

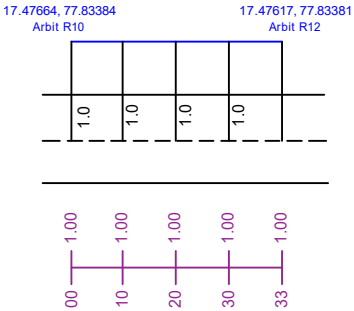


Length : 33 M

Arb : R12-R13

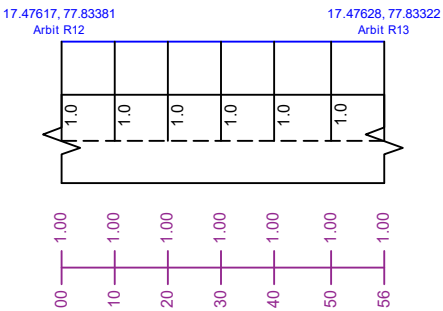


Length : 56 M

Arb : R12-R14

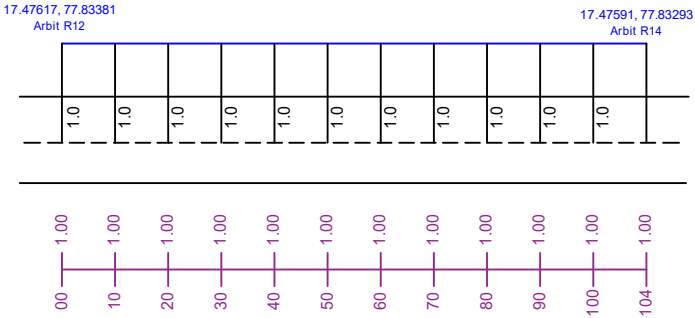

Length : 104 M






Arb : R12-R15

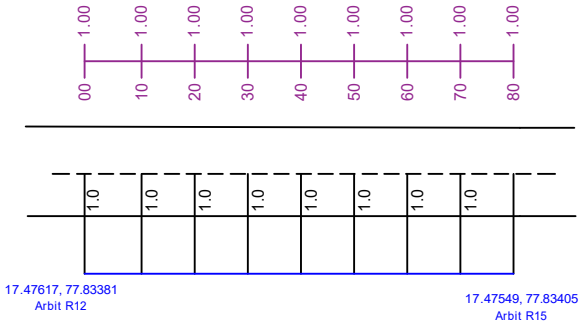

Length : 80 M

Checked	Designation	Signature


ROAD OFFSET DETAILING FOR KASARAM OHSR2 (MOMINPET)

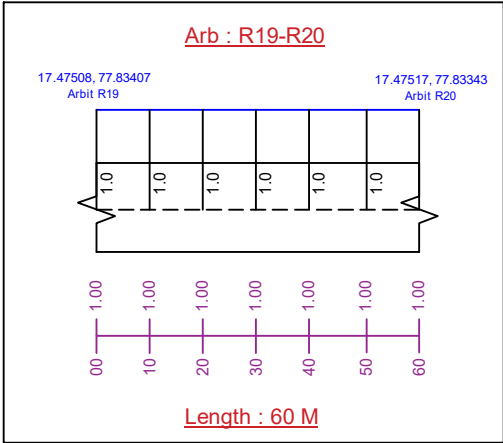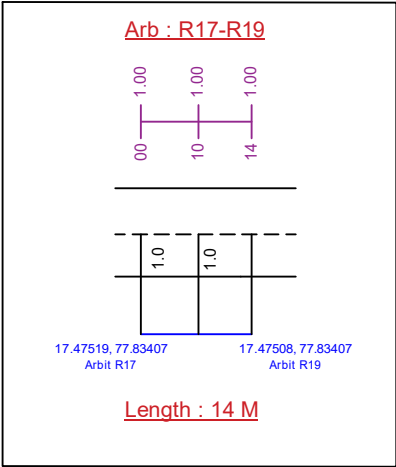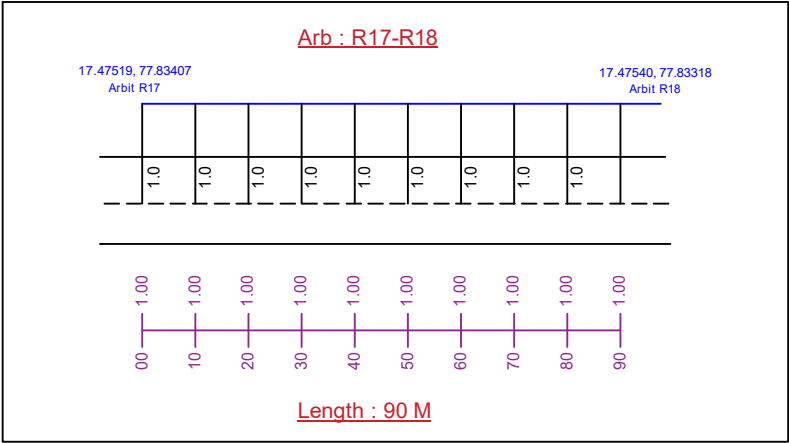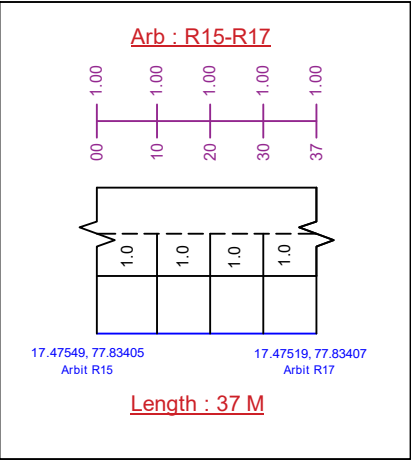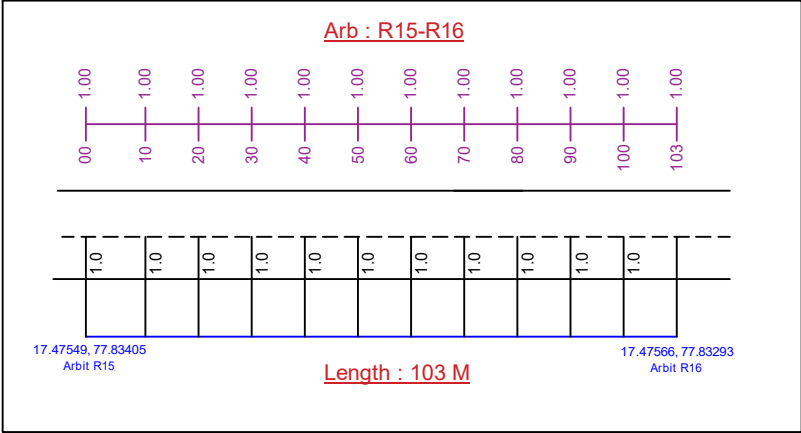

Checked	Designation	Signature


ROAD OFFSET DETAILING FOR KASARAM OHSR 2 (MOMINPET)

Arb : R19-R21

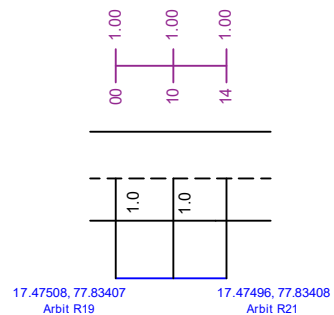


Length : 14 M

Arb : R21-R22

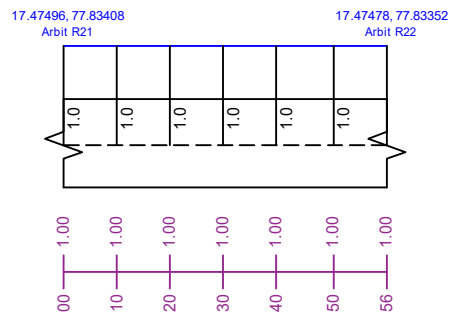


Length : 56 M

Arb : R21-R23

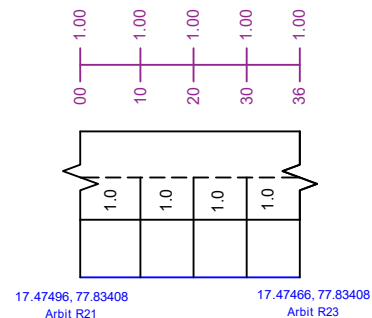


Length : 36 M

Arb : R23-R24

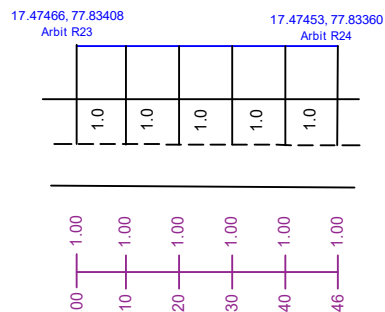

Length : 46 M

Arb : R23-R25

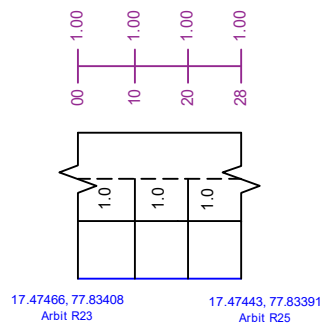

Length : 28 M

Checked	Designation	Signature

Sheet No. 05
Route Distance : 3488 M



TELANGANA FIBER GRID

TELANGANA FIBER GRID

ITE & C GOVERNMENT OF TELANGANA

7th Floor, Splendid Towers, S.P. Road

Opp: Begumpet Police Station,



Begumpet, Hyderabad-500016.

AS - BUILT DRAWINGS (ABD)

LACHANAIAK TANDA

(MOMINPET MANDAL-VIKARABAD DIST.)

SINGLELINE LOOP DIAGRAM FOR LACHANAIAK TANDA (MOMINPET)

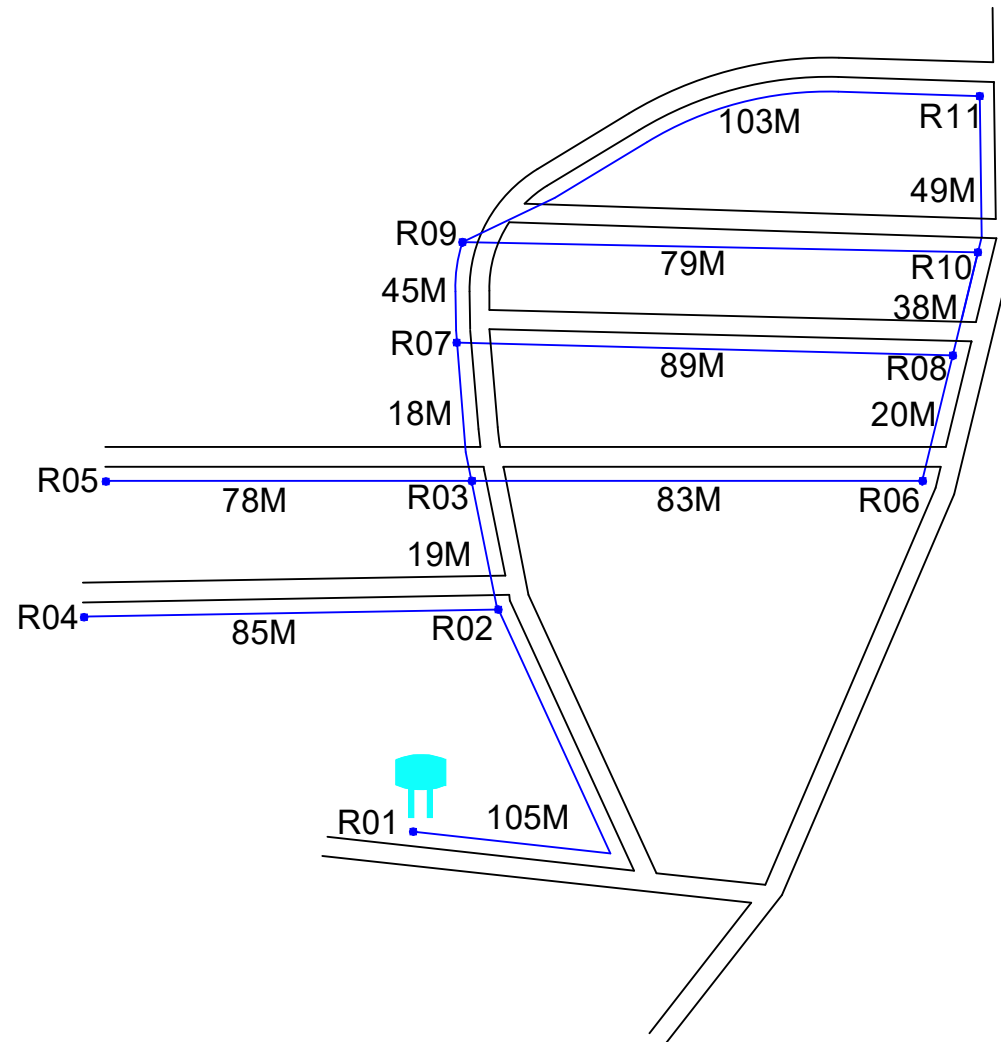
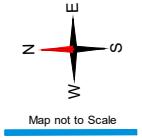



 






	DUCT PIPE
	ROAD
	OHSR
	G.P OFFICE
	TEMPLE
	HOSPITAL
	SCHOOL
	DUCT GAP

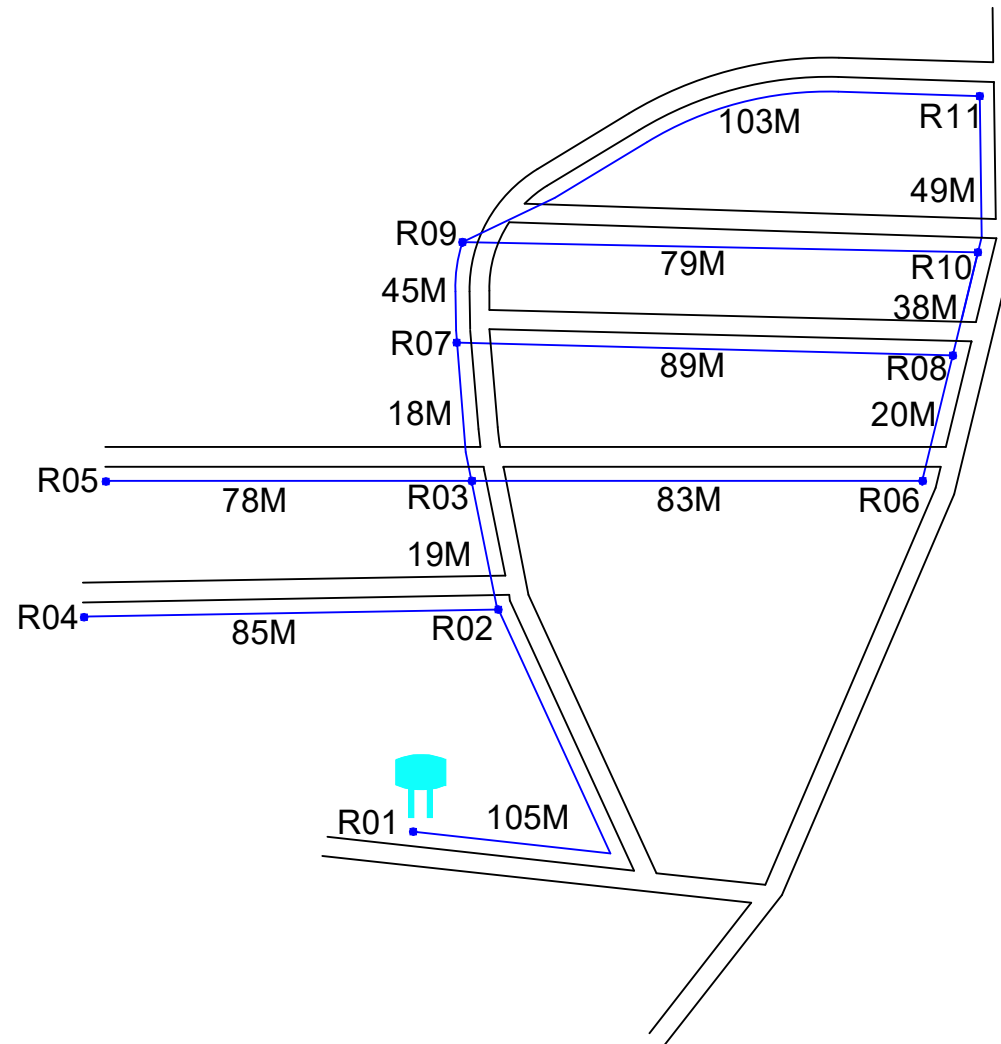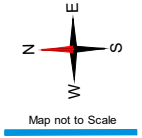Sheet No. 01
Route Distance : 839 M

Checked	Designation	Signature

DUCTLAYING ROUTE DIAGRAM FOR LACHANAIAK TANDA (MOMINPET)









	DUCT PIPE
	ROAD
	OHSR
	G.P OFFICE
	TEMPLE
	HOSPITAL
	SCHOOL
	DUCT GAP

Sheet No. 01
Route Distance : 839 M

Checked	Designation	Signature

ROAD OFFSET DETAILING FOR LACHANAIAK TANDA (MOMINPET)

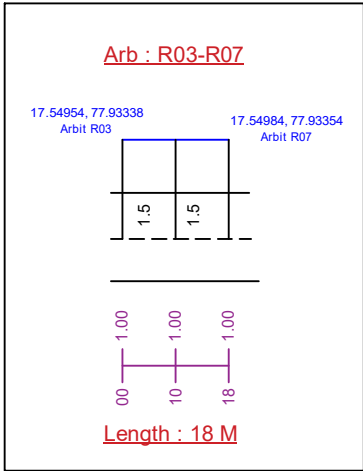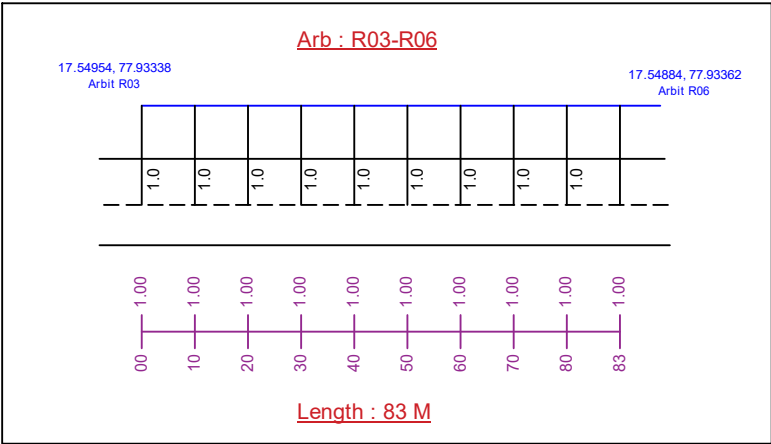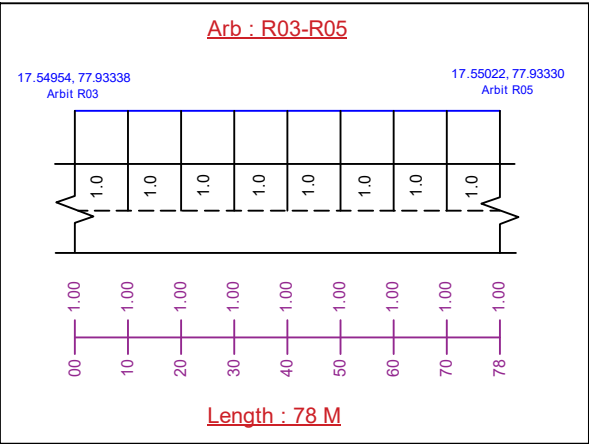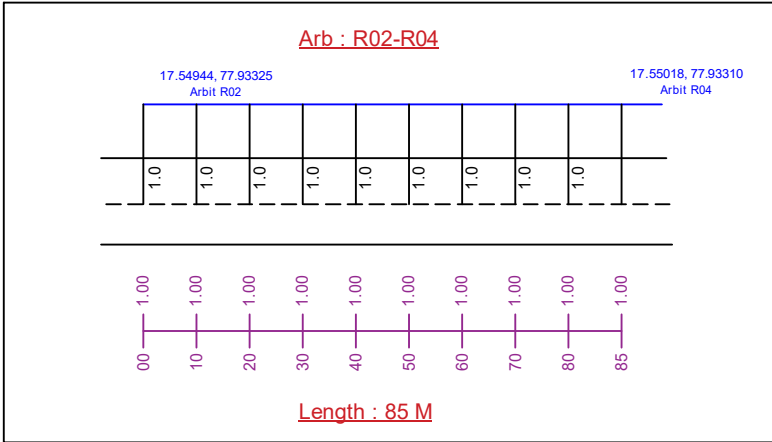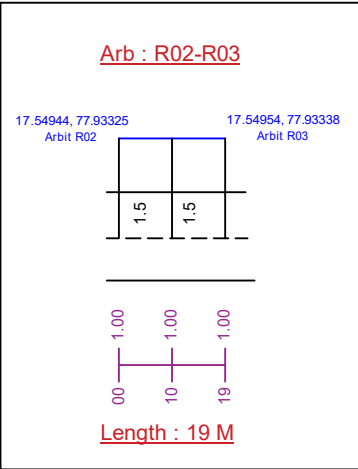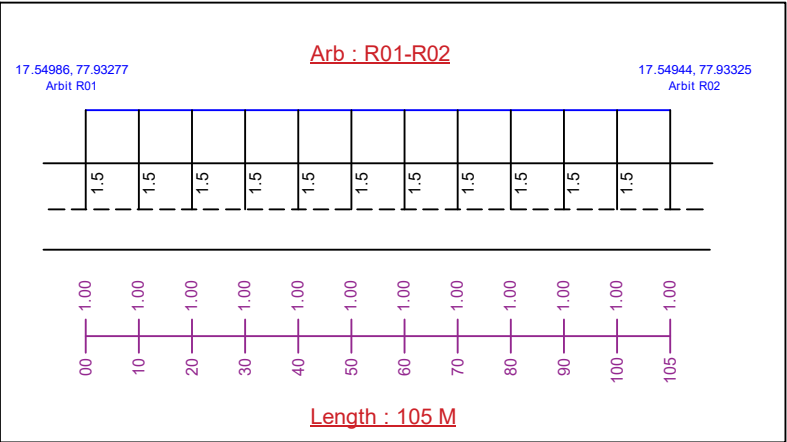


Sheet No. 01
Route Distance : 839 M

Checked	Designation	Signature


ROAD OFFSET DETAILING FOR LACHANAIAK TANDA (MOMINPET)

Arb : R07-R08

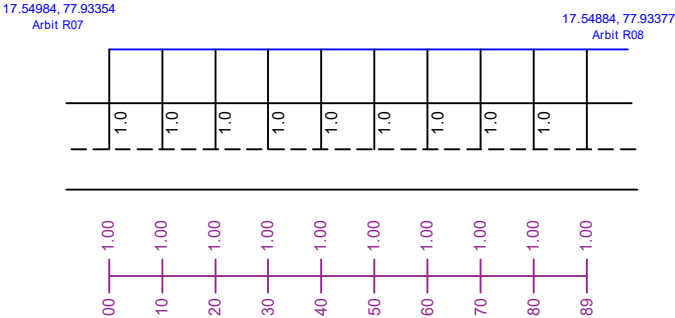


Length : 89 M

Arb : R07-R09

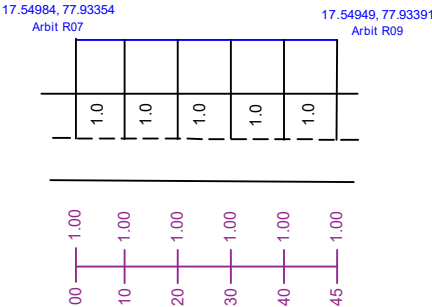


Length : 45 M

Arb : R09-R10

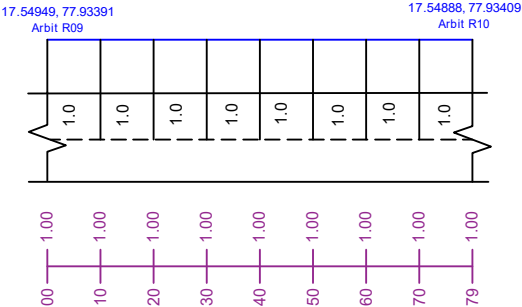


Length : 79 M

Arb : R09-R11

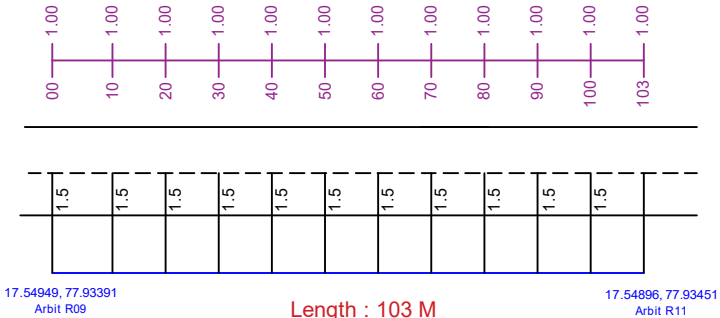


Length : 103 M

Arb : R11-R10

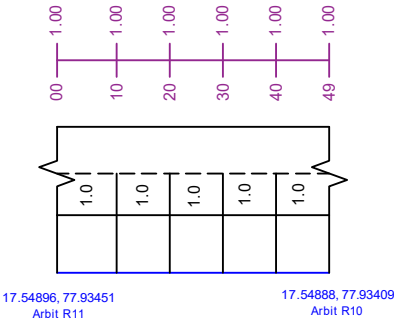

Length : 49 M

Arb : R10-R08

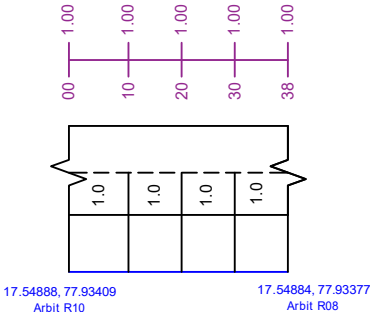

Length : 38 M



Checked	Designation	Signature

ROAD OFFSET DETAILING FOR LACHANAIAK TANDA (MOMINPET)

Arb : R06-R08

17.54884, 77.93362
Arbit R06

17.54884, 77.93377
Arbit R08

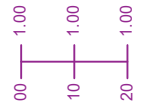
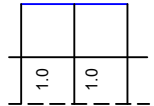


Length : 20 M

Arb : R04-R05

17.55018, 77.93310
Arbit R04

17.55022, 77.93330
Arbit R05

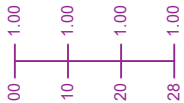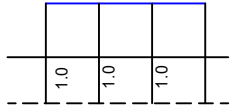

Length : 28 M

Checked	Designation	Signature



TELANGANA FIBER GRID

TELANGANA FIBER GRID

ITE & C GOVERNMENT OF TELANGANA

7th Floor, Splendid Towers, S.P. Road

Opp: Begumpet Police Station,



Begumpet, Hyderabad-500016.


 






AS - BUILT DRAWINGS (ABD)

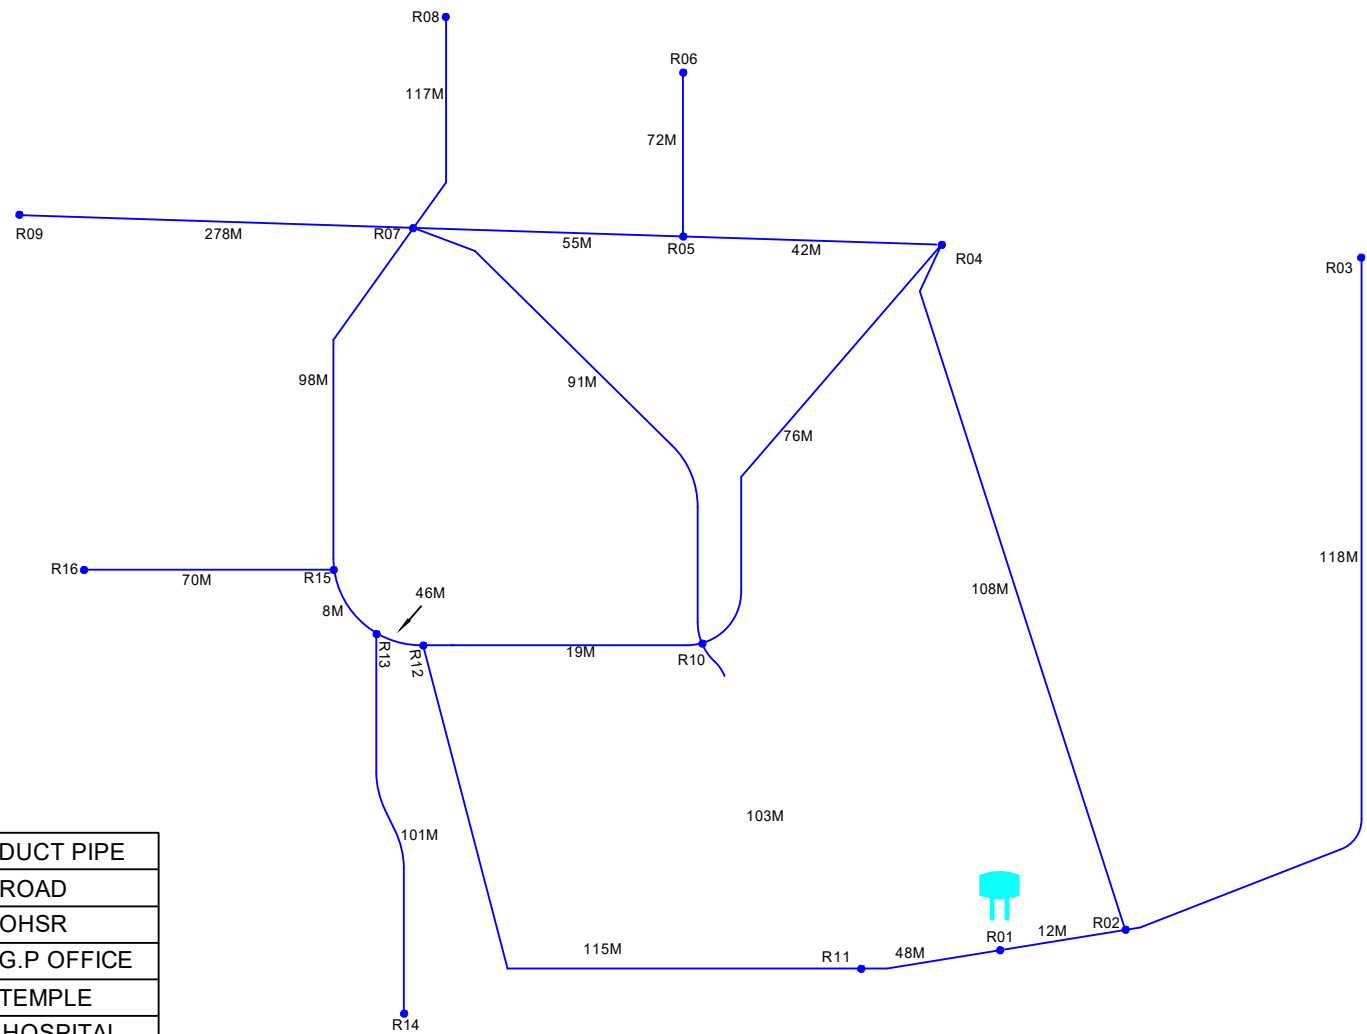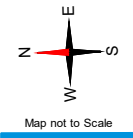MALLAREDDYGUDA

(MOMINPET MANDAL-VIKARABAD DIST.)

SINGLELINE LOOP DIAGRAM FOR MALLAREDDYGUDA (MOMINPET)






 






	DUCT PIPE
	ROAD
	OHSR
	G.P. OFFICE
	TEMPLE
	HOSPITAL
	SCHOOL
	DUCT GAP

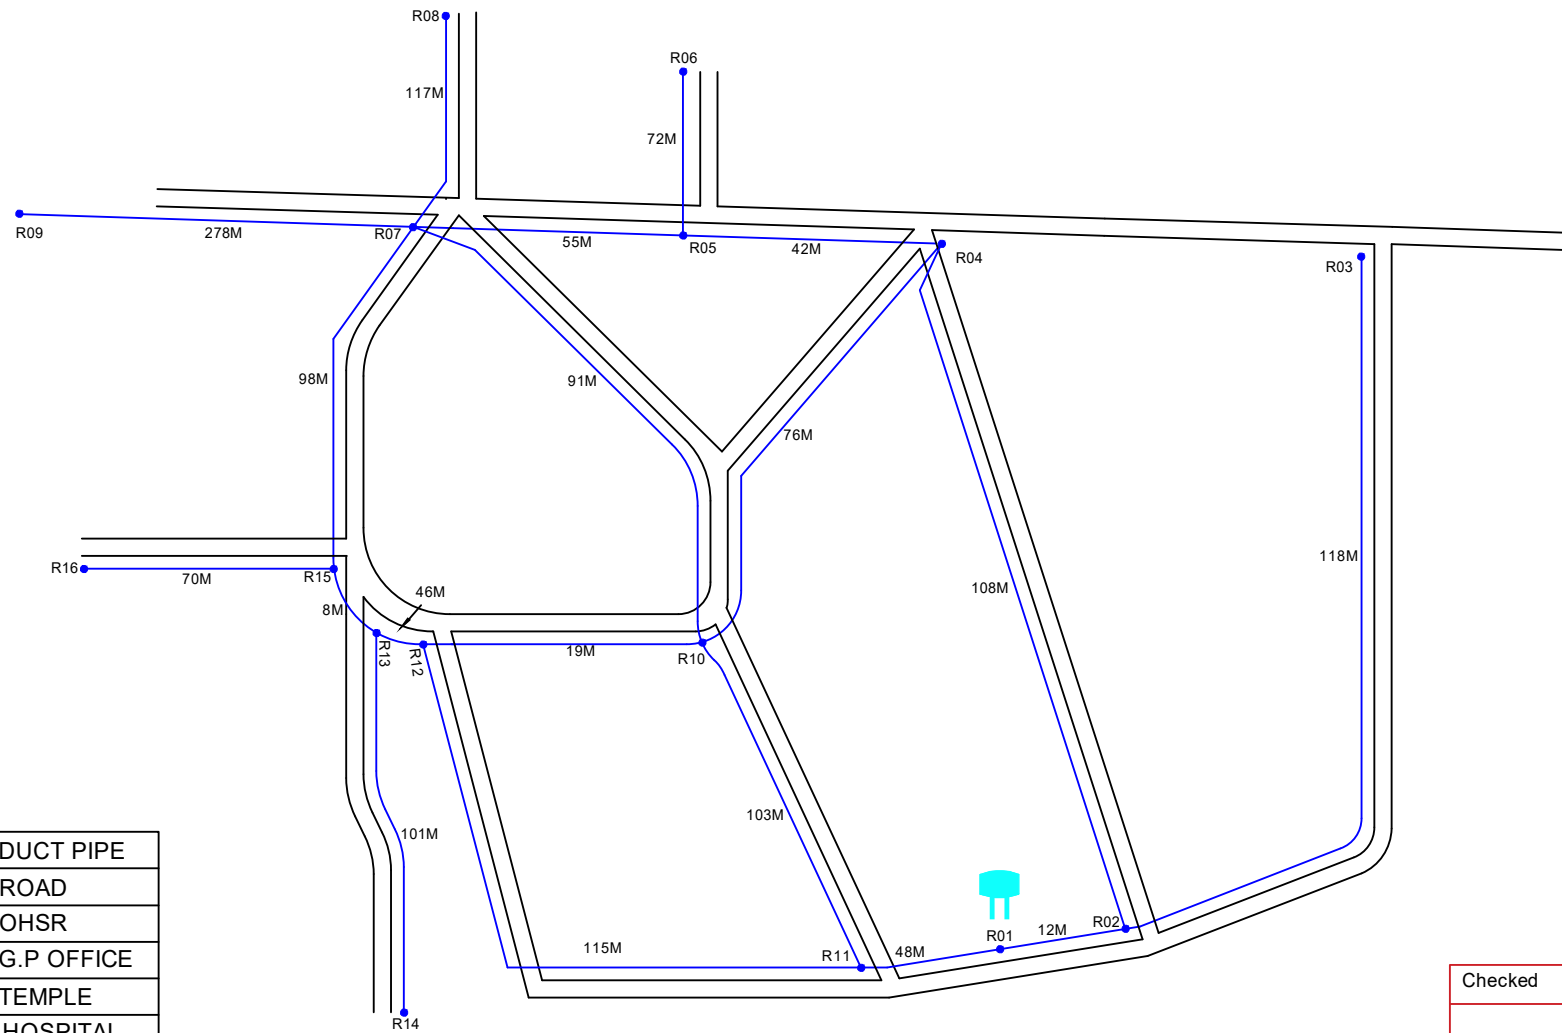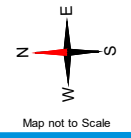Sheet No. 01
Route Distance : 1586 M

Checked	Designation	Signature

DUCTLAYING ROUTE DIAGRAM FOR MALLAREDDYGUDA (MOMINPET)




	DUCT PIPE
	ROAD
	OHSR
	G.P OFFICE
	TEMPLE
	HOSPITAL
	SCHOOL
	DUCT GAP

Sheet No. 01
Route Distance : 1586 M


Checked	Designation	Signature

ROAD OFFSET DETAILING FOR MALLAREDDYGUDA (MOMINPET)


Arb : R01-R02

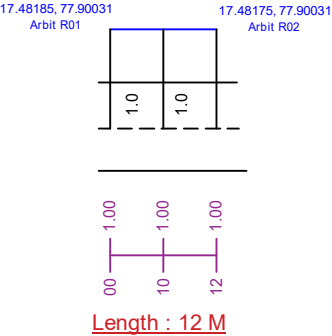


Arb : R02-R03

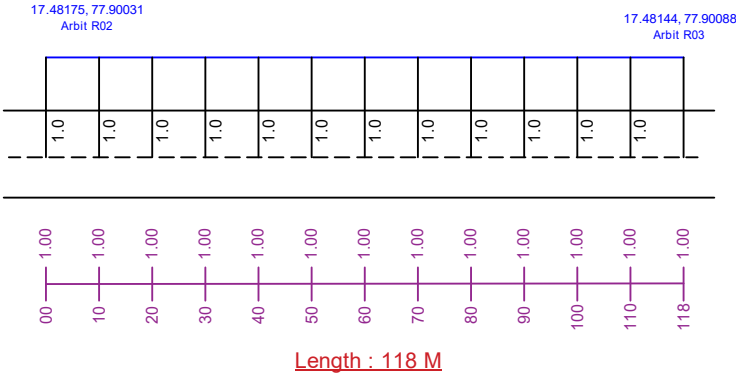


Arb : R02-R04

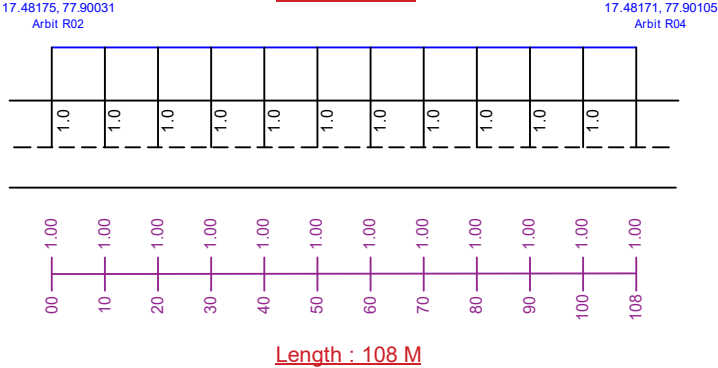


Arb : R04-R05

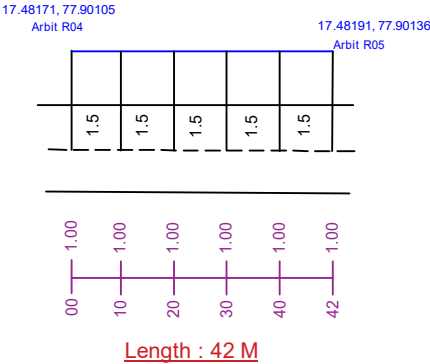

Arb : R05-R06



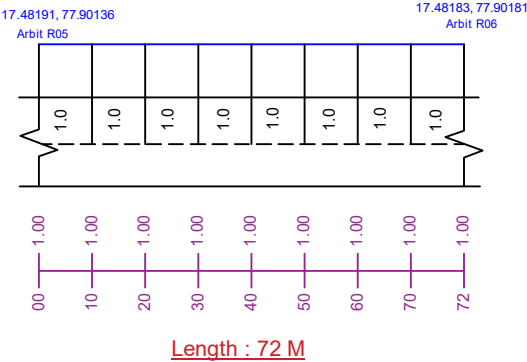


Arb : R05-R07

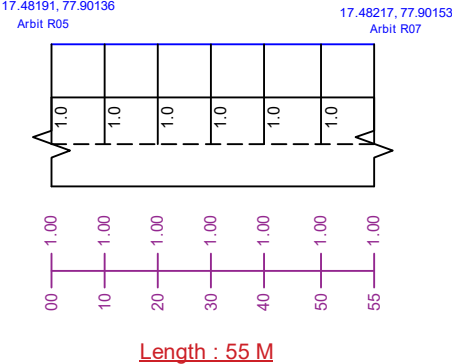

Checked	Designation	Signature






ROAD OFFSET DETAILING FOR MALLAREDDYGUDA (MOMINPET)

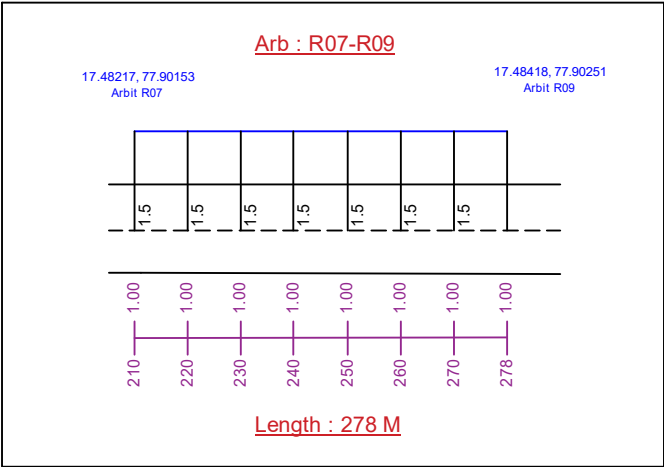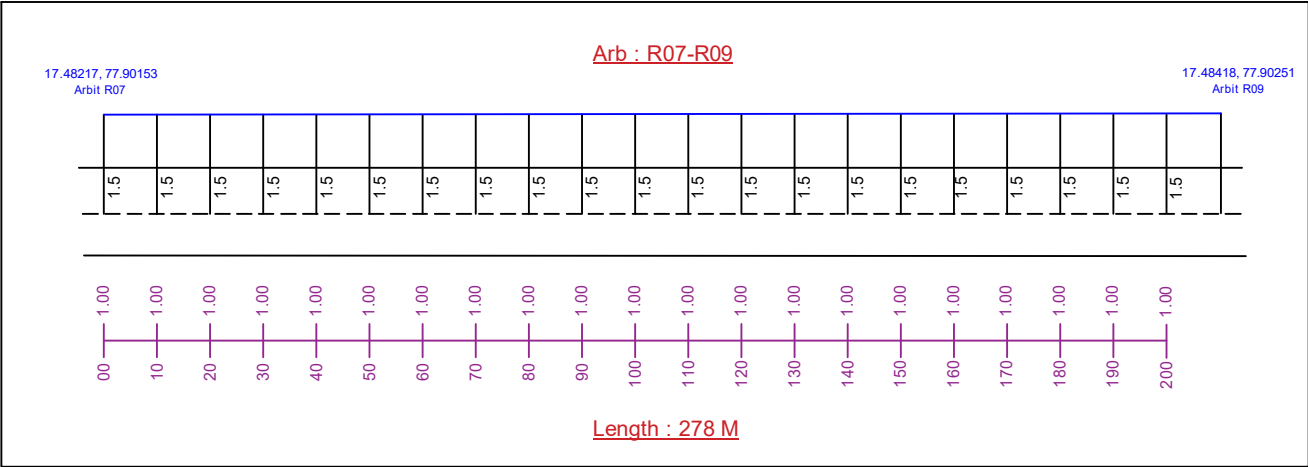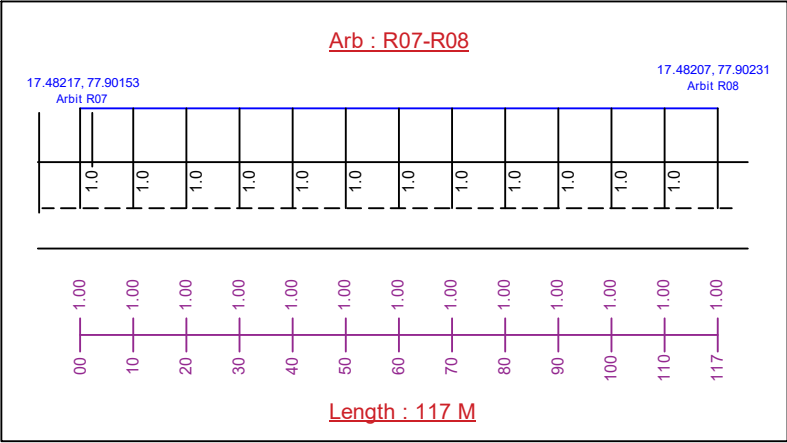

Checked	Designation	Signature






Sheet No. 02
Route Distance : 1586 M

ROAD OFFSET DETAILING FOR MALLAREDDYGUDA (MOMINPET)

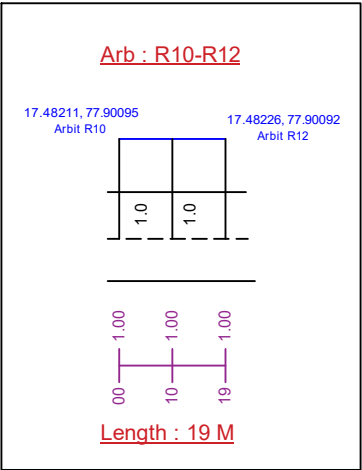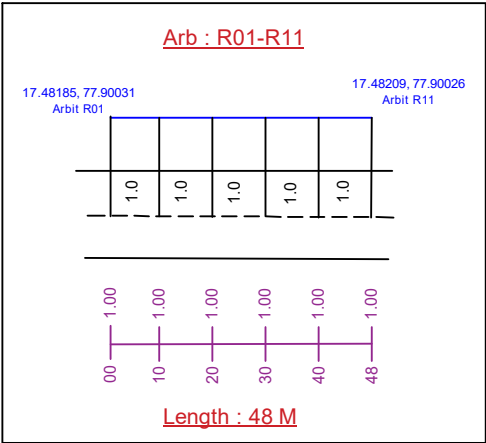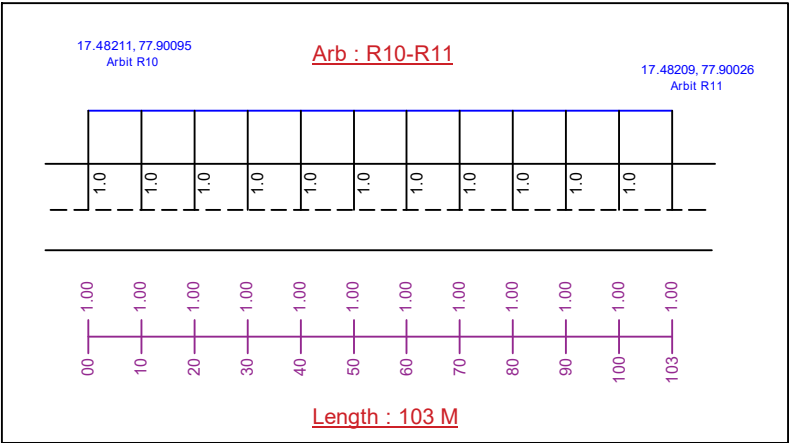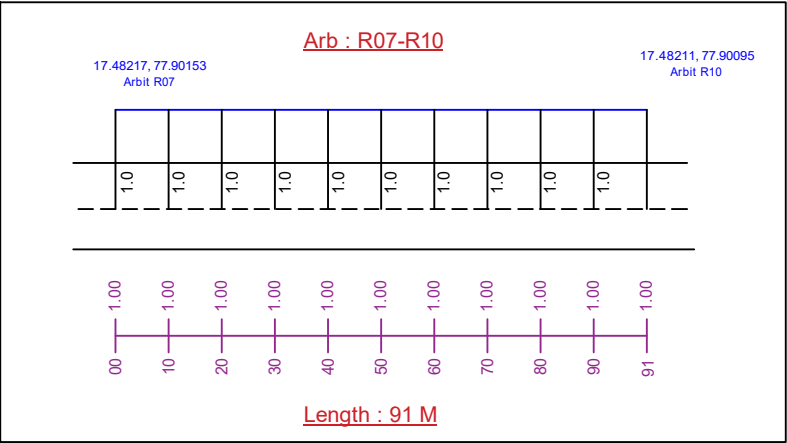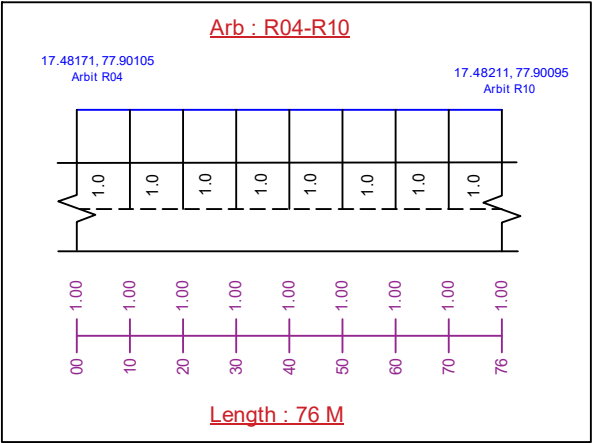


Checked	Designation	Signature

ROAD OFFSET DETAILING FOR MALLAREDDYGUDA (MOMINPET)

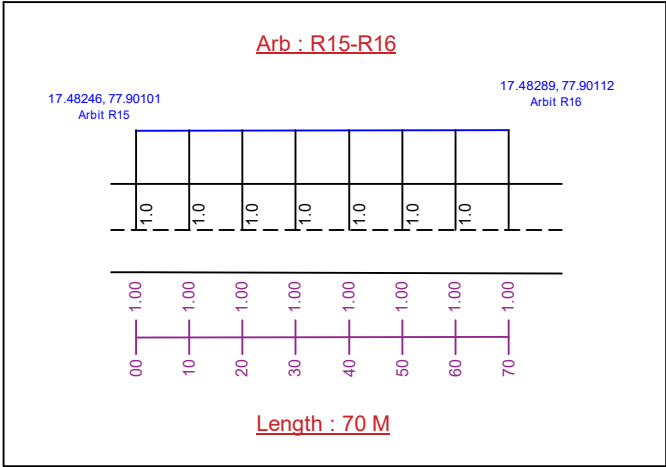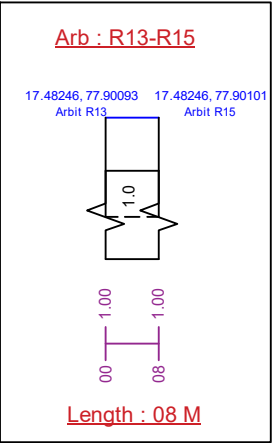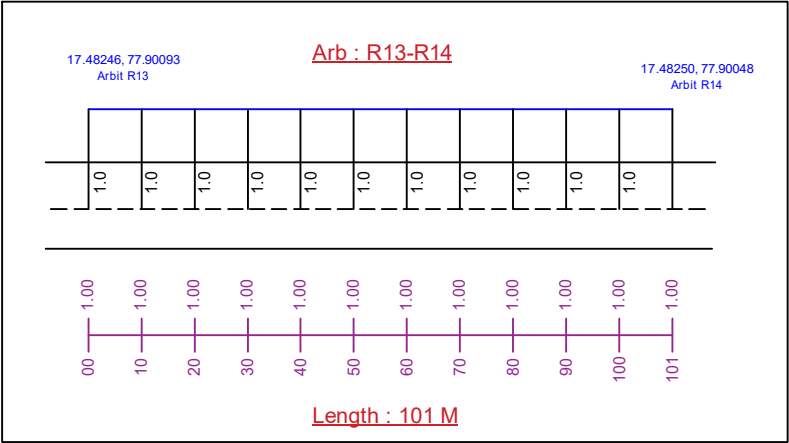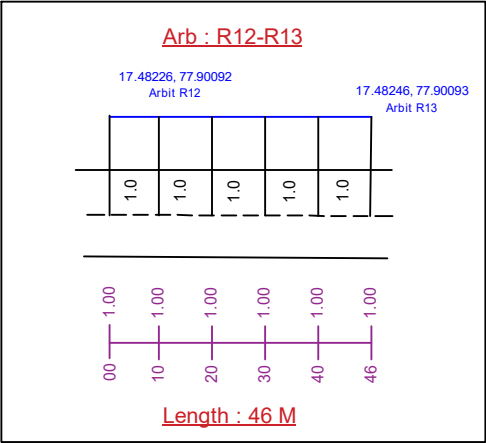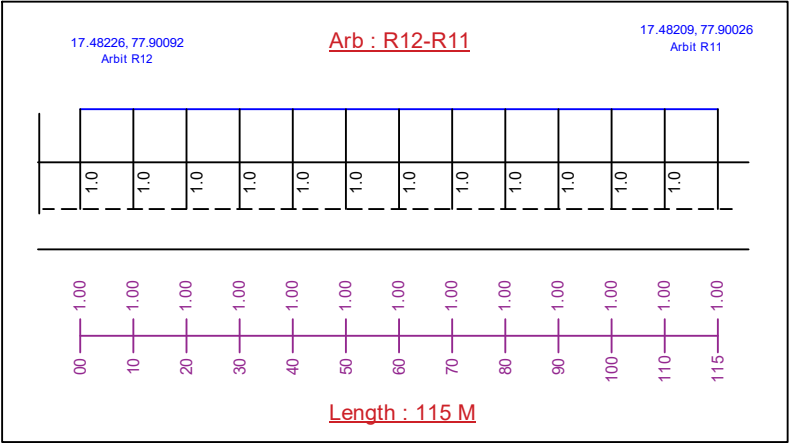

Checked	Designation	Signature

ROAD OFFSET DETAILING FOR MALLAREDDYGUDA (MOMINPET)

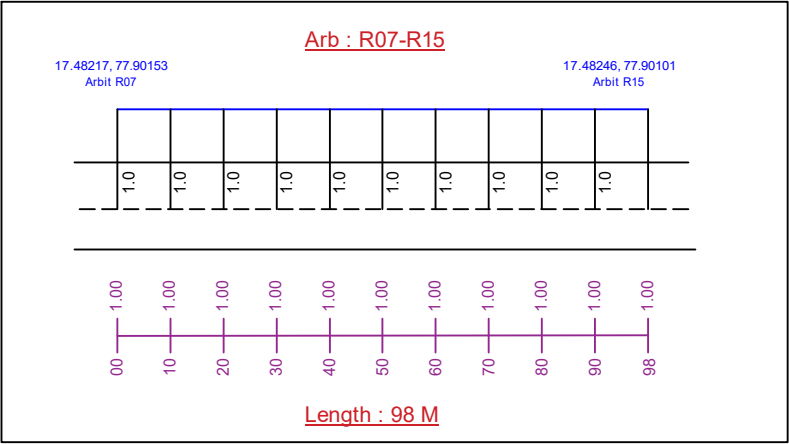

Sheet No. 05
Route Distance : 1586 M

Checked	Designation	Signature



TELANGANA FIBER GRID

TELANGANA FIBER GRID

ITE & C GOVERNMENT OF TELANGANA

7th Floor, Splendid Towers, S.P. Road

Opp: Begumpet Police Station,



Begumpet, Hyderabad-500016.


 






AS - BUILT DRAWINGS (ABD)

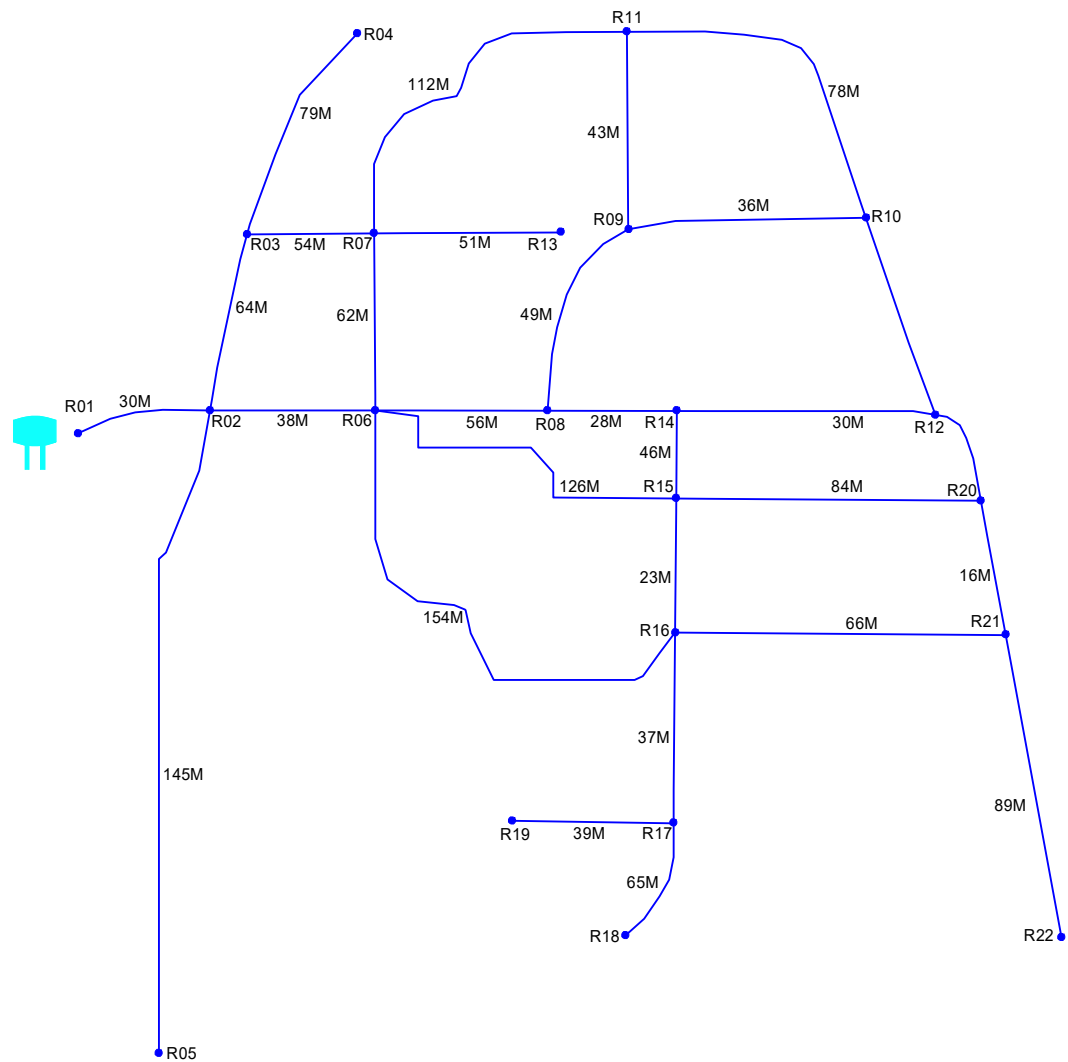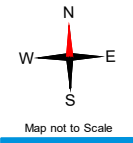MEKAVANAMPALLE

(MOMINPET MANDAL-VIKARABAD DIST.)

SINGLELINE LOOP DIAGRAM FOR MEKAVANAMPALLE OHSR1 (MOMINPET)






 






	DUCT PIPE
	ROAD
	OHSR
	G.P OFFICE
	TEMPLE
	HOSPITAL
	SCHOOL
	DUCT GAP

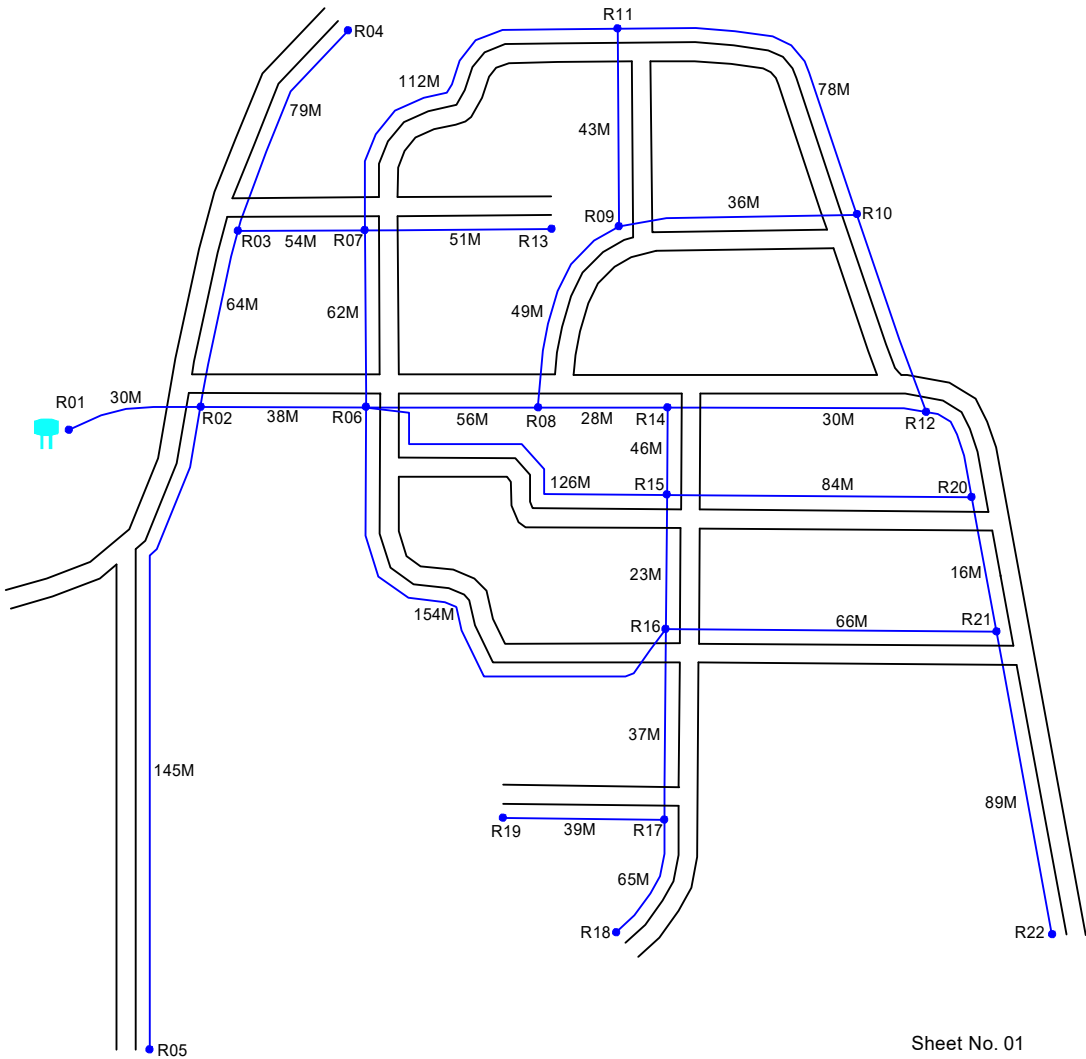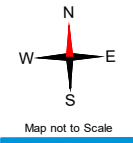Sheet No. 01
Route Distance : 5266 M

Checked	Designation	Signature

DUCTLAYING ROUTE DIAGRAM FOR MEKAVANAMPALLE OHSR1 (MOMINPET)




	DUCT PIPE
	ROAD
	OHSR
	G.P OFFICE
	TEMPLE
	HOSPITAL
	SCHOOL
	DUCT GAP

Sheet No. 01
Route Distance : 5266 M


Checked	Designation	Signature

ROAD OFFSET DETAILING FOR MEKAVANAMPALLE OHSR1 (MOMINPET)


Arb : R01-R02

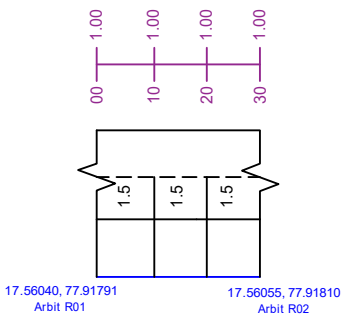


Arb : R02-R03

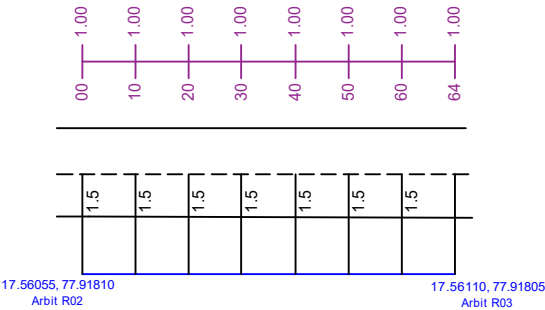


Arb : R03-R04

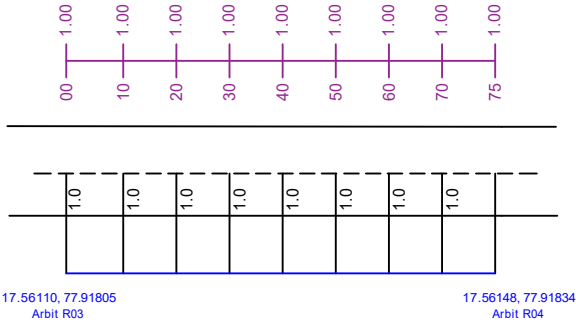

Arb : R02-R05

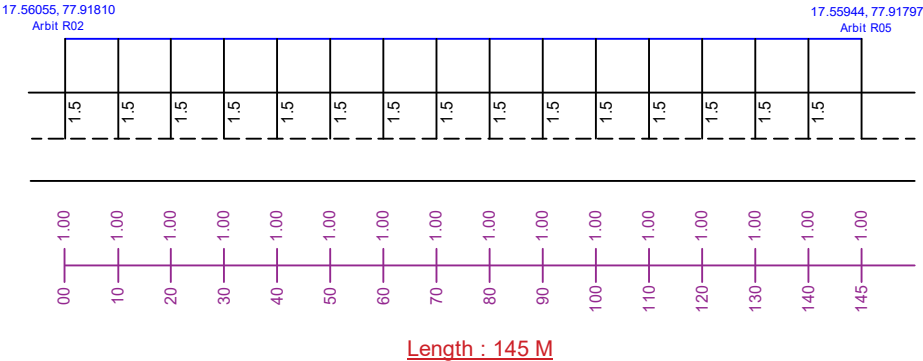


Arb : R02-R06

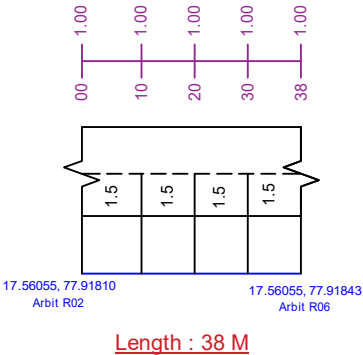

Checked	Designation	Signature


ROAD OFFSET DETAILING FOR MEKAVANAMPALLE OHSR1 (MOMINPET)

Arb : R06-R07

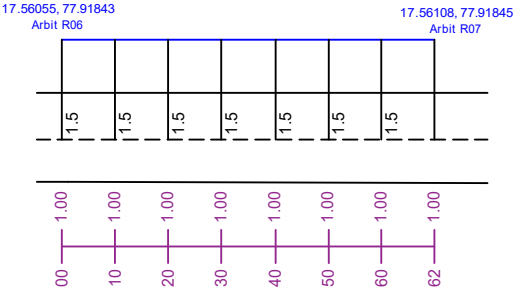


Length : 62 M

Arb : R06-R08

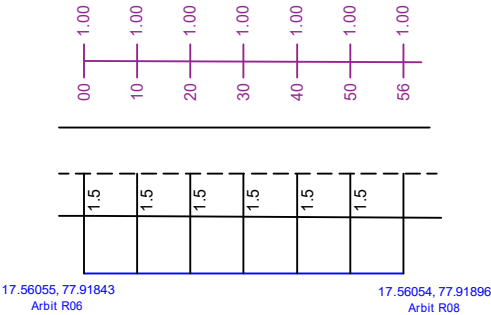


Length : 56 M

Arb : R08-R09

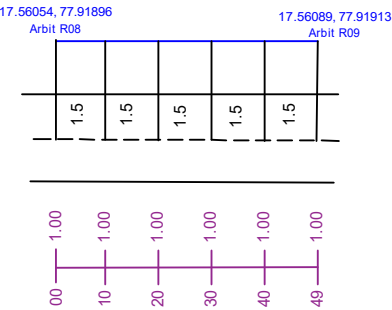


Length : 49 M

Arb : R09-R10

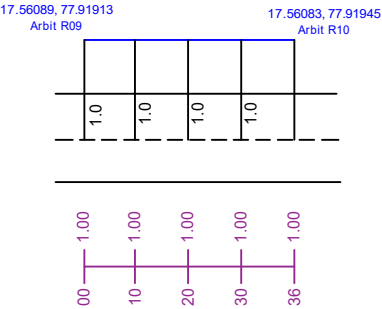


Length : 36 M

Arb : R10-R11

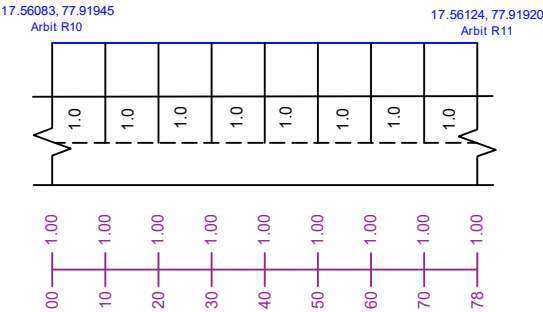

Length : 78 M








Arb : R09-R11

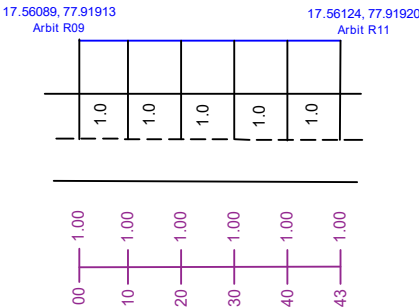

Length : 43 M

Checked	Designation	Signature


ROAD OFFSET DETAILING FOR MEKAVANAMPALLE OHSR1 (MOMINPET)

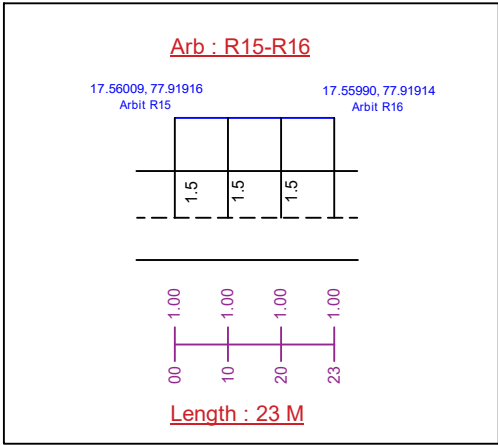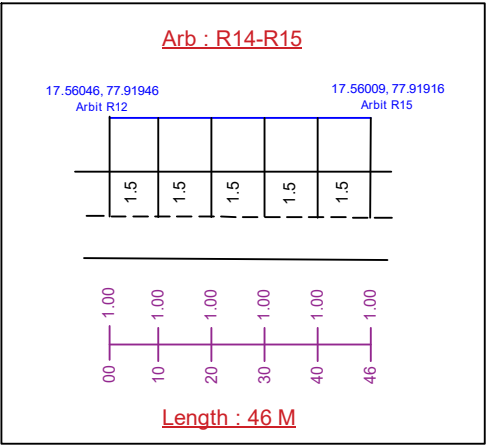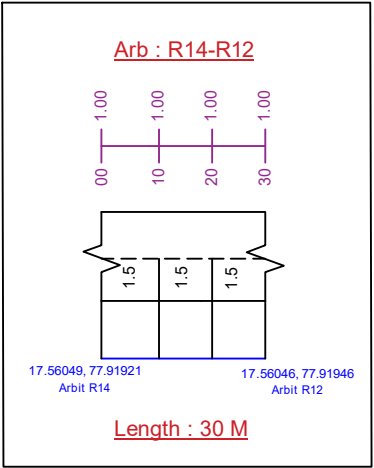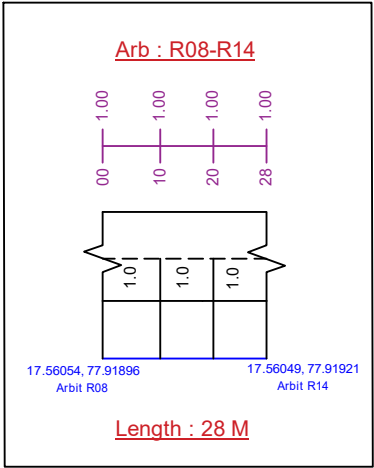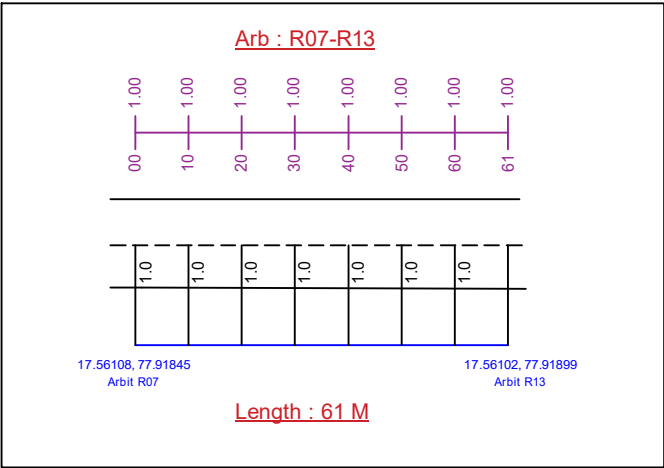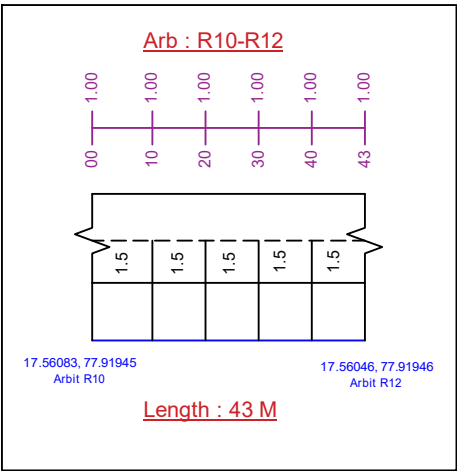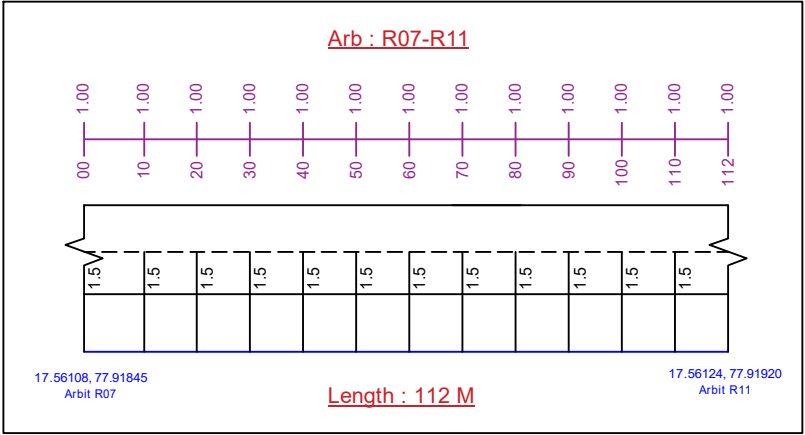

Checked	Designation	Signature


ROAD OFFSET DETAILING FOR MEKAVANAMPALLE OHSR1 (MOMINPET)

Arb : R16-R19

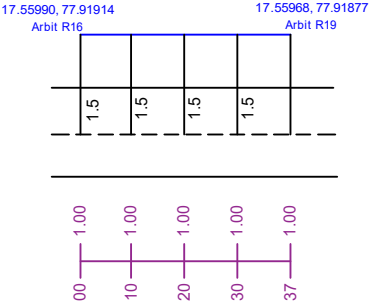


Length : 37 M

Arb : R17-R18

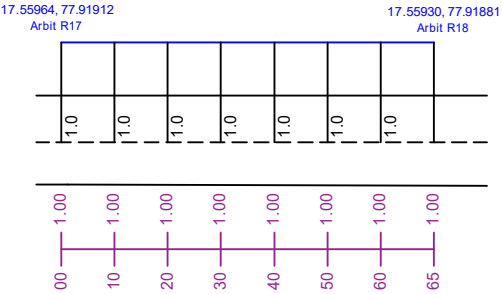


Length : 65 M

Arb : R17-R19

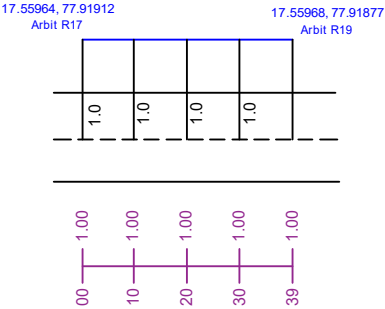


Length : 39 M

Arb : R17-R19

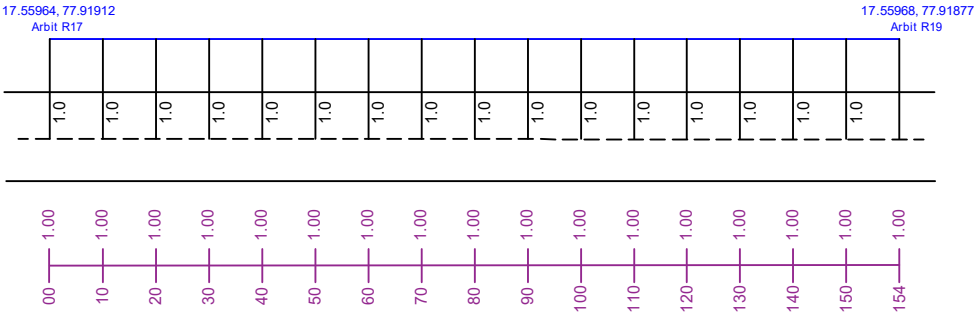

Length : 154 M

Arb : R06-R15

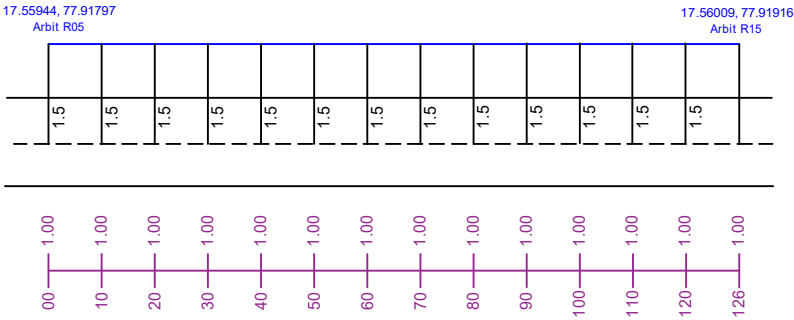


Length : 126 M

Sheet No. 04
Route Distance : 5266 M

Checked	Designation	Signature


ROAD OFFSET DETAILING FOR MEKAVANAMPALLE OHSR1 (MOMINPET)

Arb : R03-R07

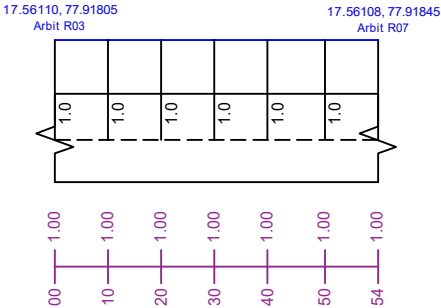


Length : 54 M

Arb : R16-R21

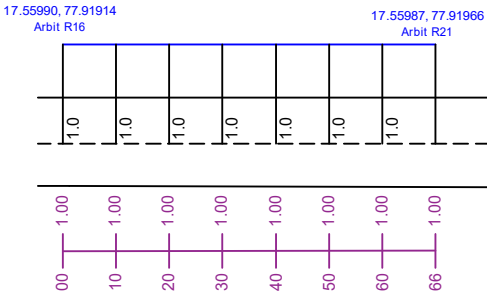


Length : 66 M

Arb : R15-R20

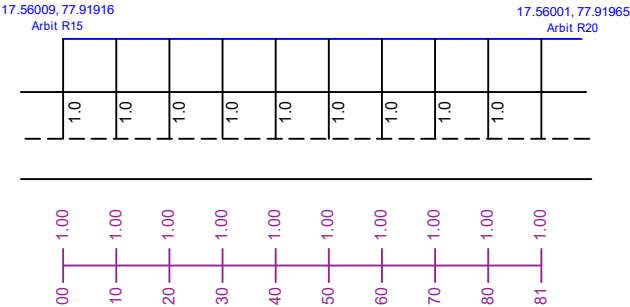


Length : 81 M

Arb : R20-R21

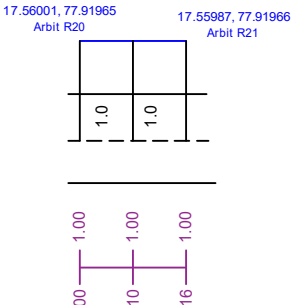

Length : 16 M



Arb : R21-R22

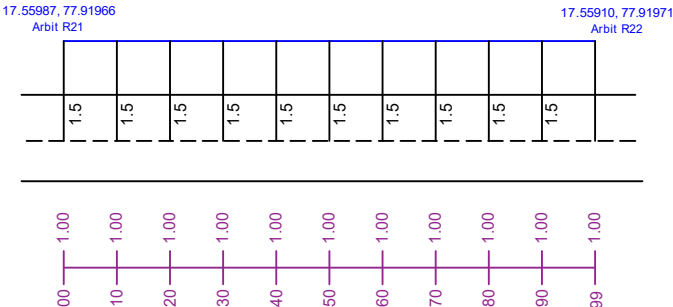
 






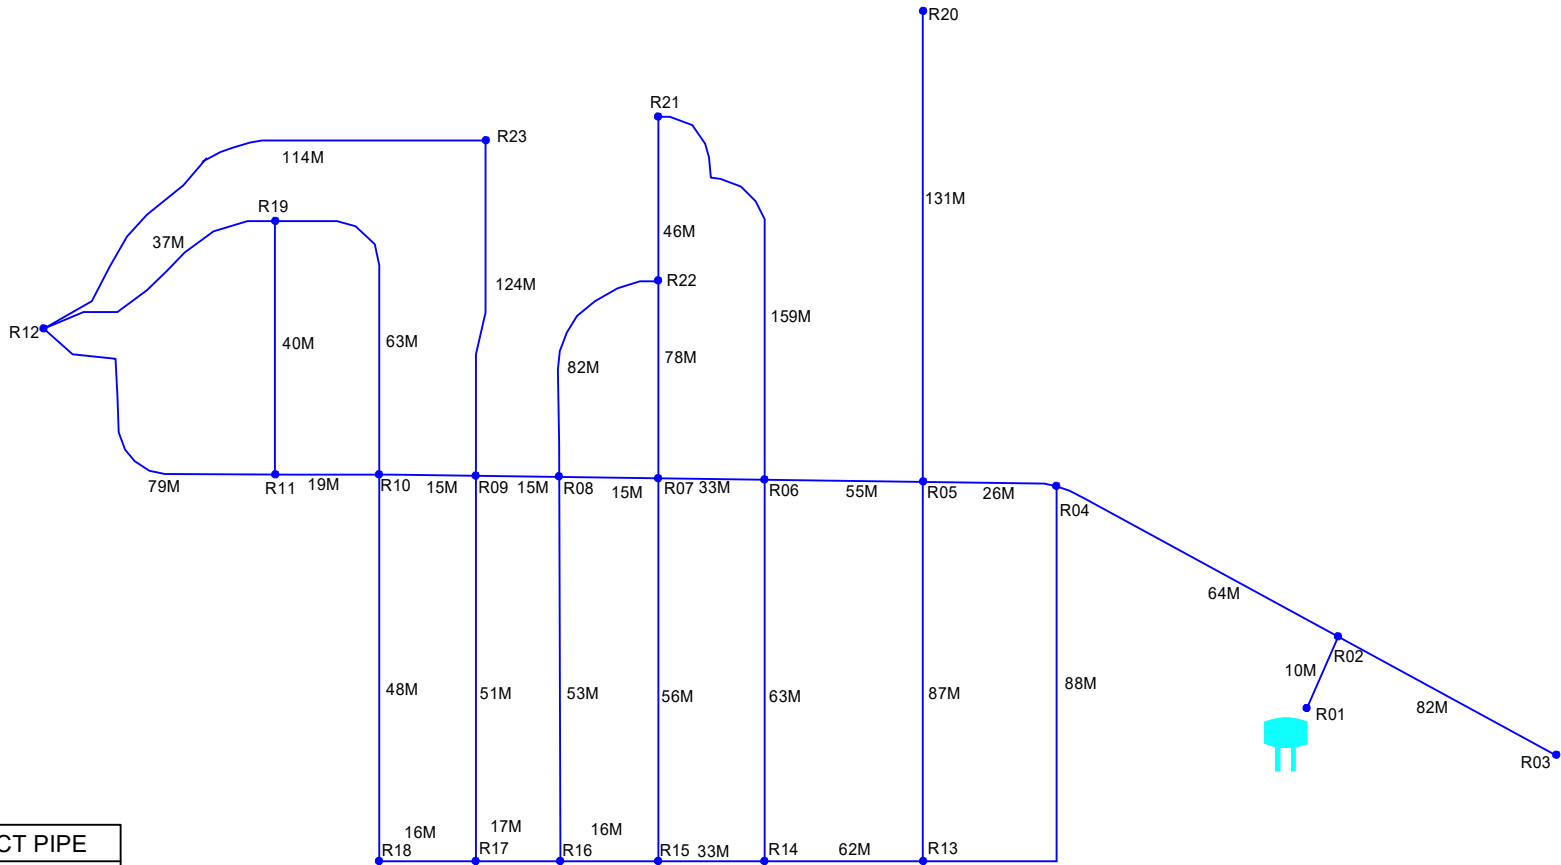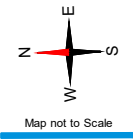

Length : 99 M

Checked	Designation	Signature

SINGLELINE LOOP DIAGRAM FOR MEKAVANAMPALLE OHSR2 (MOMINPET)





	DUCT PIPE
	ROAD
	OHSR
	G.P OFFICE
	TEMPLE
	HOSPITAL
	SCHOOL
	DUCT GAP

Sheet No. 01
Route Distance : 5266 M

Checked	Designation	Signature

DUCTLAYING ROUTE DIAGRAM FOR MEKAVANAMPALLE OHSR2 (MOMINPET)

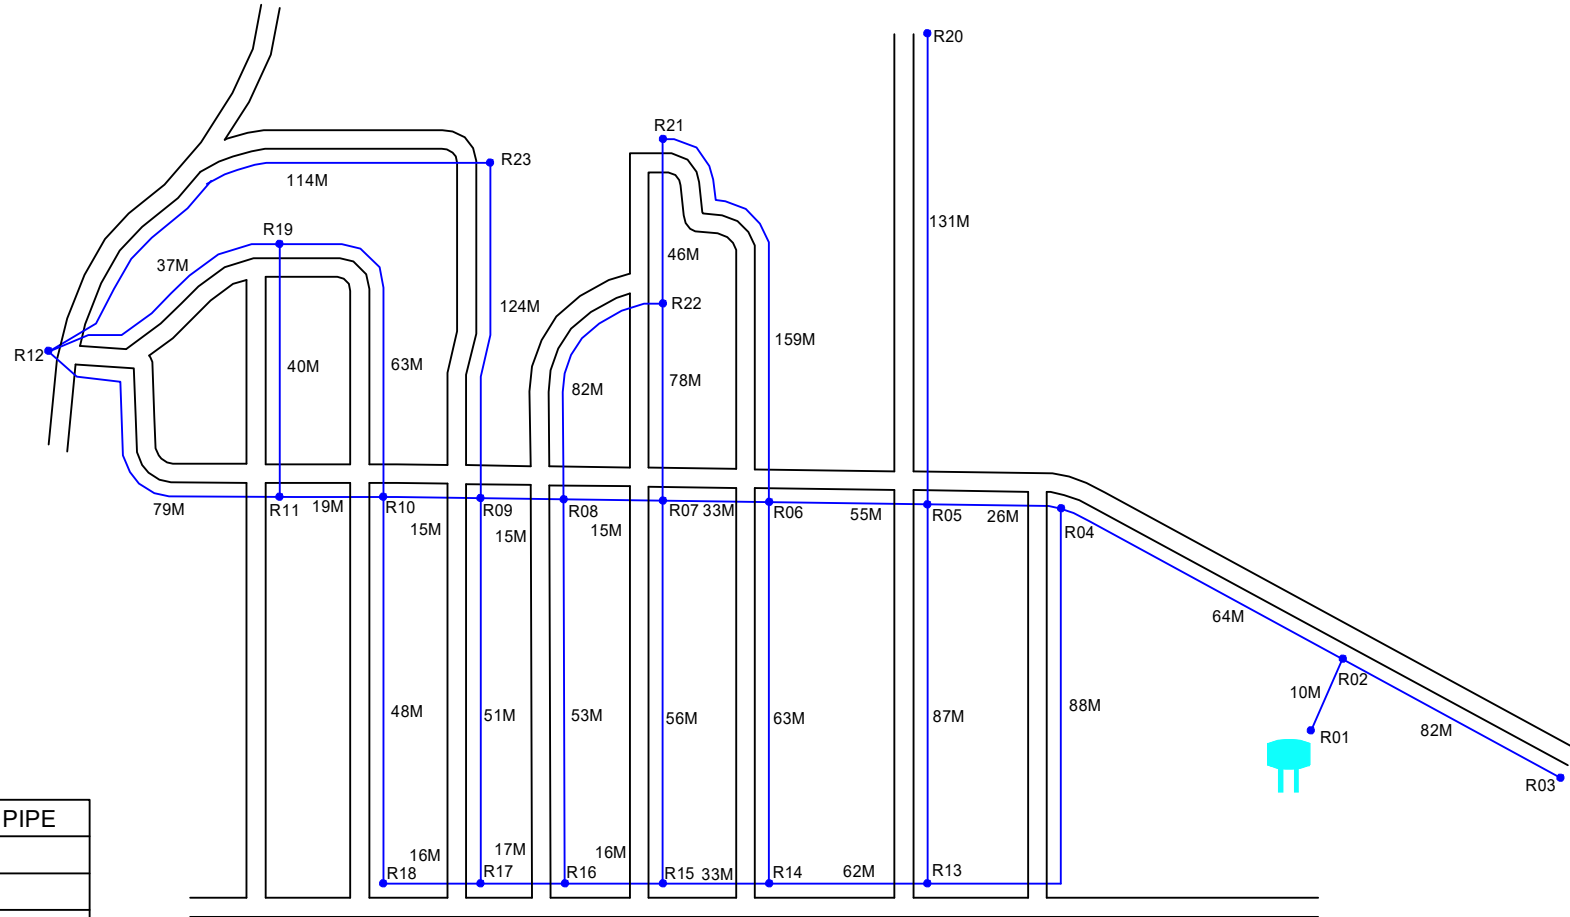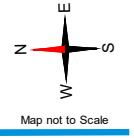


	DUCT PIPE
	ROAD
	OHSR
	G.P OFFICE
	TEMPLE
	HOSPITAL
	SCHOOL
	DUCT GAP

Sheet No. 01
Route Distance : 5266 M


Checked	Designation	Signature

ROAD OFFSET DETAILING FOR MEKAVANAMPALLE OHSR2 (MOMINPET)


Arb : R01-R02

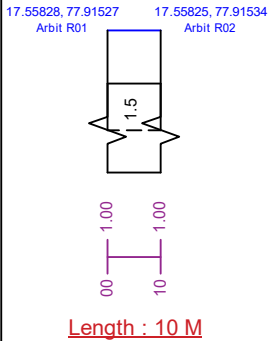


Arb : R02-R03

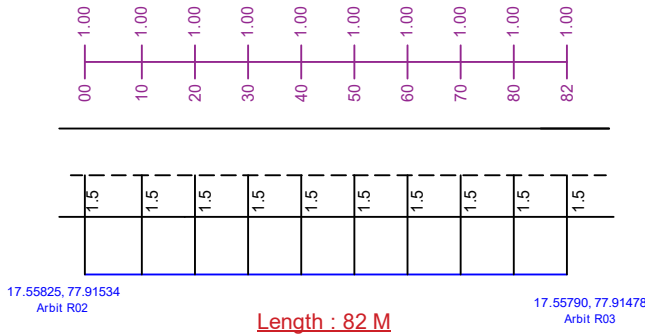


Arb : R02-R04

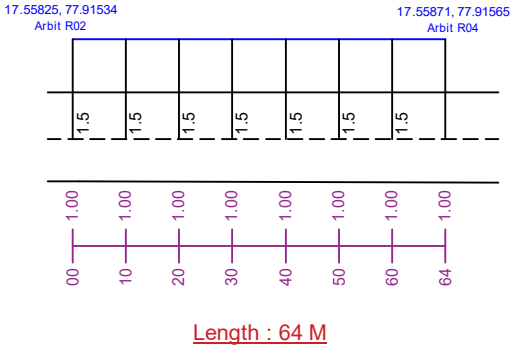


Arb : R04-R05

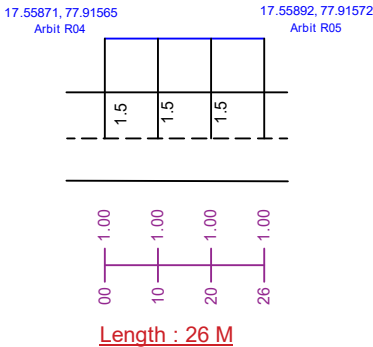

Arb : R05-R06

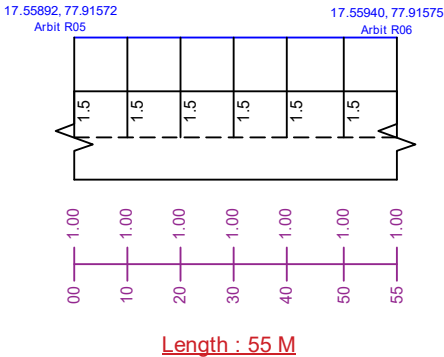


Arb : R06-R07

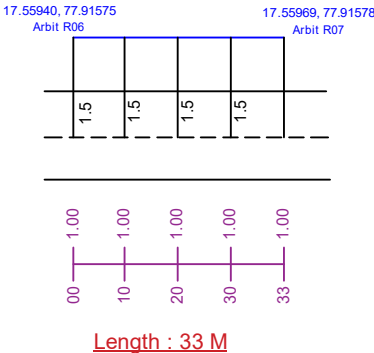


Checked	Designation	Signature

ROAD OFFSET DETAILING FOR MEKAVANAMPALLE OHSR2 (MOMINPET)


Arb : R07-R08

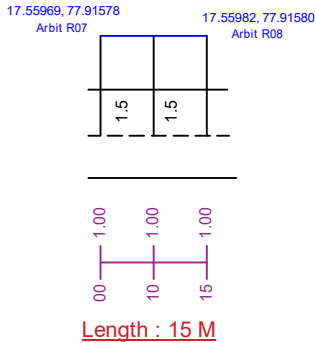


Arb : R08-R09

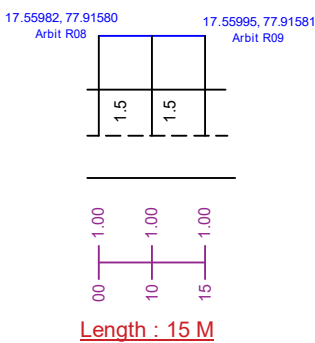


Arb : R10-R11

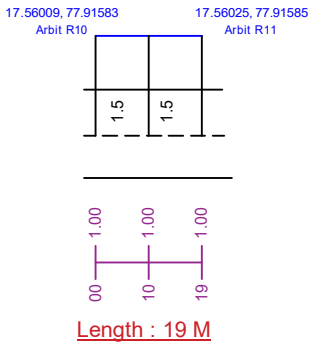


Arb : R11-R12

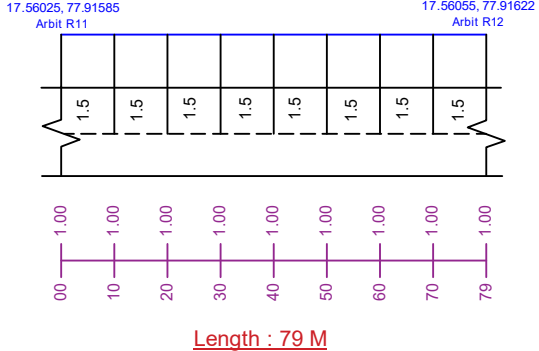

Arb : R04-R14

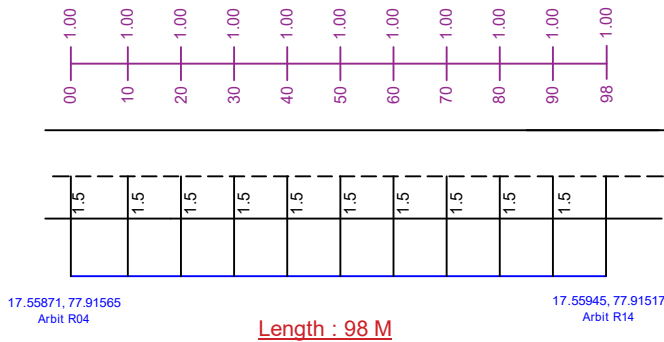


Arb : R06-R13

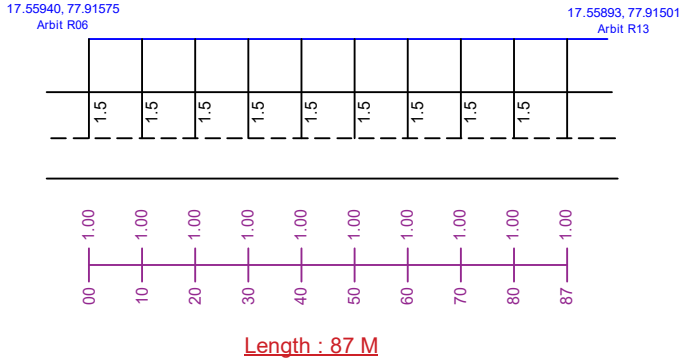

Checked	Designation	Signature

ROAD OFFSET DETAILING FOR MEKAVANAMPALLE OHSR2 (MOMINPET)

Arb : R13-R14

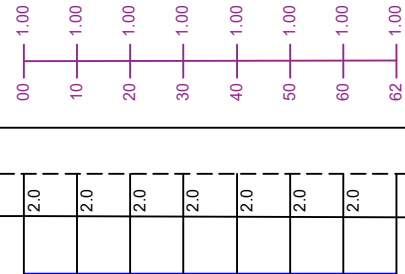


17.55893, 77.91501
Arbit R13

17.55945, 77.91517
Arbit R14

Length : 62 M

Arb : R14-R06

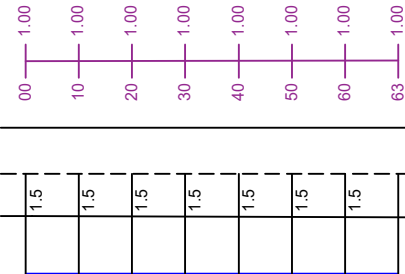


17.55945, 77.91517
Arbit R14

17.55940, 77.91575
Arbit R06

Length : 63 M

Arb : R14-R15

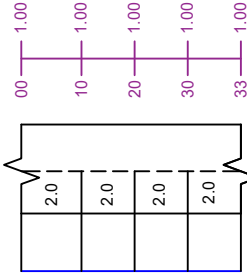


17.55945, 77.91517
Arbit R14

17.55973, 77.91526
Arbit R15

Length : 33 M

Arb : R16-R07

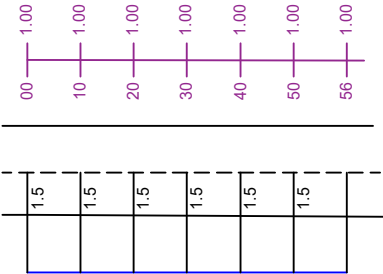


17.55986, 77.915305
Arbit R16

17.55969, 77.91578
Arbit R07

Length : 56 M

Arb : R15-R16

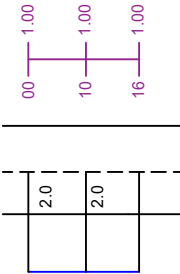


17.55973, 77.91526
Arbit R15

17.55986, 77.915305
Arbit R16

Length : 16 M

Arb : R16-R17

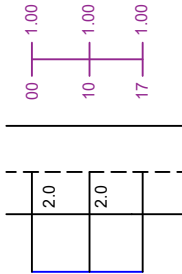


17.55986, 77.915305
Arbit R16

17.56001, 77.91534
Arbit R17

Length : 17 M

Arb : R17-R18

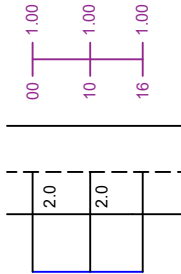

17.56001, 77.91534
Arbit R17


17.56014, 77.91538
Arbit R18

Length : 16 M


Checked	Designation	Signature

ROAD OFFSET DETAILING FOR MEKAVANAMPALLE OHSR2 (MOMINPET)


Arb : R18-R12

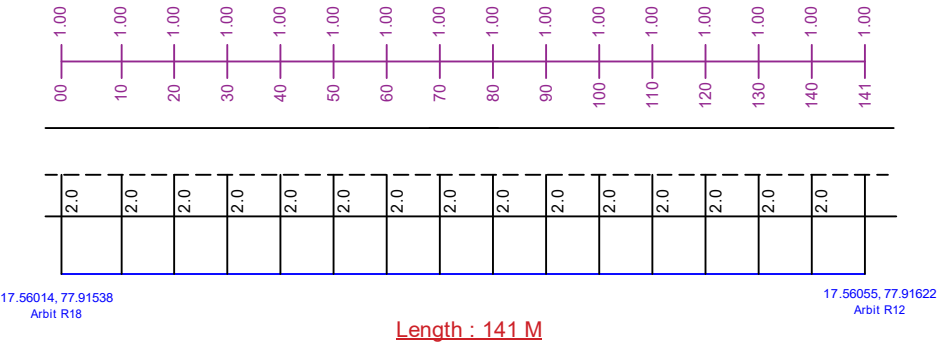


Arb : R16-R08

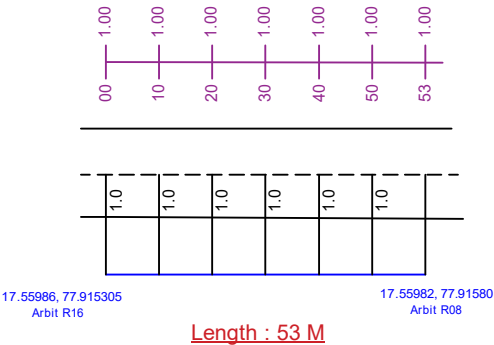


Arb : R17-R09

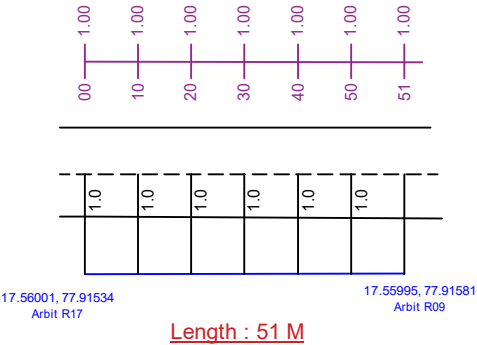

Arb : R18-R10



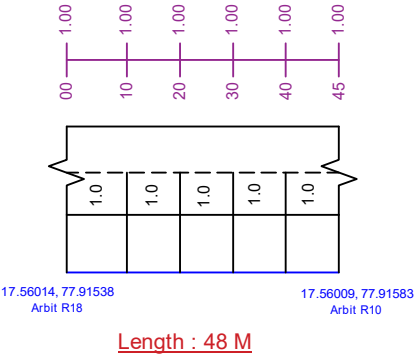


Arb : R11-R19

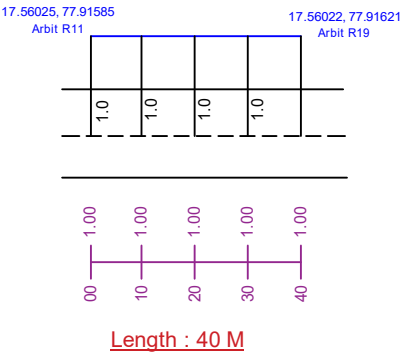

Checked	Designation	Signature


ROAD OFFSET DETAILING FOR MEKAVANAMPALLE OHSR2 (MOMINPET)

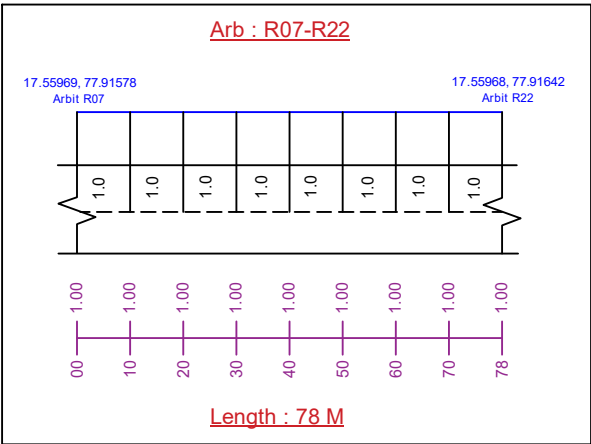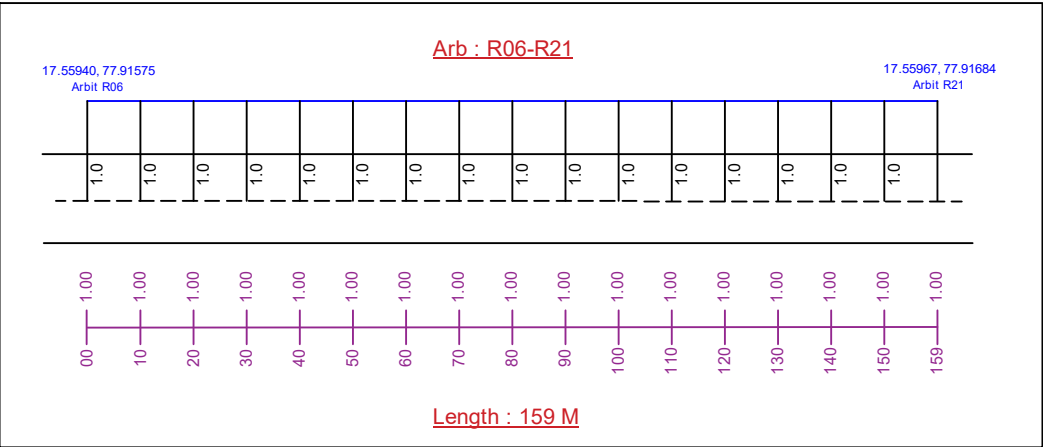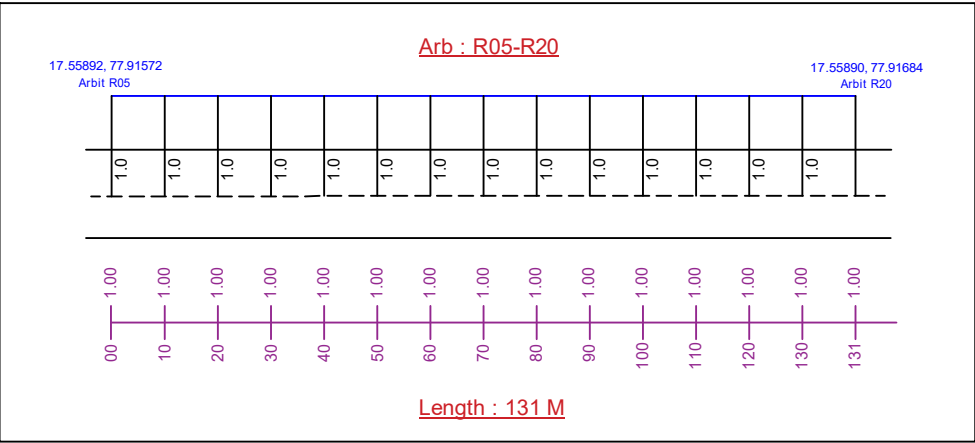


Checked	Designation	Signature

ROAD OFFSET DETAILING FOR MEKAVANAMPALLE OHSR2 (MOMINPET)


Arb : R08-R22

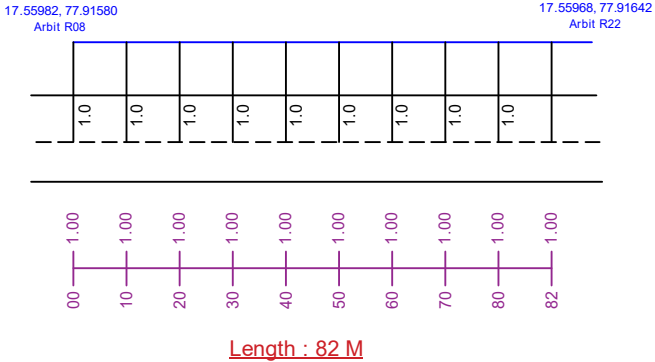


Arb : R22-R21

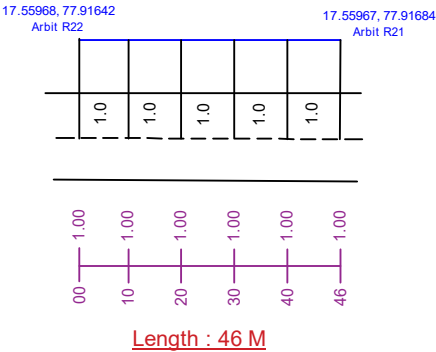

Arb : R09-R23

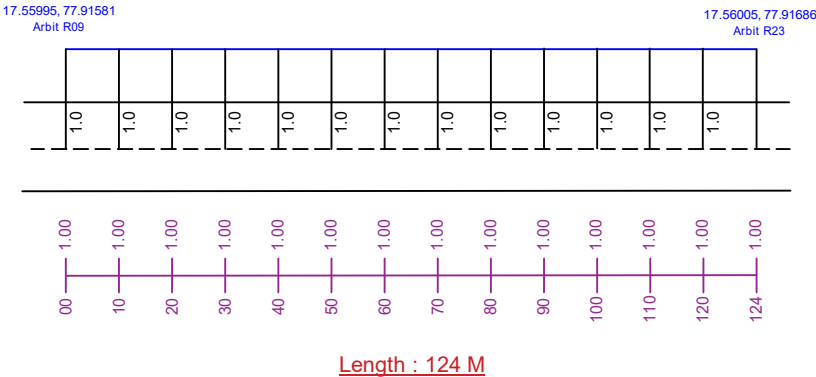


Arb : R10-R19

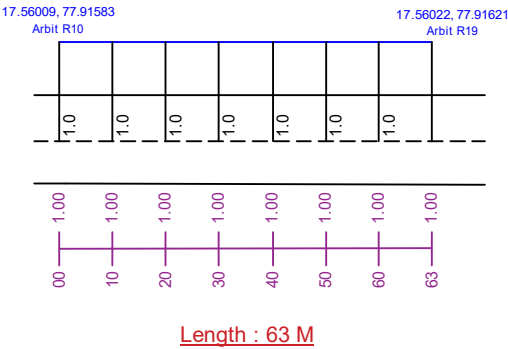


Checked	Designation	Signature

ROAD OFFSET DETAILING FOR MEKAVANAMPALLE OHSR2 (MOMINPET)

Arb : R19-R12


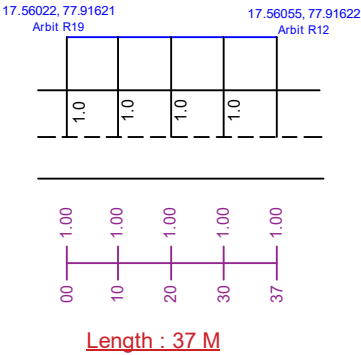



 


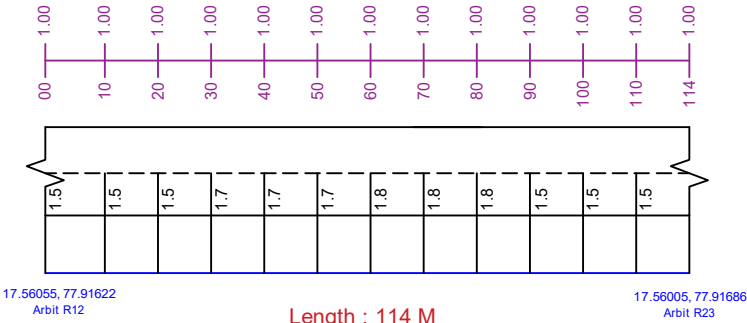



Arb : R12-R23

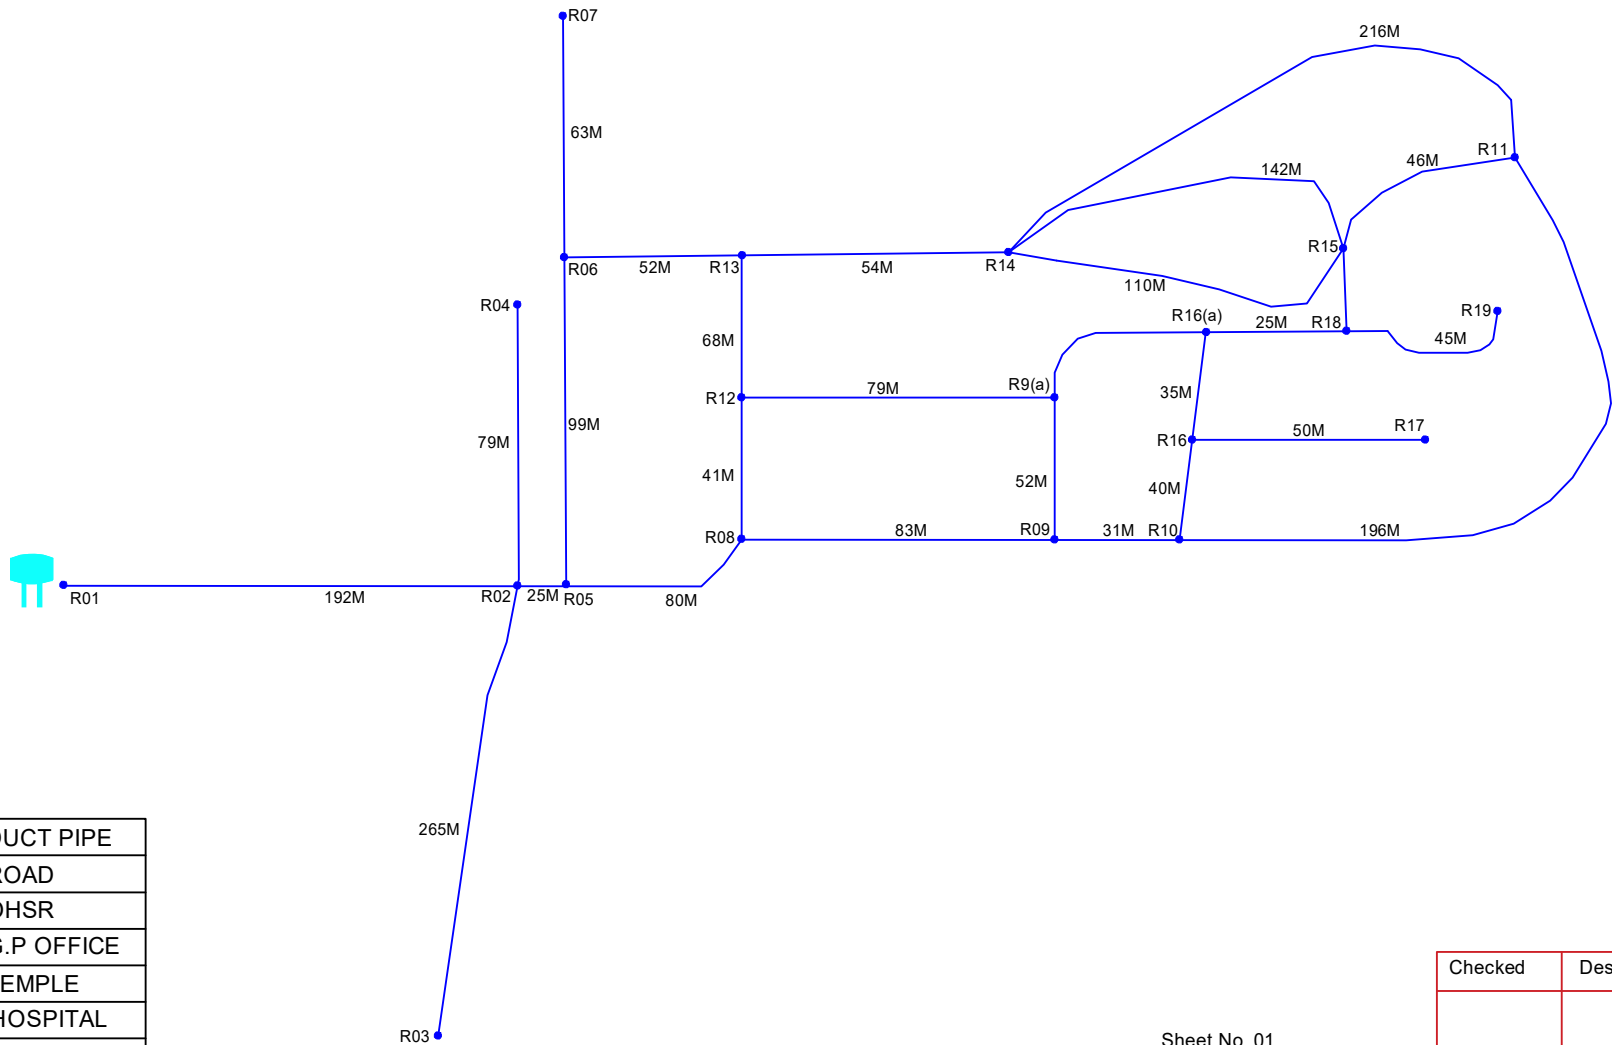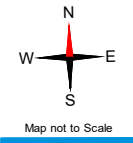

Checked	Designation	Signature

SINGLELINE LOOP DIAGRAM FOR MEKAVANAMPALLE OHSR3 (MOMINPET)





	DUCT PIPE
	ROAD
	OHSR
	G.P OFFICE
	TEMPLE
	HOSPITAL
	SCHOOL
	DUCT GAP

Sheet No. 01
Route Distance : 5266 M

Checked	Designation	Signature

DUCTLAYING ROUTE DIAGRAM FOR MEKAVANAMPALLE OHSR3 (MOMINPET)

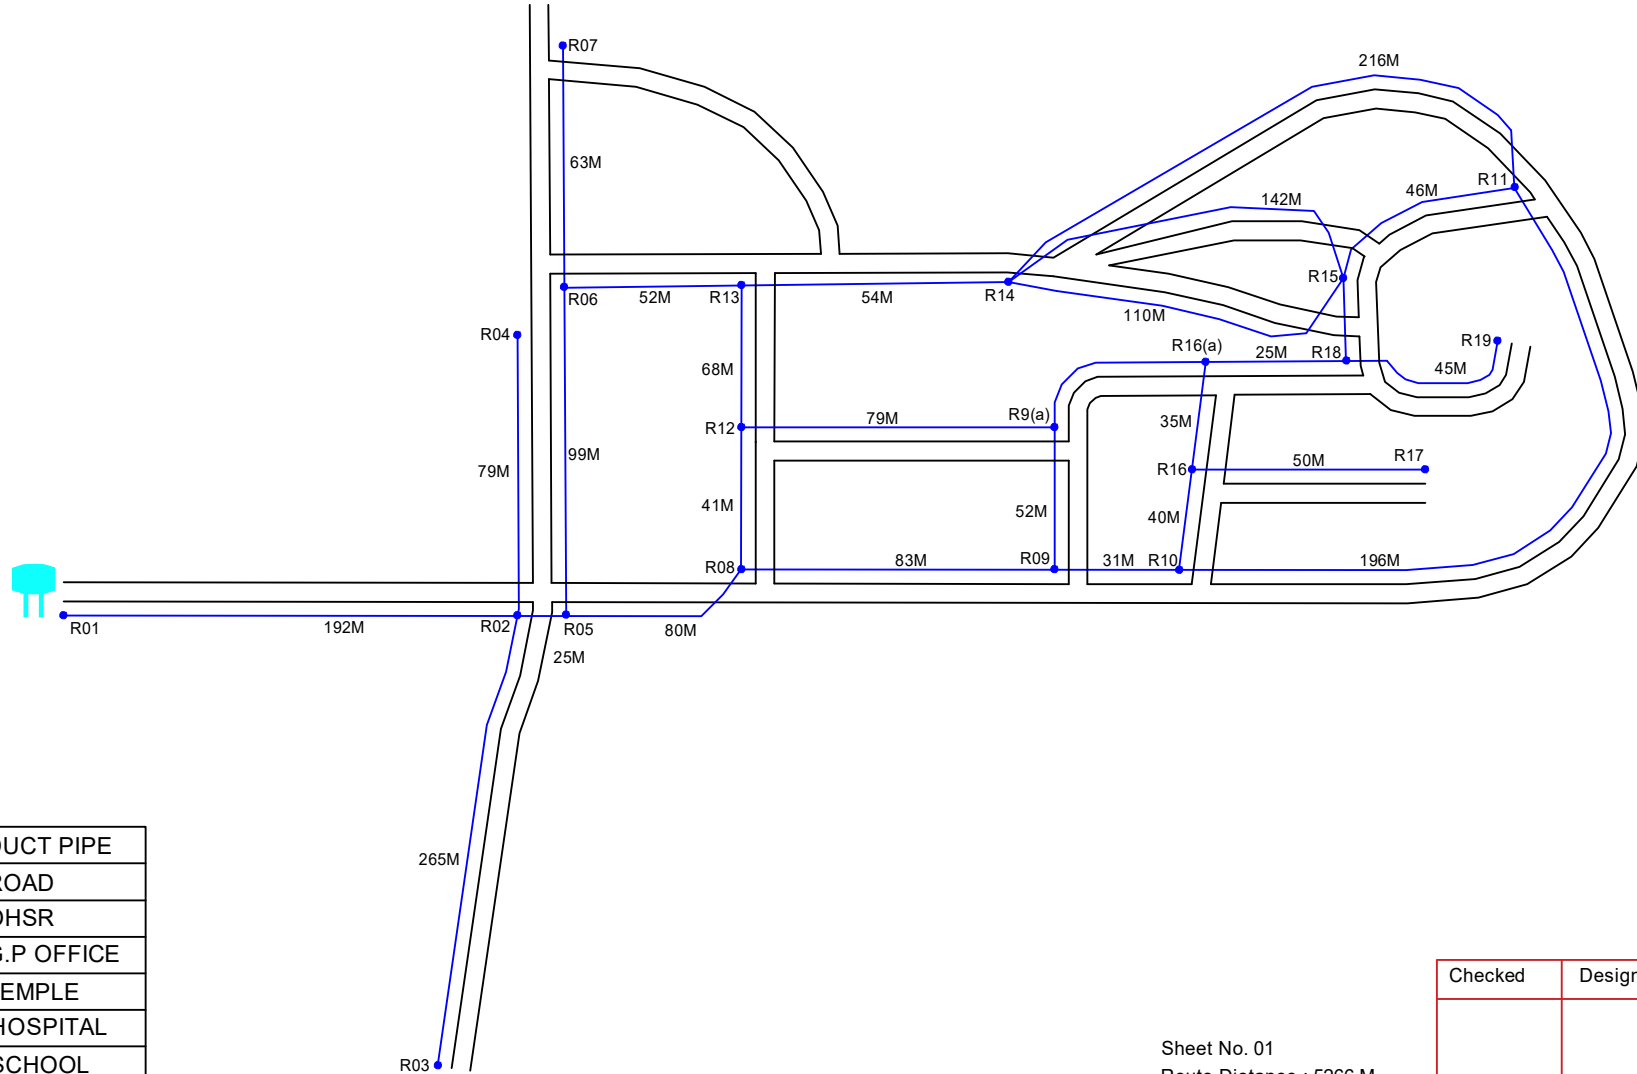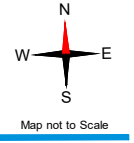



	DUCT PIPE
	ROAD
	OHSR
	G.P OFFICE
	TEMPLE
	HOSPITAL
	SCHOOL
	DUCT GAP

Sheet No. 01
Route Distance : 5266 M

Checked	Designation	Signature

ROAD OFFSET DETAILING FOR MEKAVANAMPALLE OHSR3 (MOMINPET)

Arb : R01-R02

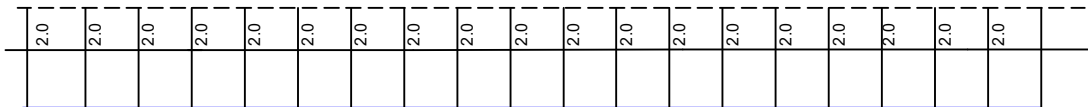
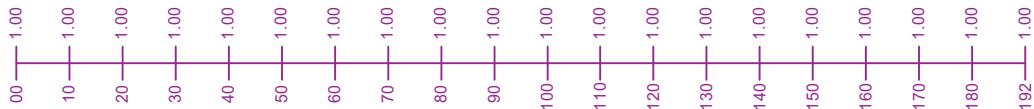


17.56078, 77.91380
Arbit R01

17.56077, 77.91534
Arbit R02

Length : 192 M



Arb : R02-R03

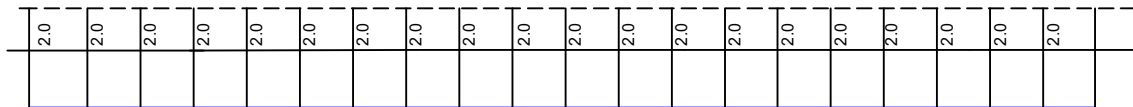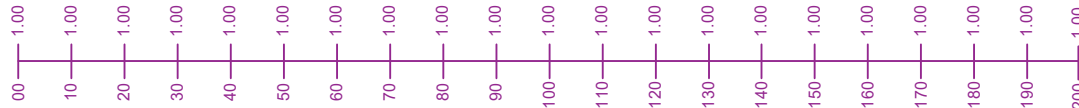

17.56077, 77.91534
Arbit R02

Length : 265 M

Arb : R02-R03

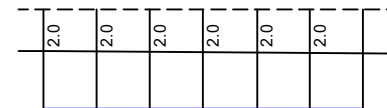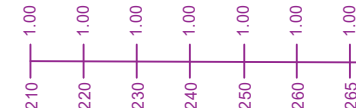

17.55862, 77.91464
Arbit R03


Length : 265 M

Checked	Designation	Signature


Sheet No. 01
Route Distance : 5266 M

ROAD OFFSET DETAILING FOR MEKAVANAMPALLE OHSR3 (MOMINPET)


Arb : R02-R04

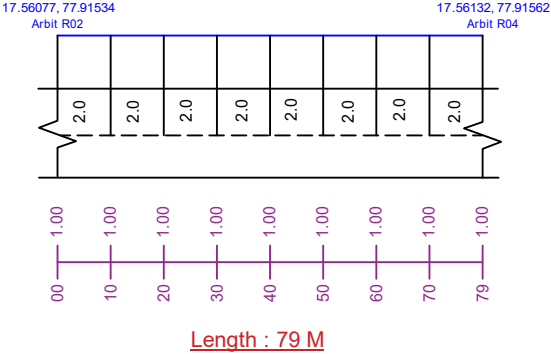


Arb : R02-R05

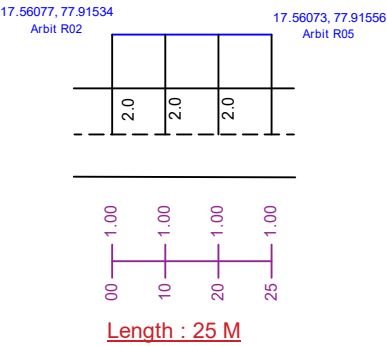


Arb : R05-R06

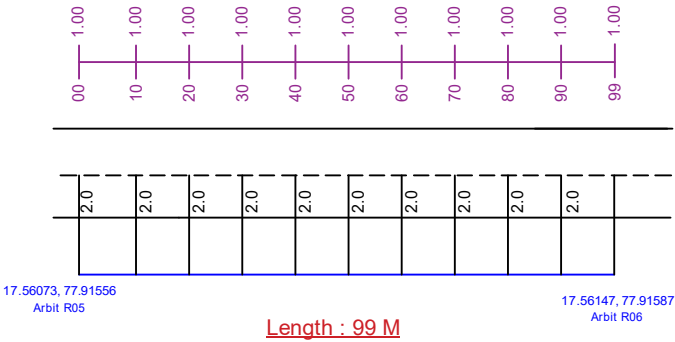

Arb : R06-R07

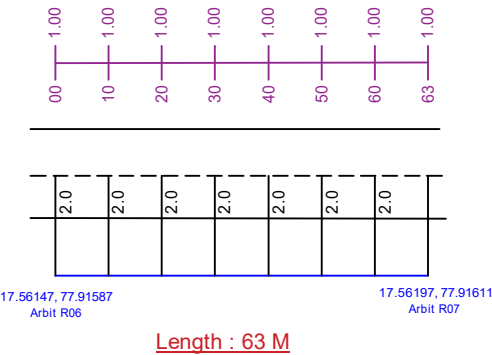


Arb : R05-R08

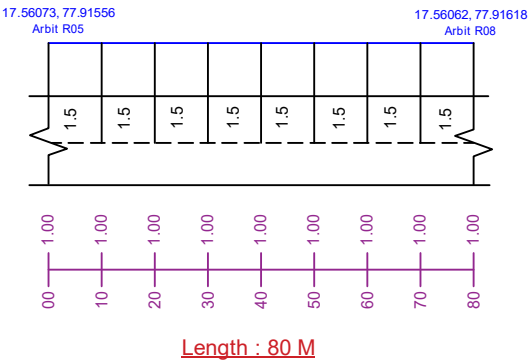


Checked	Designation	Signature

ROAD OFFSET DETAILING FOR MEKAVANAMPALLE OHSR3 (MOMINPET)


Arb : R08-R09

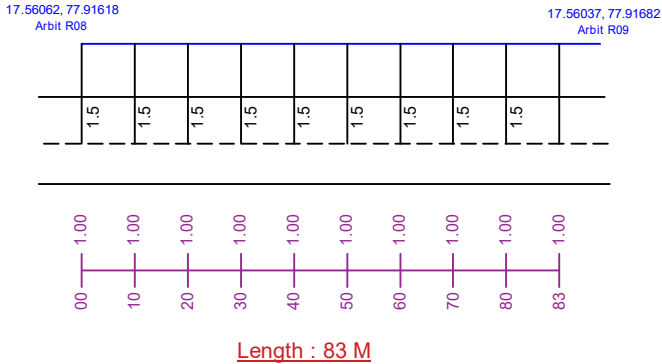


Arb : R09-R10

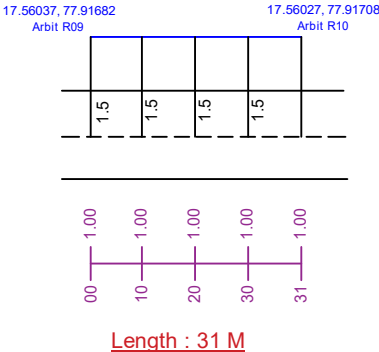

Arb : R10-R11

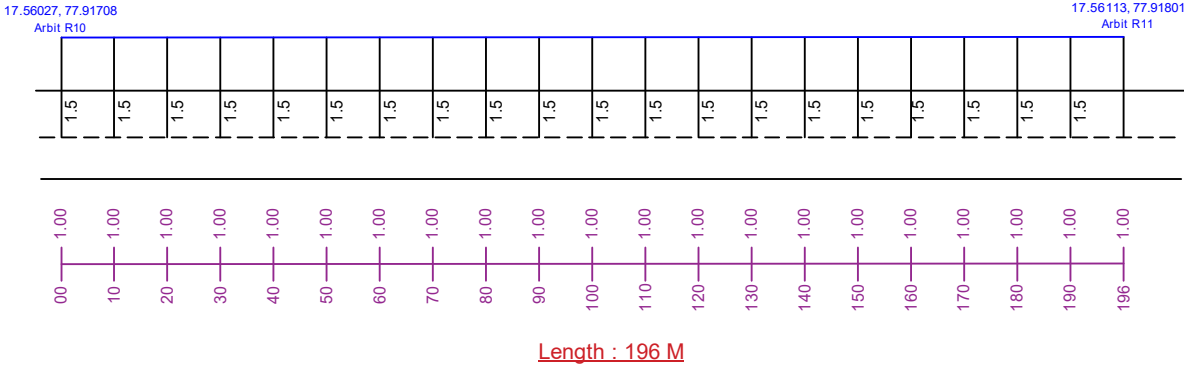


Arb : R08-R12

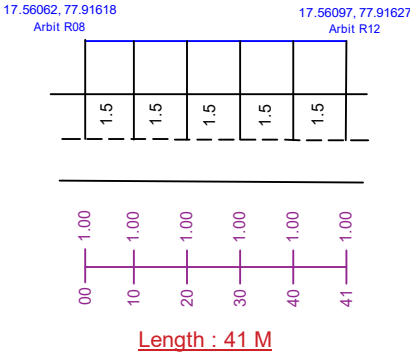

Checked	Designation	Signature


ROAD OFFSET DETAILING FOR MEKAVANAMPALLE OHSR3 (MOMINPET)

Arb : R12-R13

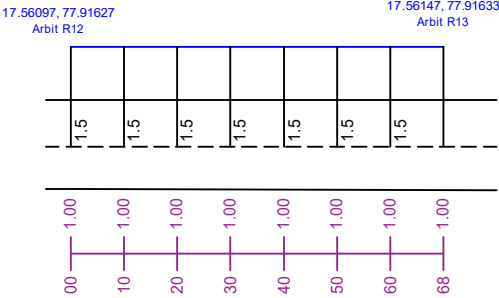


Length : 68 M

Arb : R06-R13

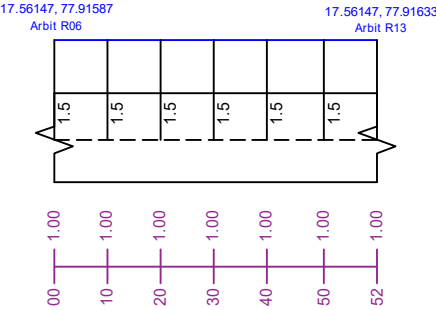


Length : 52 M

Arb : R13-R14

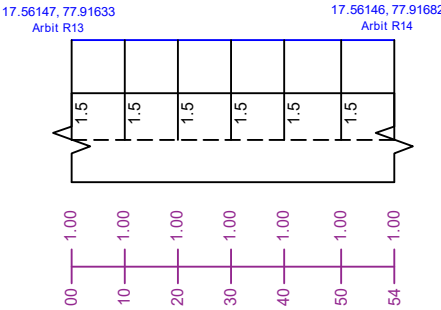


Length : 54 M

Arb : R14-R15

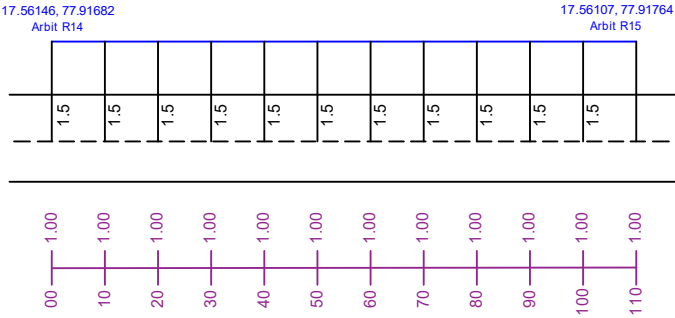

Length : 110 M

Arb : R14-R16

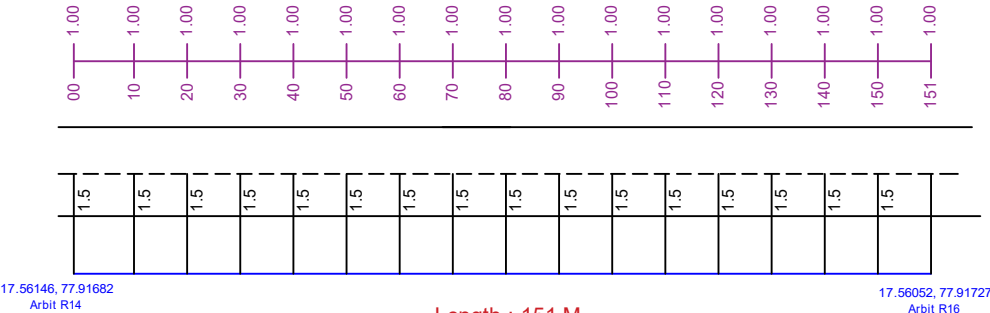


Length : 151 M

Checked	Designation	Signature


ROAD OFFSET DETAILING FOR MEKAVANAMPALLE OHSR3 (MOMINPET)

Arb : R14-R11

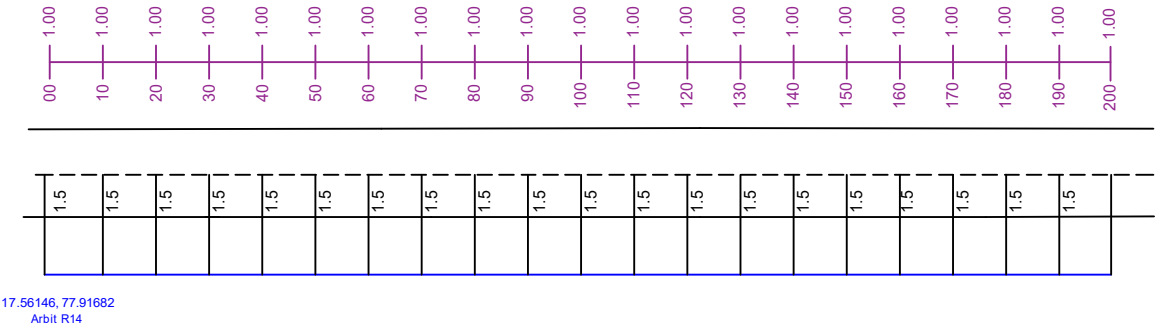


Length : 216 M

Arb : R14-R16

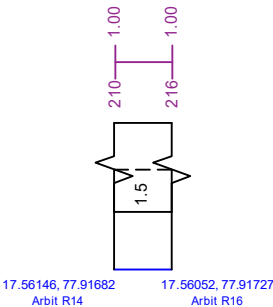


Length : 216 M

Arb : R15-R11

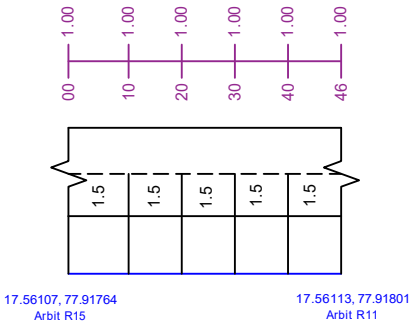


Length : 46 M

Arb : R12-R9(a)

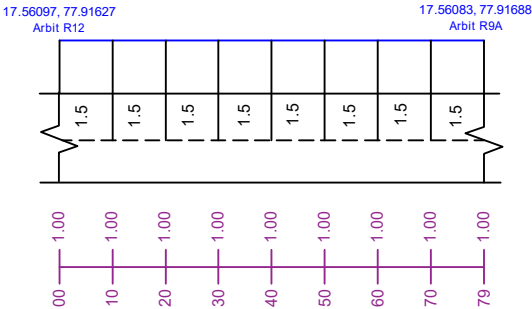

Length : 79 M

Arb : R09-R9(a)

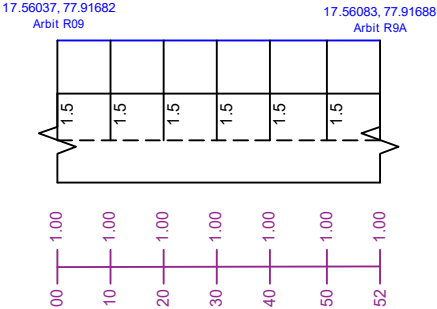


Length : 52 M

Sheet No. 05
Route Distance : 5266 M

Checked	Designation	Signature


ROAD OFFSET DETAILING FOR MEKAVANAMPALLE OHSR3 (MOMINPET)

Arb : R10-R16

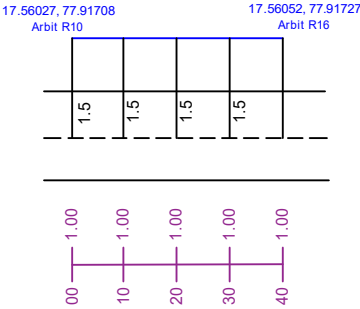


Length : 40 M

Arb : R16-R16(a)

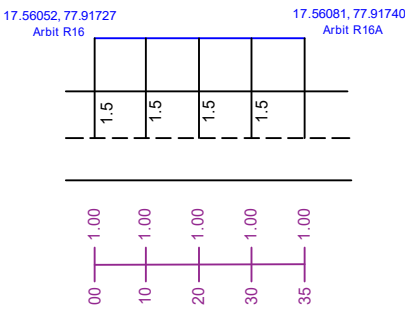


Length : 35 M

Arb : R9(a)-R16(a)

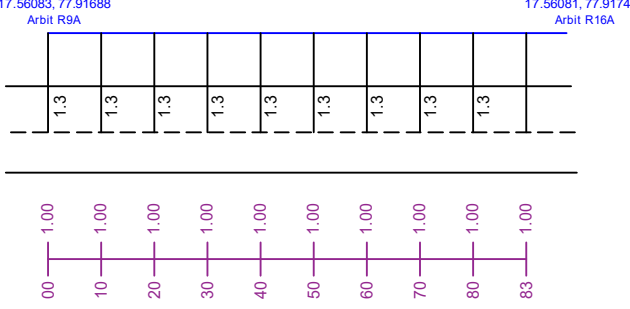


Length : 83 M

Arb : R16-R17

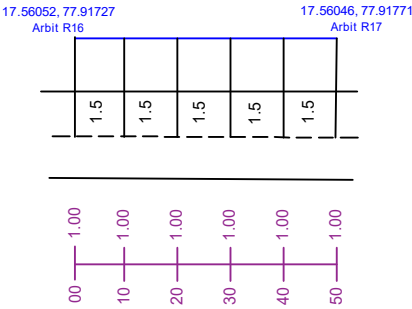


Length : 50 M

Arb : R16(a)-R18

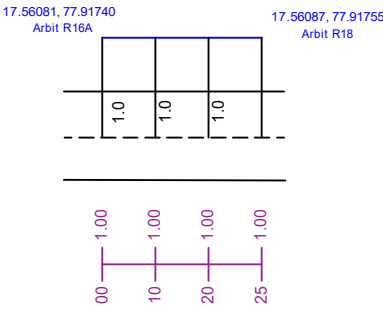

Length : 25 M


Arb : R18-R15

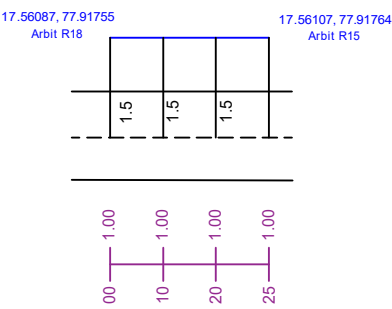

Length : 25 M

Checked	Designation	Signature

ROAD OFFSET DETAILING FOR MEKAVANAMPALLE OHSR3 (MOMINPET)

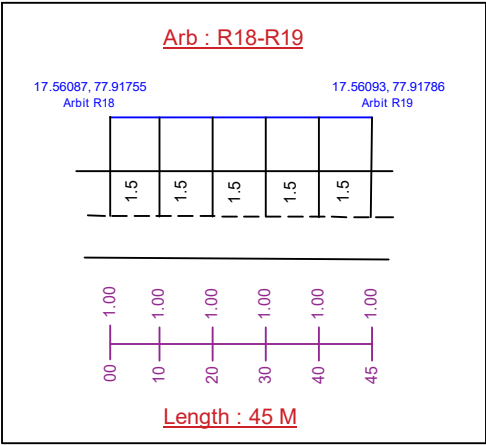

Sheet No. 07
Route Distance : 5266 M

Checked	Designation	Signature



TELANGANA FIBER GRID

TELANGANA FIBER GRID

ITE & C GOVERNMENT OF TELANGANA

7th Floor, Splendid Towers, S.P. Road

Opp: Begumpet Police Station,



Begumpet, Hyderabad-500016.

AS - BUILT DRAWINGS (ABD)

MOMINPET

(MOMINPET MANDAL-VIKARABAD DIST.)

SINGLELINE CHAIN DIAGRAM FOR MOMINPET OHSR1 (MOMINPET)

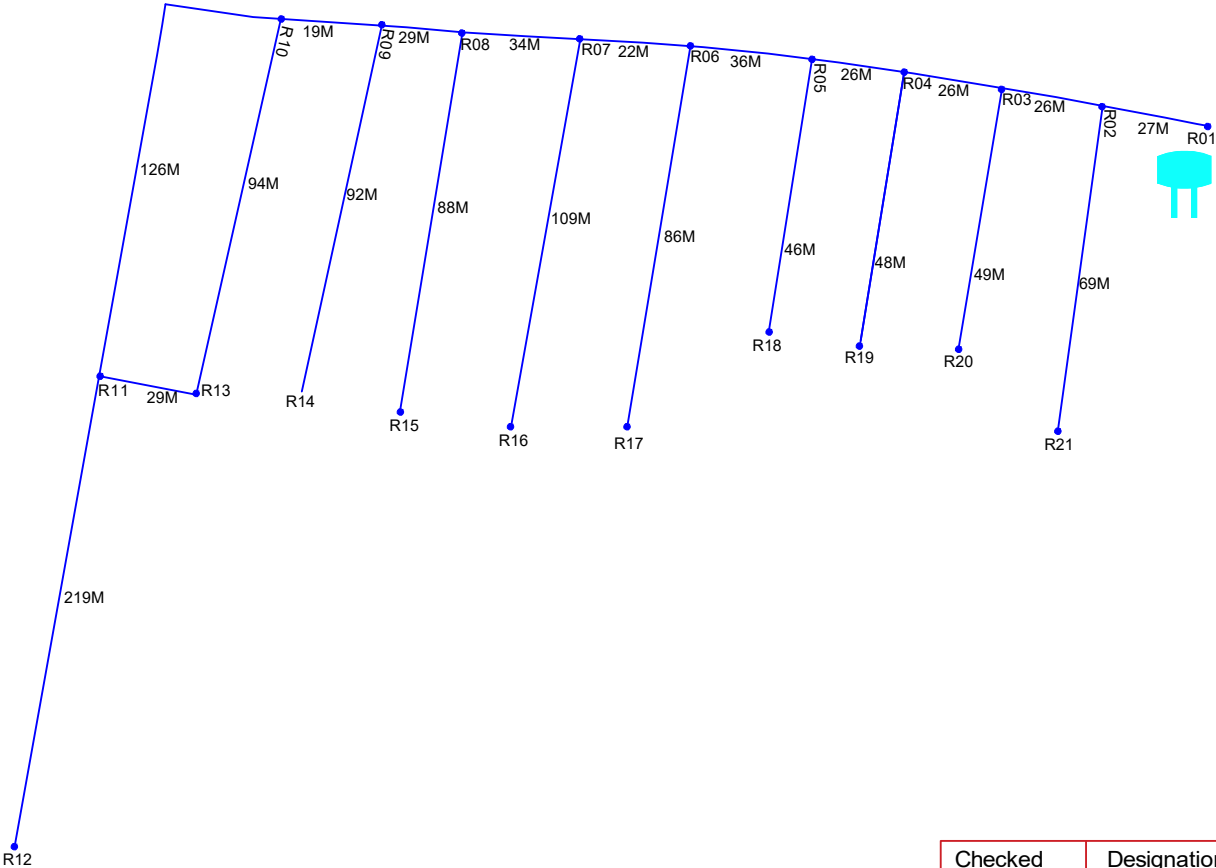
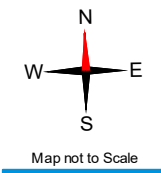


	DUCT PIPE
	ROAD
	OHSR
	G.P OFFICE
	TEMPLE
	HOSPITAL
	SCHOOL
	DUCT GAP

Sheet No. 01
Route Distance : 14577 M

Checked	Designation	Signature

DUCTLAYING ROUTE DIAGRAM FOR MOMINPET OHSR1 (MOMINPET)

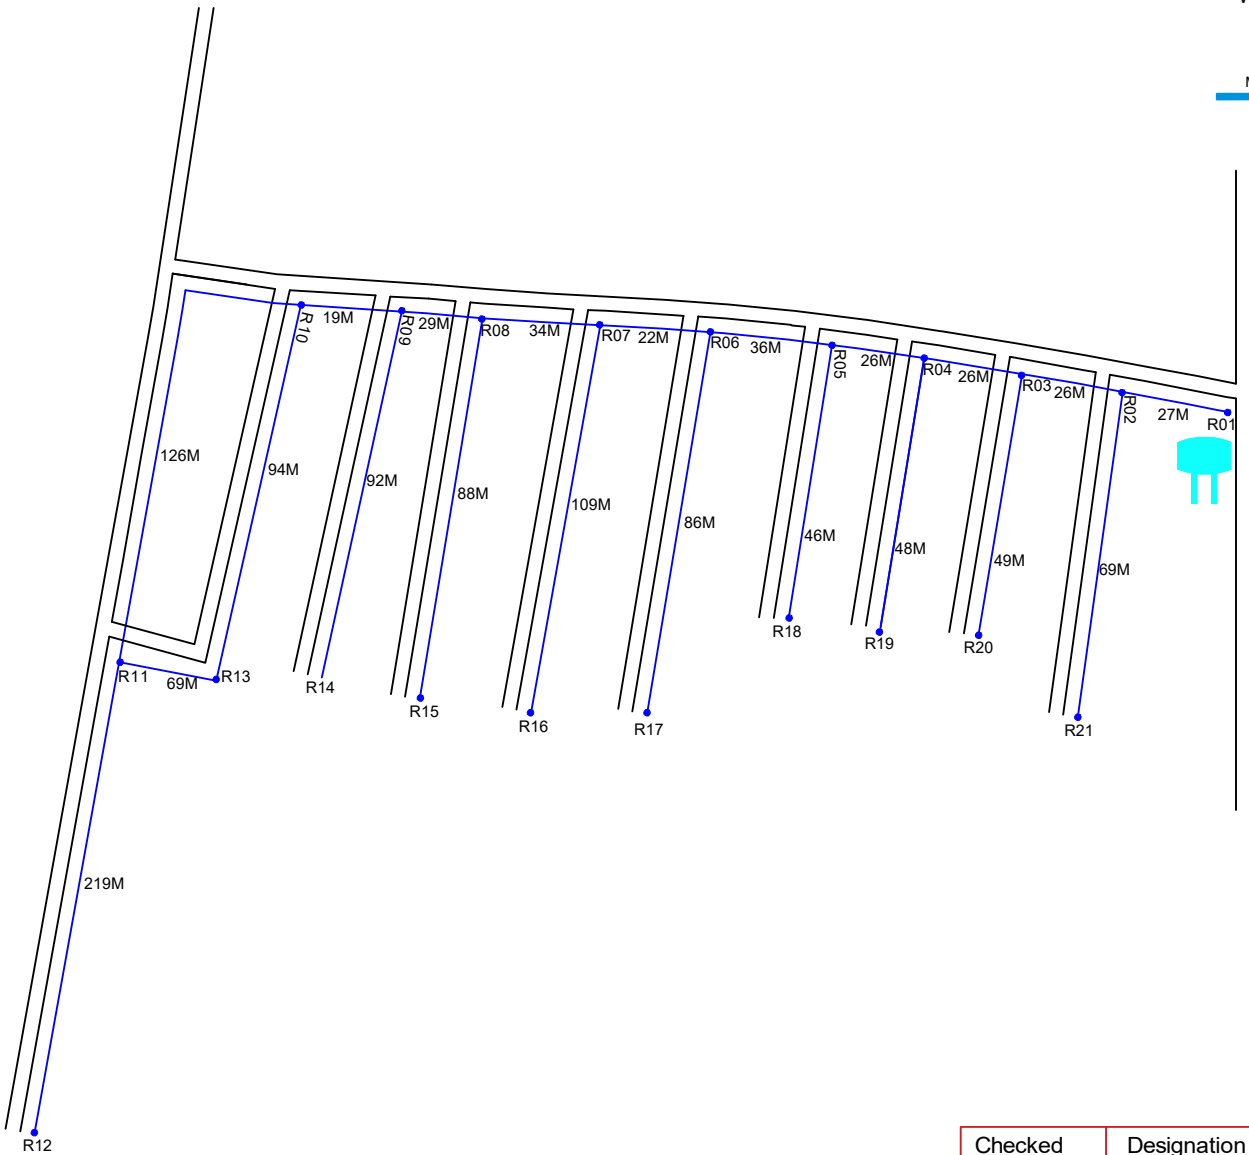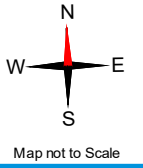


	DUCT PIPE
	ROAD
	OHSR
	G.P. OFFICE
	TEMPLE
	HOSPITAL
	SCHOOL
	DUCT GAP

Sheet No. 01
Route Distance : 14577 M


Checked	Designation	Signature

ROAD OFFSET DETAILING FOR MOMINPET OHSR1 (MOMINPET)


Arb : R01-R02

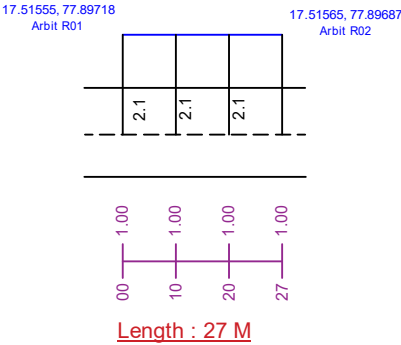


Arb : R02-R03

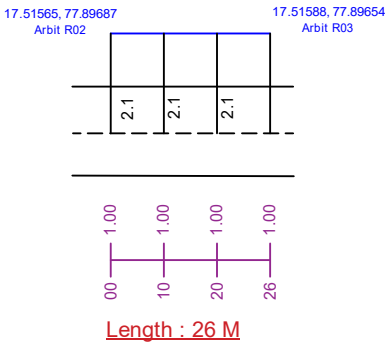


Arb : R03-R04

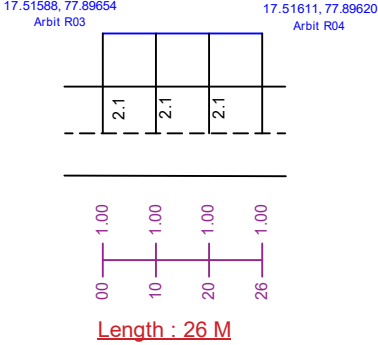


Arb : R04-R05

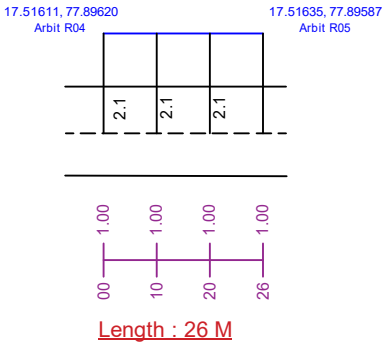


Arb : R05-R06

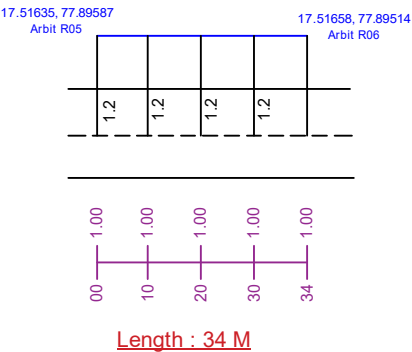


Arb : R06-R07

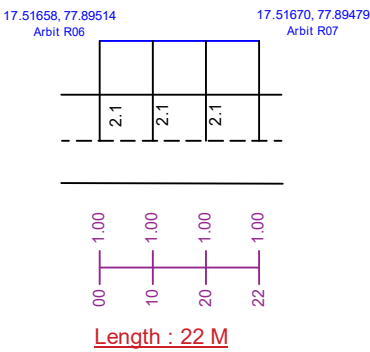

Arb : R07-R08

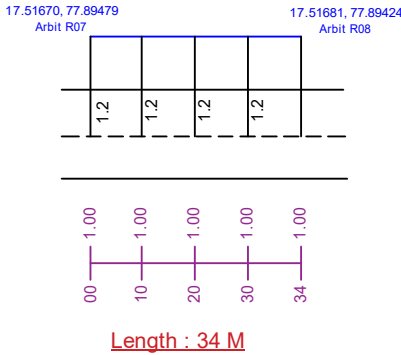


Arb : R08-R09

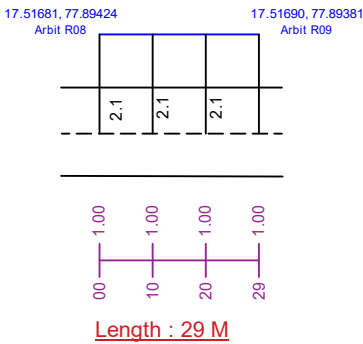

Checked	Designation	Signature


ROAD OFFSET DETAILING FOR MOMINPET OHSR1 (MOMINPET)

Arb : R09-R10

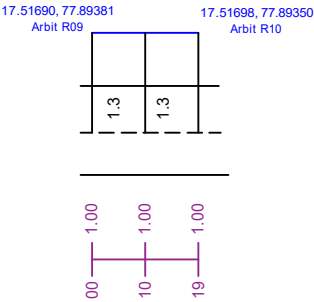


Length : 19 M

Arb : R10-R11

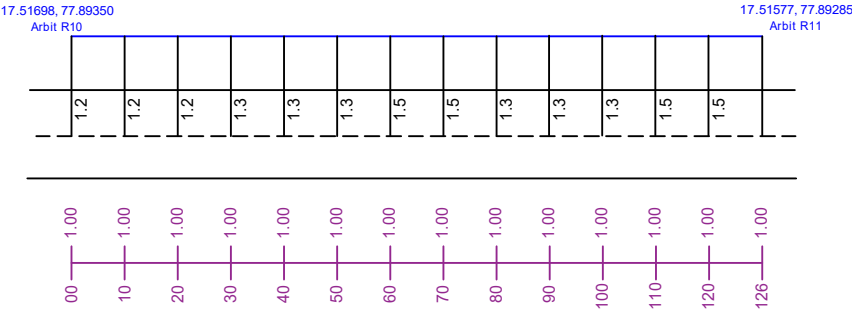


Length : 126 M

Arb : R11-R12

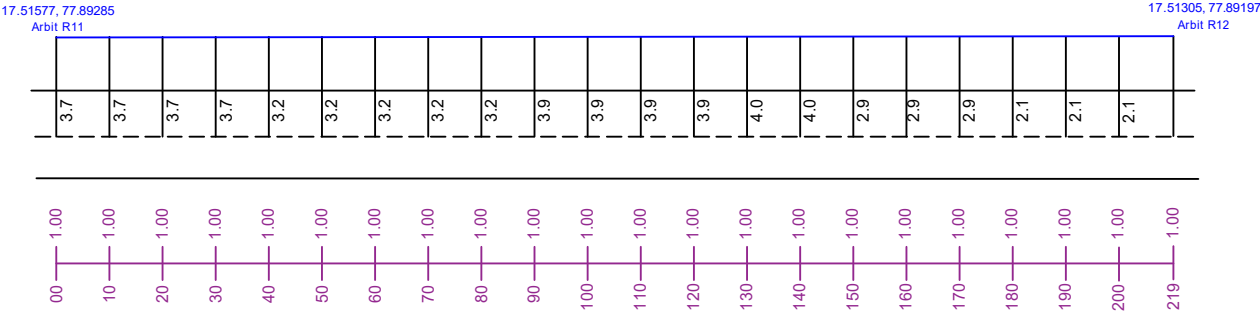

Length : 219 M

Arb : R11-R13




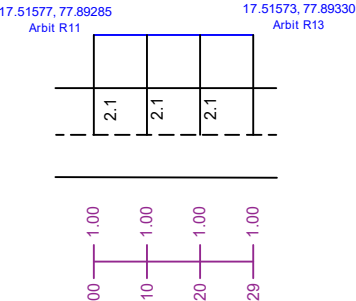


Length : 29 M

Sheet No. 02
Route Distance : 14577 M

Checked	Designation	Signature


ROAD OFFSET DETAILING FOR MOMINPET OHSR1 (MOMINPET)

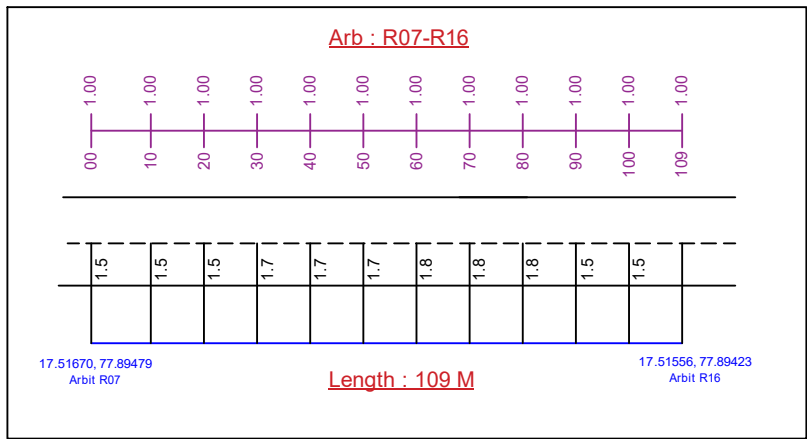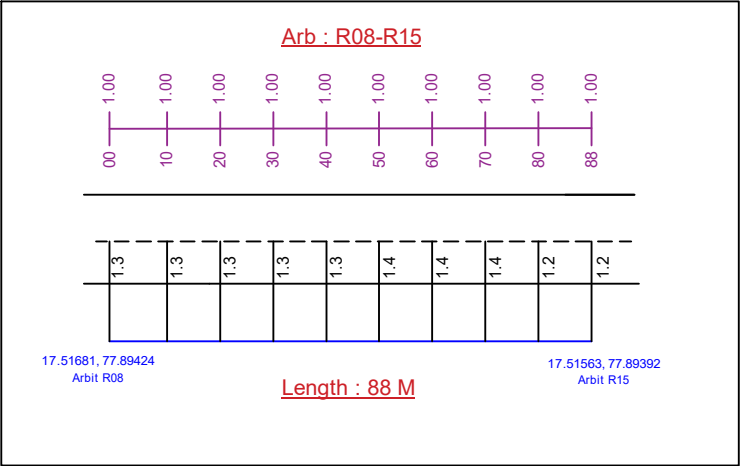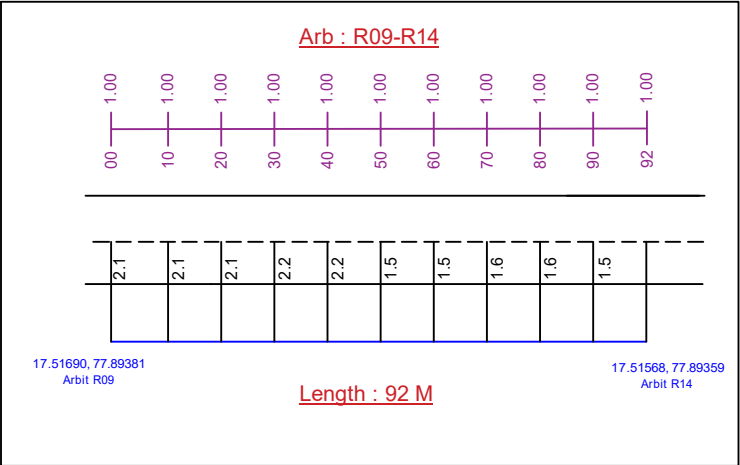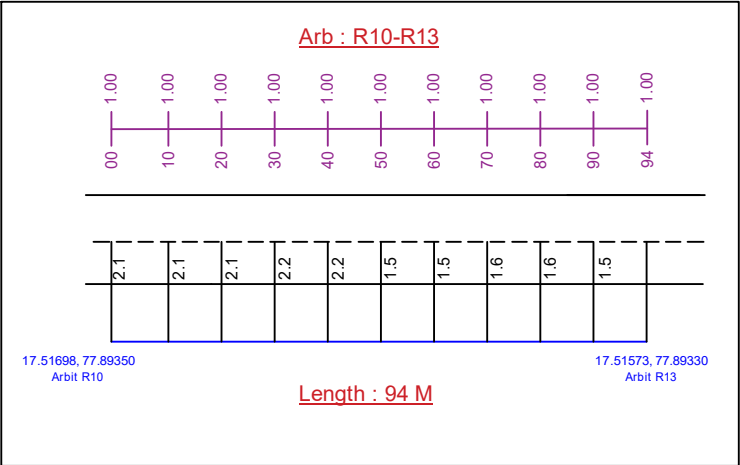

Checked	Designation	Signature


ROAD OFFSET DETAILING FOR MOMINPET OHSR1 (MOMINPET)

Arb : R06-R17

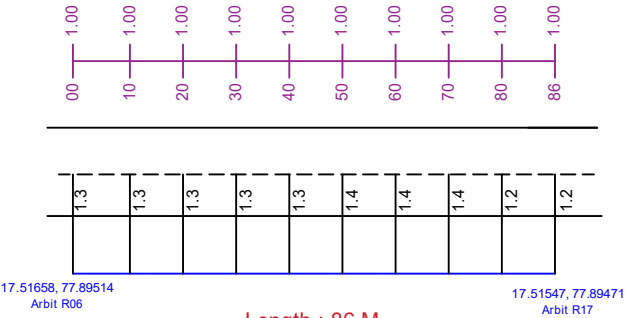


Length : 86 M

Arb : R05-R18

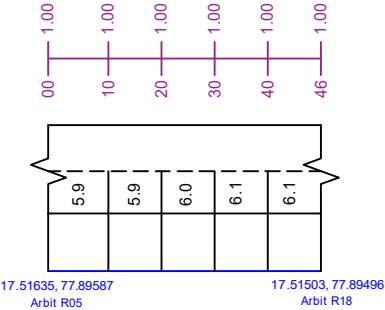


Length : 46 M

Arb : R04-R19

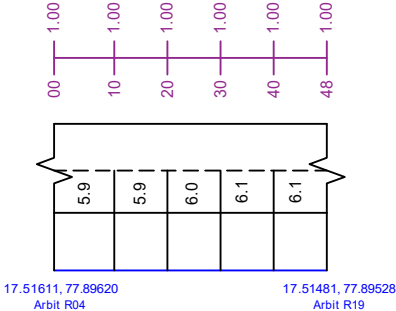


Length : 48 M

Arb : R03-R20

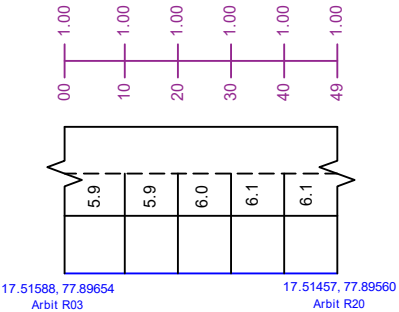

Length : 49 M


Arb : R02-R21

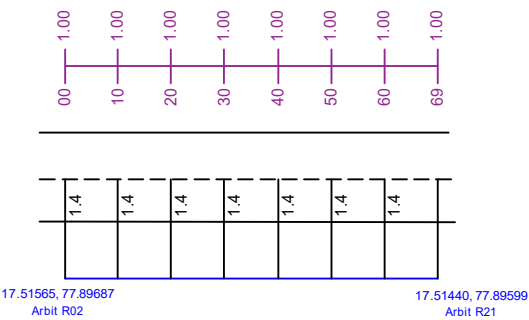

Length : 69 M

Checked	Designation	Signature

SINGLELINE CHAIN DIAGRAM FOR MOMINPET OHSR2 (MOMINPET)

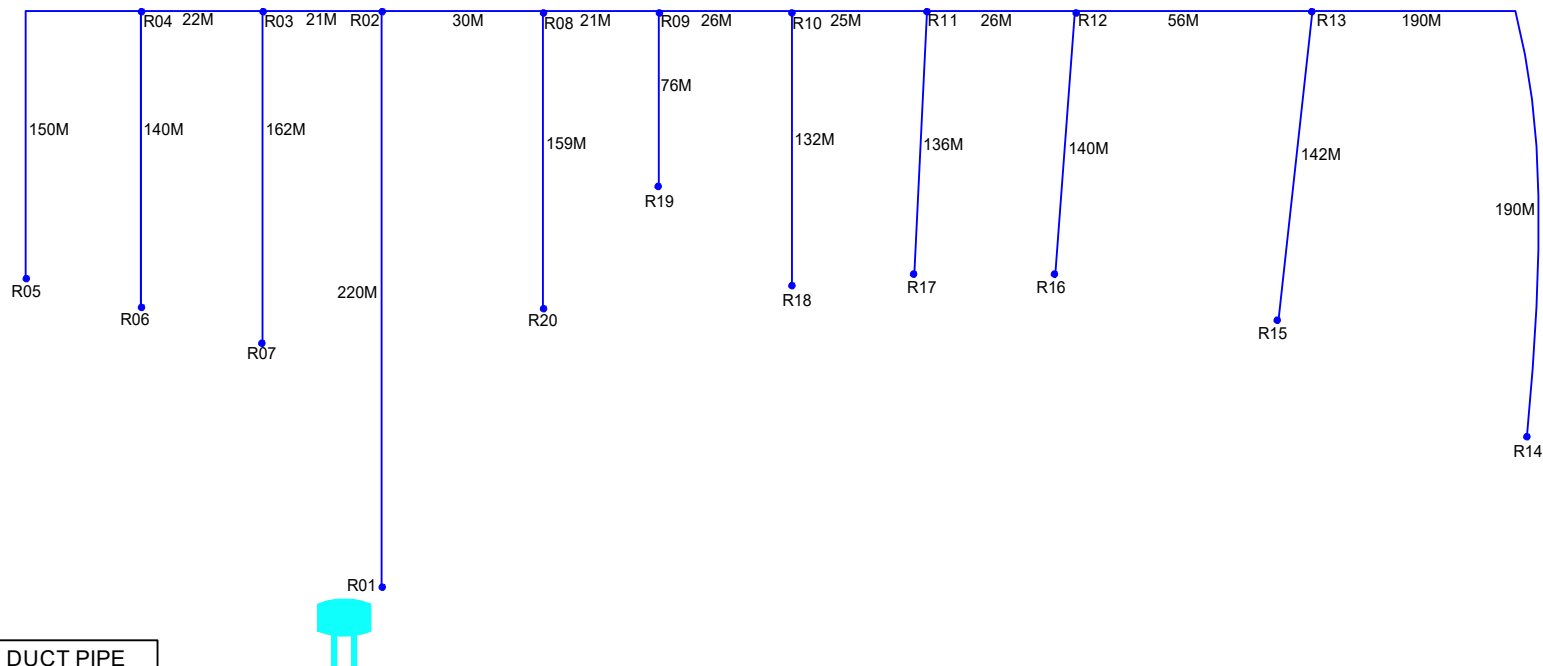

	DUCT PIPE
	ROAD
	OHSR
	G.P OFFICE
	TEMPLE
	HOSPITAL
	SCHOOL
	DUCT GAP


Sheet No. 01
Route Distance : 14577 M

Checked	Designation	Signature

DUCTLAYING ROUTE DIAGRAM FOR MOMINPET OHSR2 (MOMINPET)



Map not to Scale

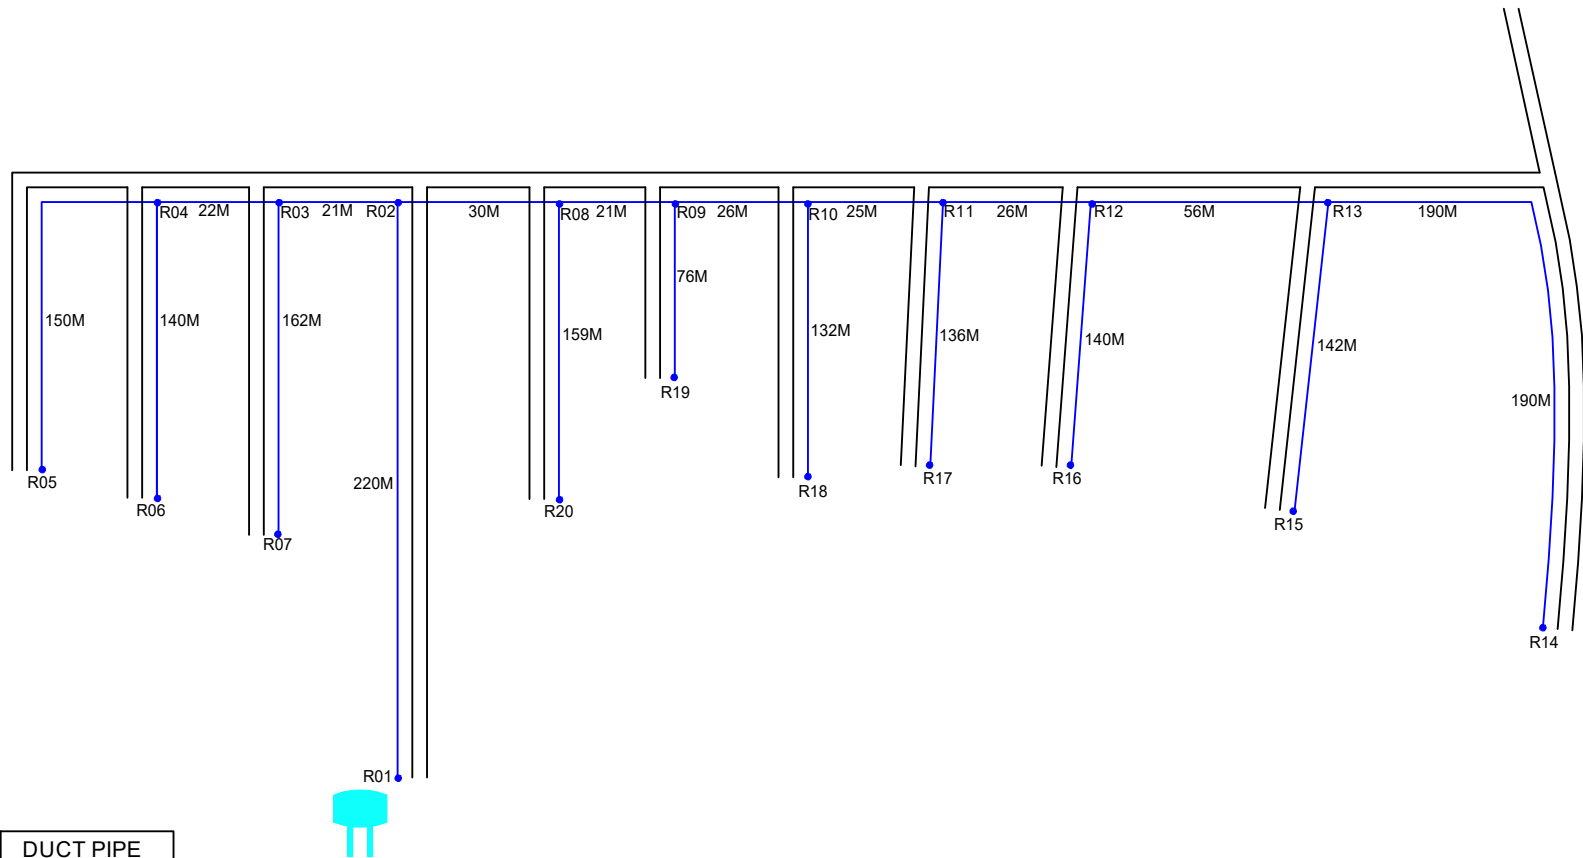


	DUCT PIPE
	ROAD
	OHSR
	G.P OFFICE
	TEMPLE
	HOSPITAL
	SCHOOL
	DUCT GAP

Sheet No. 01
Route Distance : 14577 M


Checked	Designation	Signature

ROAD OFFSET DETAILING FOR MOMINPET OHSR2 (MOMINPET)


Arb : R01-R02

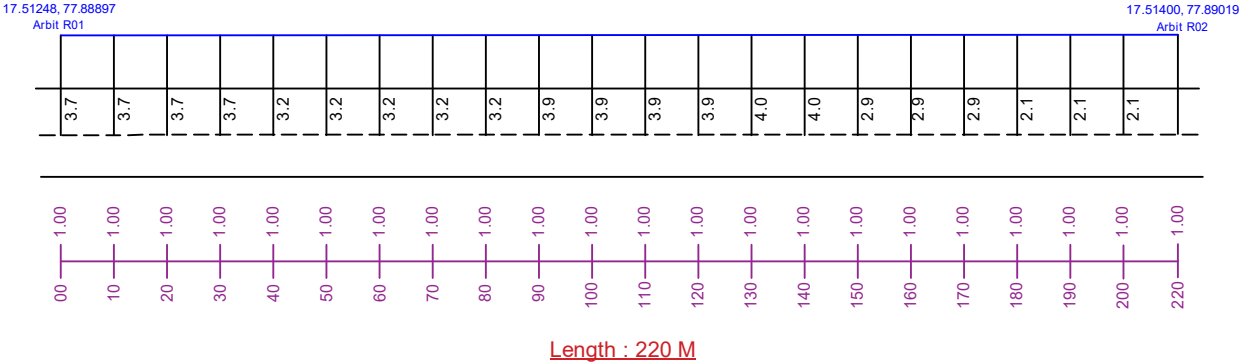


Arb : R02-R03

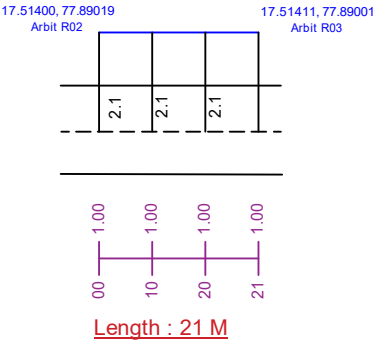

Arb : R03-R04




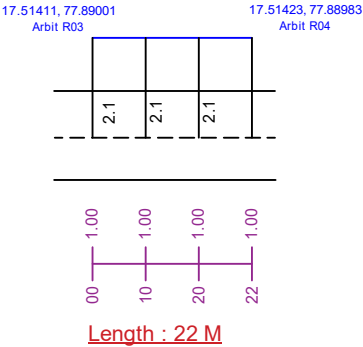


Arb : R04-R05

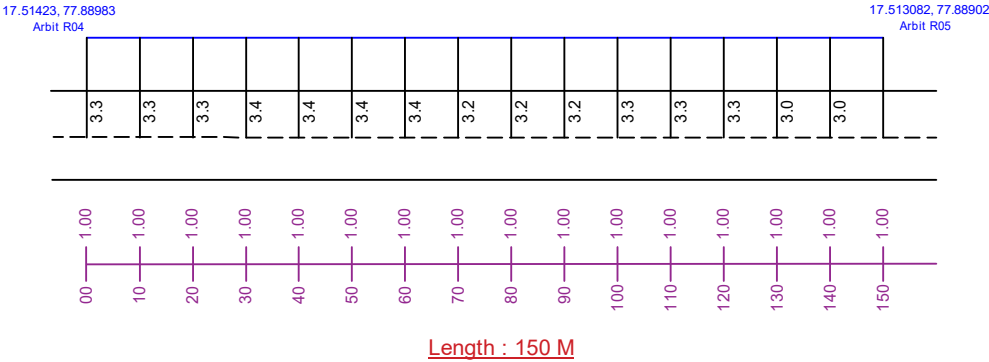

Checked	Designation	Signature


ROAD OFFSET DETAILING FOR MOMINPET OHSR2 (MOMINPET)

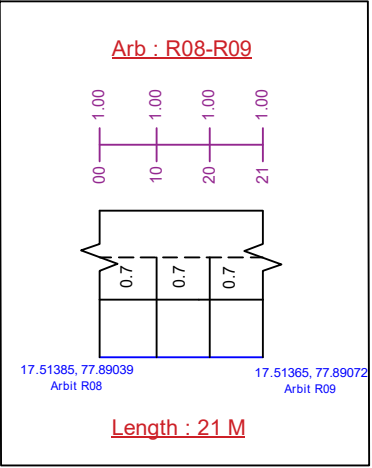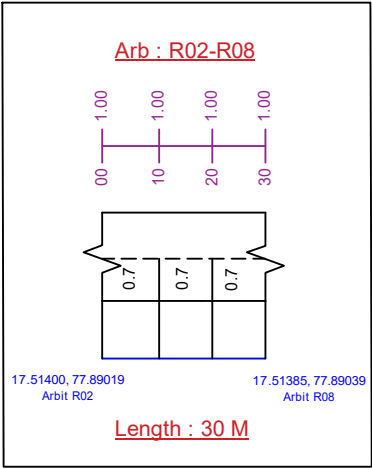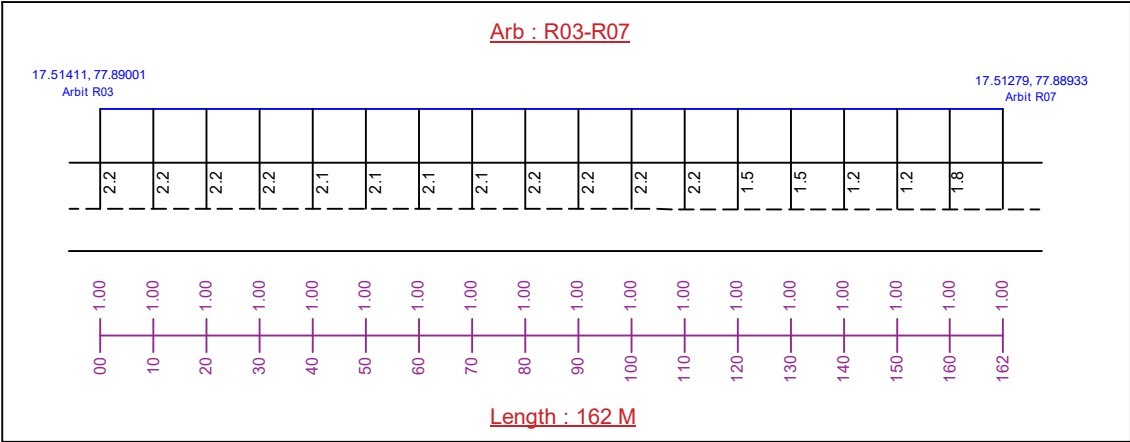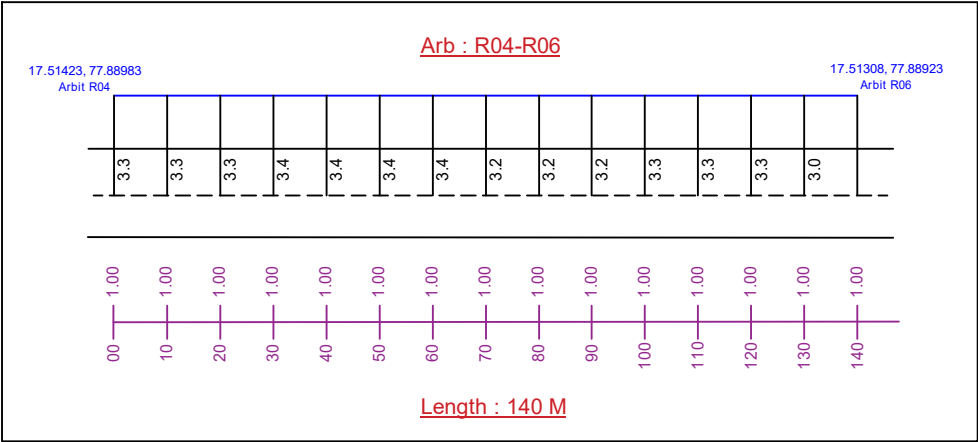

Checked	Designation	Signature


ROAD OFFSET DETAILING FOR MOMINPET OHSR2 (MOMINPET)

Arb : R09-R10

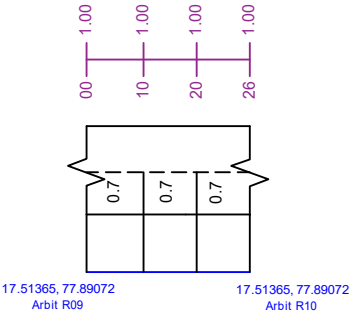


Length : 26 M

Arb : R10-R11

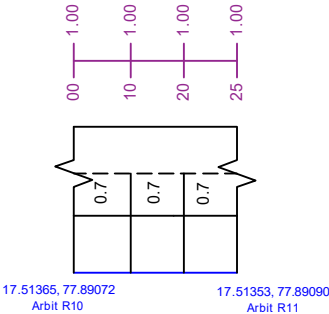


Length : 25 M

Arb : R11-R12

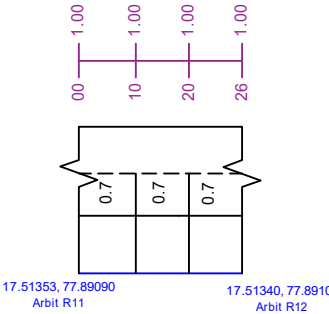


Length : 26 M

Arb : R12-R13

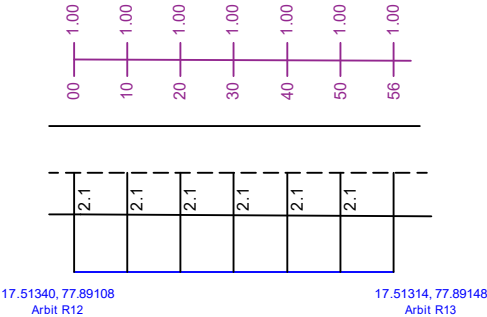

Length : 56 M

Arb : R13-R14

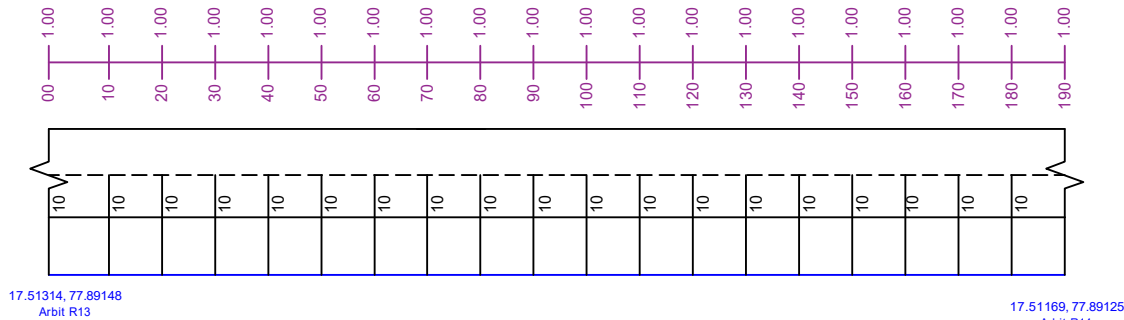


Length : 190 M

Checked	Designation	Signature

ROAD OFFSET DETAILING FOR MOMINPET OHSR2 (MOMINPET)

Arb : R13-R15

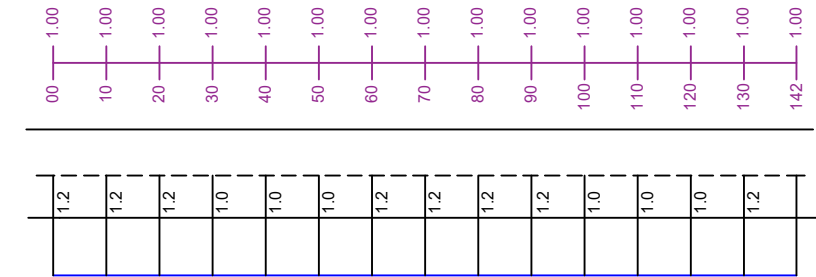


17.51314, 77.89148
Arbit R13

17.51211, 77.89071
Arbit R15

Length : 142 M

Arb : R12-R16

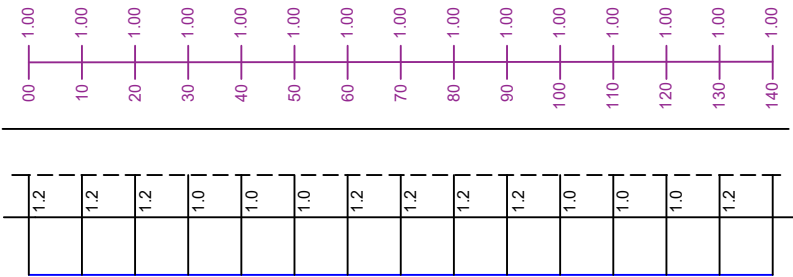


17.51340, 77.89108
Arbit R12

17.51241, 77.89035
Arbit R16

Length : 140 M

Arb : R11-R17

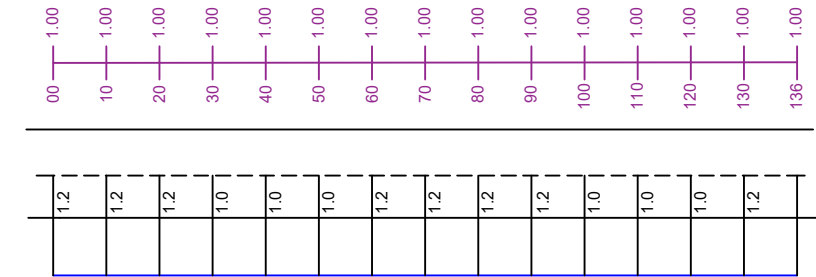


17.51353, 77.89090
Arbit R11

17.51253, 77.89025
Arbit R17

Length : 136 M

Arb : R10-R18

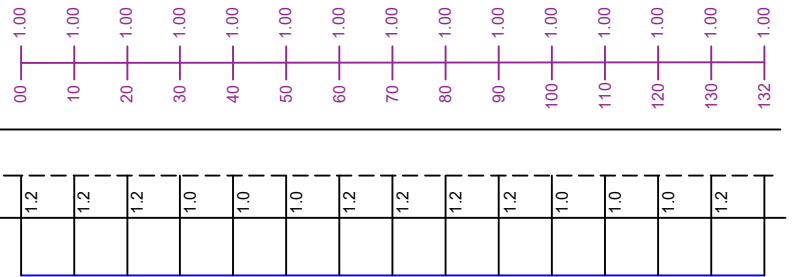

17.51365, 77.89072
Arbit R10

17.51266, 77.89009
Arbit R18


Length : 132 M

Checked	Designation	Signature

Sheet No. 04
Route Distance : 14577 M

ROAD OFFSET DETAILING FOR MOMINPET OHSR2 (MOMINPET)

Arb : R09-R19

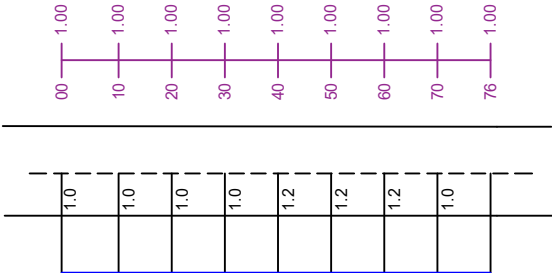


17.51365, 77.89072
Arbit R09

17.51317, 77.89021
Arbit R19

Length : 76 M

Arb : R08-R20

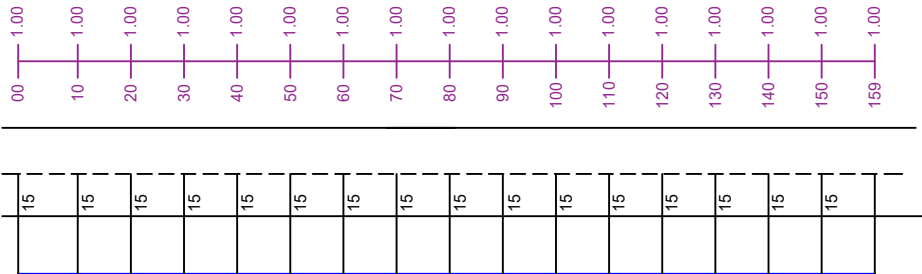


17.51385, 77.89039
Arbit R08

17.51264, 77.88981
Arbit R20


Length : 156 M

Checked	Designation	Signature

SINGLELINE CHAIN DIAGRAM FOR MOMINPET OHSR3 (MOMINPET)

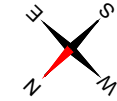

Map not to Scale


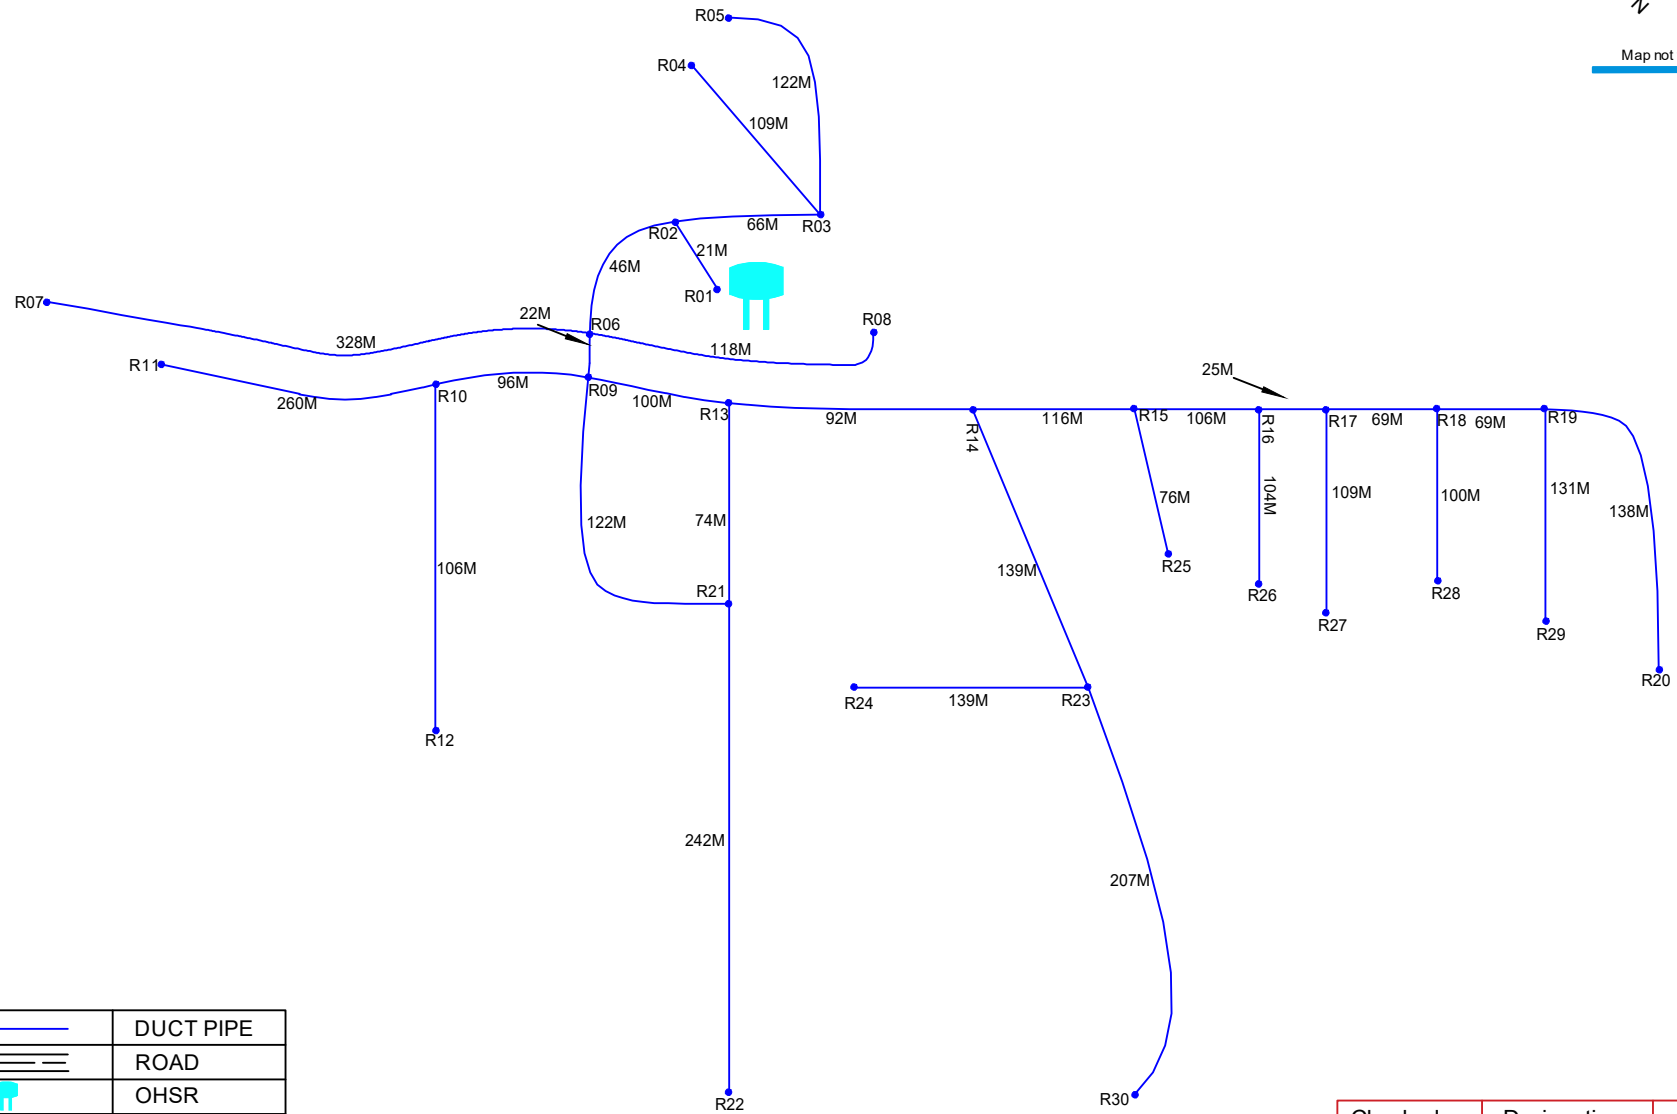


	DUCT PIPE
	ROAD
	OHSR
	G.P OFFICE
	TEMPLE
	HOSPITAL
	SCHOOL
	DUCT GAP

Sheet No. 01
Route Distance : 14577 M

Checked	Designation	Signature

DUCTLAYING ROUTE DIAGRAM FOR MOMINPET OHSR3 (MOMINPET)

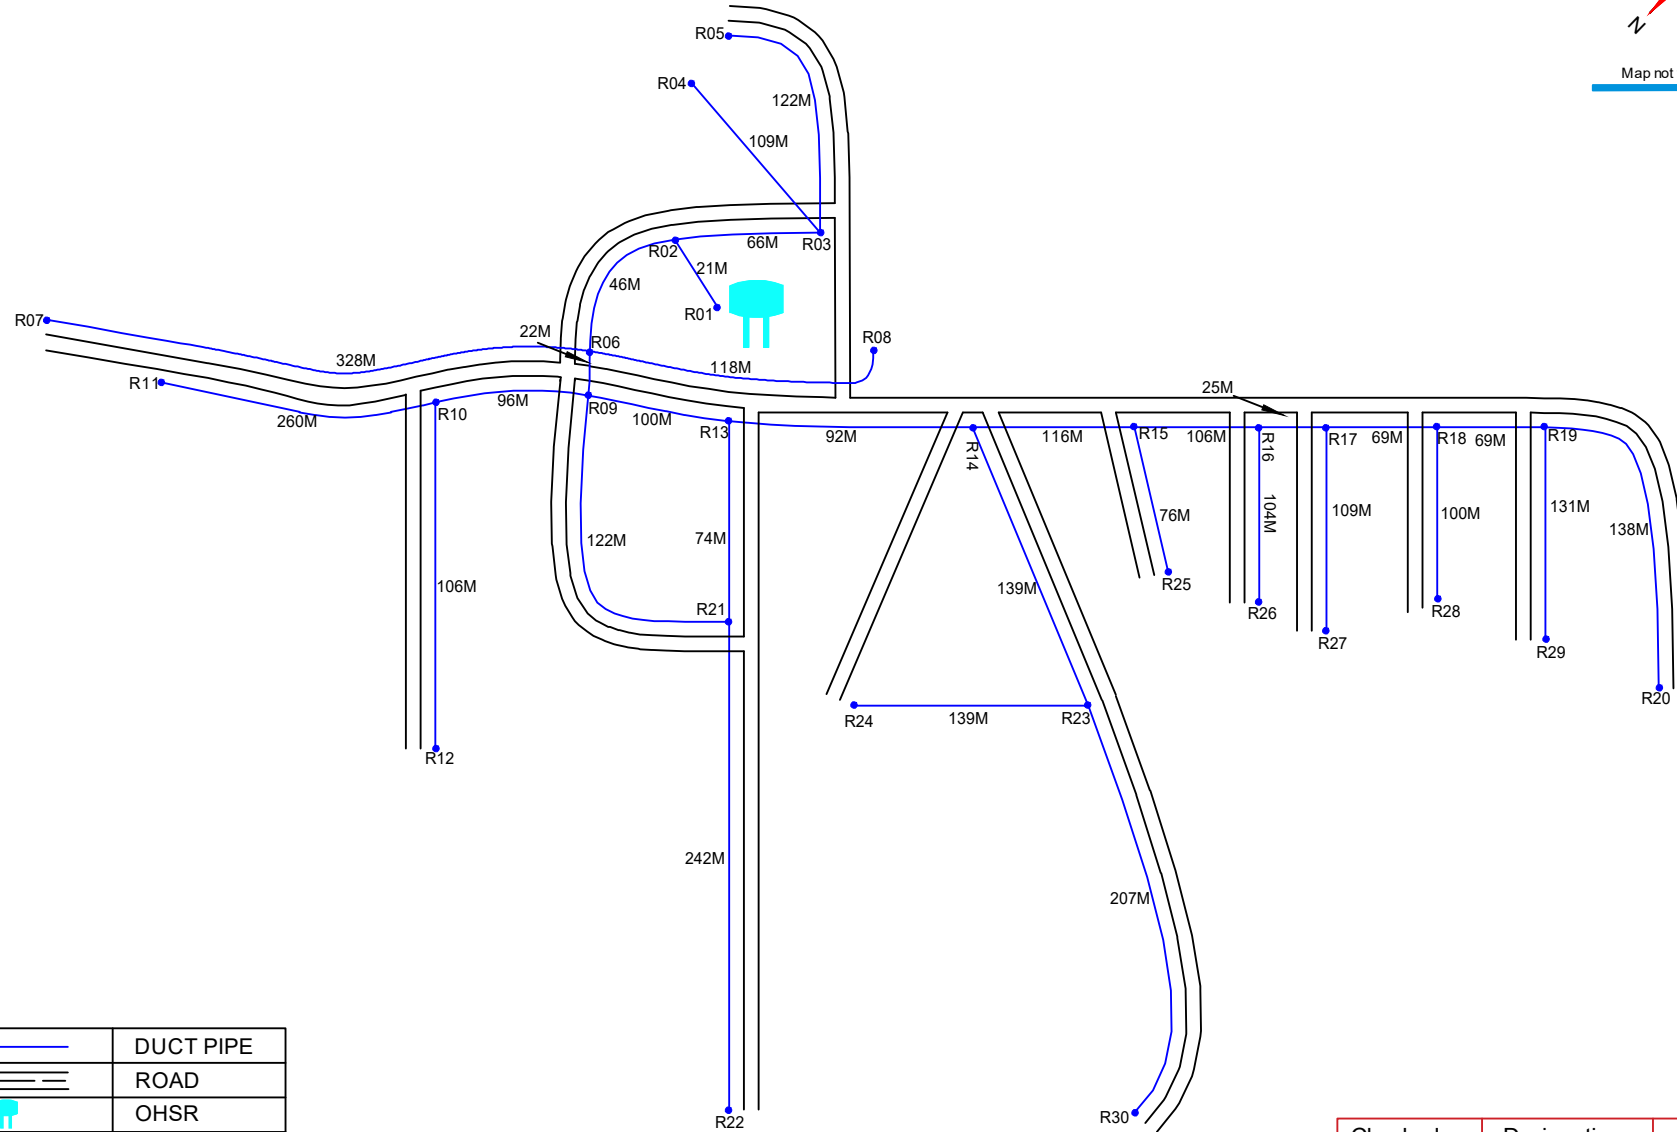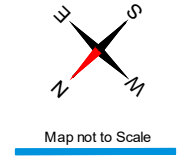


	DUCT PIPE
	ROAD
	OHSR
	G.P OFFICE
	TEMPLE
	HOSPITAL
	SCHOOL
	DUCT GAP

Sheet No. 01
Route Distance : 14577 M


Checked	Designation	Signature

ROAD OFFSET DETAILING FOR MOMINPET OHSR3 (MOMINPET)


Arb : R01-R02

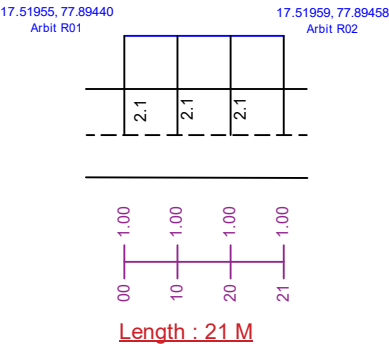


Arb : R02-R03

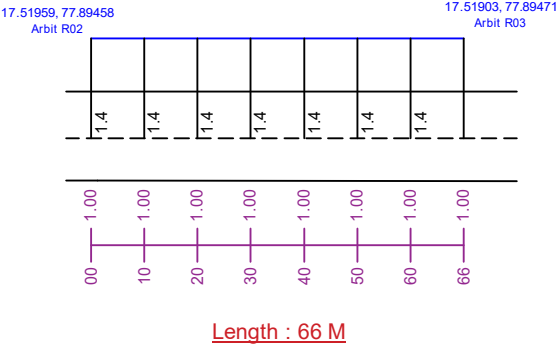


Arb : R03-R04

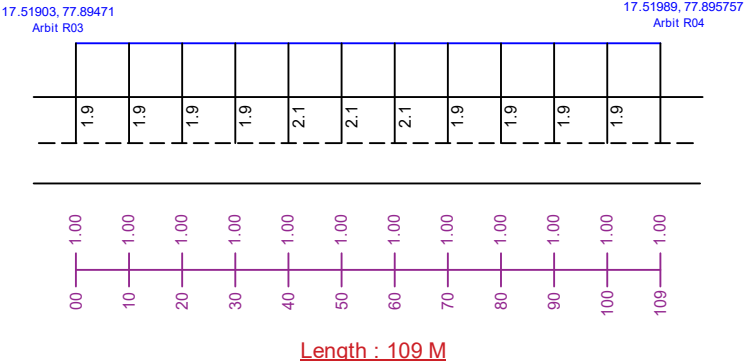

Arb : R03-R05

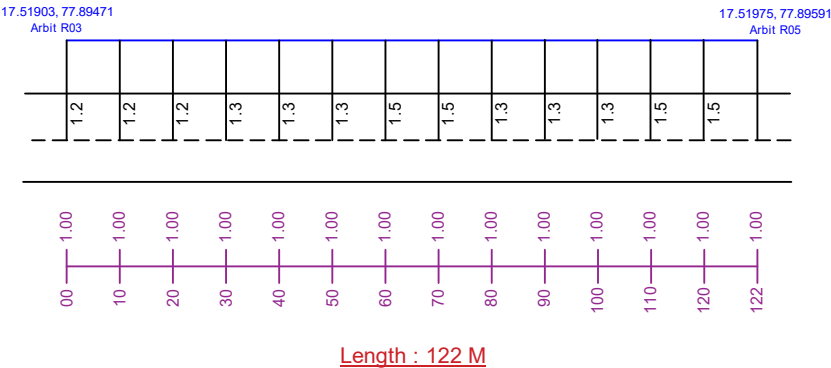


Arb : R02-R06

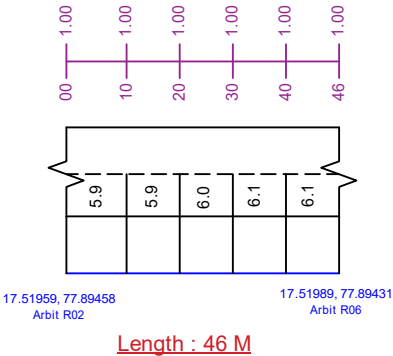

Checked	Designation	Signature


ROAD OFFSET DETAILING FOR MOMINPET OHSR3 (MOMINPET)

Arb : R06-R07

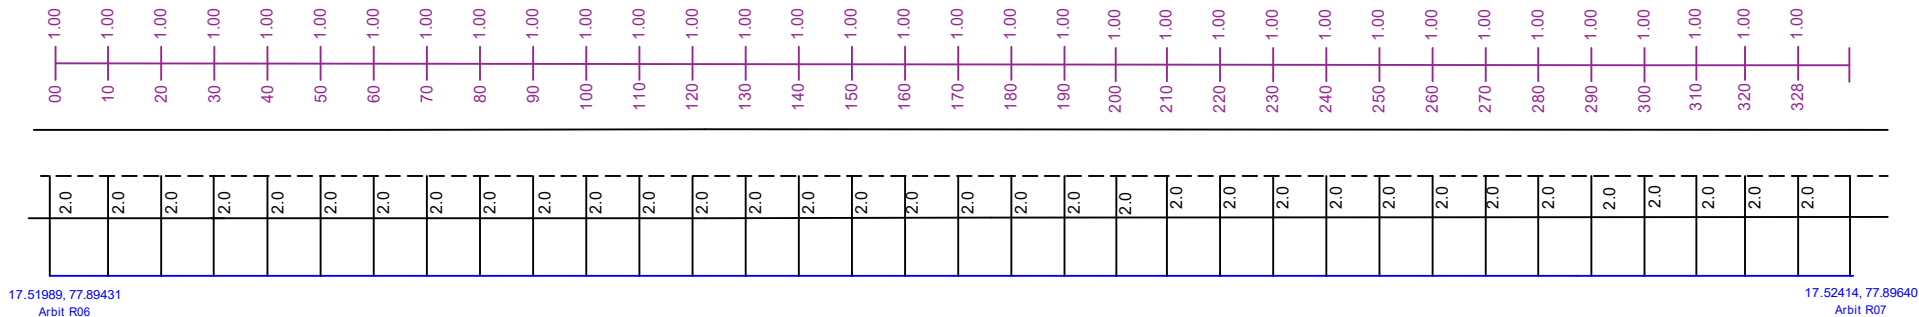


Length : 328 M

Arb : R06-R08

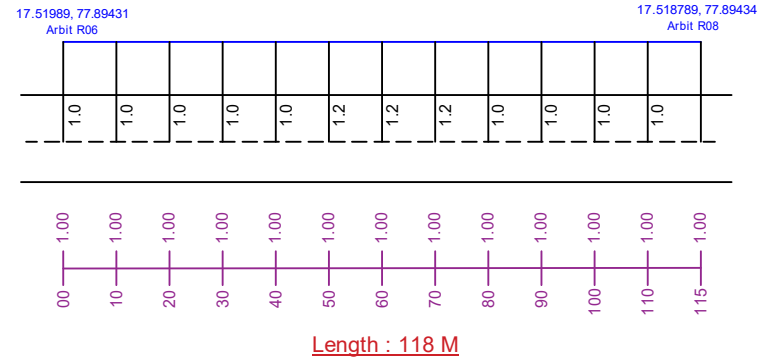

Length : 118 M

Arb : R06-R09



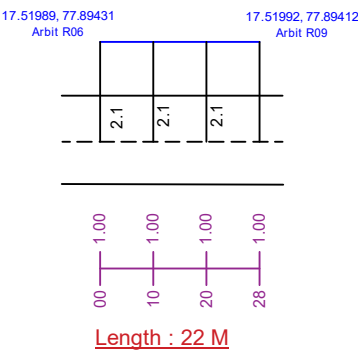


Length : 22 M

Sheet No. 02
Route Distance : 14577 M





Checked	Designation	Signature

ROAD OFFSET DETAILING FOR MOMINPET OHSR3 (MOMINPET)

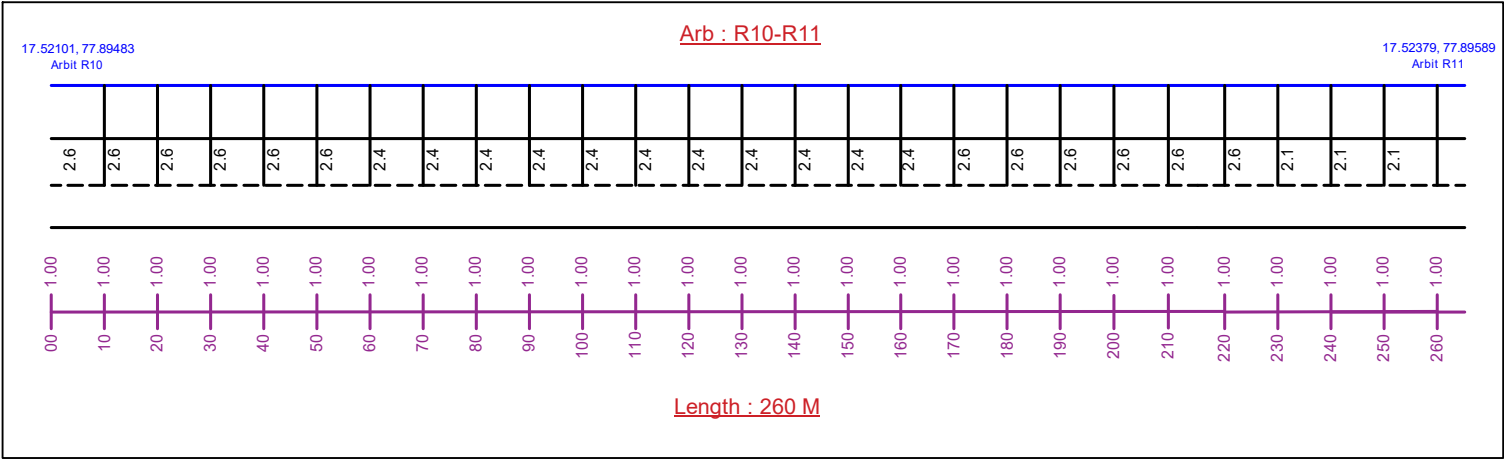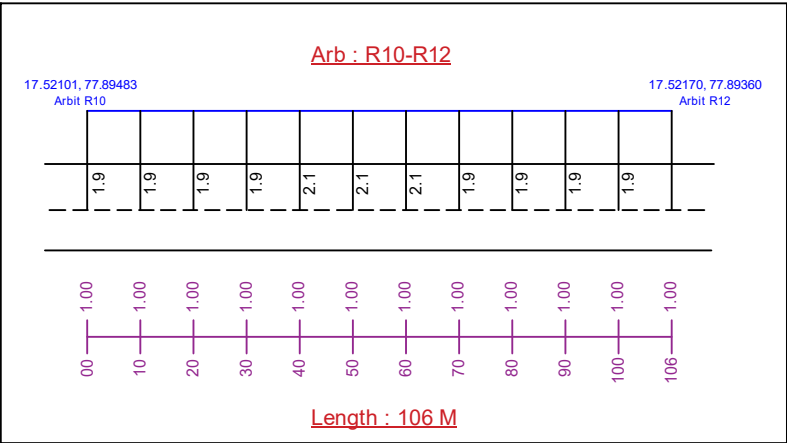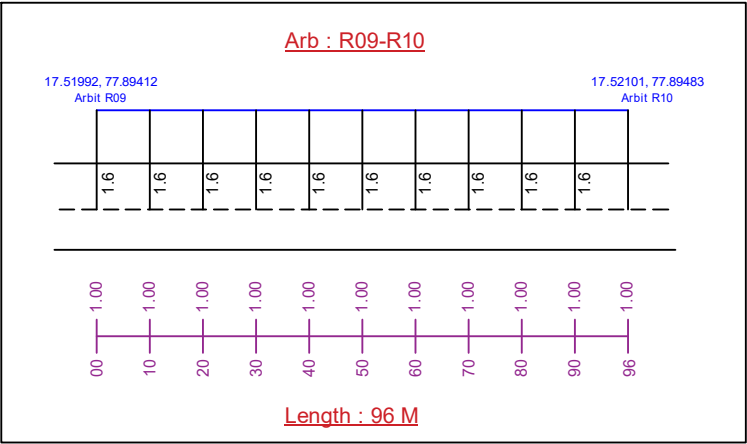

Checked	Designation	Signature


ROAD OFFSET DETAILING FOR MOMINPET OHSR3 (MOMINPET)

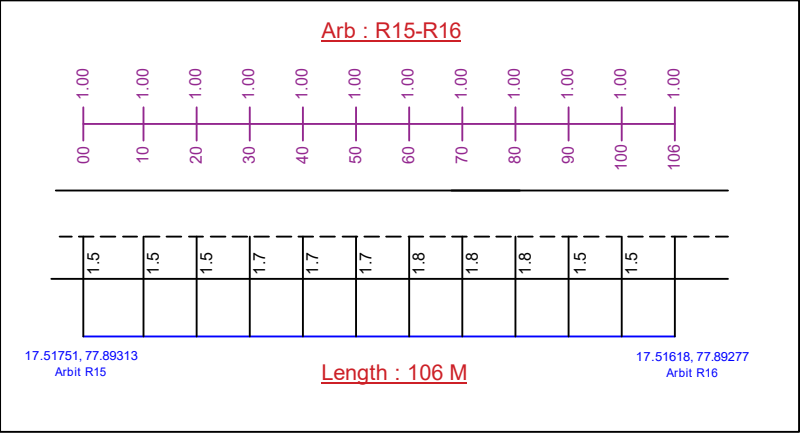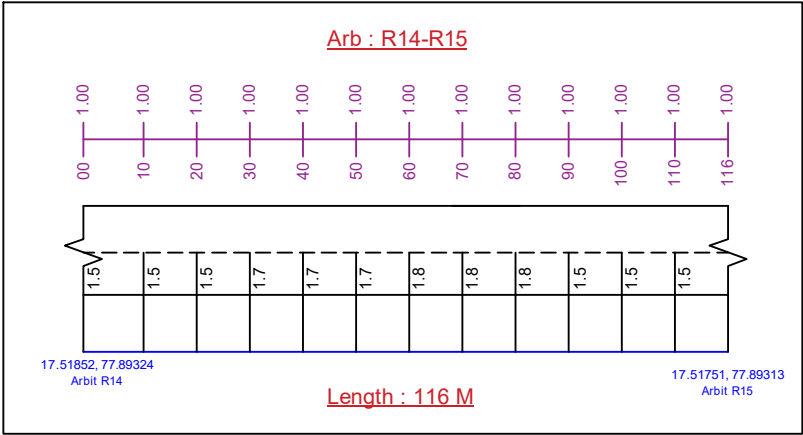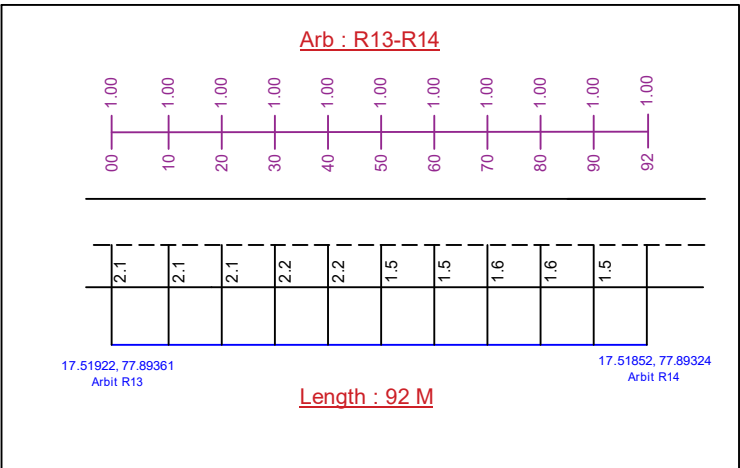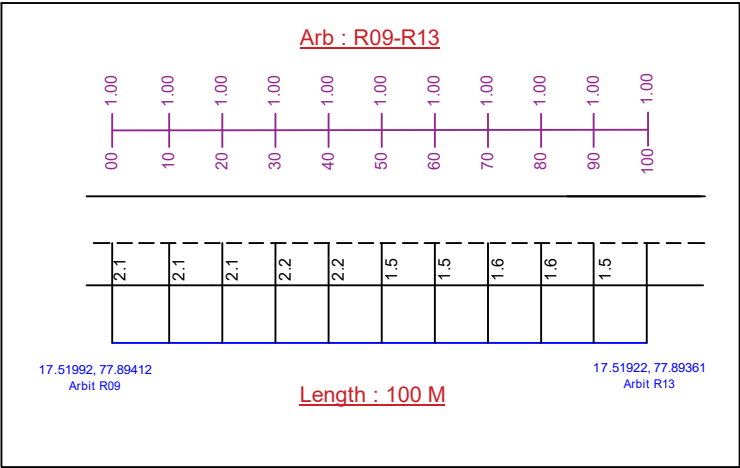

Checked	Designation	Signature


ROAD OFFSET DETAILING FOR MOMINPET OHSR3 (MOMINPET)

Arb : R16-R17

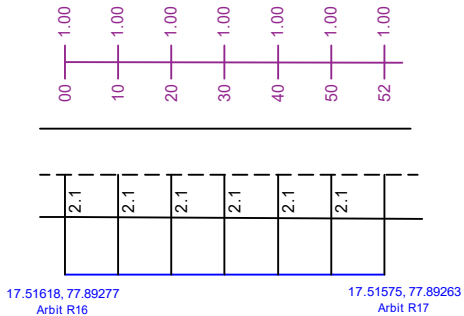


Length : 52 M

Arb : R17-R18

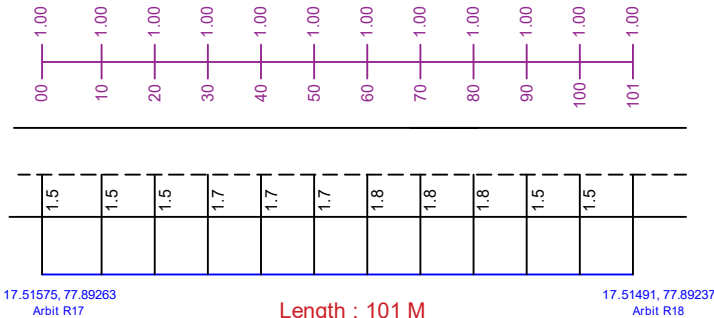


Length : 101 M

Arb : R18-R19

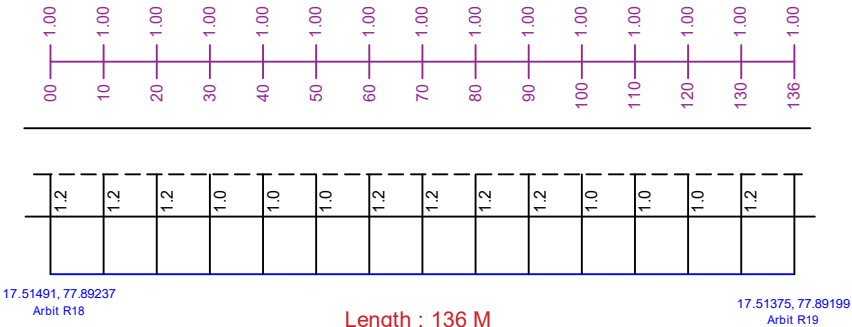

Length : 136 M

Arb : R19-R20

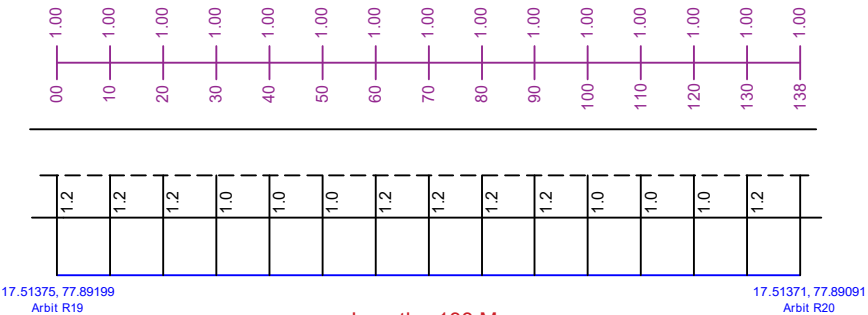


Length : 138 M

Checked	Designation	Signature


ROAD OFFSET DETAILING FOR MOMINPET OHSR3 (MOMINPET)

Arb : R13-R21

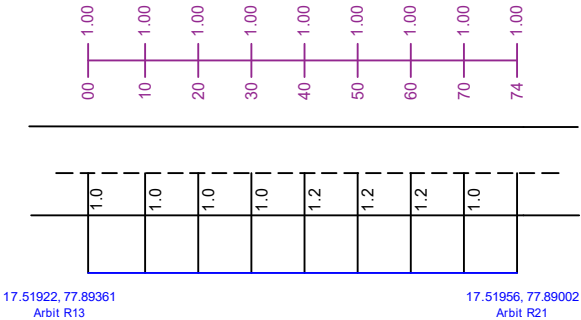


Length : 74 M

Arb : R21-R09

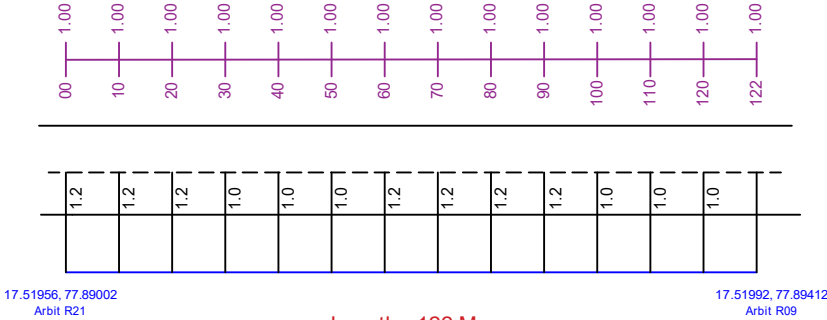

Length : 122 M

Arb : R21-R22

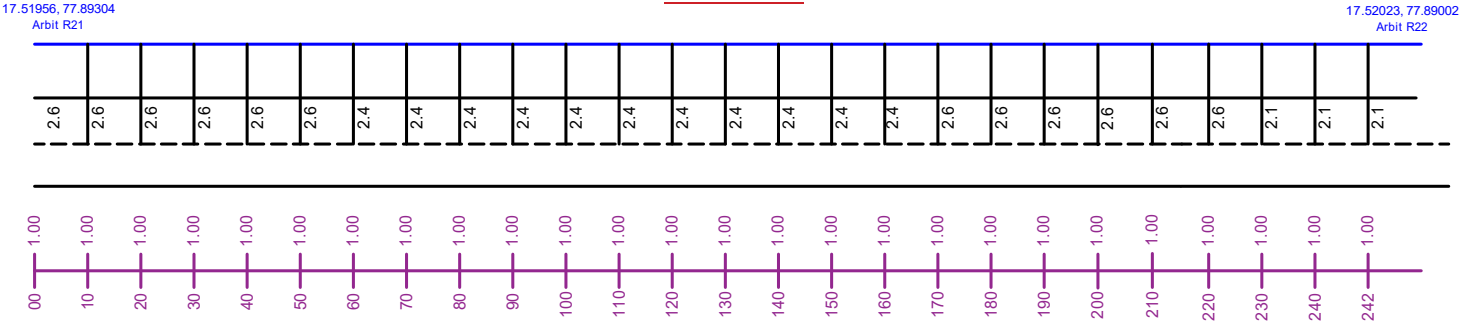


Length : 242 M

Checked	Designation	Signature


ROAD OFFSET DETAILING FOR MOMINPET OHSR3 (MOMINPET)

Arb : R14-R23

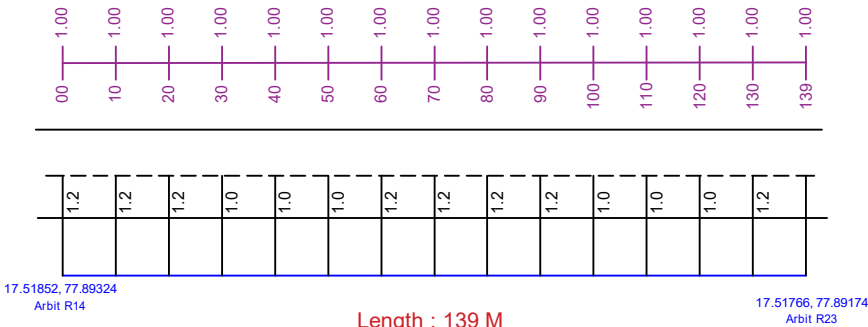


Length : 139 M

Arb : R23-R24

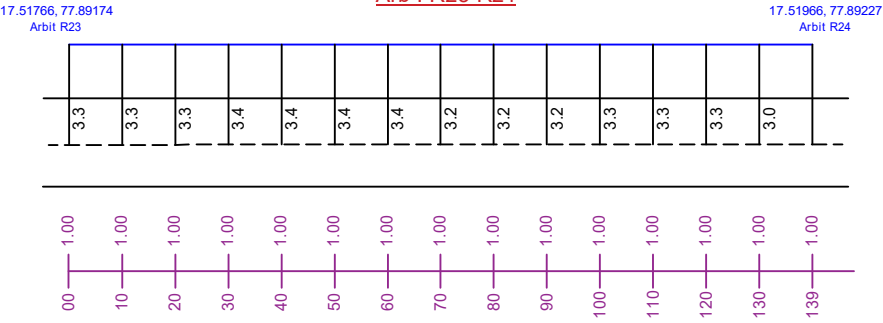


Length : 139 M

Arb : R15-R25

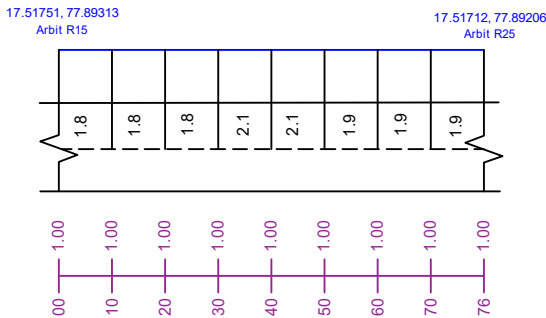

Length : 76 M




Arb : R16-R26

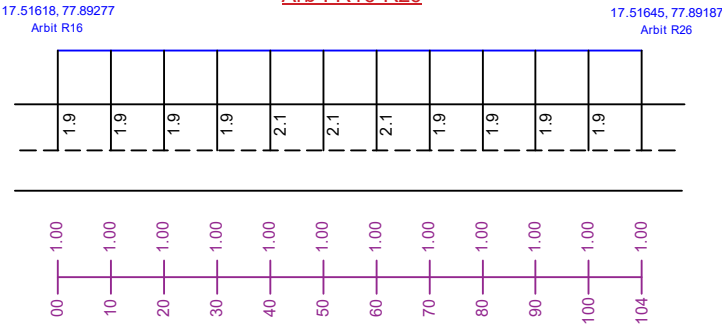

Length : 104 M


Checked	Designation	Signature

ROAD OFFSET DETAILING FOR MOMINPET OHSR3 (MOMINPET)

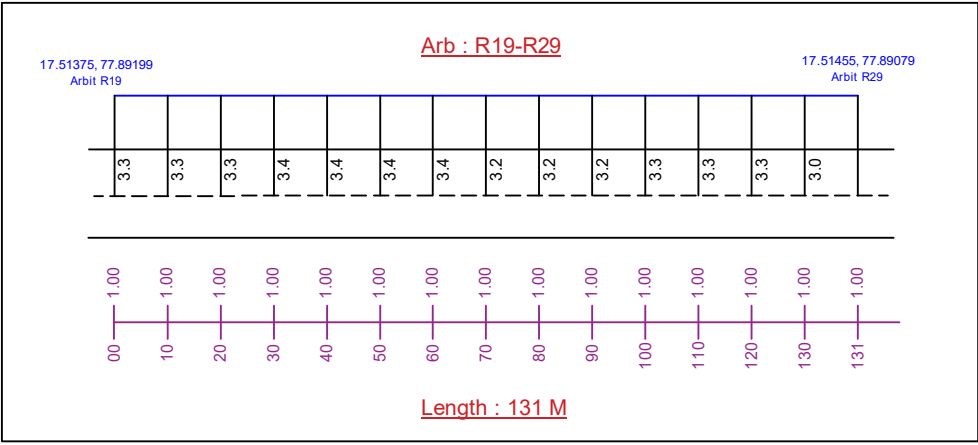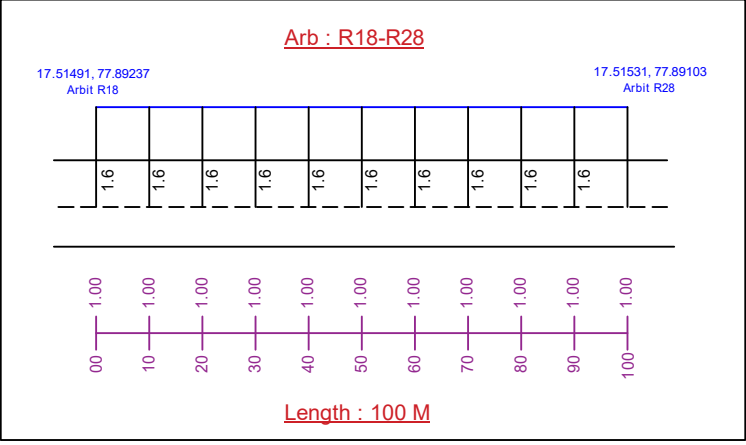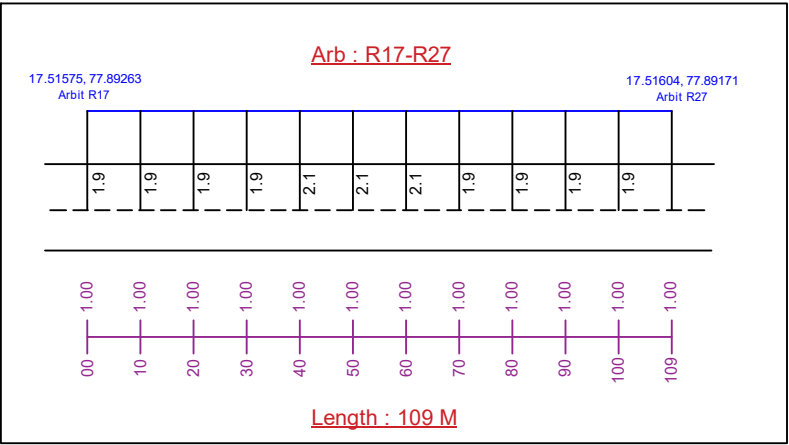

Checked	Designation	Signature


ROAD OFFSET DETAILING FOR MOMINPET OHSR3 (MOMINPET)

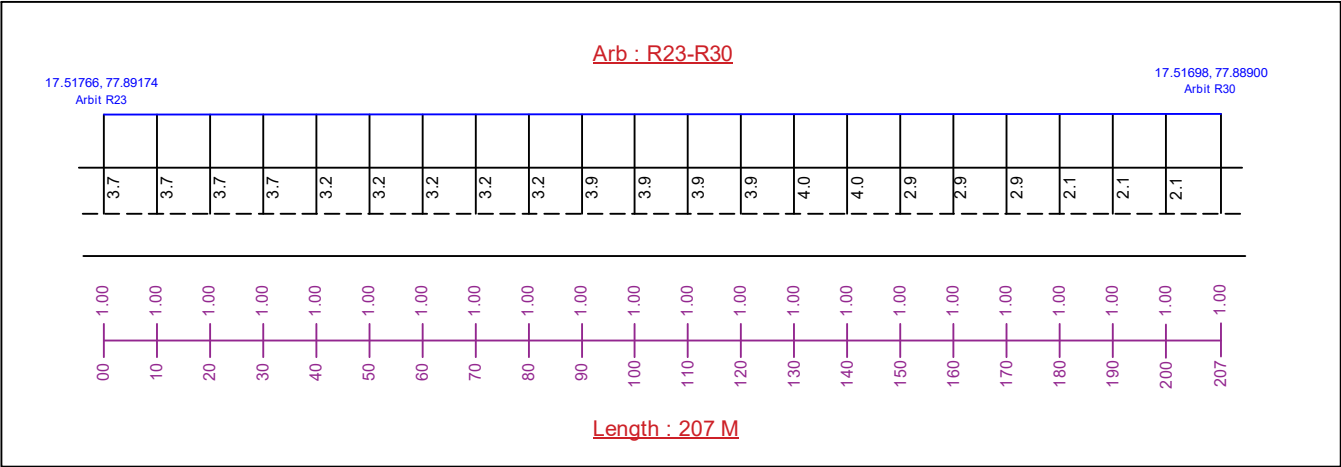

Sheet No. 09
Route Distance : 14577 M

Checked	Designation	Signature

SINGLELINE CHAIN DIAGRAM FOR MOMINPET OHSR4 (MOMINPET)


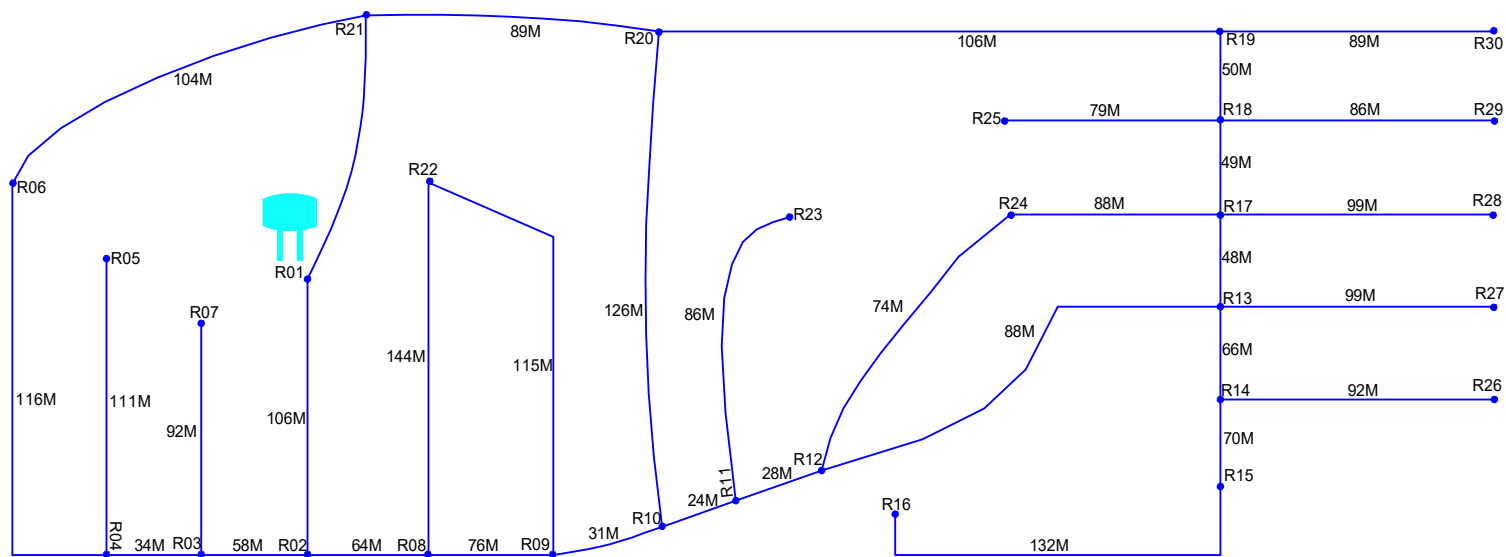



 





 
	DUCT PIPE
	ROAD
	OHSR
	G.P OFFICE
	TEMPLE
	HOSPITAL
	SCHOOL
	DUCT GAP

Sheet No. 01
Route Distance : 14577 M

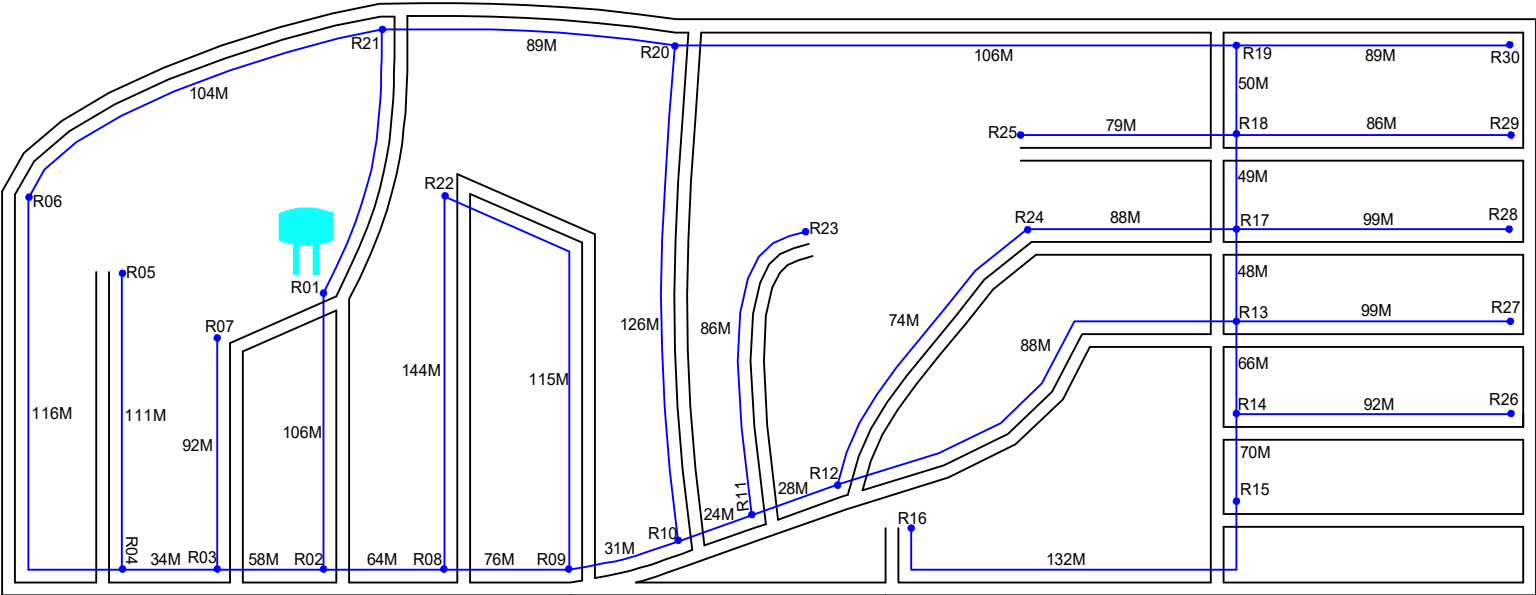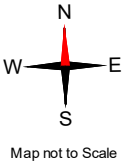Checked	Designation	Signature

DUCTLAYING ROUTE DIAGRAM FOR MOMINPET OHSR4 (MOMINPET)








	DUCT PIPE
	ROAD
	OHSR
	G.P OFFICE
	TEMPLE
	HOSPITAL
	SCHOOL
	DUCT GAP

Checked	Designation	Signature

Sheet No. 01
Route Distance : 14577 M






ROAD OFFSET DETAILING FOR MOMINPET OHSR4 (MOMINPET)

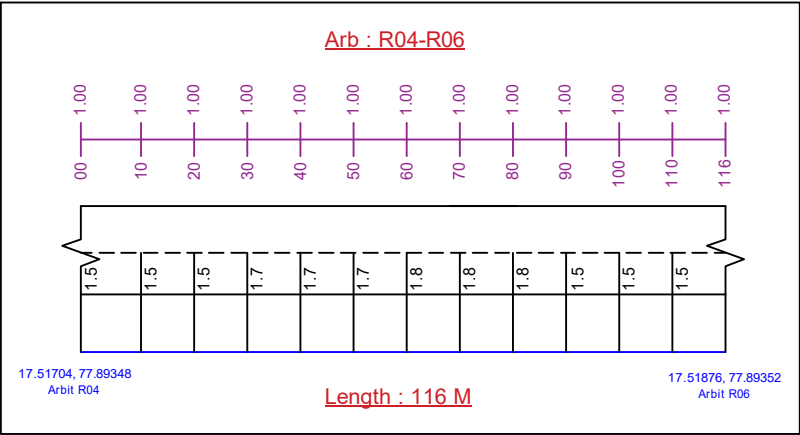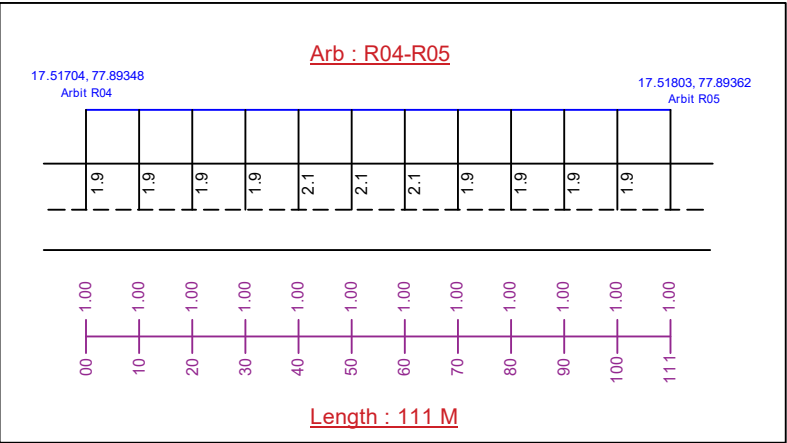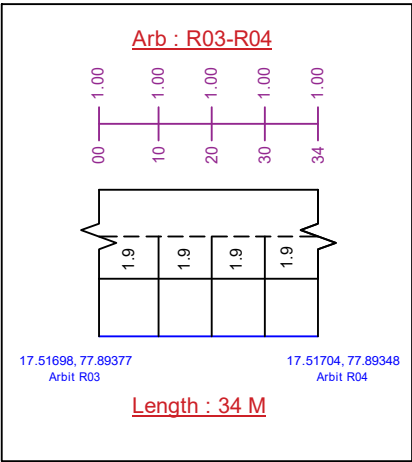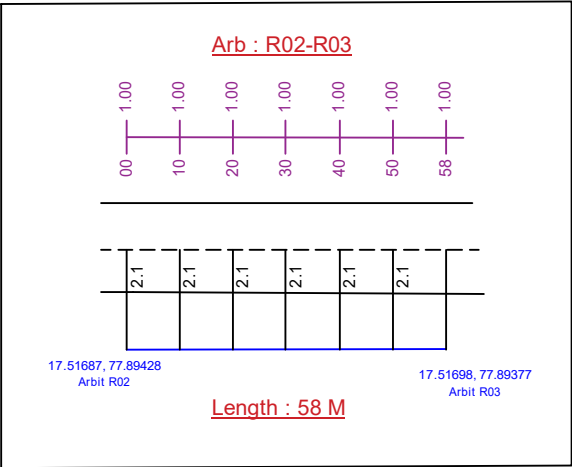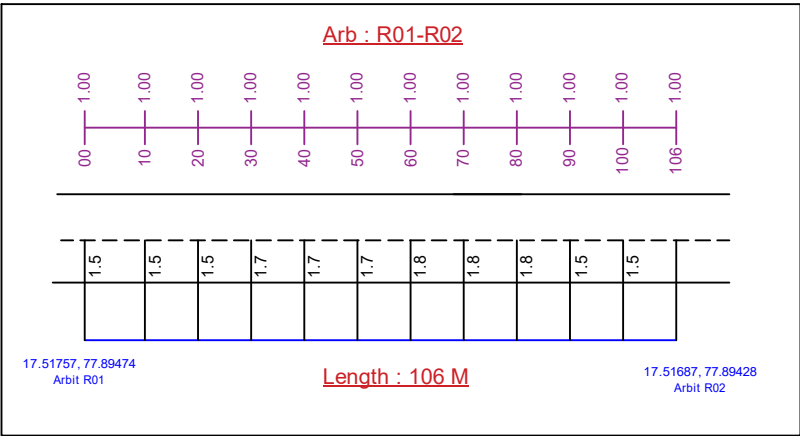

Sheet No. 01
Route Distance : 14577 M

Checked	Designation	Signature


ROAD OFFSET DETAILING FOR MOMINPET OHSR4 (MOMINPET)

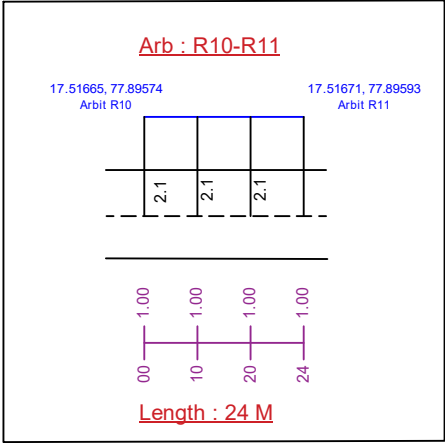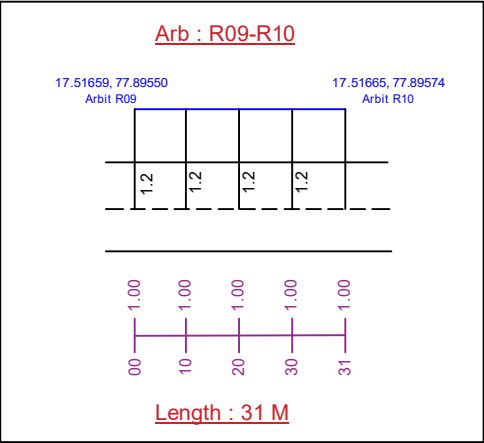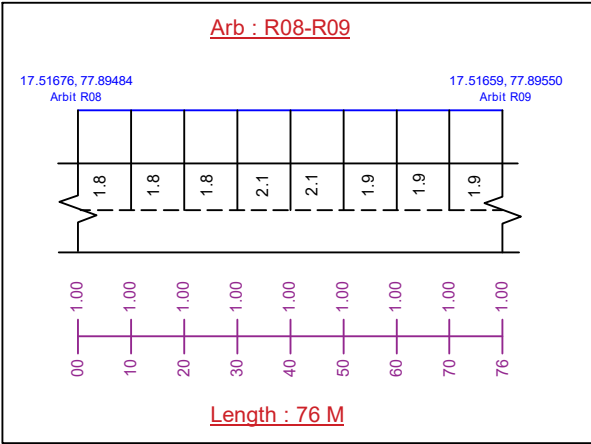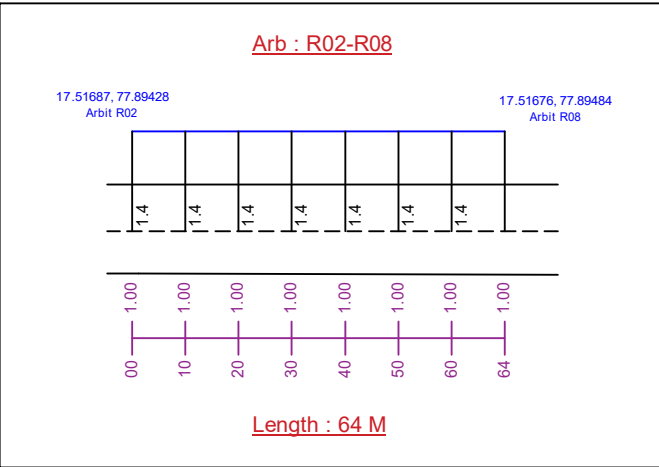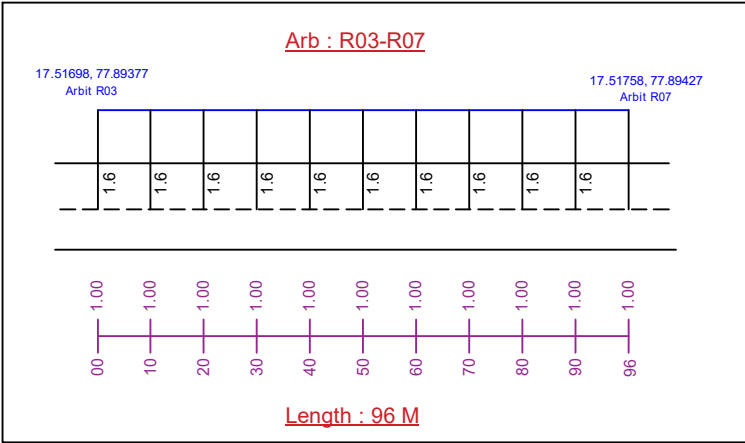


Checked	Designation	Signature

ROAD OFFSET DETAILING FOR MOMINPET OHSR4 (MOMINPET)


Arb : R11-R12

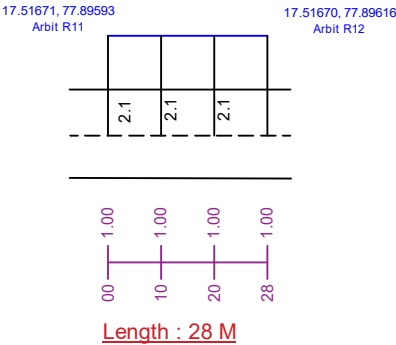


Arb : R12-R13

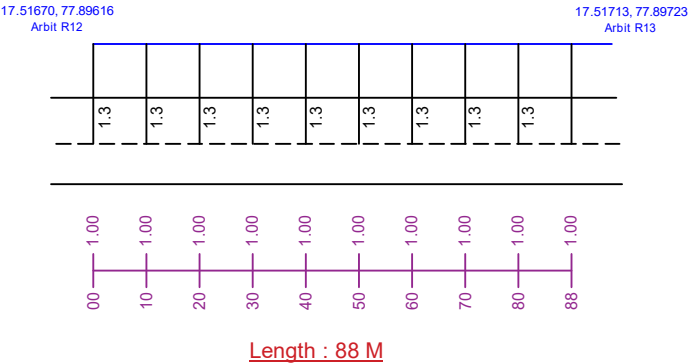


Arb : R13-R14

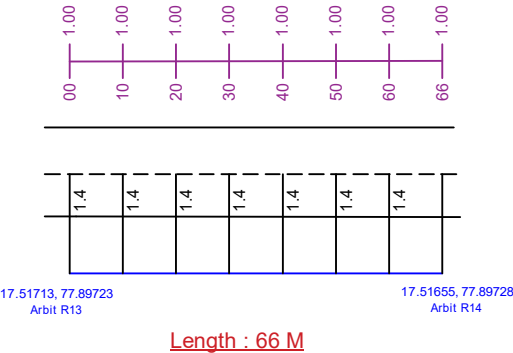

Arb : R14-R15

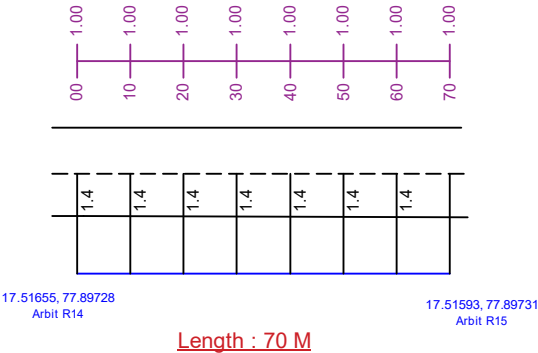


Arb : R15-R16

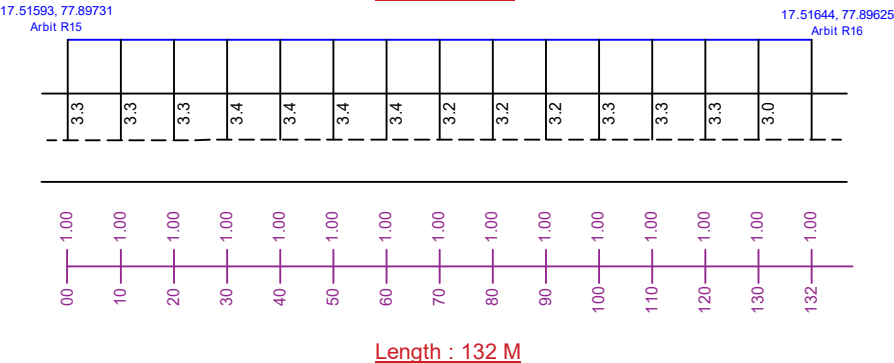


Checked	Designation	Signature

ROAD OFFSET DETAILING FOR MOMINPET OHSR4 (MOMINPET)


Arb : R13-R17

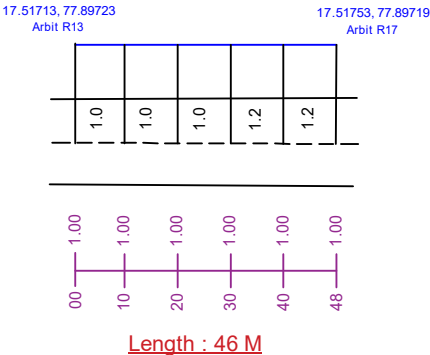


Arb : R17-R18

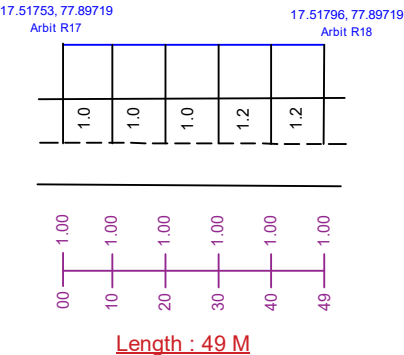


Arb : R18-R19

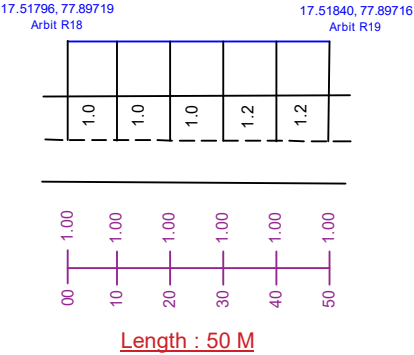

Arb : R19-R20




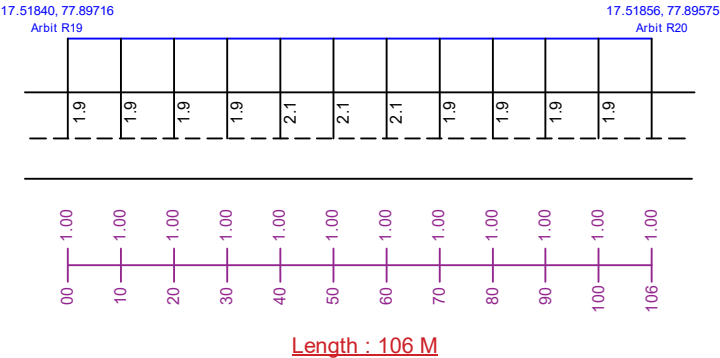


Arb : R20-R21

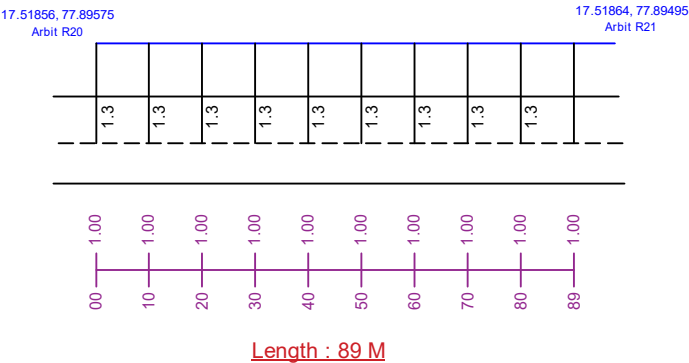

Checked	Designation	Signature

ROAD OFFSET DETAILING FOR MOMINPET OHSR4 (MOMINPET)

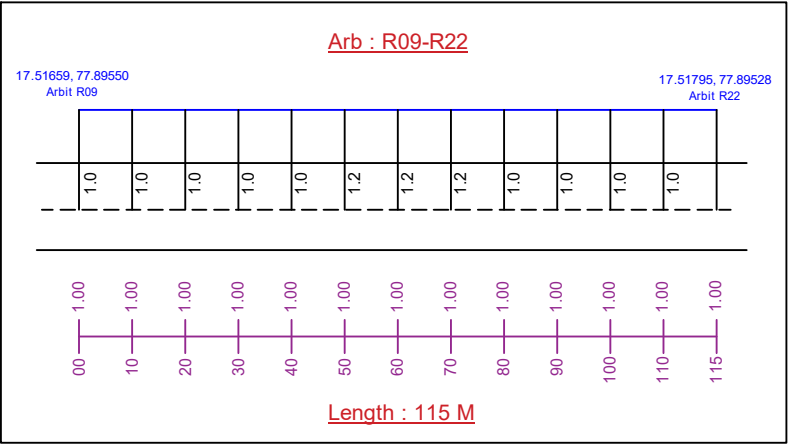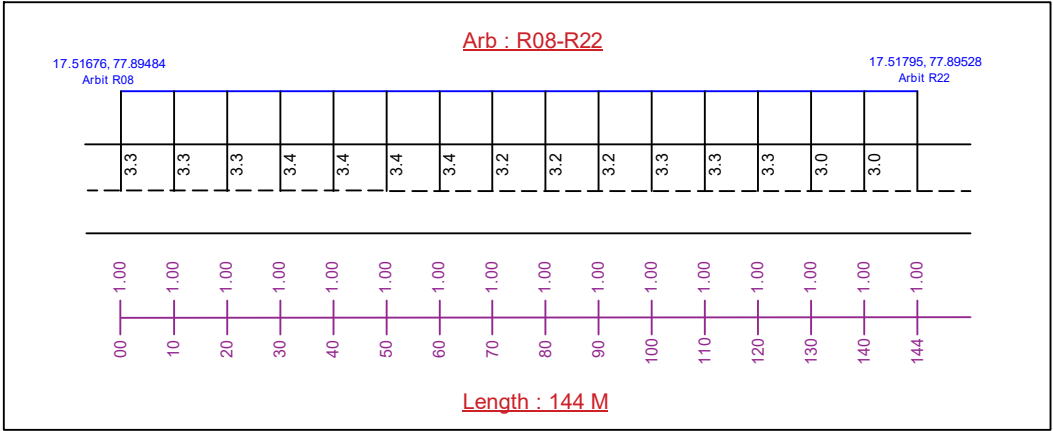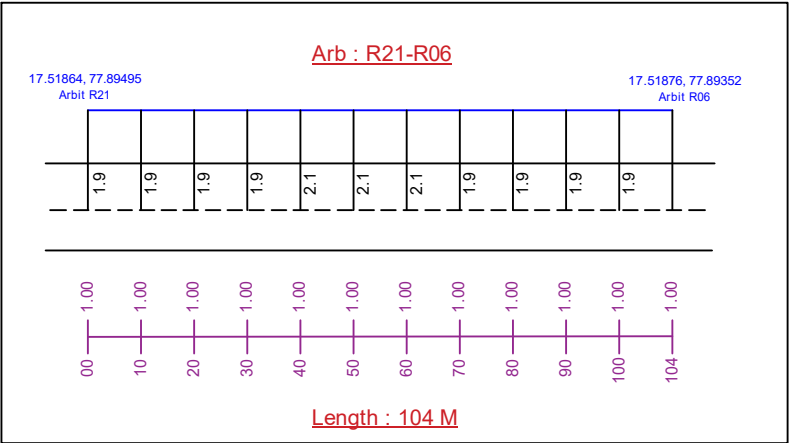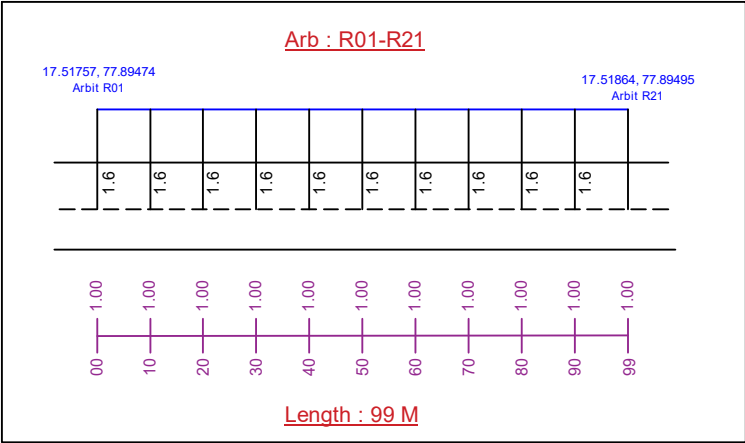


Sheet No. 05
Route Distance : 14577 M


Checked	Designation	Signature

ROAD OFFSET DETAILING FOR MOMINPET OHSR4 (MOMINPET)


Arb : R10-R20

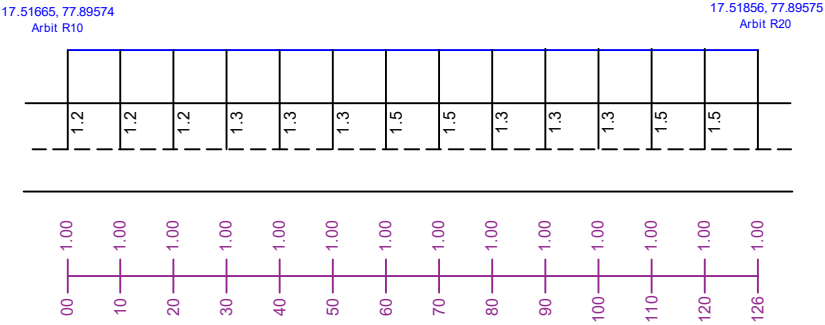


Arb : R11-R23

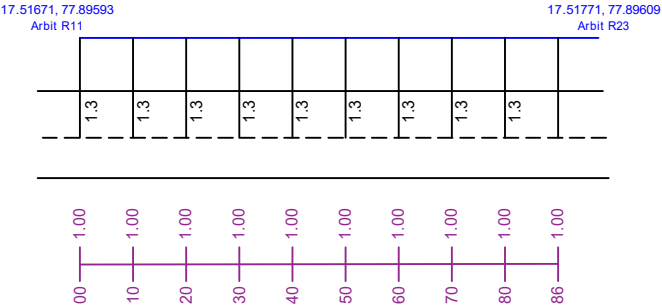

Arb : R12-R24




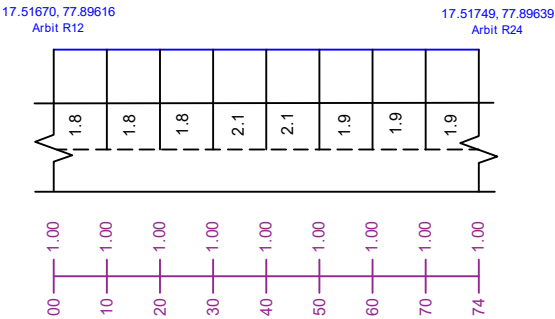


Arb : R17-R24

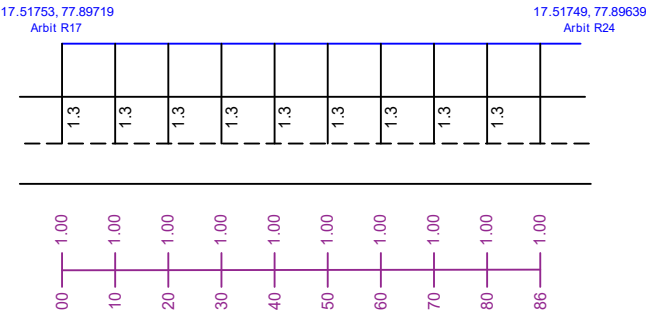



Checked	Designation	Signature

ROAD OFFSET DETAILING FOR MOMINPET OHSR4 (MOMINPET)

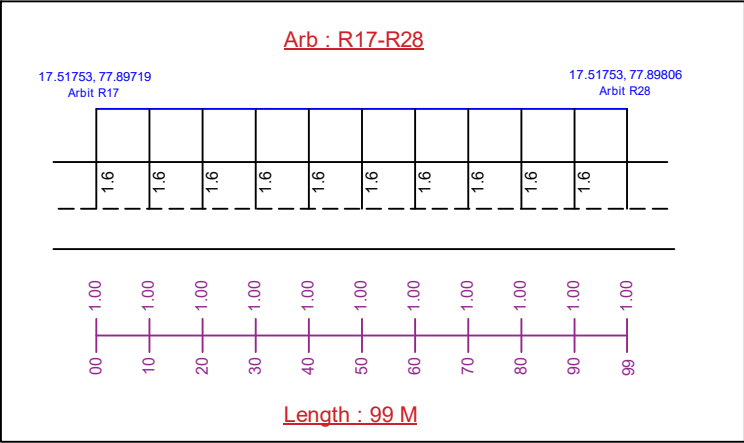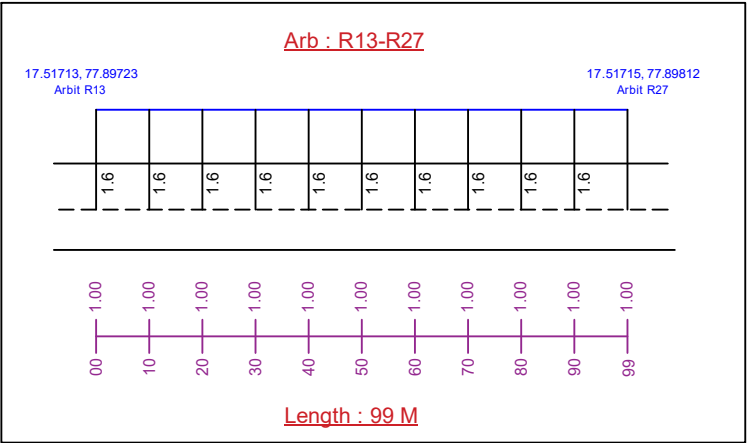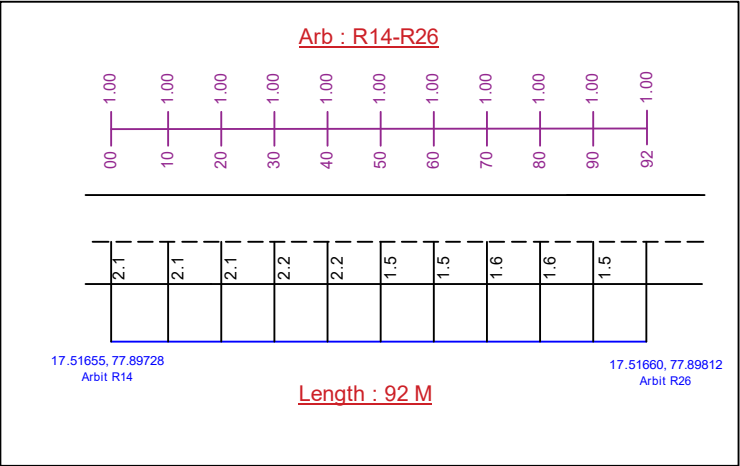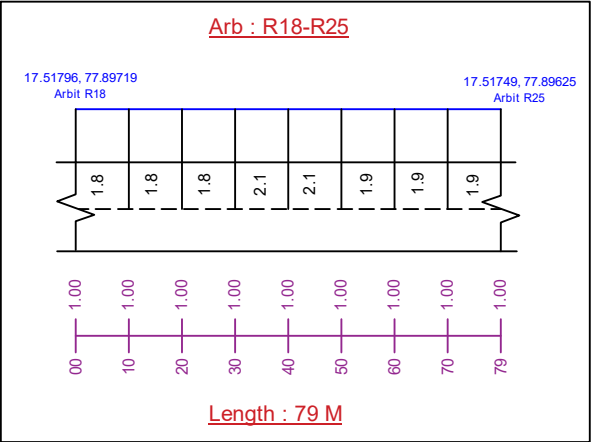



Checked	Designation	Signature



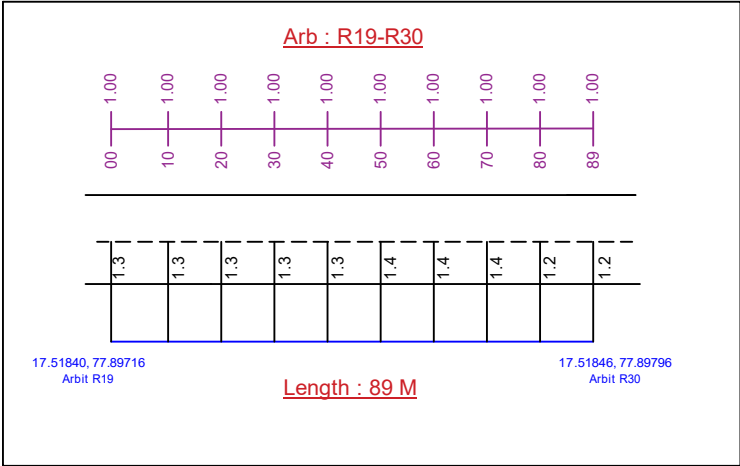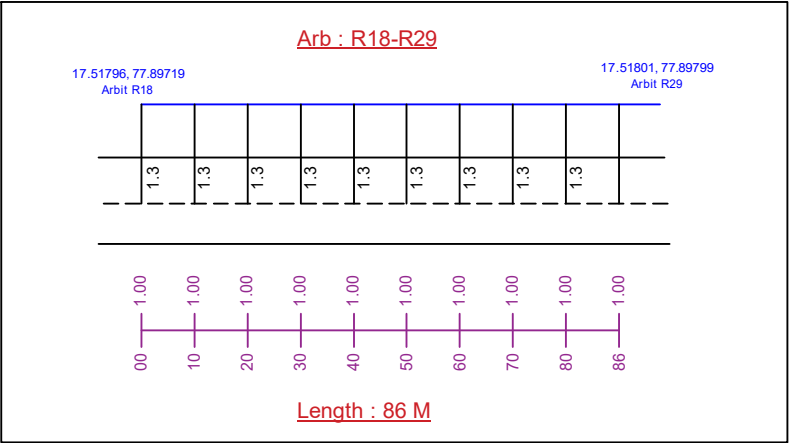



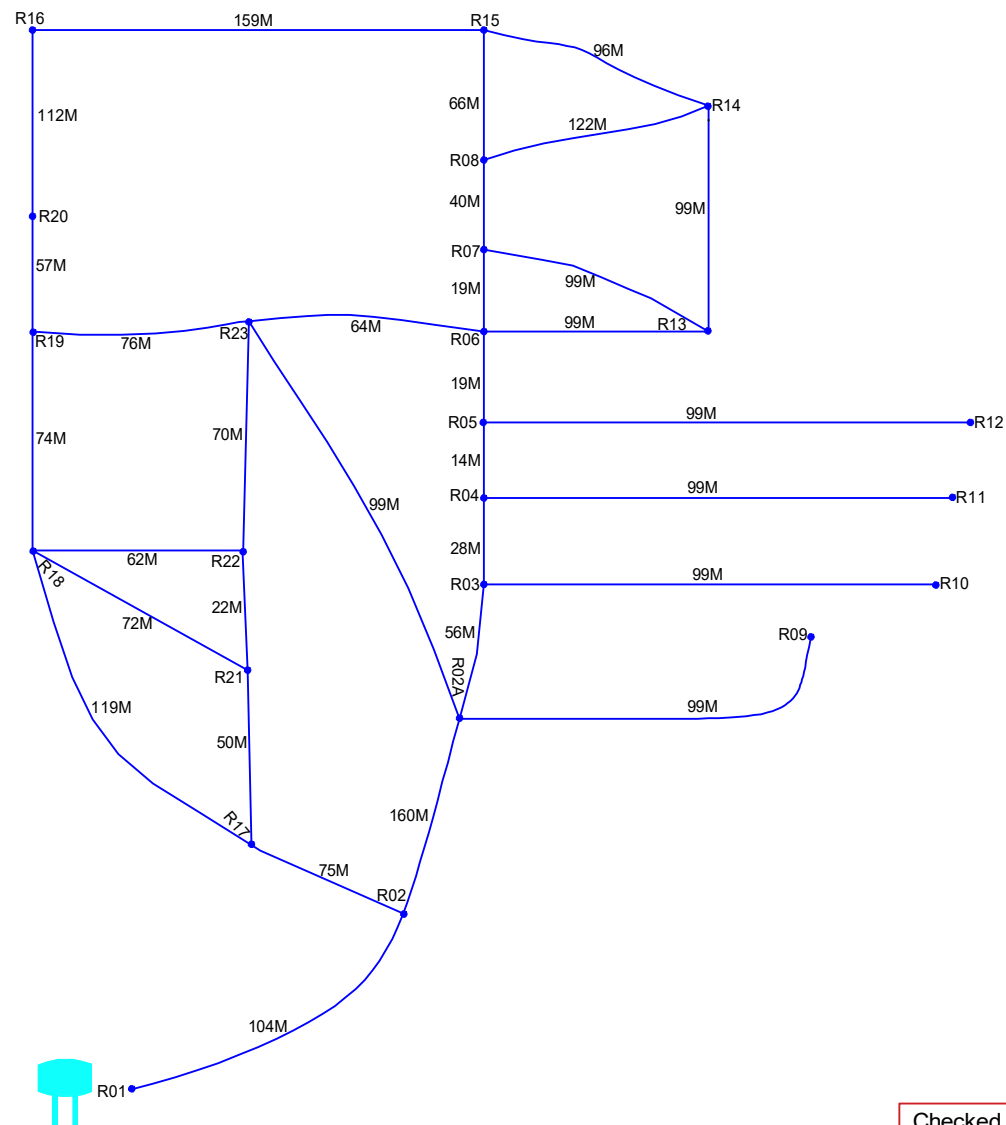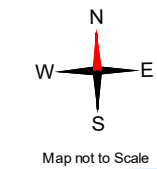

ROAD OFFSET DETAILING FOR MOMINPET OHSR4 (MOMINPET)



Checked	Designation	Signature

SINGLELINE LOOP DIAGRAM FOR MOMINPET OHSR5 (MOMINPET)





	DUCT PIPE
	ROAD
	OHSR
	G.P OFFICE
	TEMPLE
	HOSPITAL
	SCHOOL
	DUCT GAP

Sheet No. 01
Route Distance : 14577 M

Checked	Designation	Signature

DUCTLAYING ROUTE DIAGRAM FOR MOMINPET OHSR5 (MOMINPET)





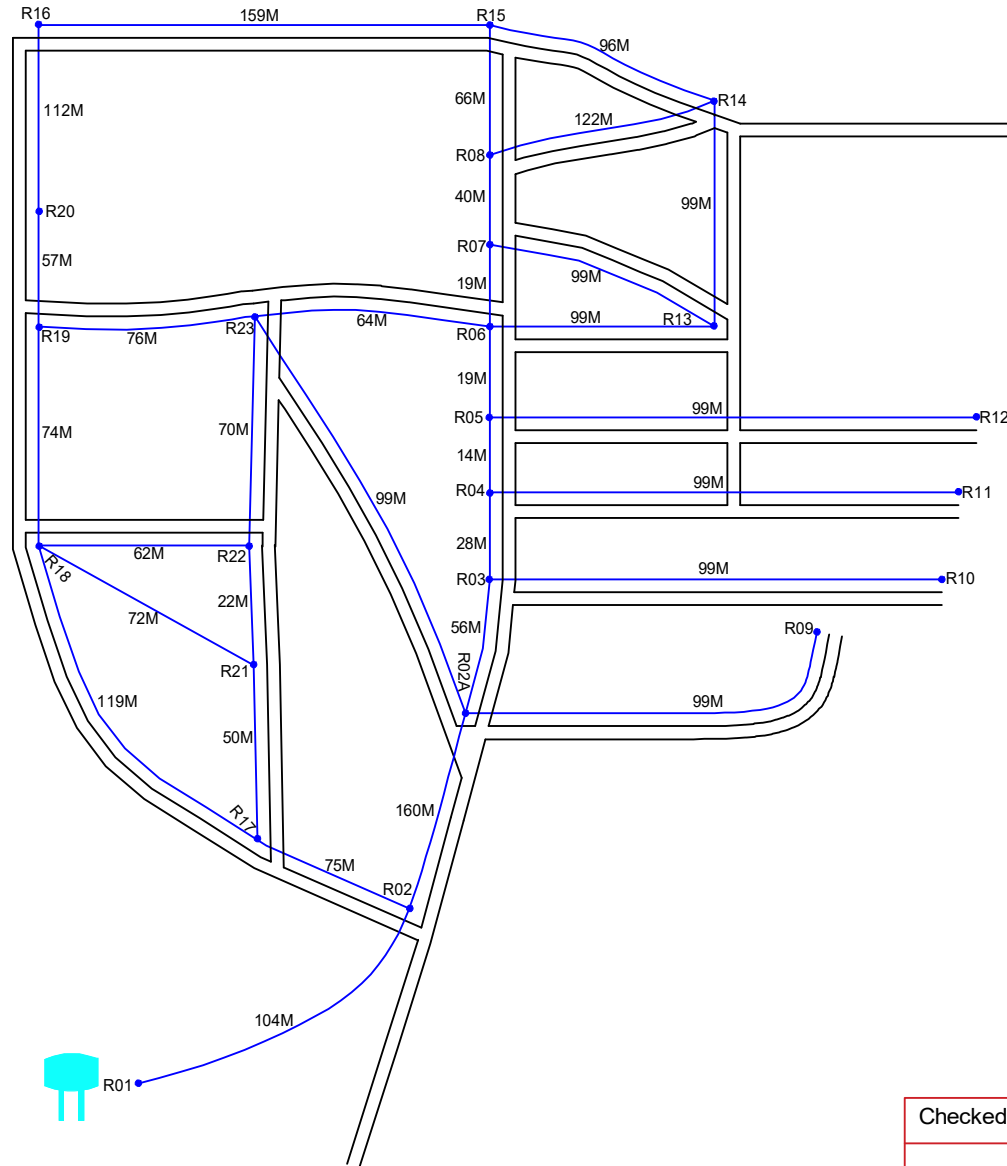
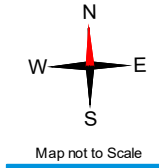


	DUCT PIPE
	ROAD
	OHSR
	G.P OFFICE
	TEMPLE
	HOSPITAL
	SCHOOL
	DUCT GAP

Sheet No. 01
Route Distance : 14577 M

Checked	Designation	Signature


ROAD OFFSET DETAILING FOR MOMINPET OHSR1 (MOMINPET)

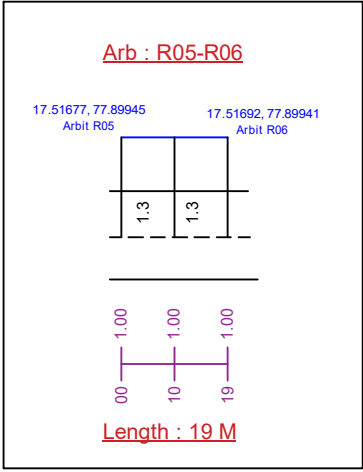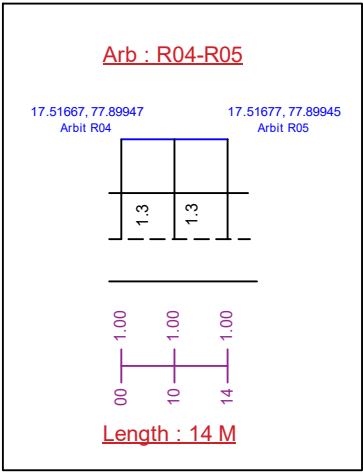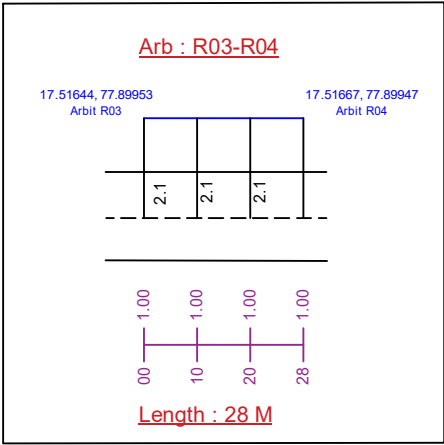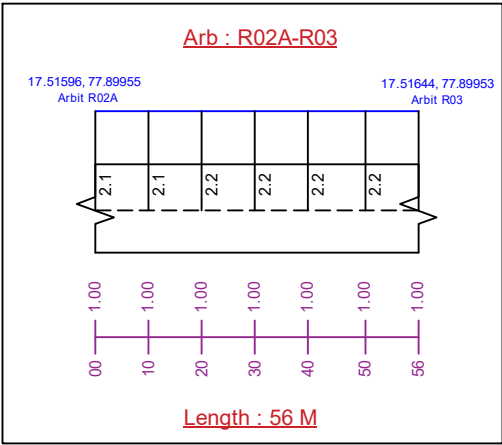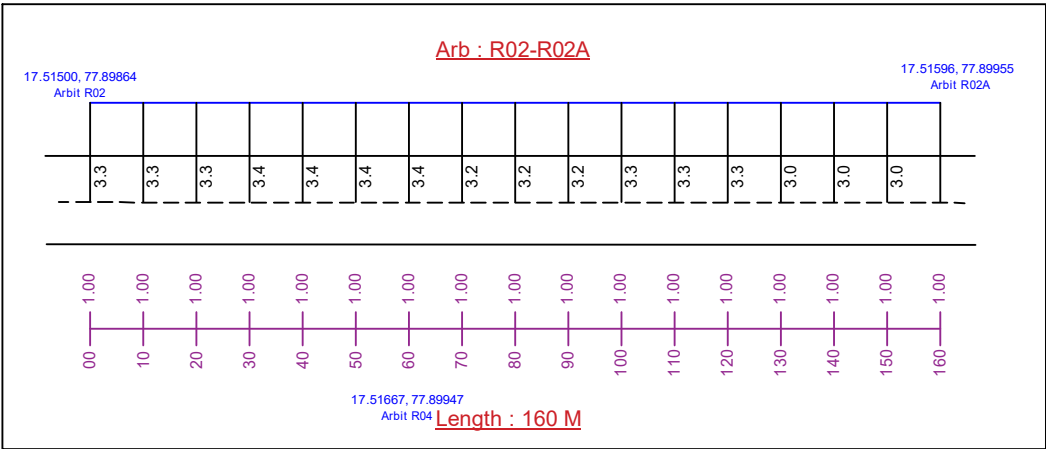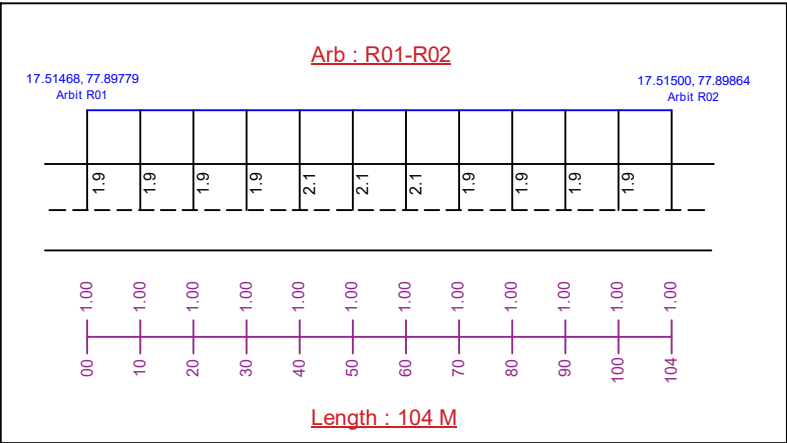


Checked	Designation	Signature

ROAD OFFSET DETAILING FOR MOMINPET OHSR1 (MOMINPET)


Arb : R06-R07

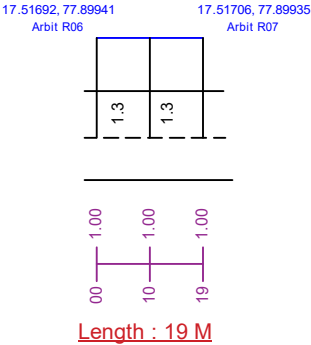


Arb : R07-R08

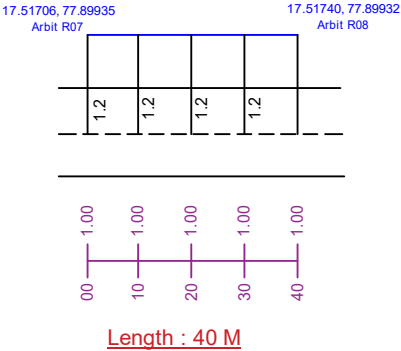

Arb : R03-R10

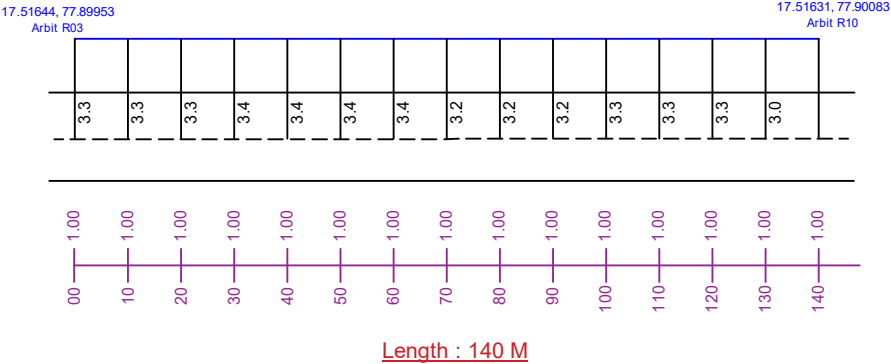


Arb : R02A-R09

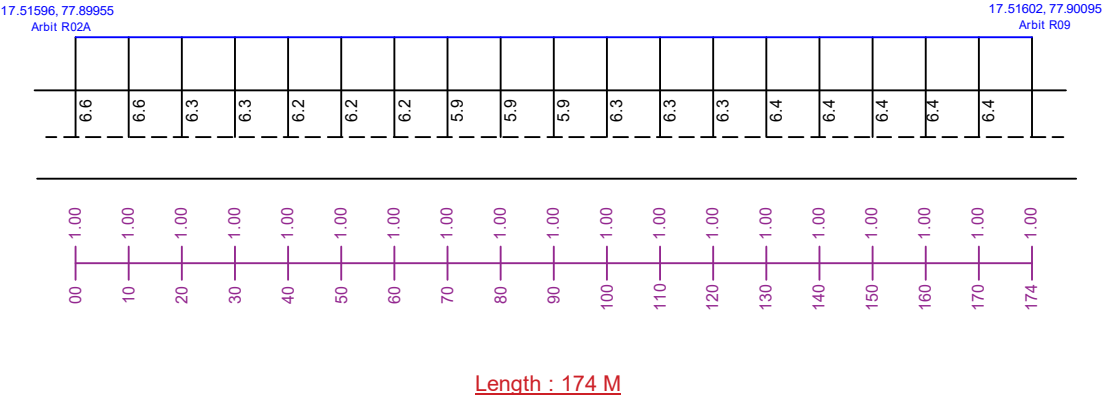

Checked	Designation	Signature


ROAD OFFSET DETAILING FOR MOMINPET OHSR1 (MOMINPET)

Arb : R04-R11

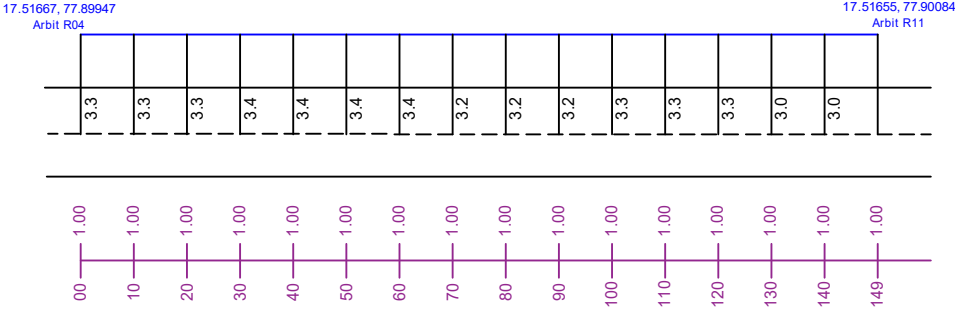


Length : 149 M

Arb : R06-R13

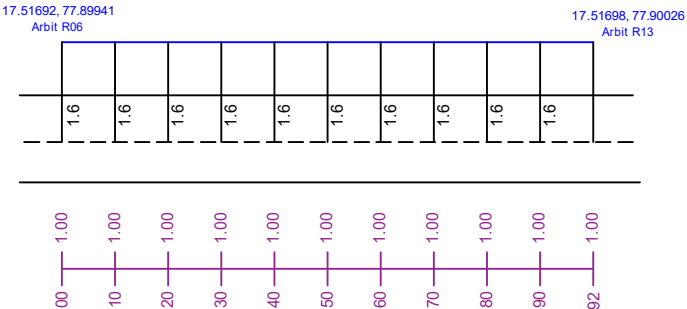


Length : 92 M

Arb : R05-R12

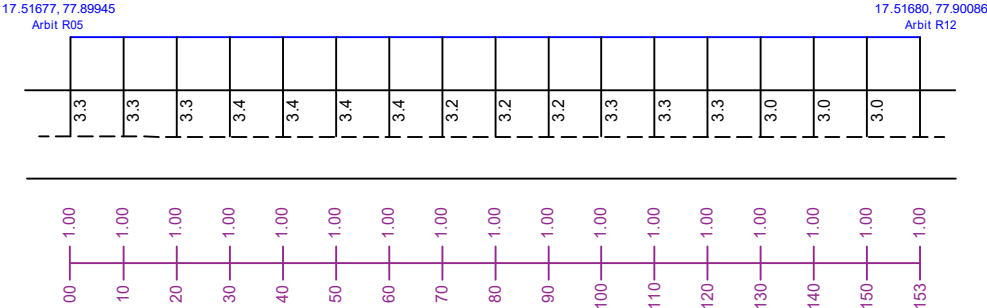

Length : 153 M

Arb : R07-R13

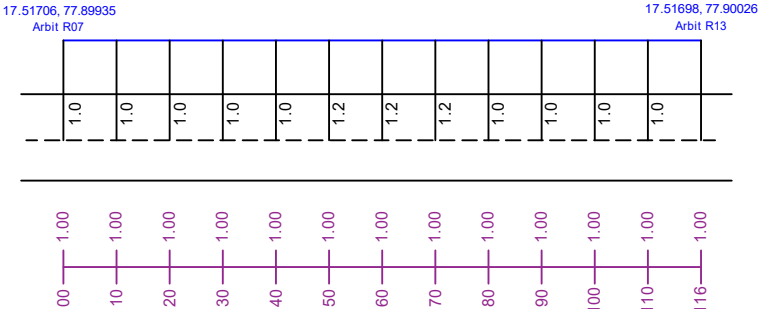


Length : 116 M

Checked	Designation	Signature


ROAD OFFSET DETAILING FOR MOMINPET OHSR1 (MOMINPET)

Arb : R13-R14

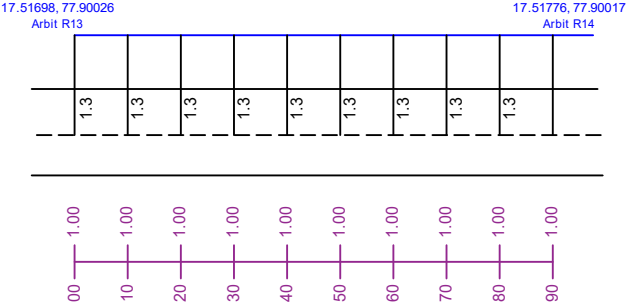


Length : 90 M

Arb : R08-R14

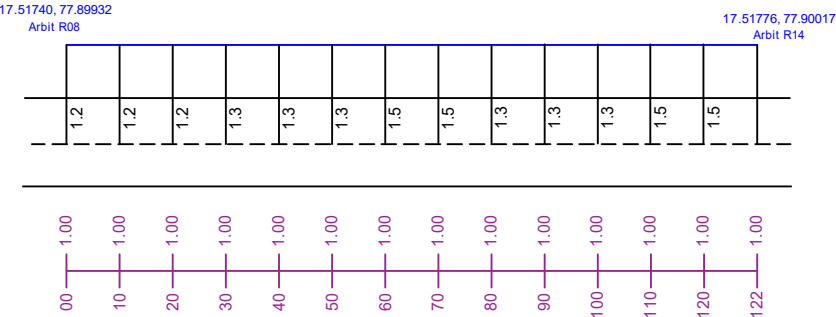


Length : 122 M

Arb : R08-R15

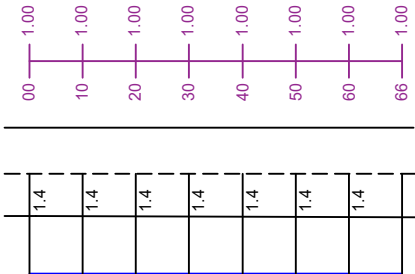

Length : 66 M





Arb : R15-R14

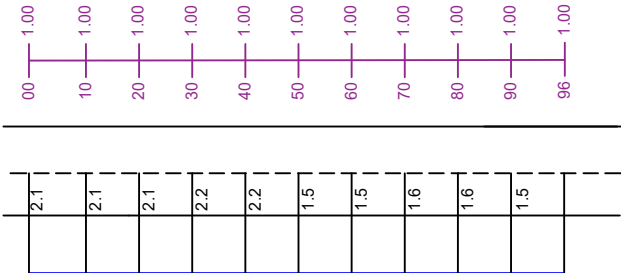

Length : 96 M

Checked	Designation	Signature


ROAD OFFSET DETAILING FOR MOMINPET OHSR1 (MOMINPET)

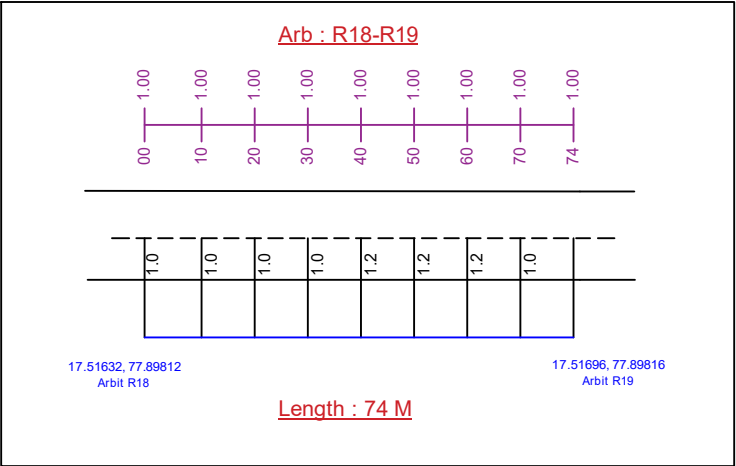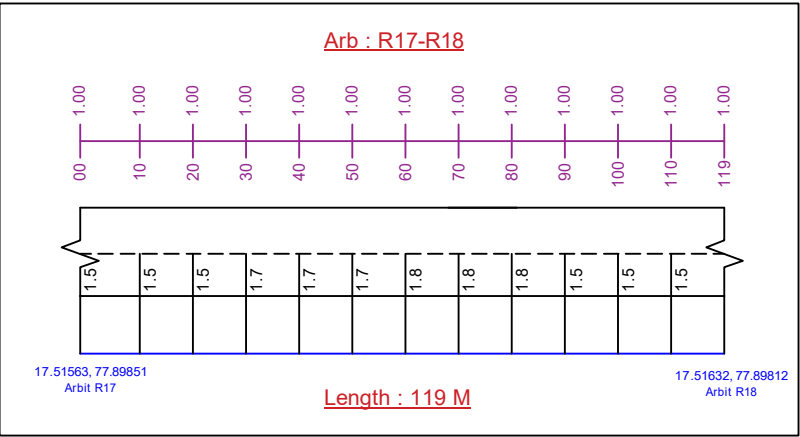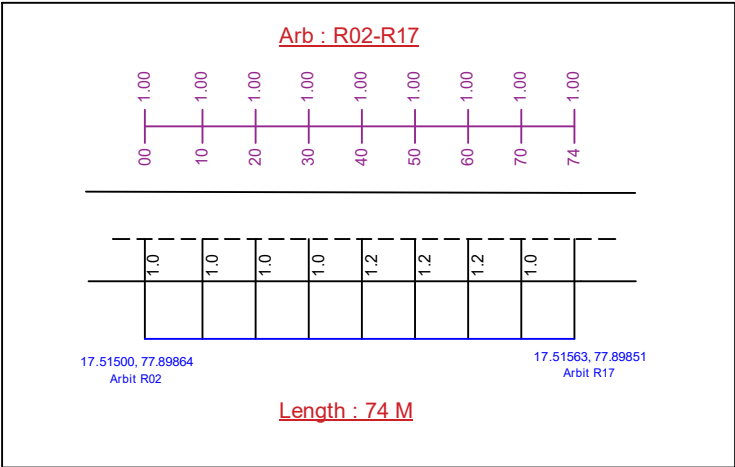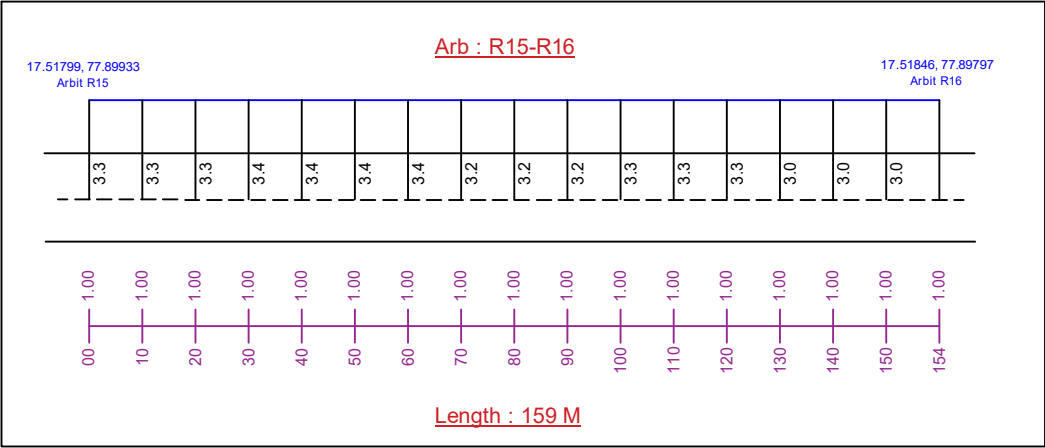

Checked	Designation	Signature

ROAD OFFSET DETAILING FOR MOMINPET OHSR1 (MOMINPET)

Arb : R19-R20

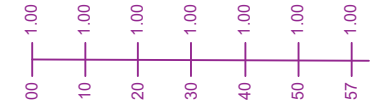


17.51696, 77.89816
Arbit R19

17.51747, 77.89813
Arbit R20

Length : 57 M

Arb : R20-R16

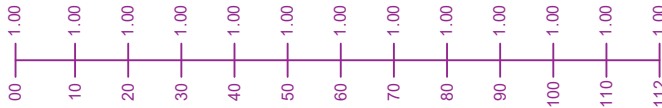


17.51747, 77.89813
Arbit R20

17.51846, 77.89797
Arbit R16

Length : 112 M

Arb : R18-R21

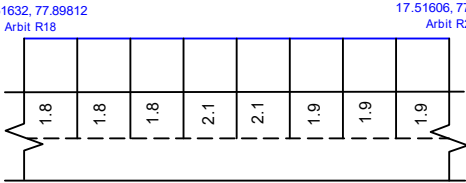


17.51632, 77.89812
Arbit R18

17.51606, 77.89862
Arbit R21

Length : 72 M

Arb : R17-R21

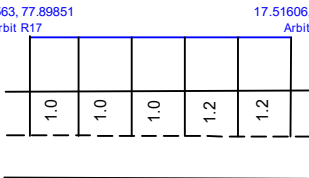


17.51563, 77.89851
Arbit R17

17.51606, 77.89862
Arbit R21

Length : 50 M

Arb : R21-R22

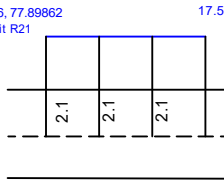

17.51606, 77.89862
Arbit R21


17.51625, 77.89869
Arbit R22

Length : 22 M

Checked	Designation	Signature


ROAD OFFSET DETAILING FOR MOMINPET OHSR1 (MOMINPET)

Arb : R18-R22

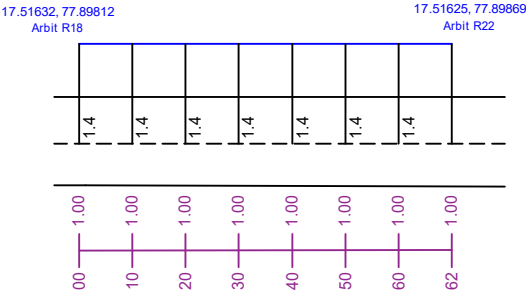


Length : 62 M

Arb : R02A-R23

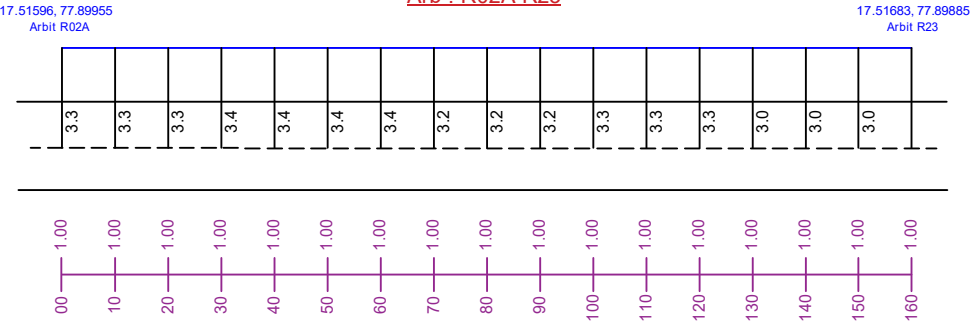


Length : 160 M

Arb : R22-R23

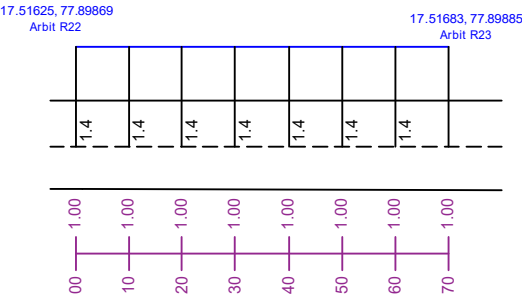


Length : 70 M

Arb : R19-R23

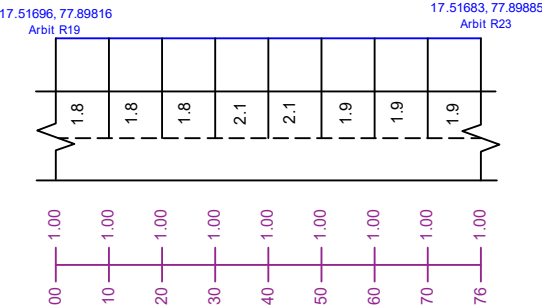

Length : 76 M



Arb : R22-R06

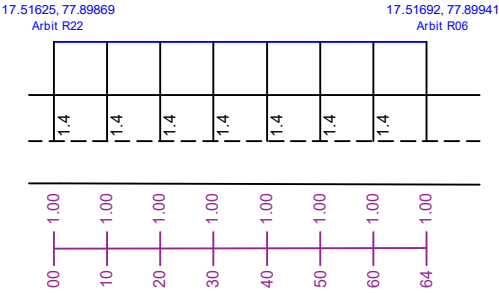

Length : 64 M

Checked	Designation	Signature

SINGLELINE CHAIN DIAGRAM FOR MOMINPET OHSR6 (MOMINPET)

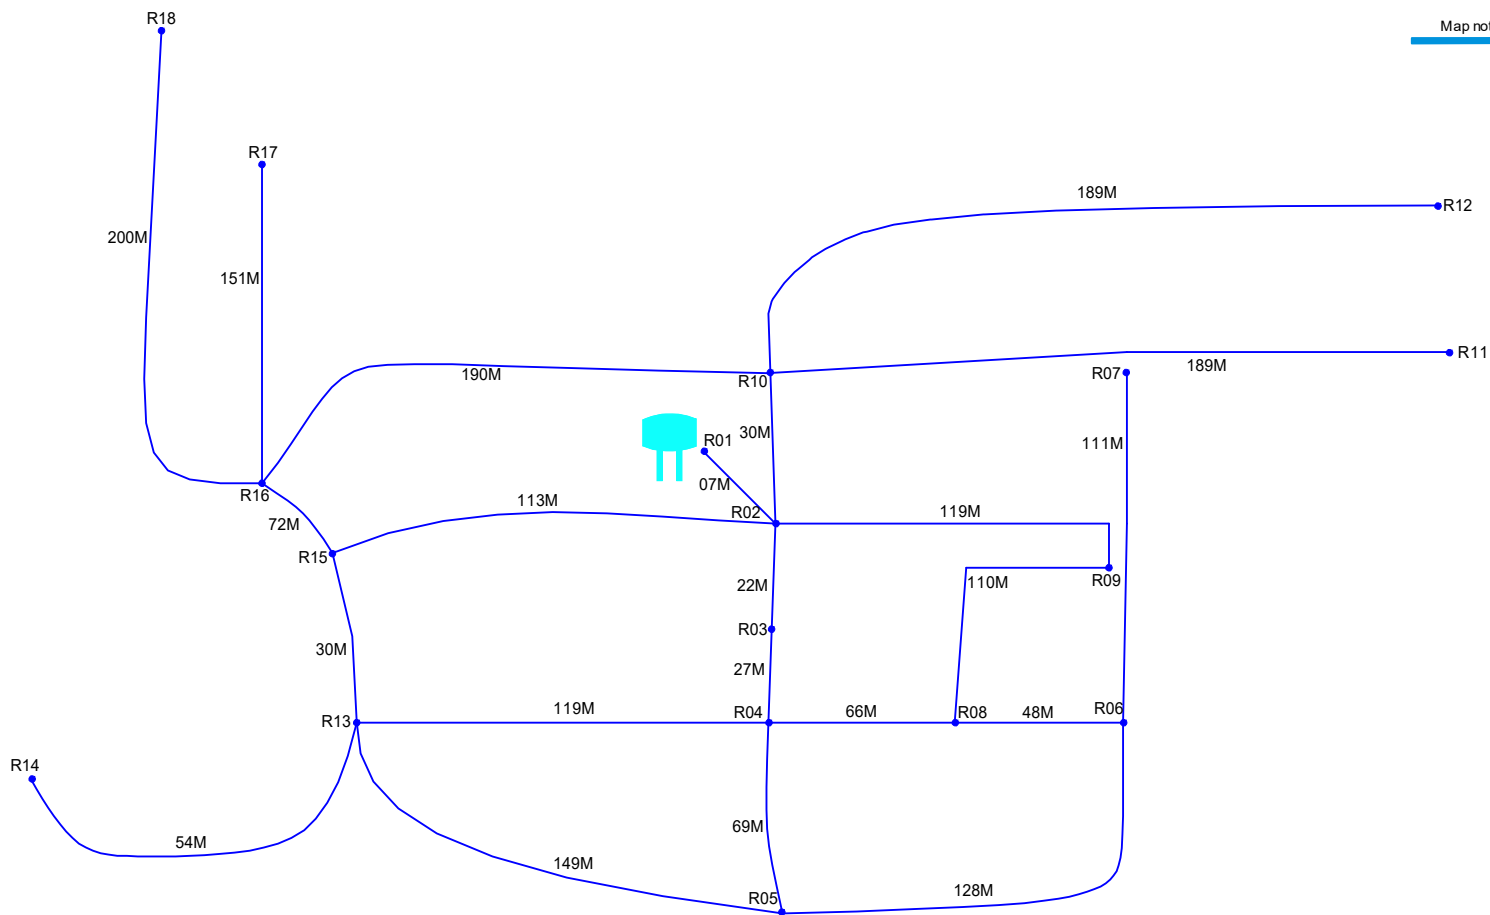
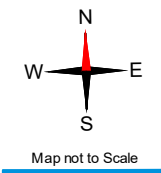


	DUCT PIPE
	ROAD
	OHSR
	G.P OFFICE
	TEMPLE
	HOSPITAL
	SCHOOL
	DUCT GAP

Sheet No. 01
Route Distance : 14577 M

Checked	Designation	Signature

DUCTLAYING ROUTE DIAGRAM FOR MOMINPET OHSR6 (MOMINPET)

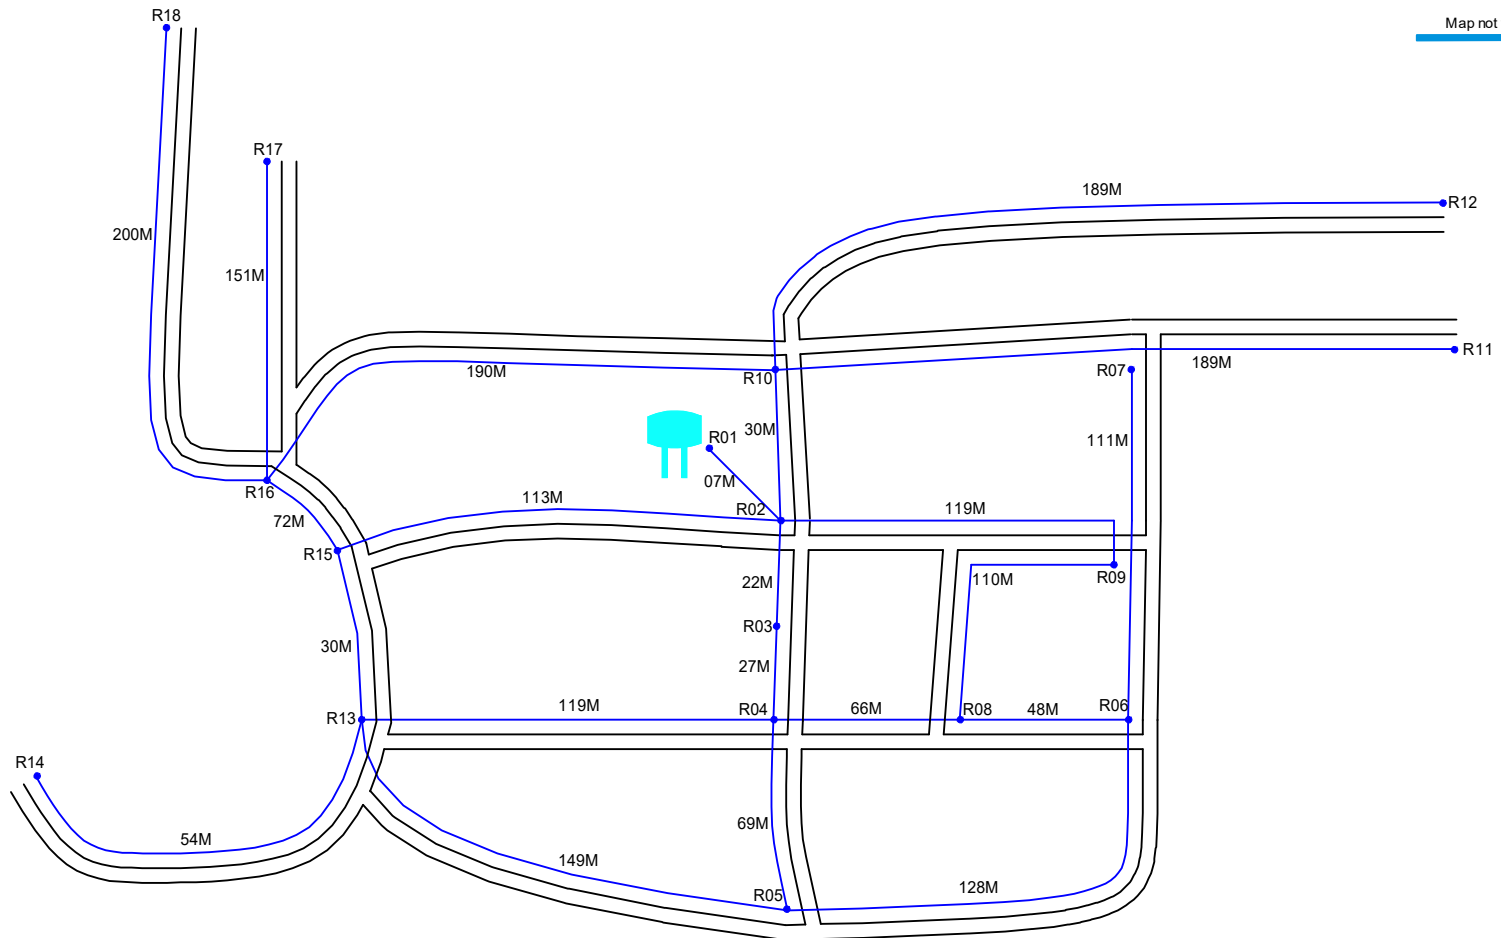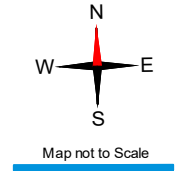


	DUCT PIPE
	ROAD
	OHSR
	G.P OFFICE
	TEMPLE
	HOSPITAL
	SCHOOL
	DUCT GAP

Sheet No. 01
Route Distance : 14577 M

Checked	Designation	Signature


ROAD OFFSET DETAILING FOR MOMINPET OHSR6 (MOMINPET)

Arb : R01-R02

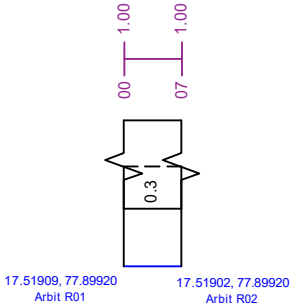


Length : 07 M

Arb : R02-R03

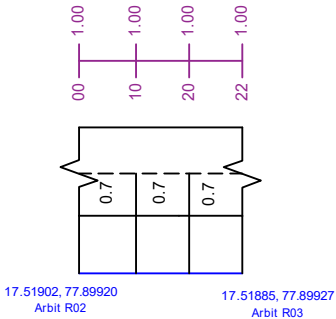


Length : 22 M

Arb : R03-R04

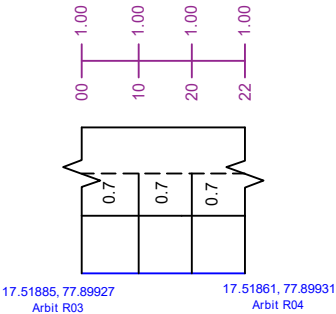


Length : 22 M

Arb : R04-R05

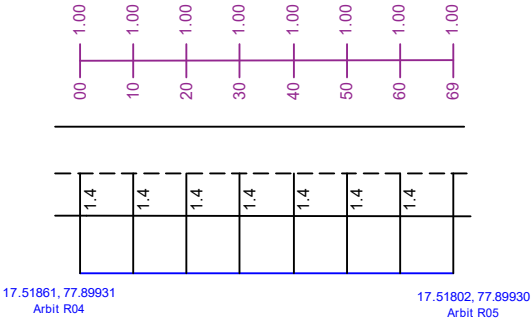


Length : 69 M

Arb : R05-R06

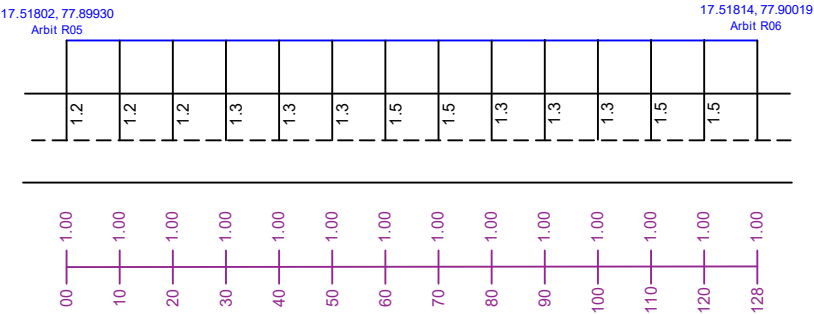

Length : 128 M






Arb : R06-R07

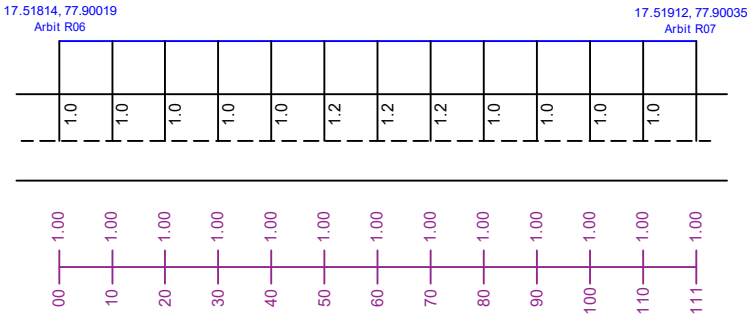

Length : 111 M

Checked	Designation	Signature


ROAD OFFSET DETAILING FOR MOMINPET OHSR6 (MOMINPET)

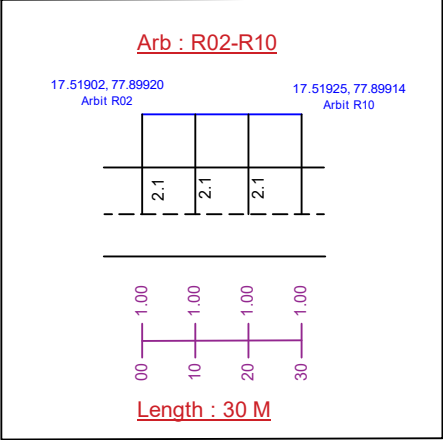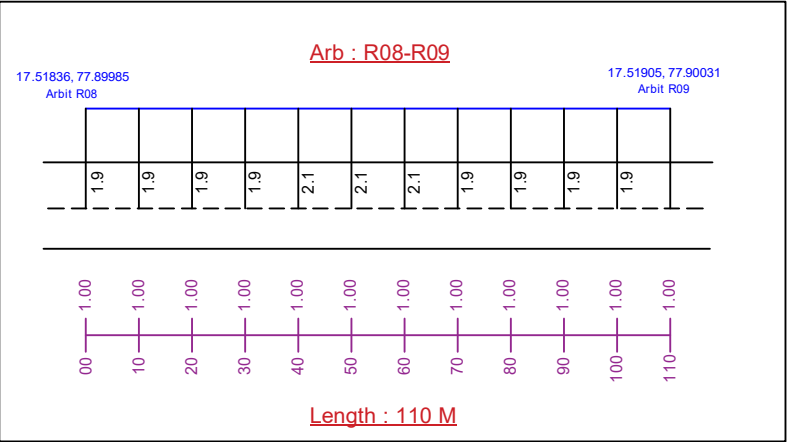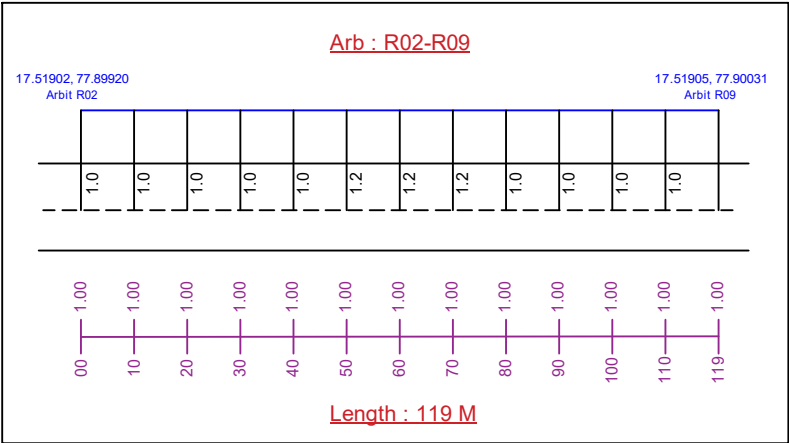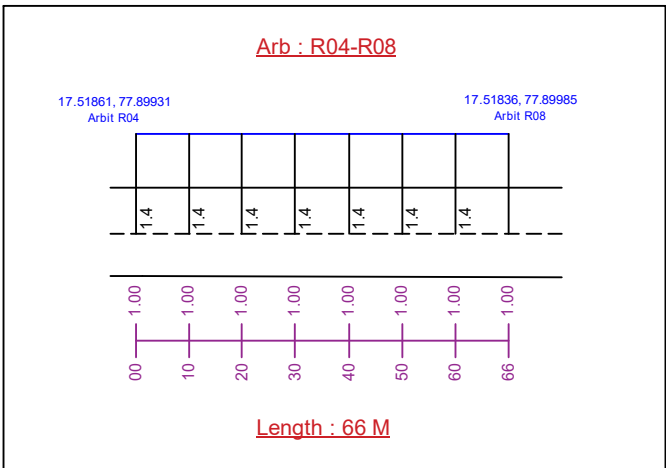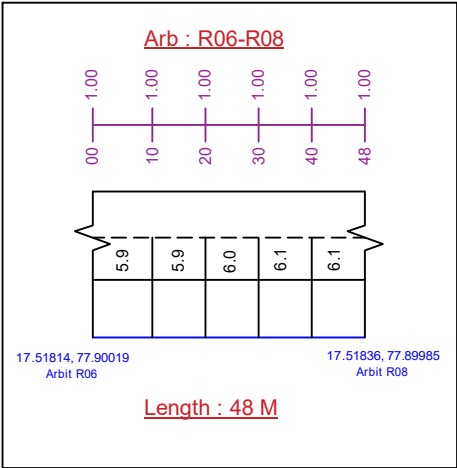

Checked	Designation	Signature


ROAD OFFSET DETAILING FOR MOMINPET OHSR6 (MOMINPET)

Arb : R13-R14

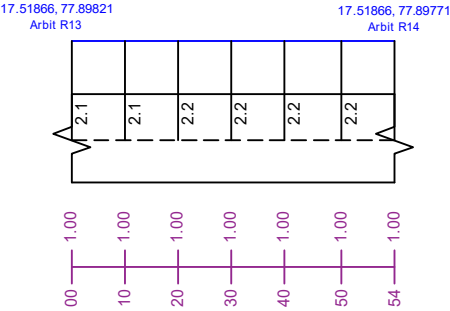


Length : 54 M

Arb : R13-R15

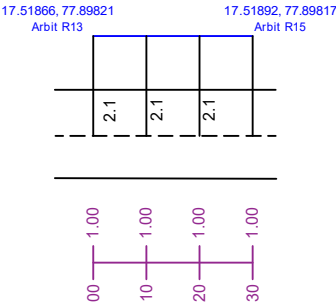


Length : 30 M

Arb : R15-R02

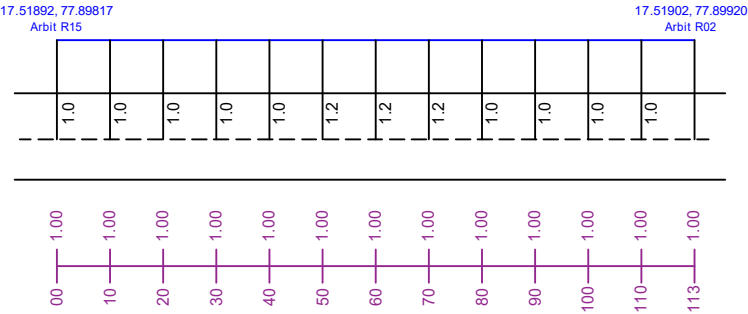


Length : 113 M

Arb : R15-R16

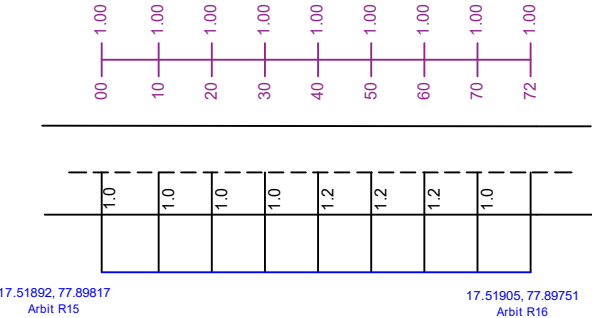

Length : 72 M



Arb : R10-R16

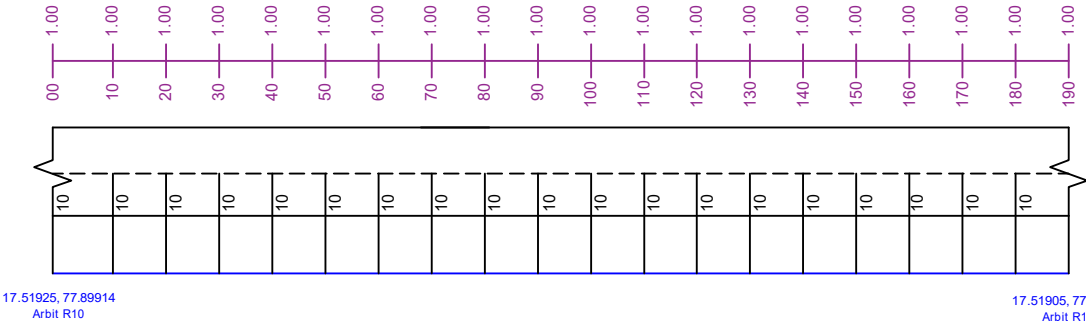

Length : 190 M

Checked	Designation	Signature

ROAD OFFSET DETAILING FOR MOMINPET OHSR6 (MOMINPET)

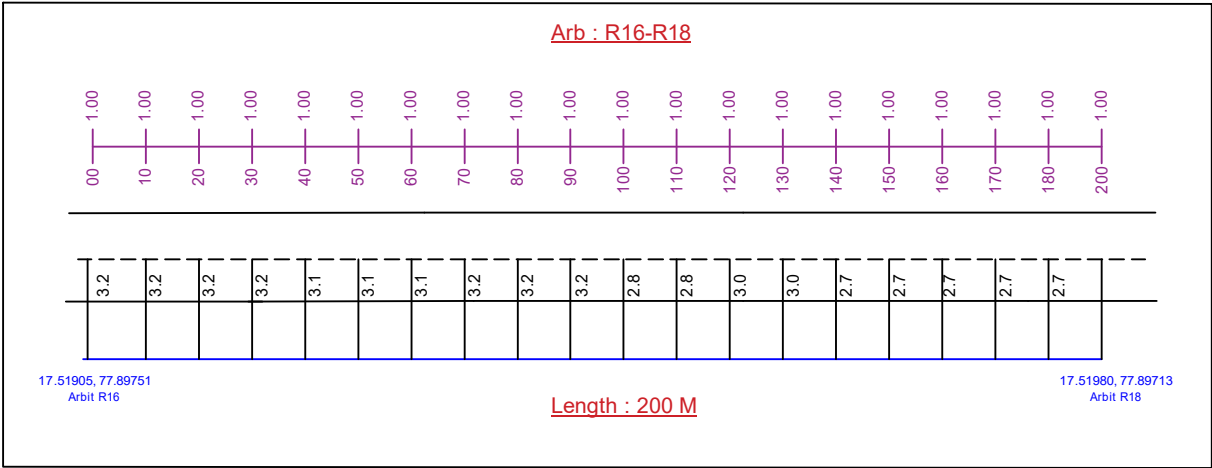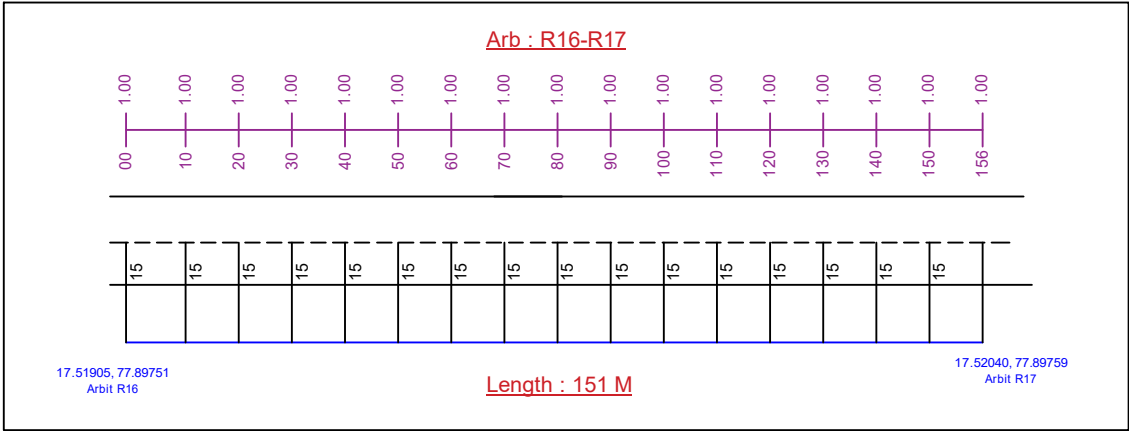

Checked	Designation	Signature



TELANGANA FIBER GRID

TELANGANA FIBER GRID

ITE & C GOVERNMENT OF TELANGANA

7th Floor, Splendid Towers, S.P. Road

Opp: Begumpet Police Station,



Begumpet, Hyderabad-500016.


 






AS - BUILT DRAWINGS (ABD)

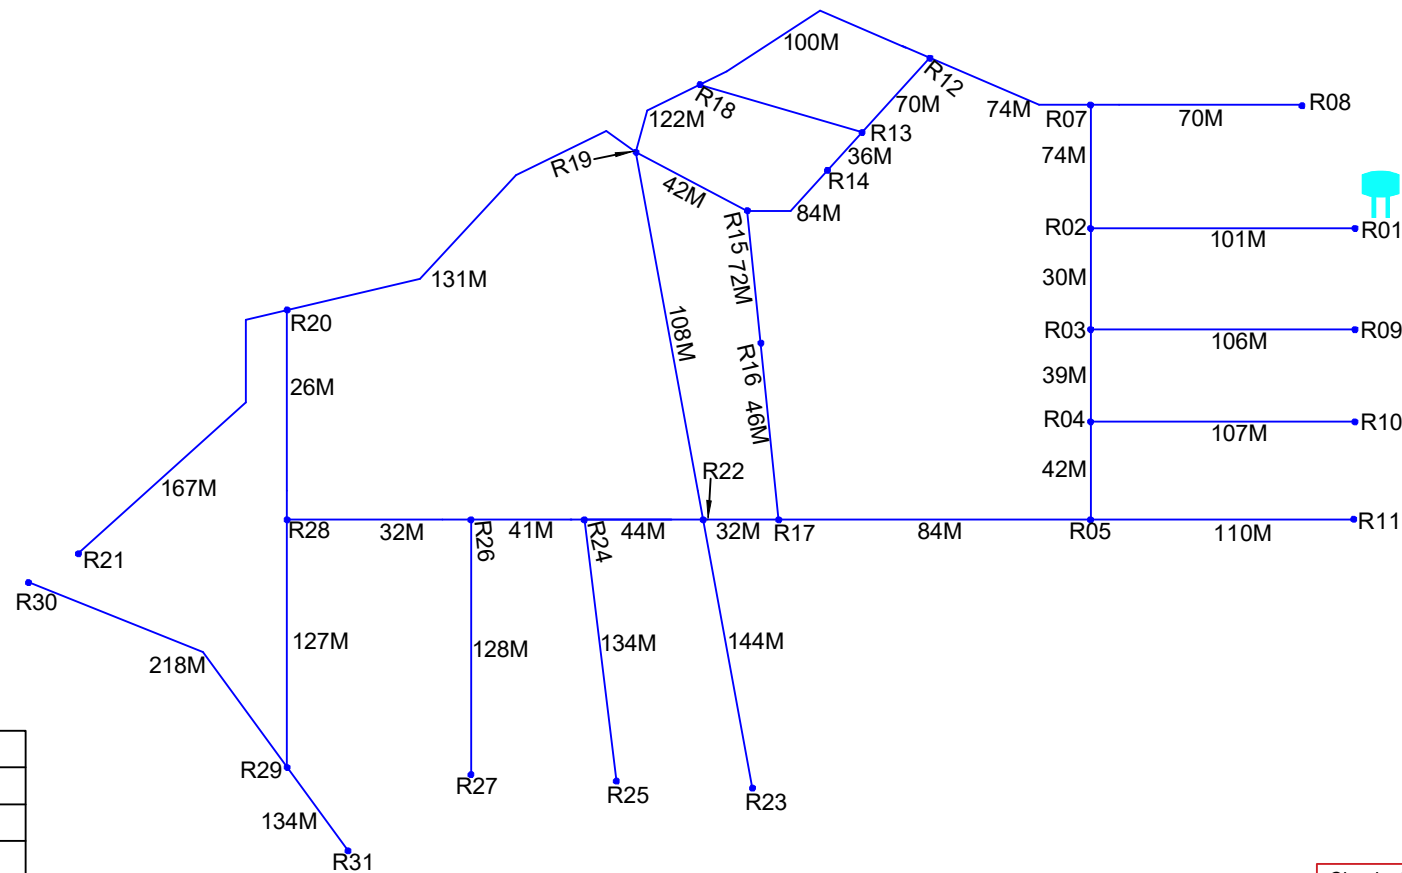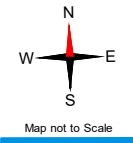MORANGPALLE

(MOMINPET MANDAL-VIKARABAD DIST.)

SINGLELINE LOOP DIAGRAM FOR MORANGPALLE OHSR1 (MOMINPET)






 






	DUCT PIPE
	ROAD
	OHSR
	G.P OFFICE
	TEMPLE
	HOSPITAL
	SCHOOL
	DUCT GAP

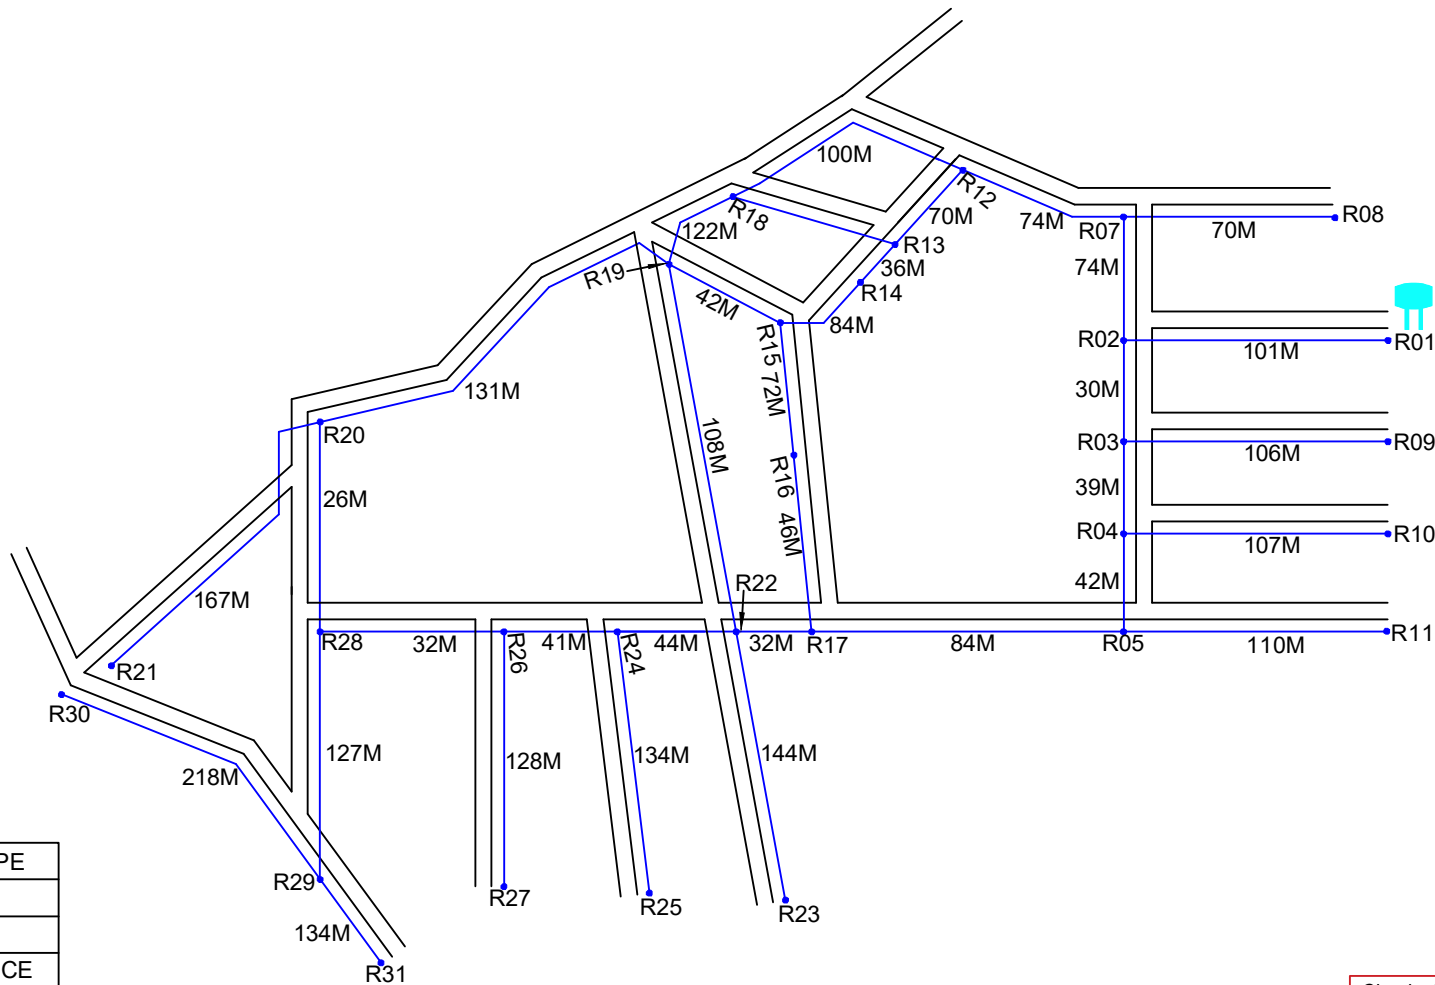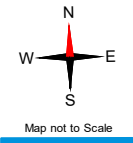Sheet No. 01
Route Distance : 5321 M

Checked	Designation	Signature

DUCTLAYING ROUTE DIAGRAM FOR MORANGPALLE OHSR1 (MOMINPET)









	DUCT PIPE
	ROAD
	OHSR
	G.P OFFICE
	TEMPLE
	HOSPITAL
	SCHOOL
	DUCT GAP

Sheet No. 01
Route Distance : 5321 M

Checked	Designation	Signature


ROAD OFFSET DETAILING FOR MORANGAPALLE OHSR1 (MOMINPET)

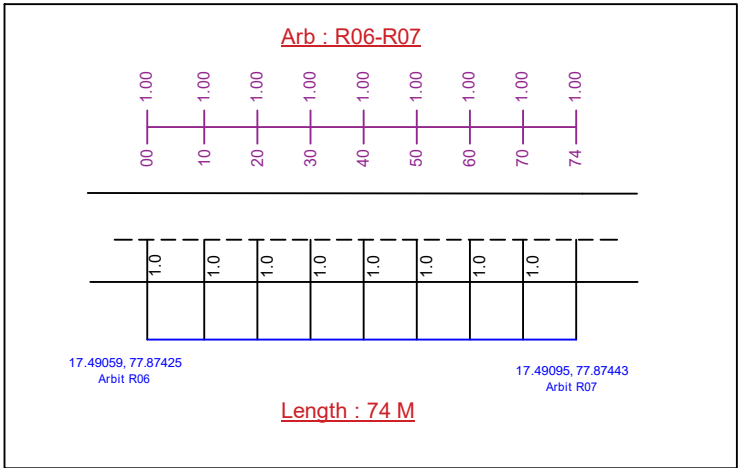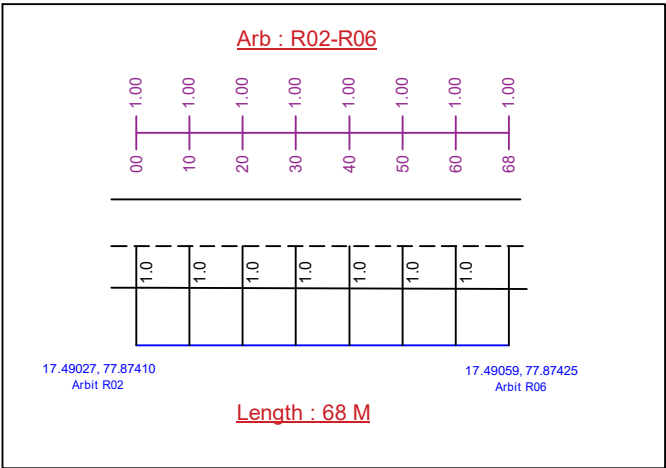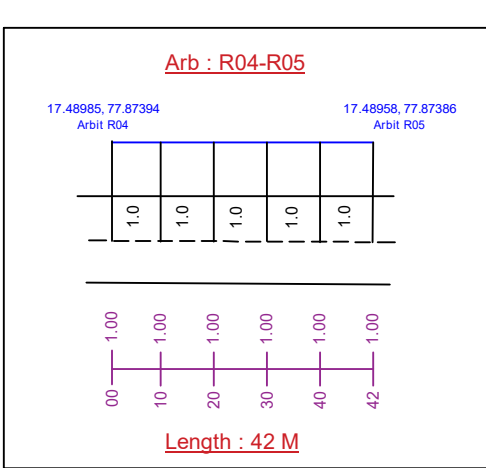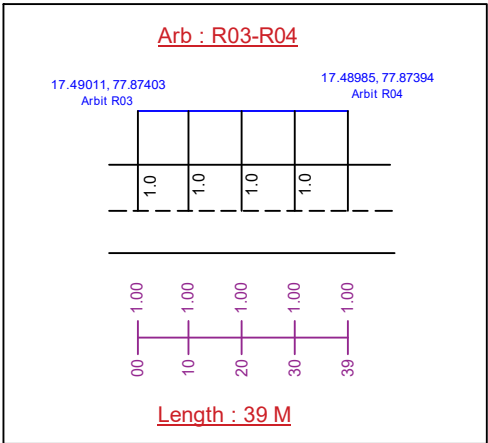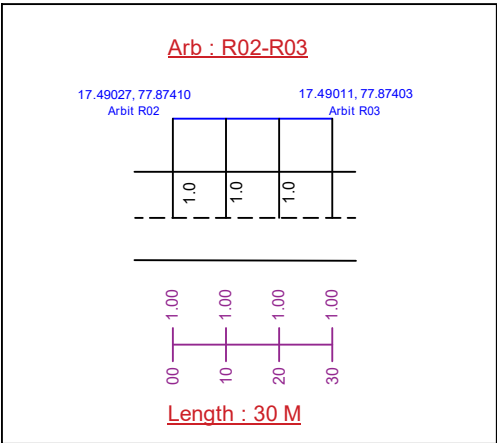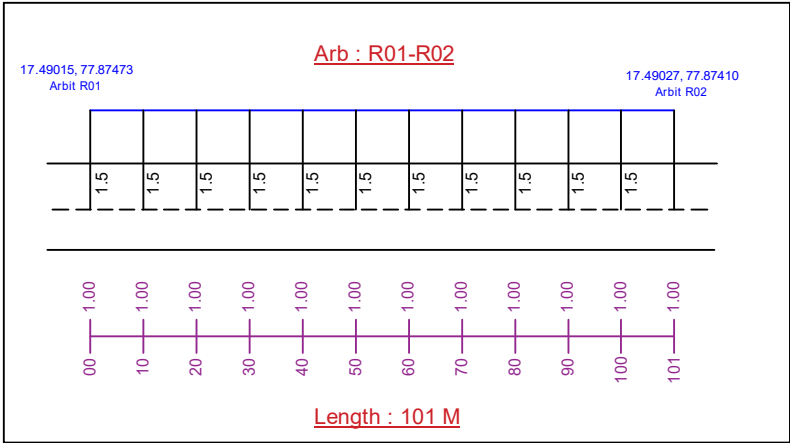

Checked	Designation	Signature


ROAD OFFSET DETAILING FOR MORANGAPALLE OHSR1 (MOMINPET)

Arb : R07-R08

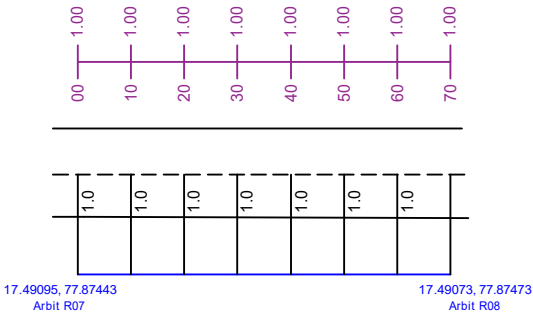


Length : 70 M

Arb : R03-R09

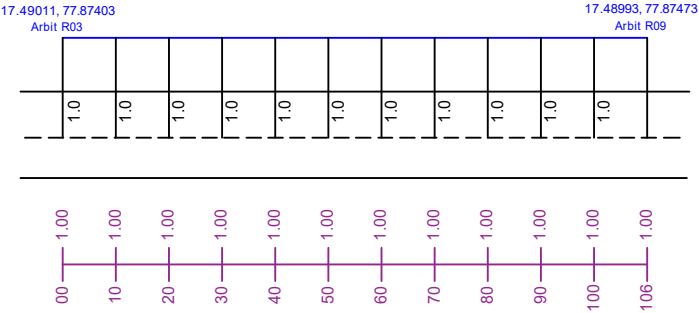


Length : 106 M

Arb : R04-R10

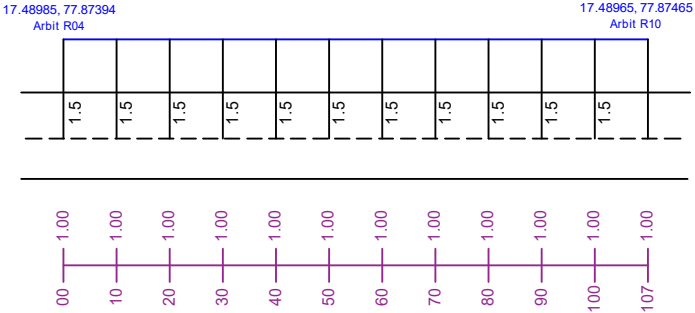

Length : 107 M

Arb : R05-R11

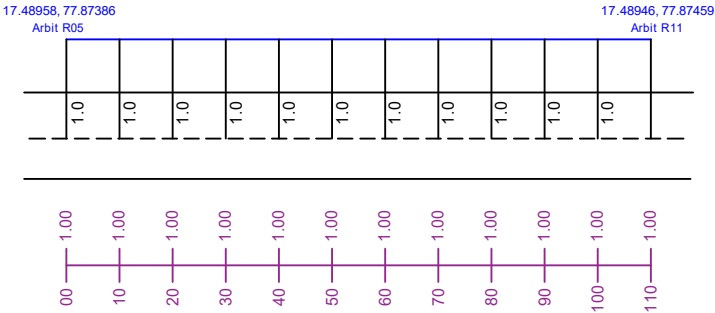


Length : 110 M


Checked	Designation	Signature

ROAD OFFSET DETAILING FOR MORANGAPALLE OHSR1 (MOMINPET)


Arb : R07-R12

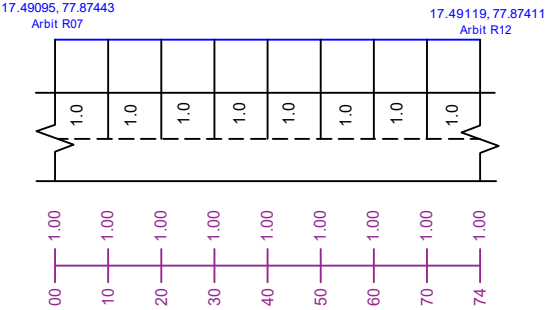


Arb : R12-R13

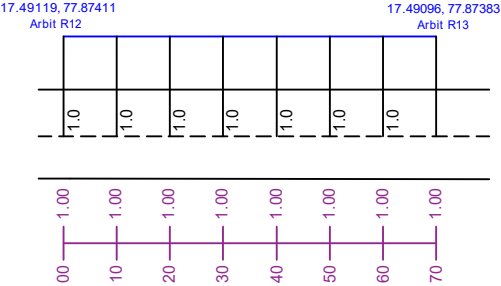


Arb : R13-R14

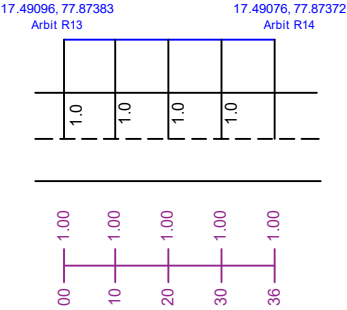


Arb : R14-R15

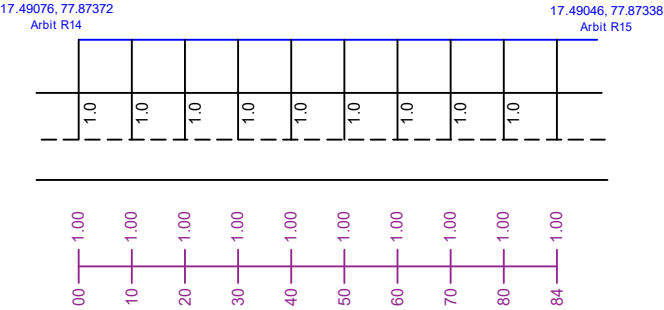

Arb : R15-R16




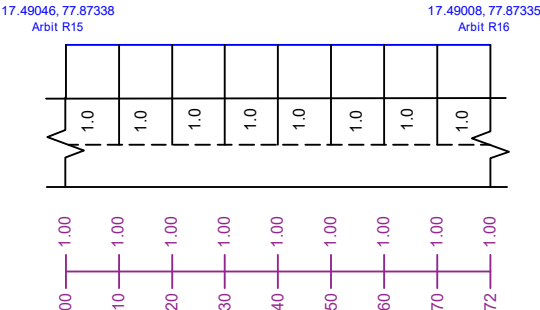


Arb : R16-R17

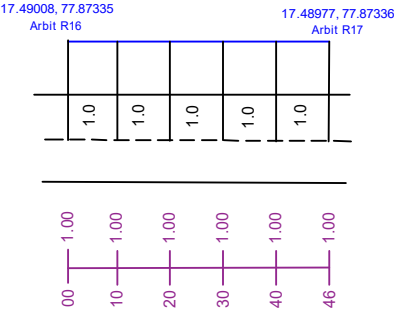

Checked	Designation	Signature


ROAD OFFSET DETAILING FOR MORANGAPALLE OHSR1 (MOMINPET)

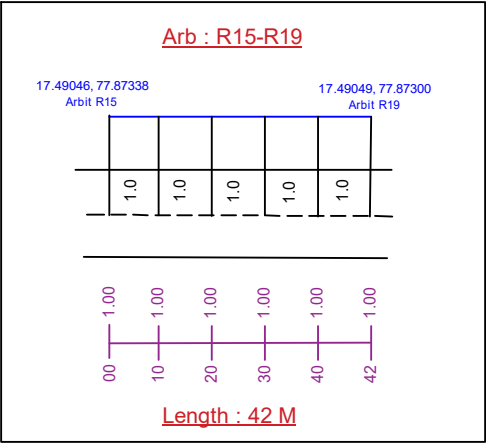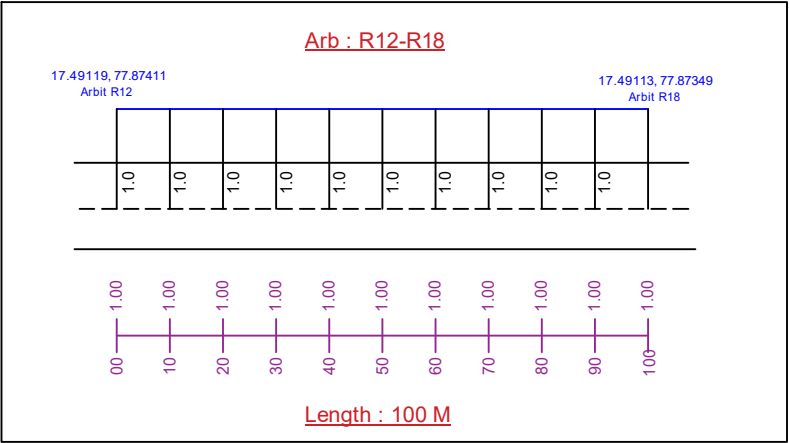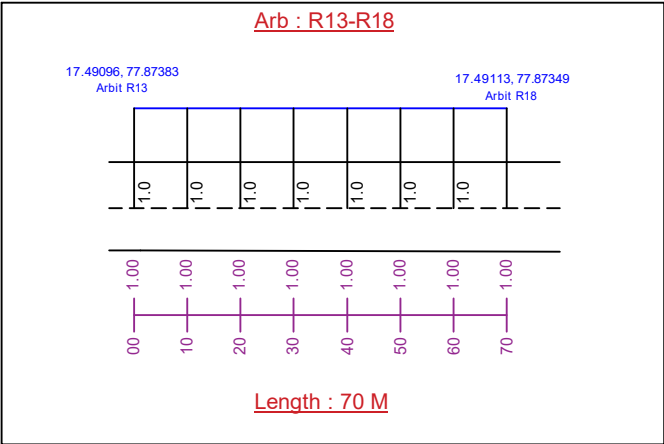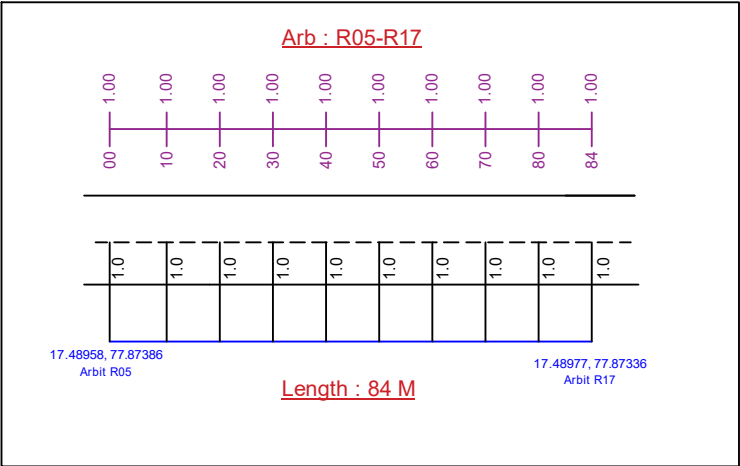

Checked	Designation	Signature


ROAD OFFSET DETAILING FOR MORANGAPALLE OHSR1 (MOMINPET)

Arb : R18-R19

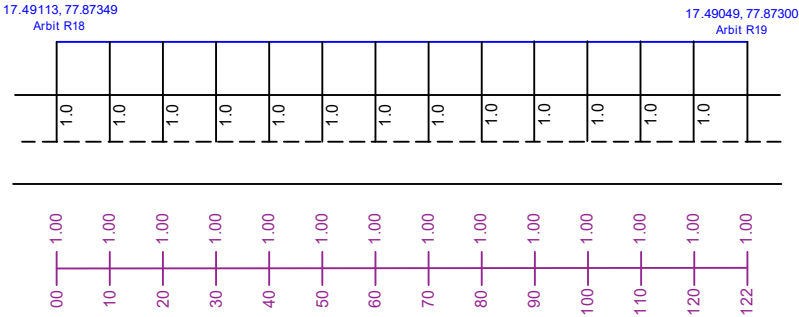


Length : 122 M

Arb : R19-R20

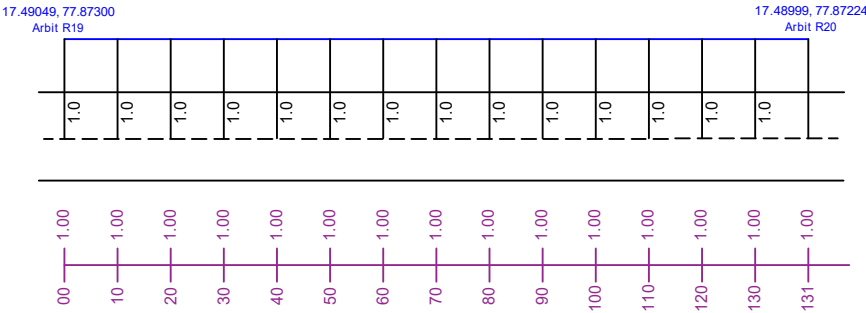


Length : 131 M

Arb : R20-R21

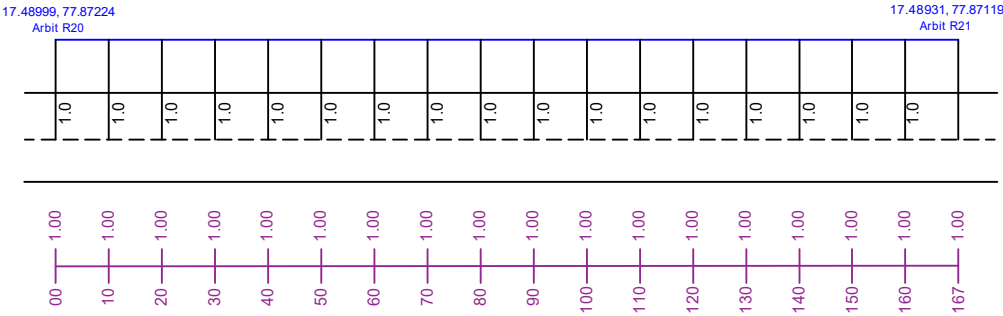

Length : 167 M

Arb : R19-R22

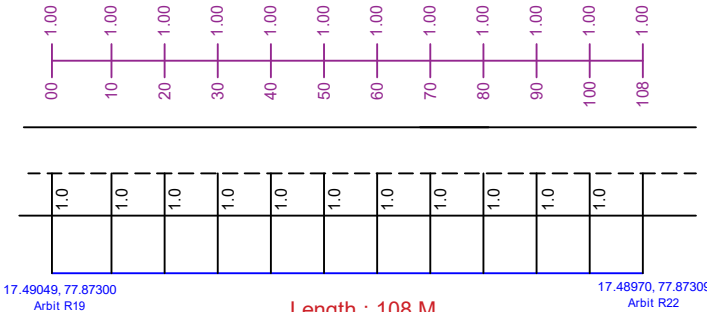


Length : 108 M

Checked	Designation	Signature

Sheet No. 05
Route Distance : 5321 M


ROAD OFFSET DETAILING FOR MORANGAPALLE OHSR1 (MOMINPET)

Arb : R17-R22

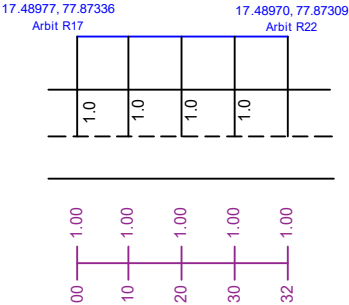


Length : 32 M

Arb : R22-R23

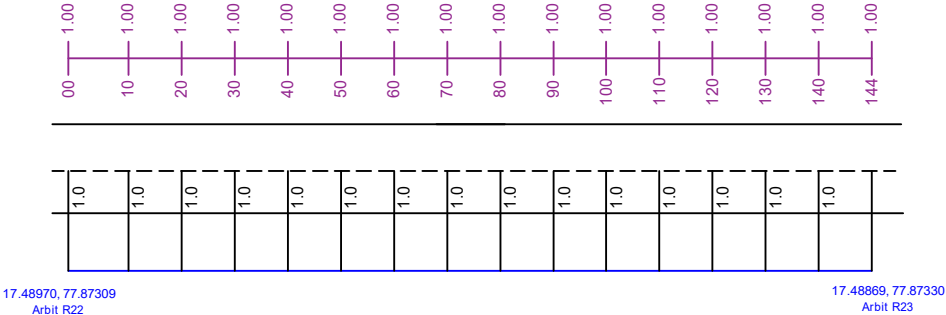


Length : 144 M

Arb : R22-R24

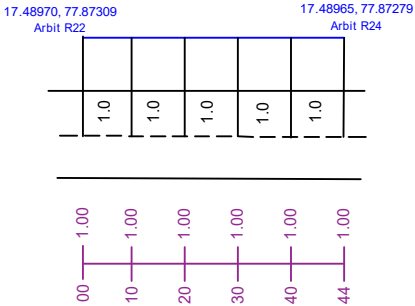

Length : 44 M

Arb : R24-R25

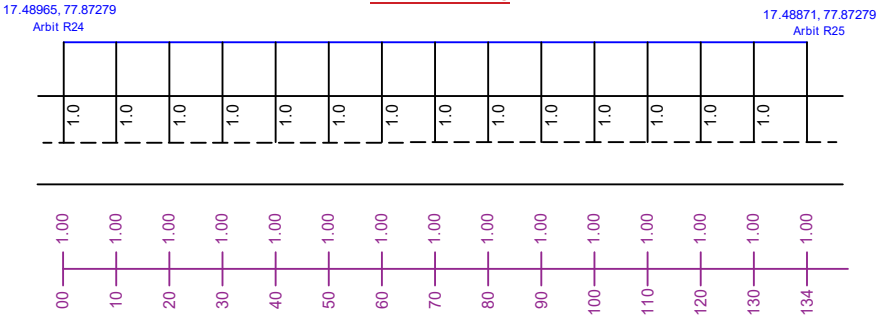


Length : 134 M


Checked	Designation	Signature

ROAD OFFSET DETAILING FOR MORANGAPALLE OHSR1 (MOMINPET)


Arb : R24-R26

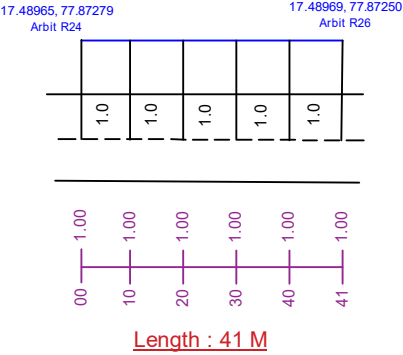


Arb : R26-R27

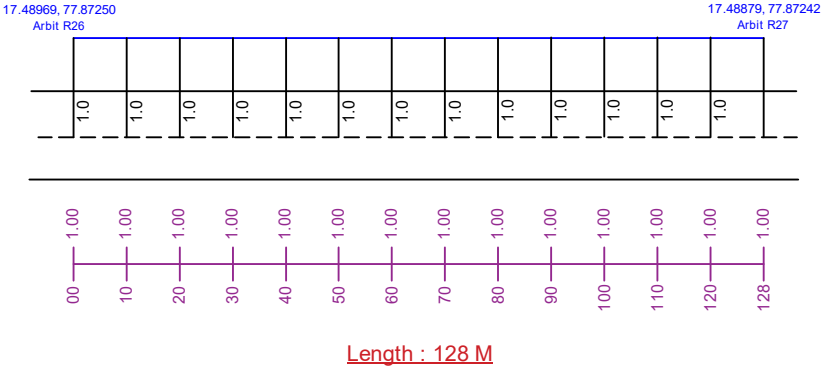


Arb : R26-R28

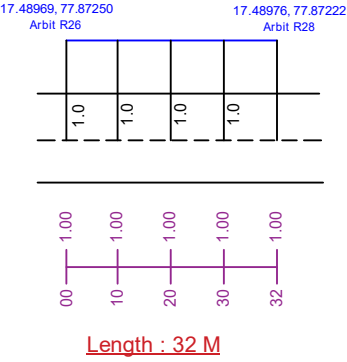

Arb : R20-R28


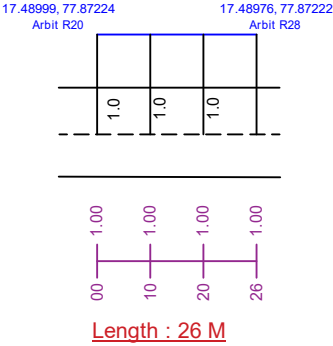


Arb : R28-R29

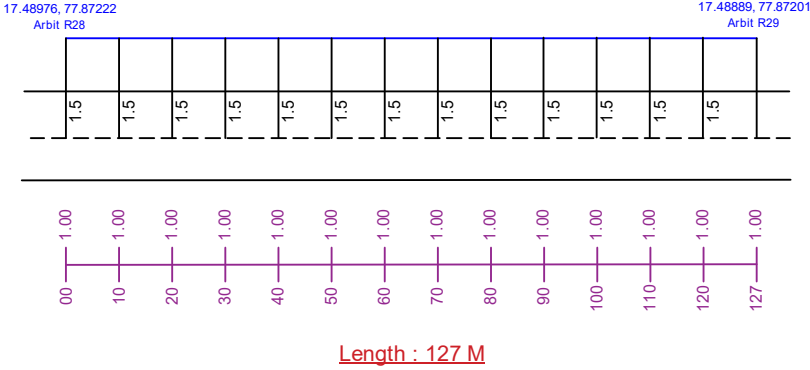



Checked	Designation	Signature



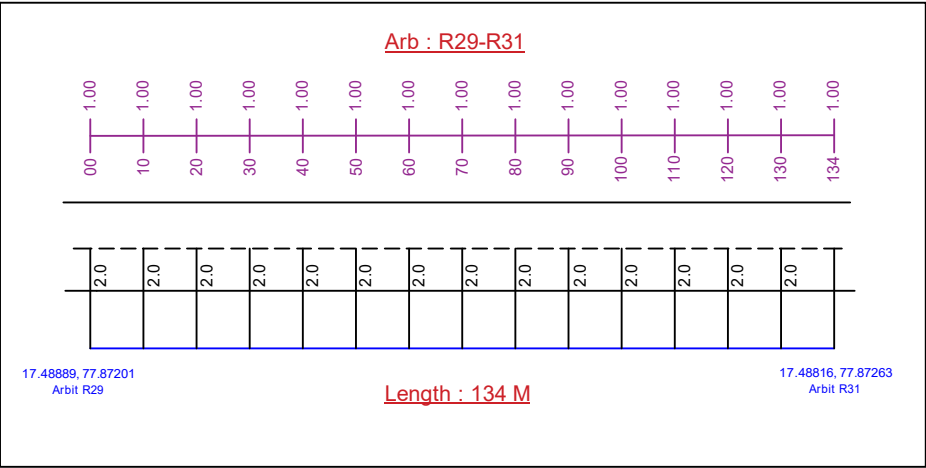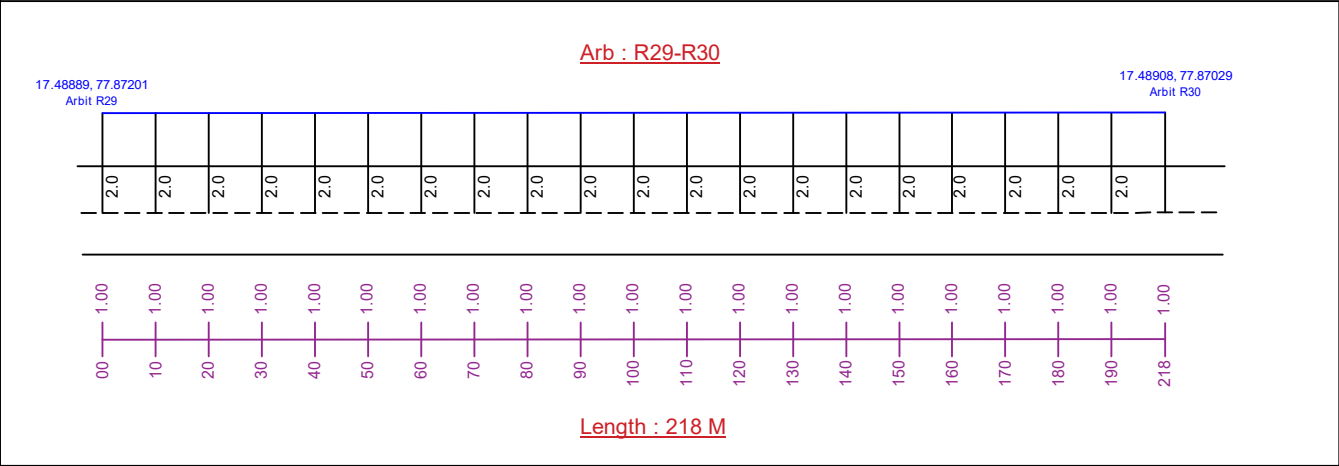



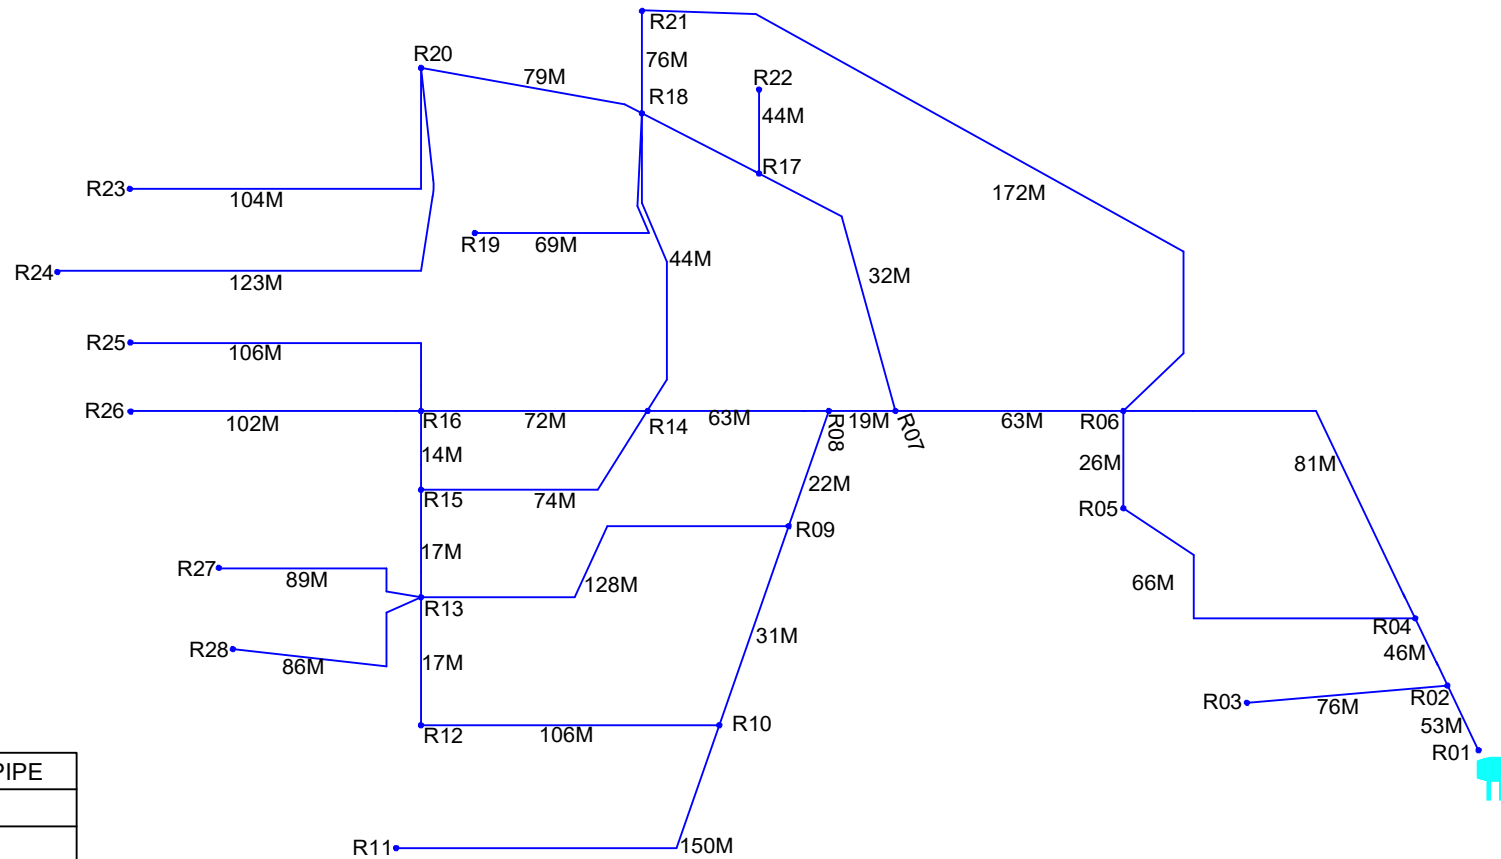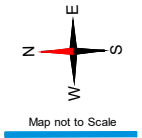

ROAD OFFSET DETAILING FOR MORANGAPALLE OHSR1 (MOMINPET)



Checked	Designation	Signature

SINGLELINE LOOP DIAGRAM FOR MORANGPALLE OHSR2 (MOMINPET)





	DUCT PIPE
	ROAD
	OHSR
	G.P OFFICE
	TEMPLE
	HOSPITAL
	SCHOOL
	DUCT GAP

Checked	Designation	Signature

Sheet No. 01
Route Distance : 5321 M

DUCTLAYING ROUTE DIAGRAM FOR MORANGPALLE OHSR2 (MOMINPET)

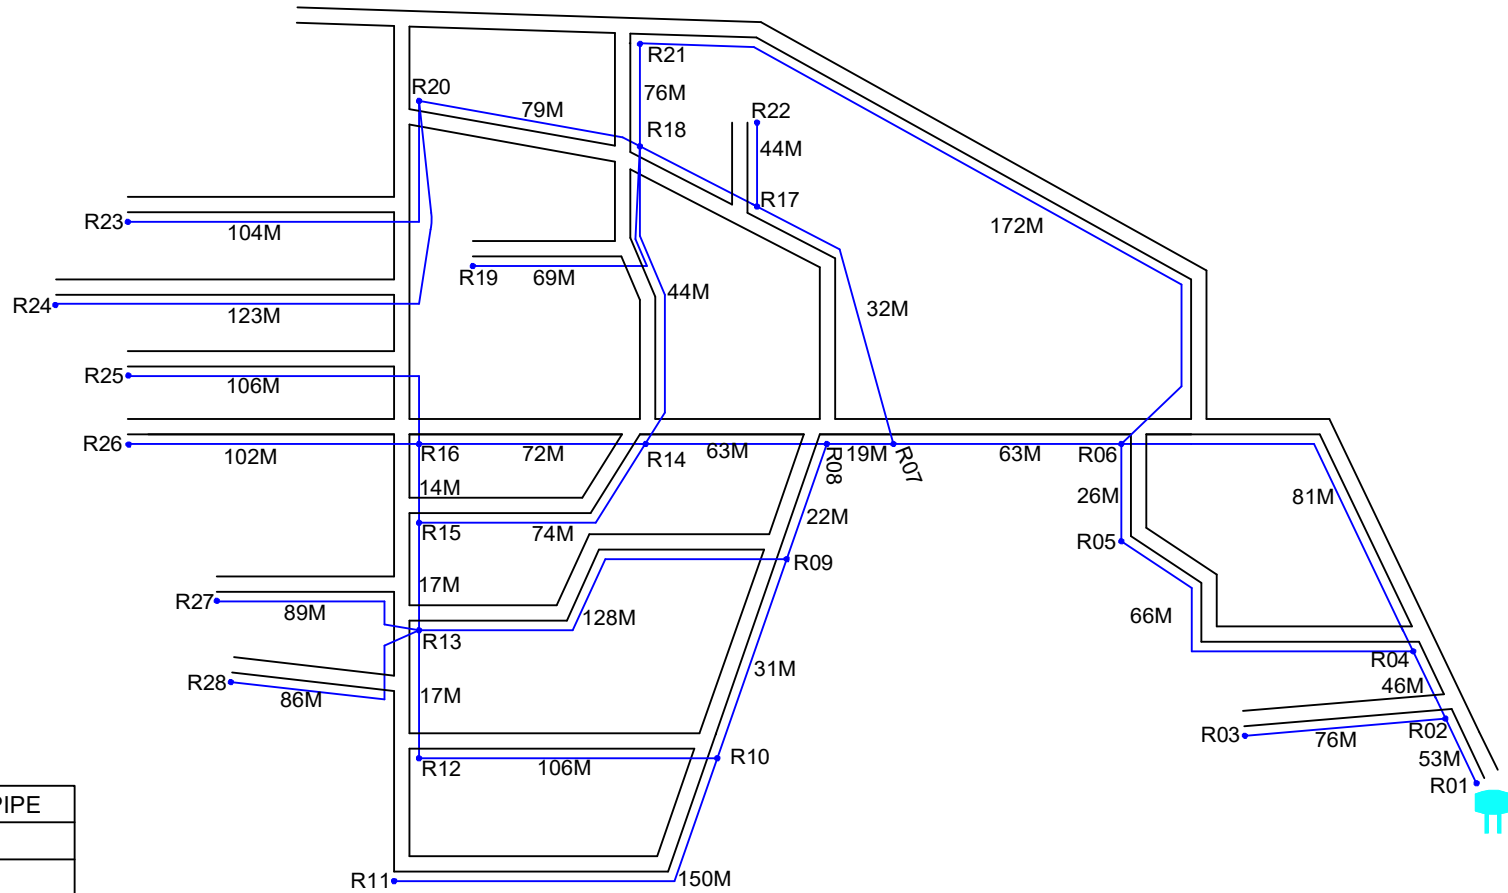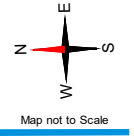


	DUCT PIPE
	ROAD
	OHHSR
	G.P. OFFICE
	TEMPLE
	HOSPITAL
	SCHOOL
	DUCT GAP

Sheet No. 01
Route Distance : 5321 M


Checked	Designation	Signature

ROAD OFFSET DETAILING FOR MORANGAPALLE OHSR2(MOMINPET)


Arb : R01-R02

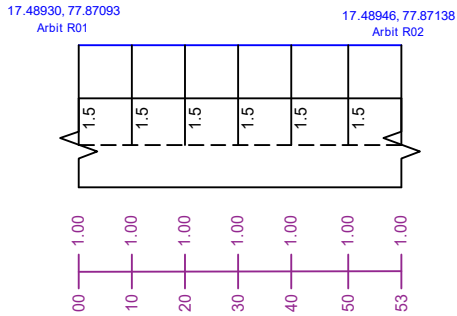


Arb : R02-R03

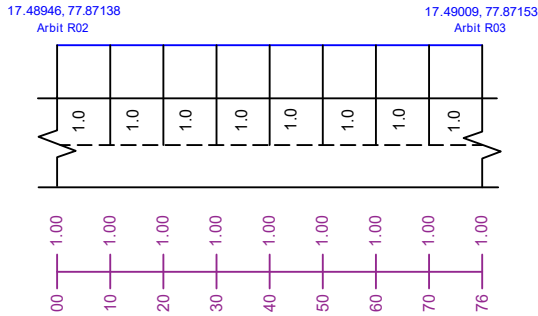

Arb : R02-R04

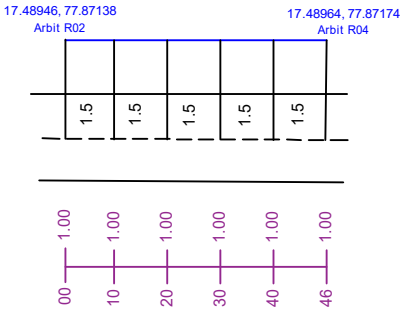


Arb : R04-R05

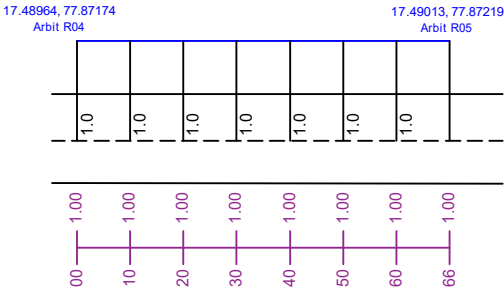


Checked	Designation	Signature

ROAD OFFSET DETAILING FOR MORANGAPALLE OHSR2(MOMINPET)


Arb : R04-R06

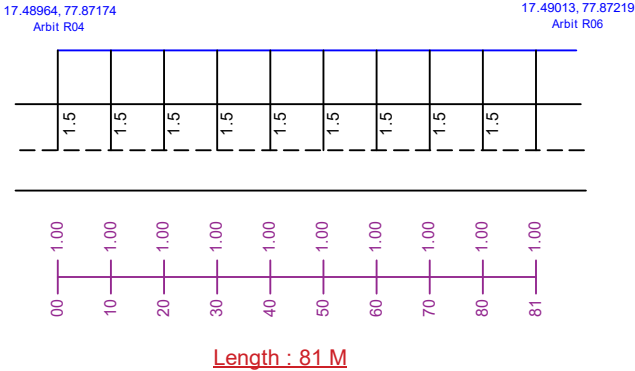


Arb : R05-R06

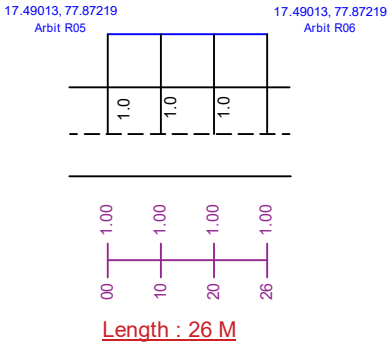


Arb : R06-R07

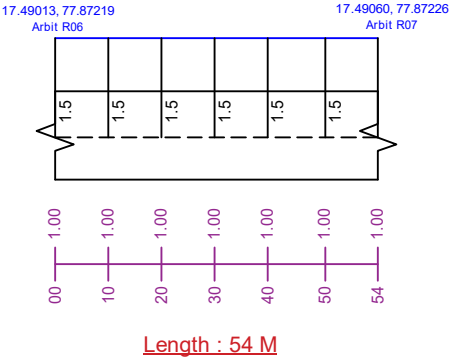


Arb : R07-R08

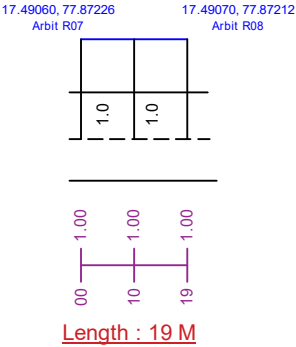

Arb : R08-R09

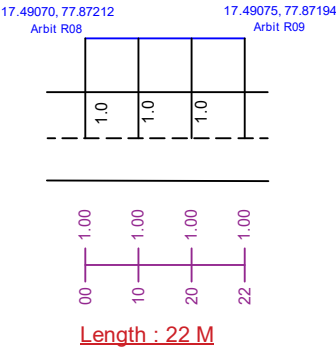


Arb : R09-R10

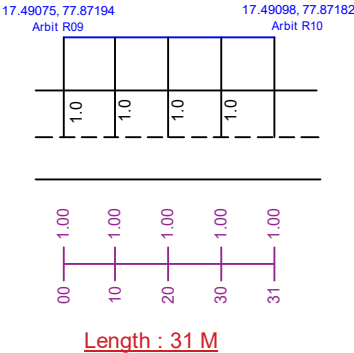

Checked	Designation	Signature


ROAD OFFSET DETAILING FOR MORANGAPALLE OHSR2(MOMINPET)

Arb : R10-R11

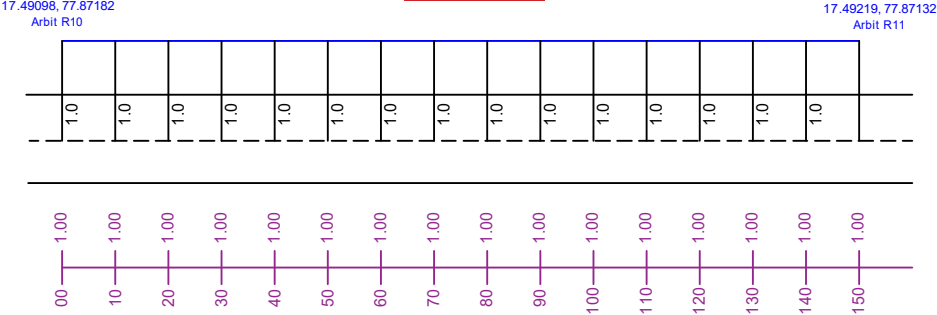


Length : 150 M

Arb : R10-R12

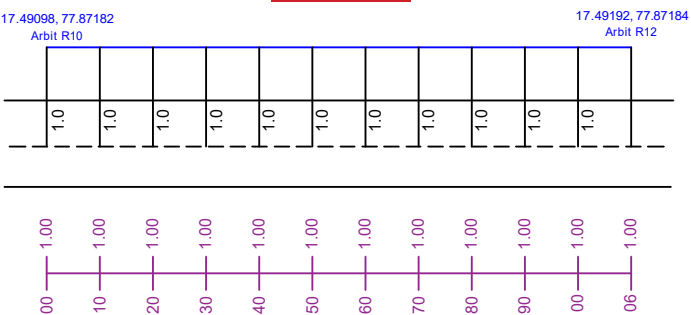


Length : 106 M

Arb : R09-R13

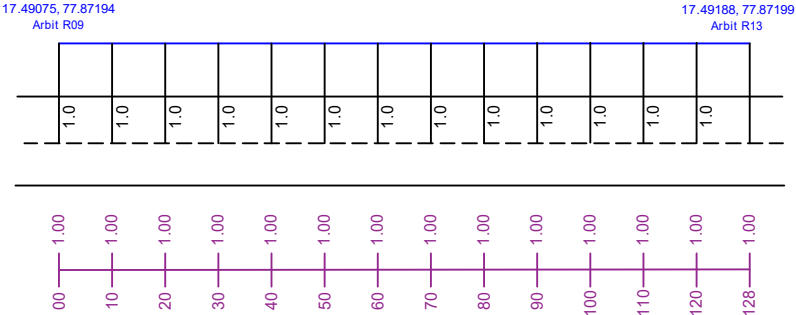

Length : 128 M

Arb : R08-R14

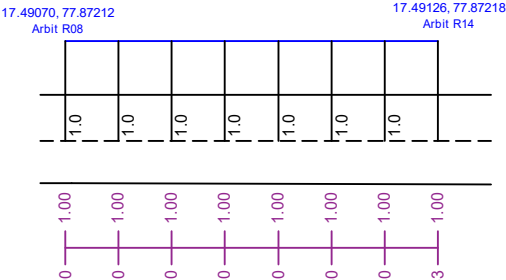


Length : 63 M


Checked	Designation	Signature

ROAD OFFSET DETAILING FOR MORANGAPALLE OHSR2(MOMINPET)


Arb : R14-R15

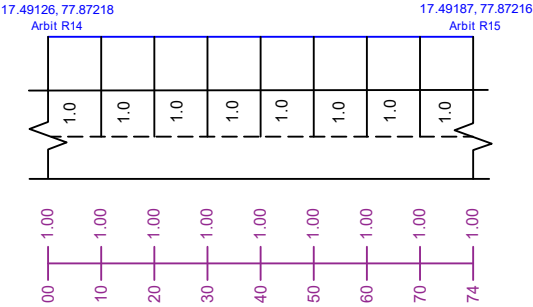


Arb : R14-R16

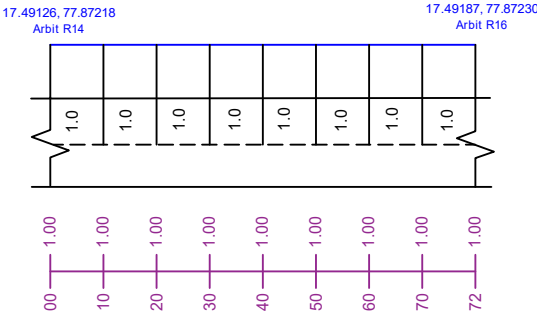


Arb : R07-R17

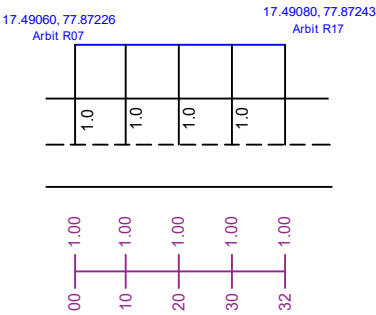


Arb : R17-R18

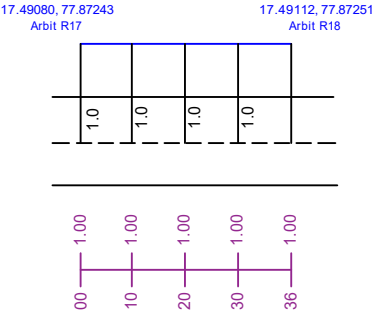

Arb : R18-R14

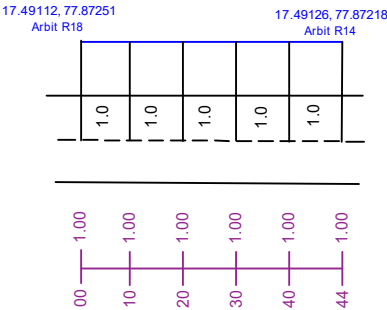


Arb : R18-R19

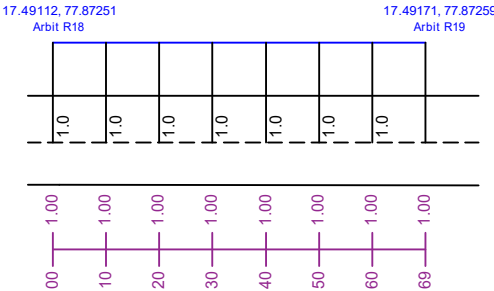

Checked	Designation	Signature


ROAD OFFSET DETAILING FOR MORANGAPALLE OHSR2(MOMINPET)

Arb : R18-R20

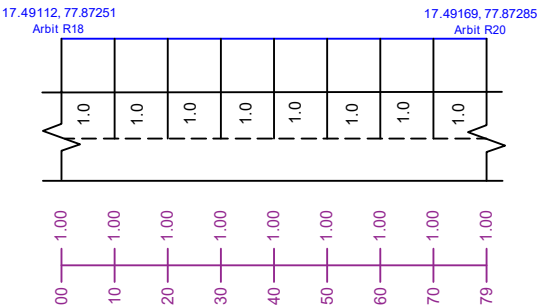


Length : 79 M

Arb : R18-R21

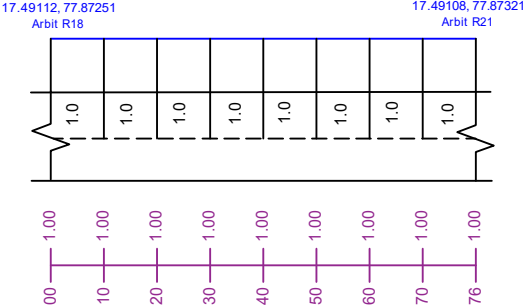


Length : 76 M

Arb : R17-R22

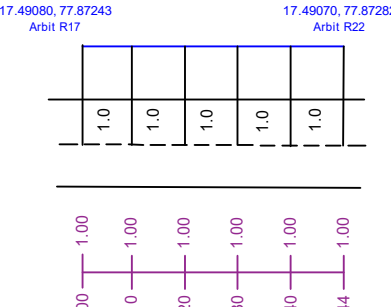


Length : 44 M

Arb : R20-R23

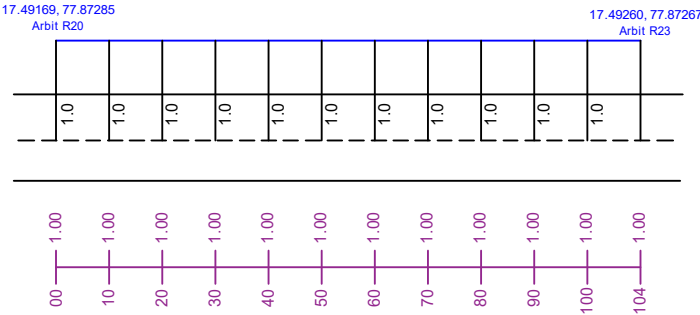

Length : 104 M

Arb : R20-R24

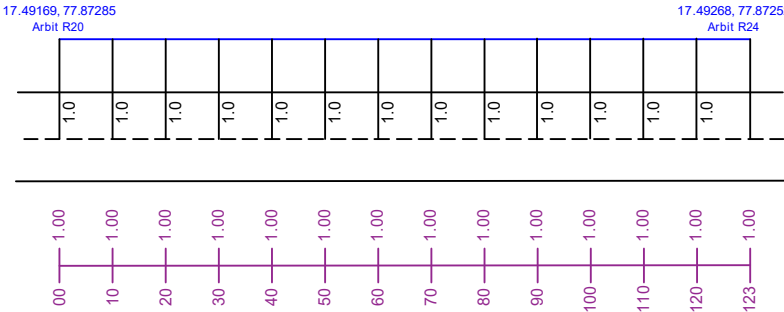


Length : 123 M

Checked	Designation	Signature


ROAD OFFSET DETAILING FOR MORANGAPALLE OHSR2(MOMINPET)

Arb : R16-R25

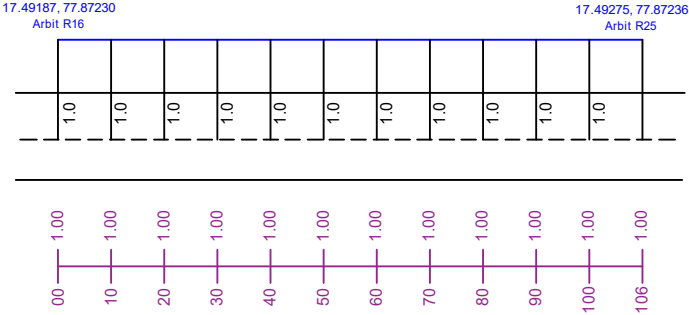


Length : 106 M

Arb : R16-R26

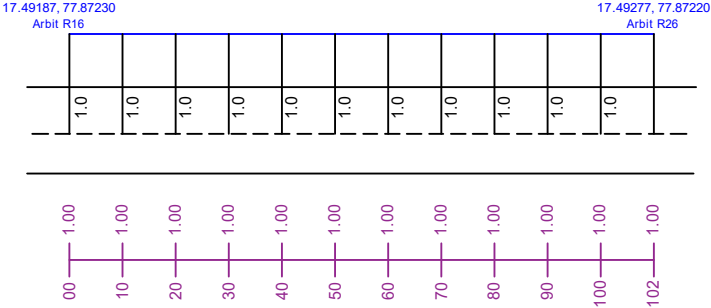


Length : 102 M

Arb : R13-R27

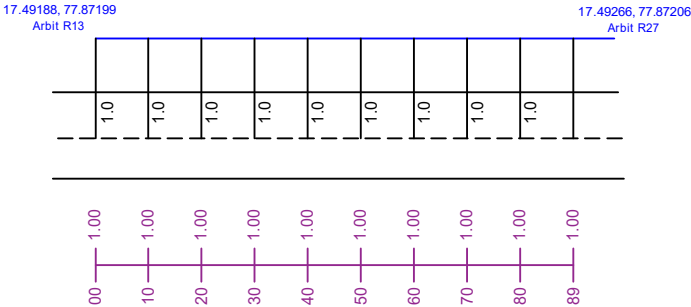

Length : 89 M

Arb : R19-R28

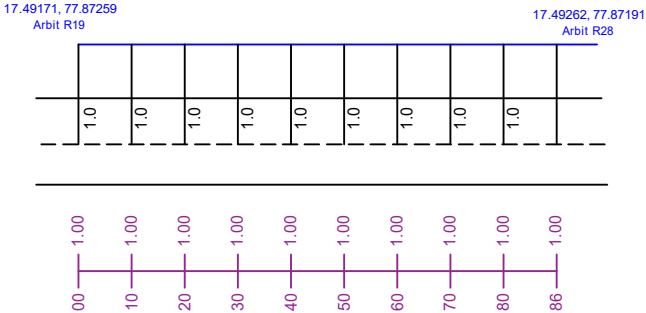


Length : 86 M

Checked	Designation	Signature

ROAD OFFSET DETAILING FOR MORANGAPALLE OHSR2(MOMINPET)

Arb : R12-R13

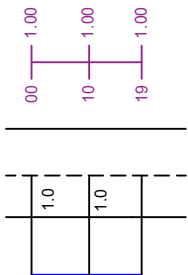


17.49192, 77.87184
Arbit R12

17.49188, 77.87199
Arbit R13

Length : 17 M

Arb : R13-R15

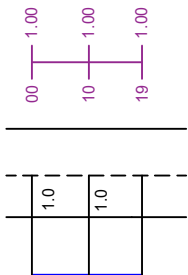


17.49188, 77.87199
Arbit R13

17.49187, 77.87216
Arbit R15

Length : 18 M

Arb : R15-R16

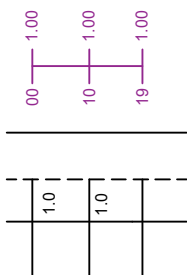


17.49187, 77.87216
Arbit R15

17.49187, 77.87230
Arbit R16

Length : 14 M

Arb : R06-R21

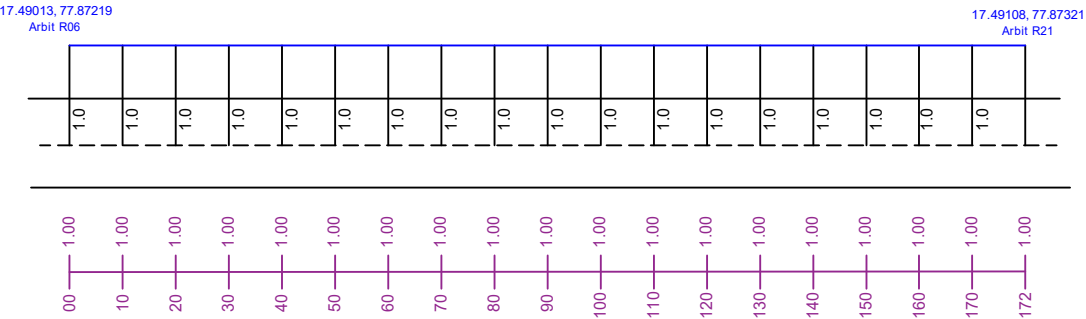

17.49013, 77.87219
Arbit R06

17.49108, 77.87321
Arbit R21

Length : 172 M

Checked	Designation	Signature



TELANGANA FIBER GRID

TELANGANA FIBER GRID

ITE & C GOVERNMENT OF TELANGANA

7th Floor, Splendid Towers, S.P. Road

Opp: Begumpet Police Station,



Begumpet, Hyderabad-500016.







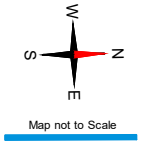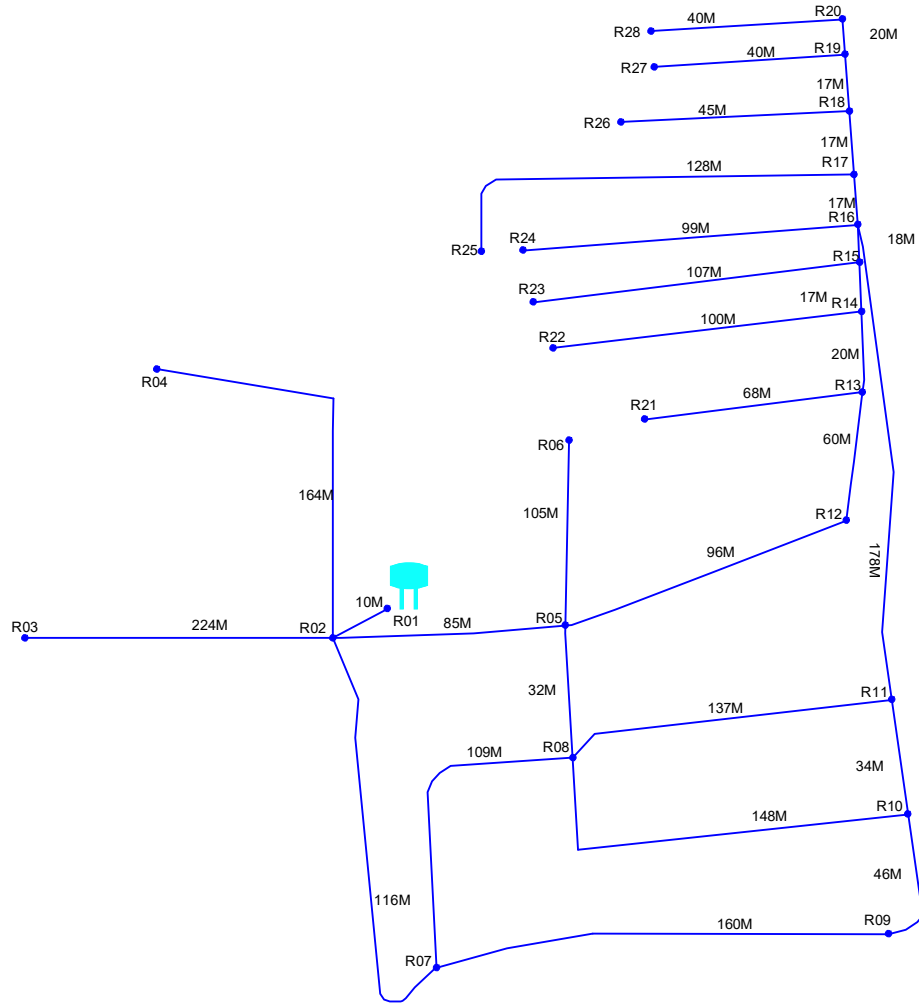

AS - BUILT DRAWINGS (ABD)

NEW KOLKONDA

(MOMINPET MANDAL-VIKARABAD DIST.)

SINGLELINE LOOP DIAGRAM FOR NEW KOLKONDA OHSR1 (MOMINPET)





	DUCT PIPE
	ROAD
	OHSR
	G.P. OFFICE
	TEMPLE
	HOSPITAL
	SCHOOL
	DUCT GAP

Sheet No. 01
Route Distance : 3131 M

Checked	Designation	Signature

DUCTLAYING ROUTE DIAGRAM FOR NEW KOLKONDA OHSR1 (MOMINPET)

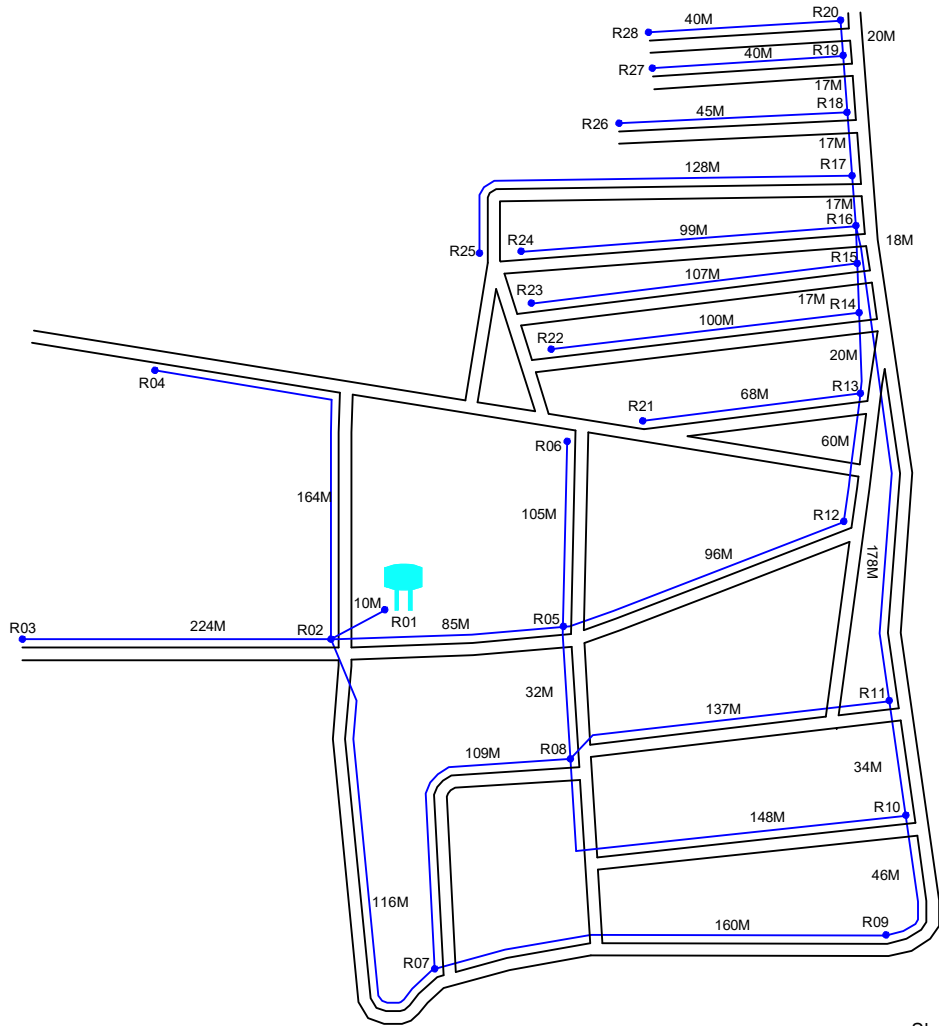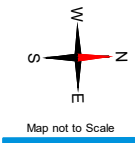


	DUCT PIPE
	ROAD
	OHSR
	G.P OFFICE
	TEMPLE
	HOSPITAL
	SCHOOL
	DUCT GAP

Sheet No. 01
Route Distance : 3131 M

Checked	Designation	Signature


ROAD OFFSET DETAILING FOR NEW KOLKONDA OHSR1 (MOMINPET)

Arb : R01-R02

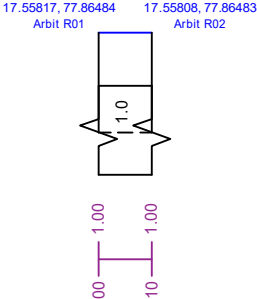


Length : 10 M

Arb : R02-R03

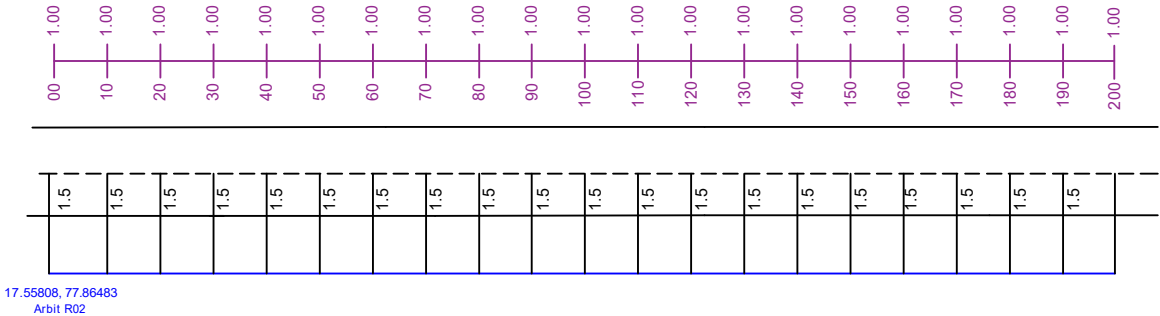


Length : 224 M

Arb : R02-R03

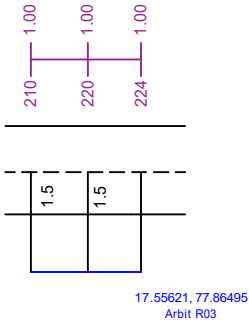


Length : 224 M

Arb : R02-R04

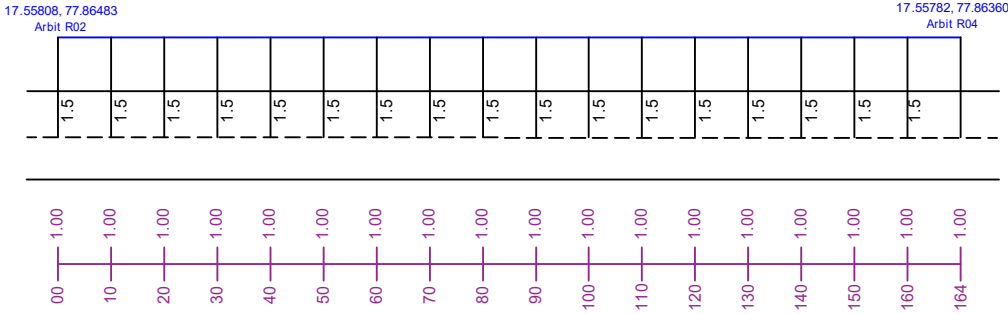

Length : 164 M

Arb : R02-R05




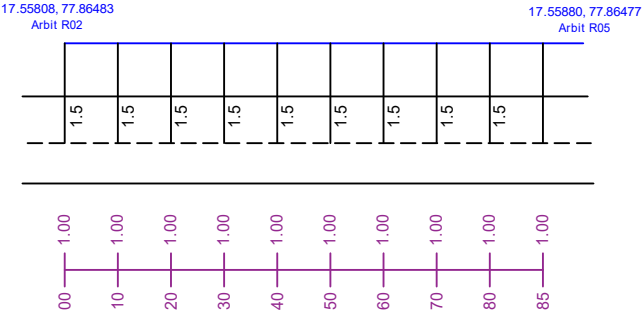


Length : 85 M

Sheet No. 01
Route Distance : 3131 M

Checked	Designation	Signature


ROAD OFFSET DETAILING FOR NEW KOLKONDA OHSR1 (MOMINPET)

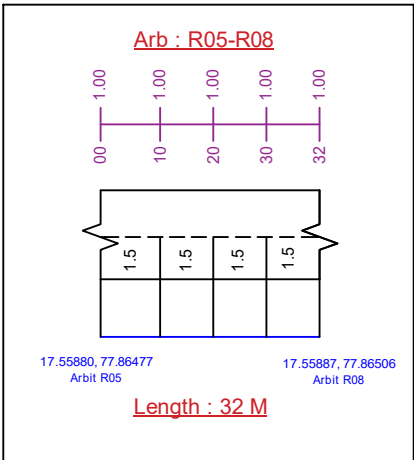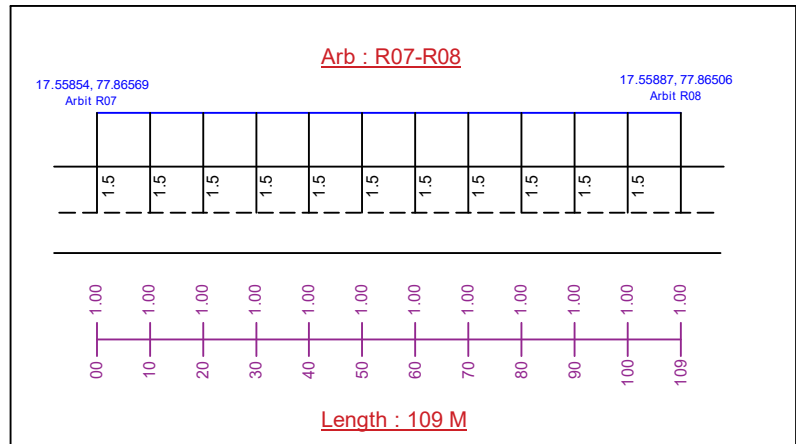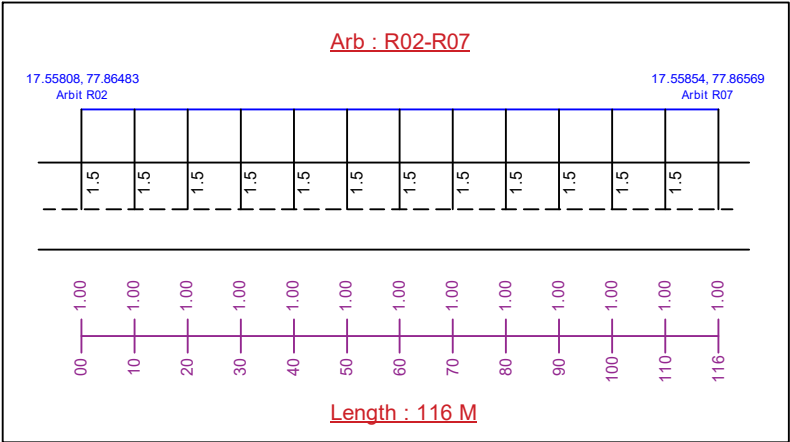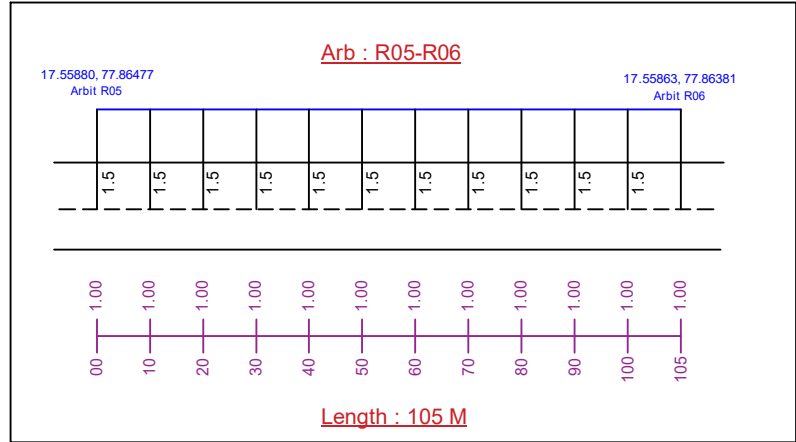


Checked	Designation	Signature

ROAD OFFSET DETAILING FOR NEW KOLKONDA OHSR1 (MOMINPET)


Arb : R07-R09

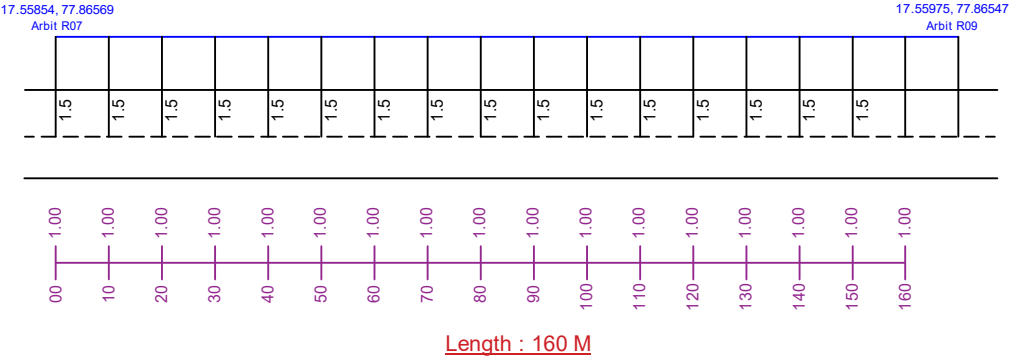

Arb : R08-R10




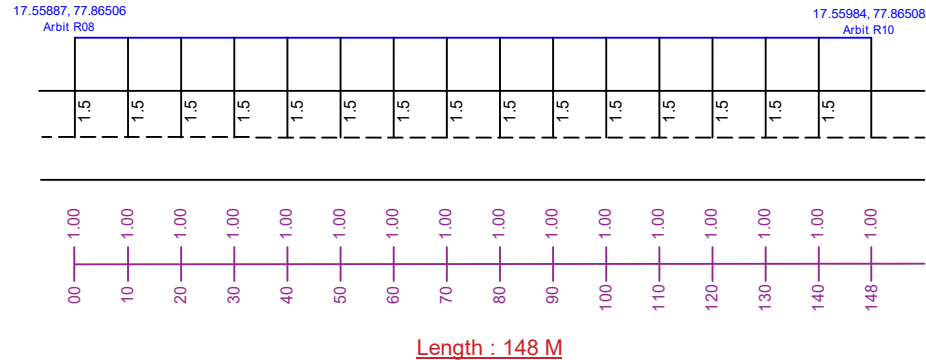


Arb : R08-R11

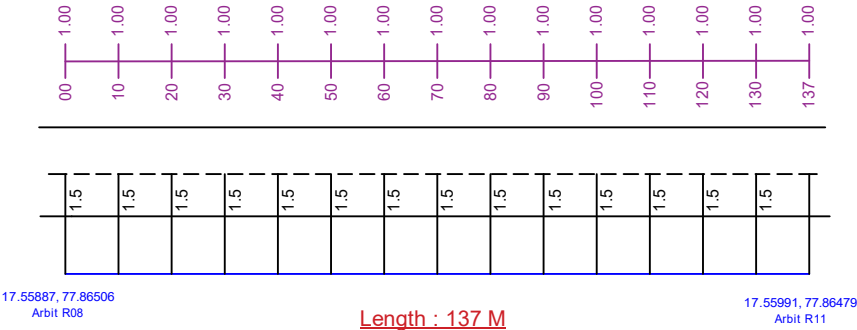

Checked	Designation	Signature


ROAD OFFSET DETAILING FOR NEW KOLKONDA OHSR1 (MOMINPET)

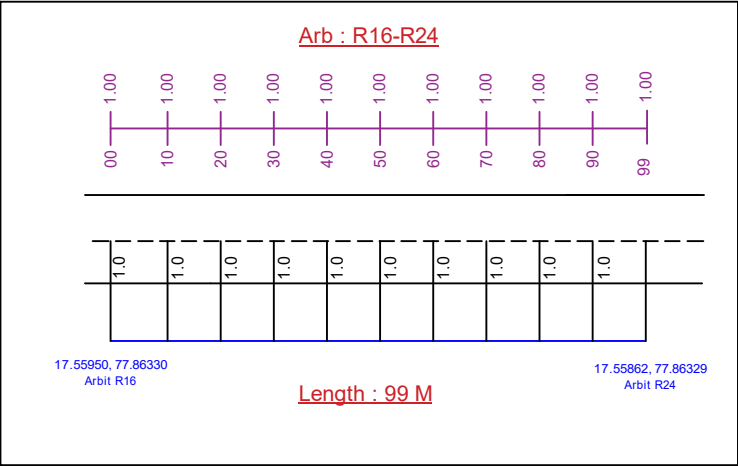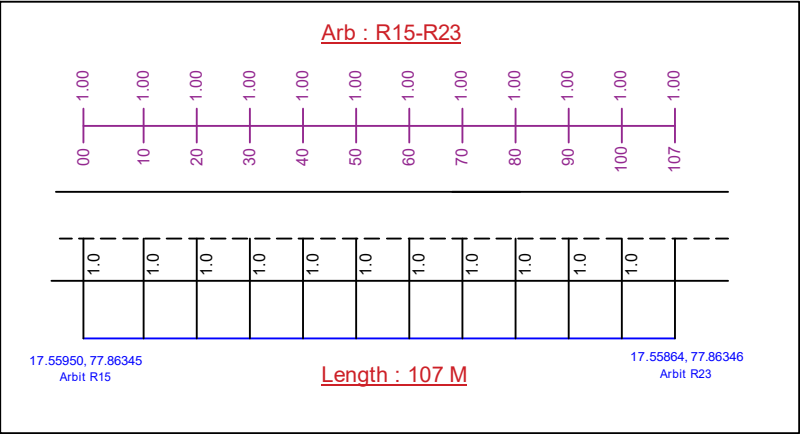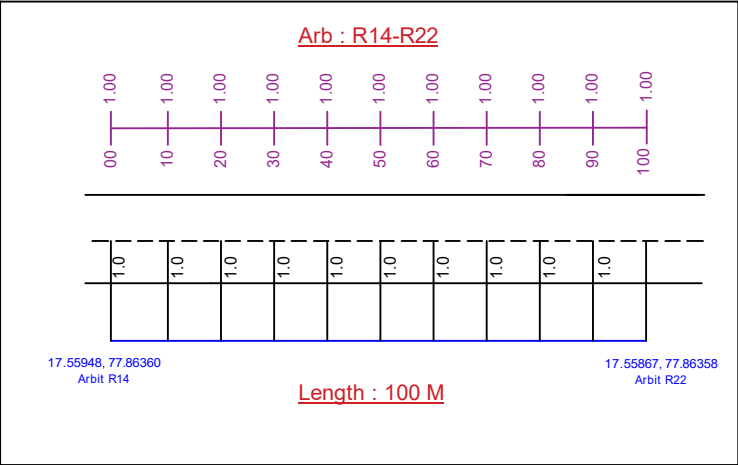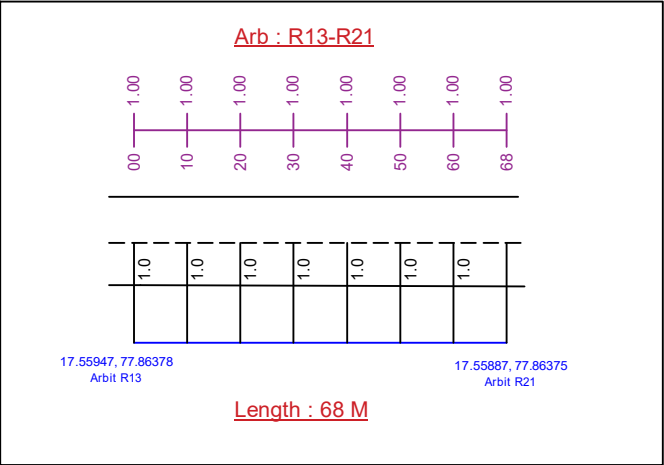


Checked	Designation	Signature

ROAD OFFSET DETAILING FOR NEW KOLKONDA OHSR1 (MOMINPET)


Arb : R17-R25

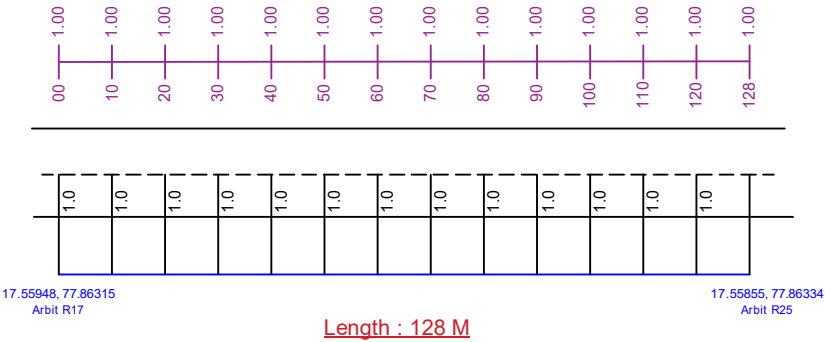


Arb : R18-R26

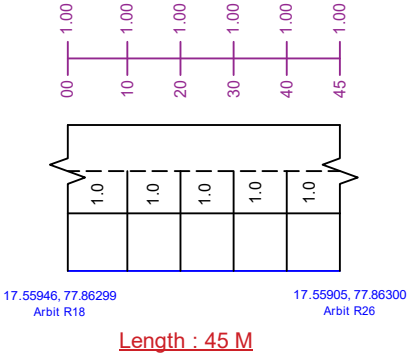


Arb : R19-R27

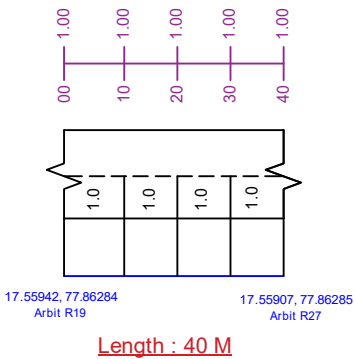


Arb : R20-R28

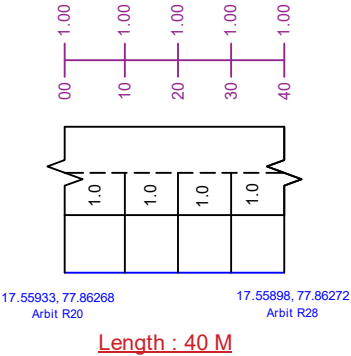

Arb : R09-R10

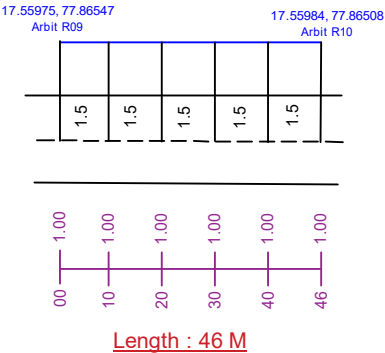


Arb : R10-R11

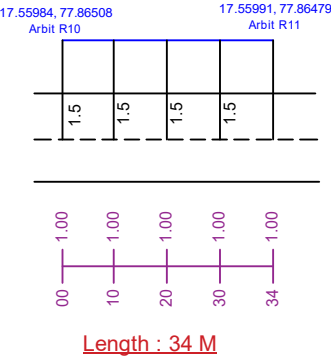

Checked	Designation	Signature

ROAD OFFSET DETAILING FOR NEW KOLKONDA OHSR1 (MOMINPET)

Arb : R11-R16


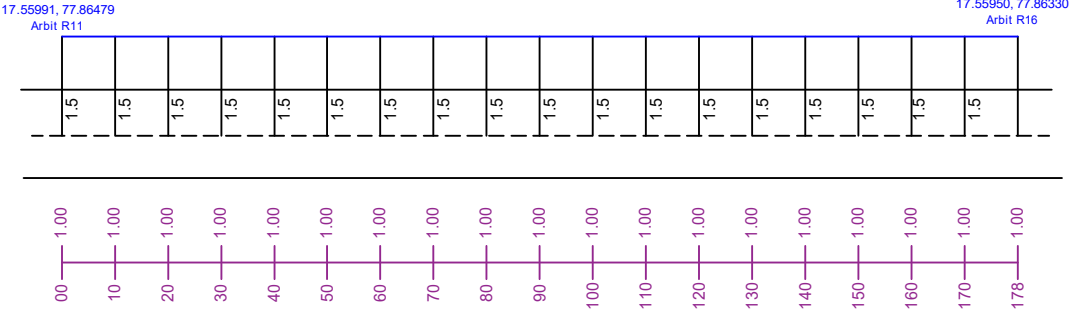


Length : 178 M

Sheet No. 07
Route Distance : 3131 M

Checked	Designation	Signature

SINGLELINE LOOP DIAGRAM FOR NEW KOLKONDA OHSR2 (MOMINPET)

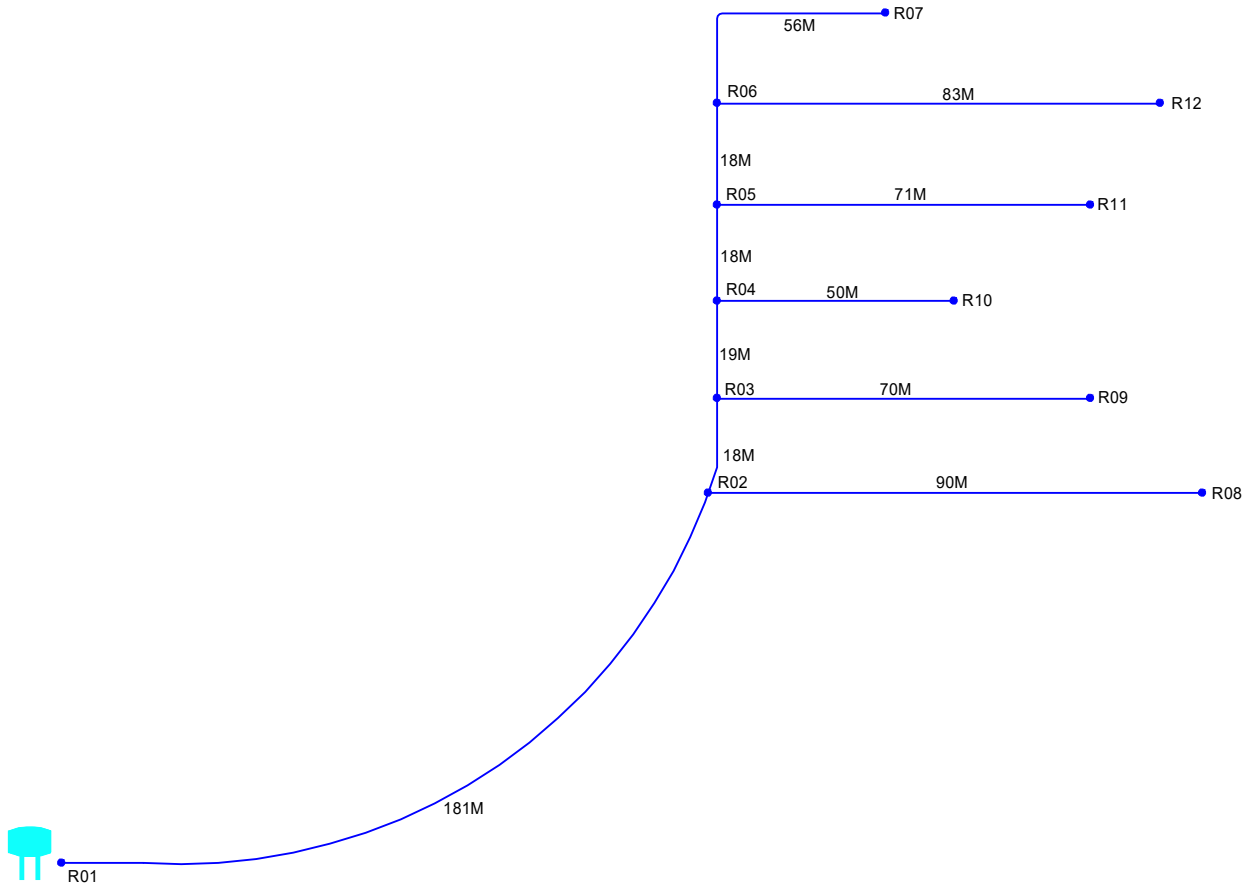
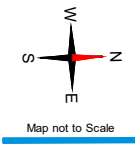


	DUCT PIPE
	ROAD
	OHSR
	G.P OFFICE
	TEMPLE
	HOSPITAL
	SCHOOL
	DUCT GAP

Sheet No. 01
Route Distance : 3131 M

Checked	Designation	Signature

DUCTLAYING ROUTE DIAGRAM FOR NEW KOLKONDA OHSR2 (MOMINPET)

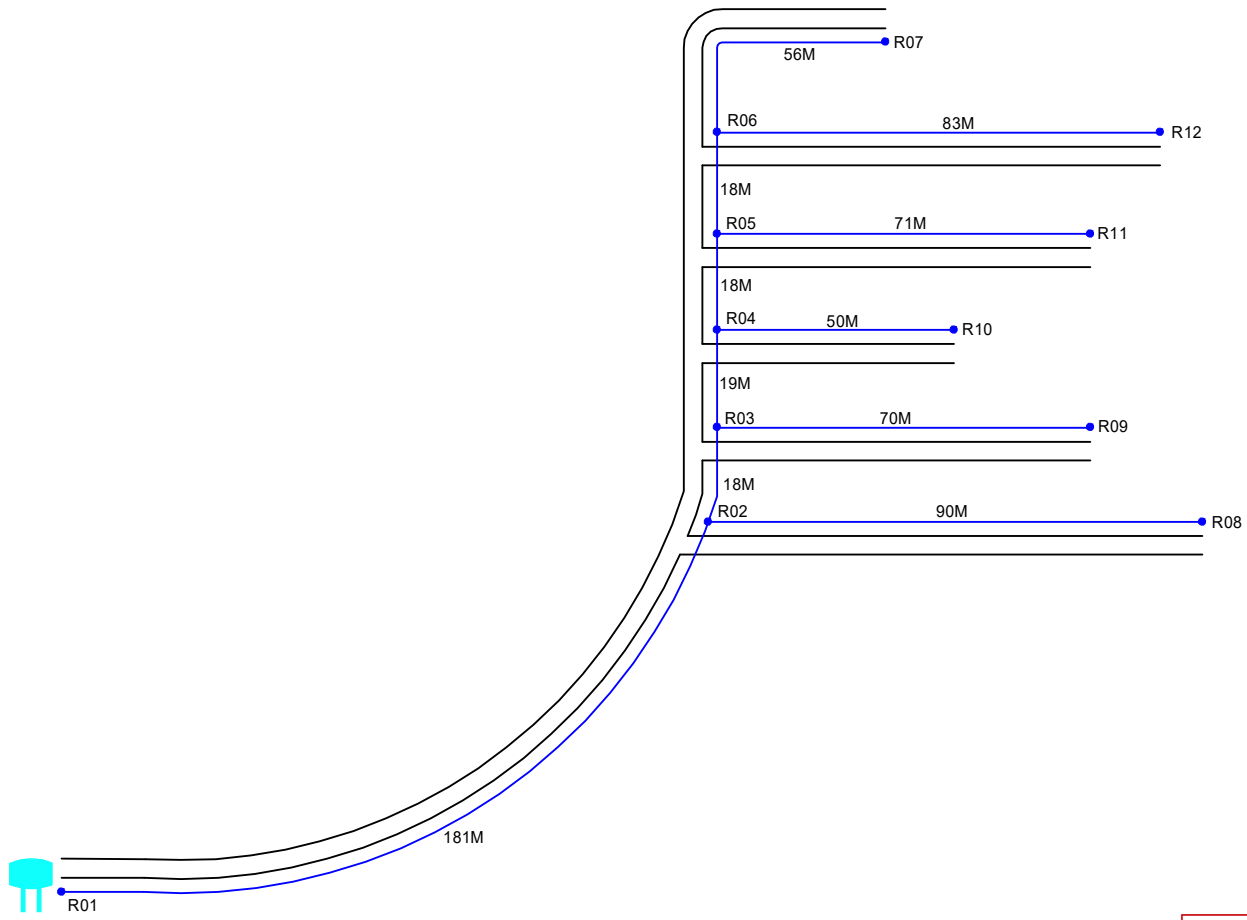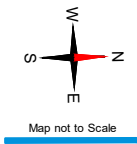


	DUCT PIPE
	ROAD
	OHSR
	G.P OFFICE
	TEMPLE
	HOSPITAL
	SCHOOL
	DUCT GAP

Sheet No. 01
Route Distance : 3131 M


Checked	Designation	Signature

ROAD OFFSET DETAILING FOR NEW KOLKONDA OHSR2 (MOMINPET)


Arb : R01-R02

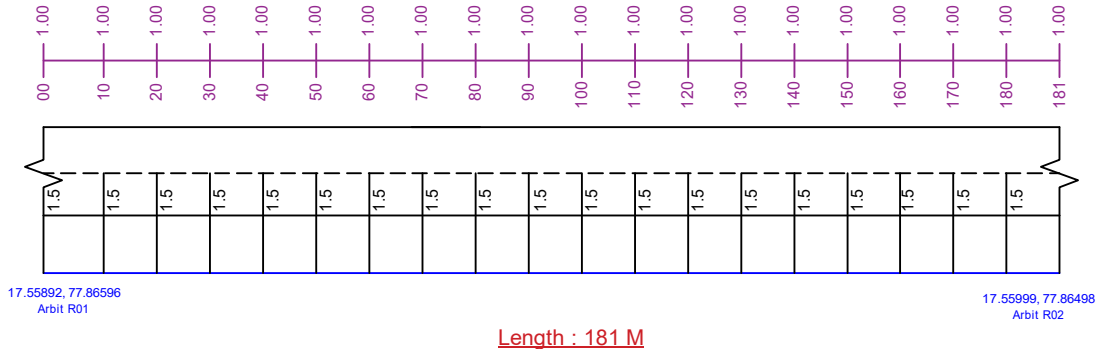


Arb : R02-R03

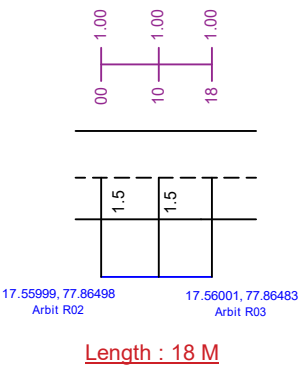


Arb : R03-R04

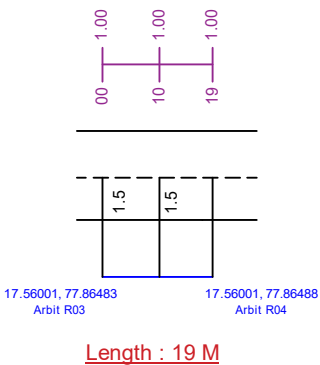


Arb : R04-R05

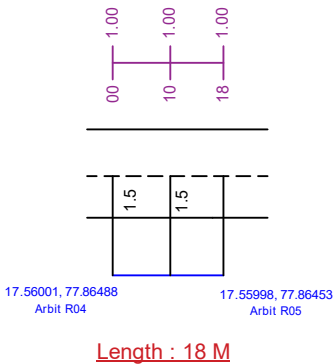

Arb : R05-R06

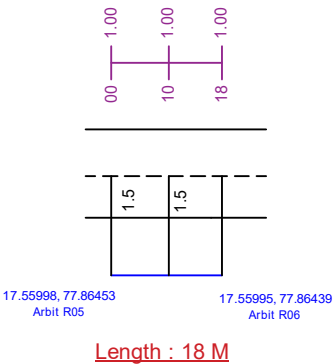


Arb : R06-R07

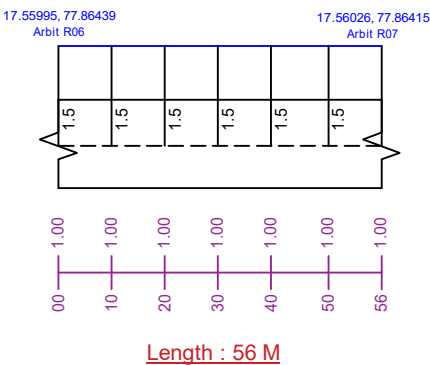

Checked	Designation	Signature


ROAD OFFSET DETAILING FOR NEW KOLKONDA OHSR2 (MOMINPET)

Arb : R02-R08

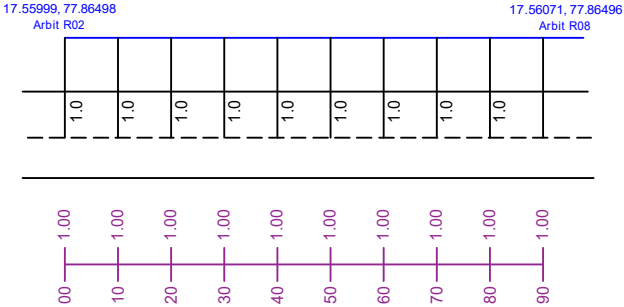


Length : 90 M

Arb : R03-R09

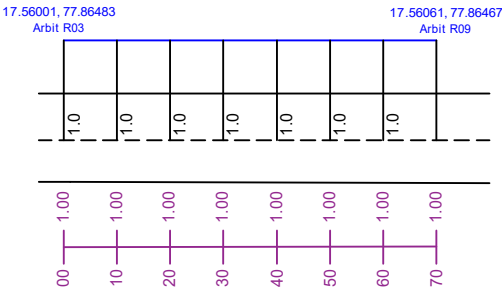


Length : 70 M

Arb : R04-R10

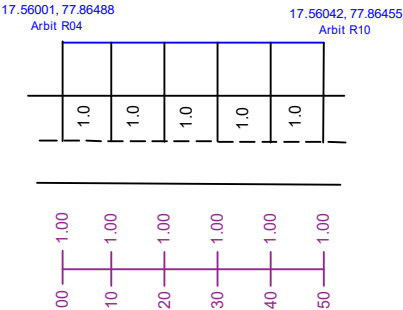


Length : 50 M

Arb : R05-R11

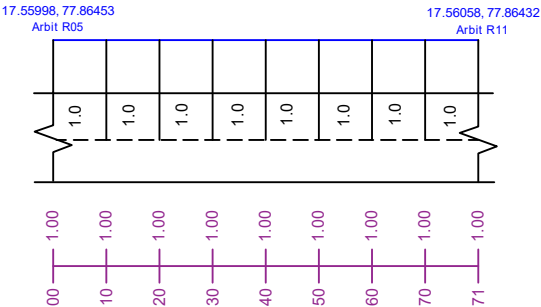

Length : 71 M

Arb : R06-R12

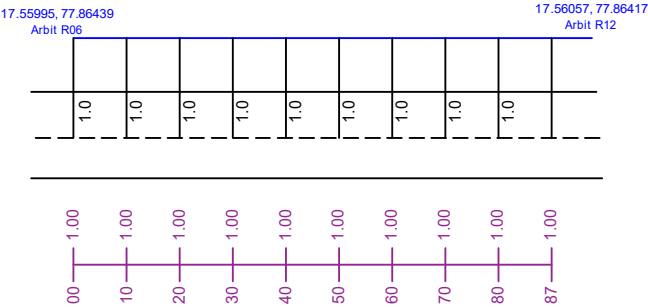

Length : 83 M

Checked	Designation	Signature



TELANGANA FIBER GRID

TELANGANA FIBER GRID

ITE & C GOVERNMENT OF TELANGANA

7th Floor, Splendid Towers, S.P. Road

Opp: Begumpet Police Station,



Begumpet, Hyderabad-500016.


 






AS - BUILT DRAWINGS (ABD)

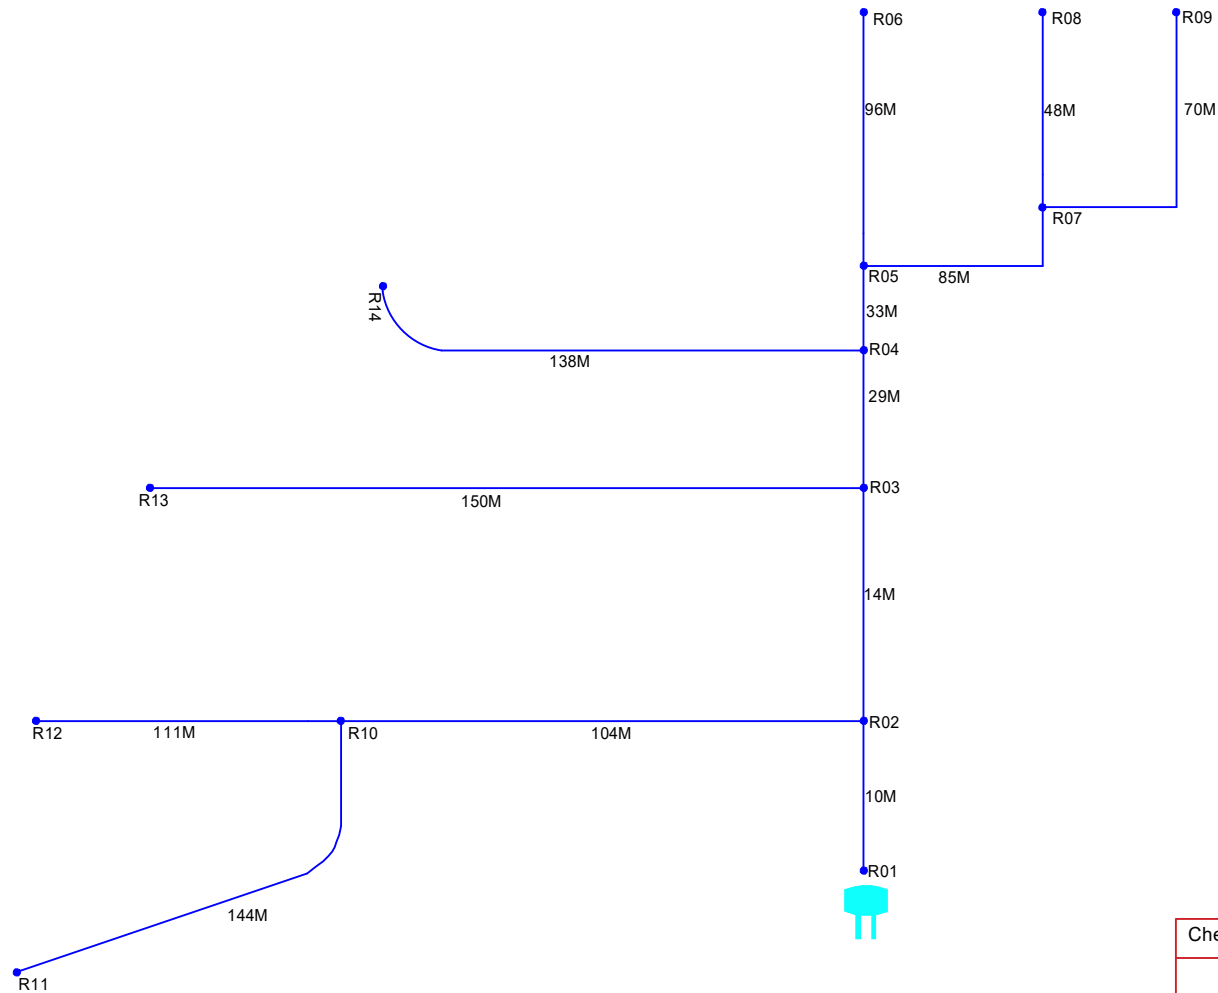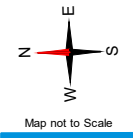RAVULAPALLE

(MOMINPET MANDAL-VIKARABAD DIST.)

SINGLELINE LOOP DIAGRAM FOR RAVULAPALLE (MOMINPET)











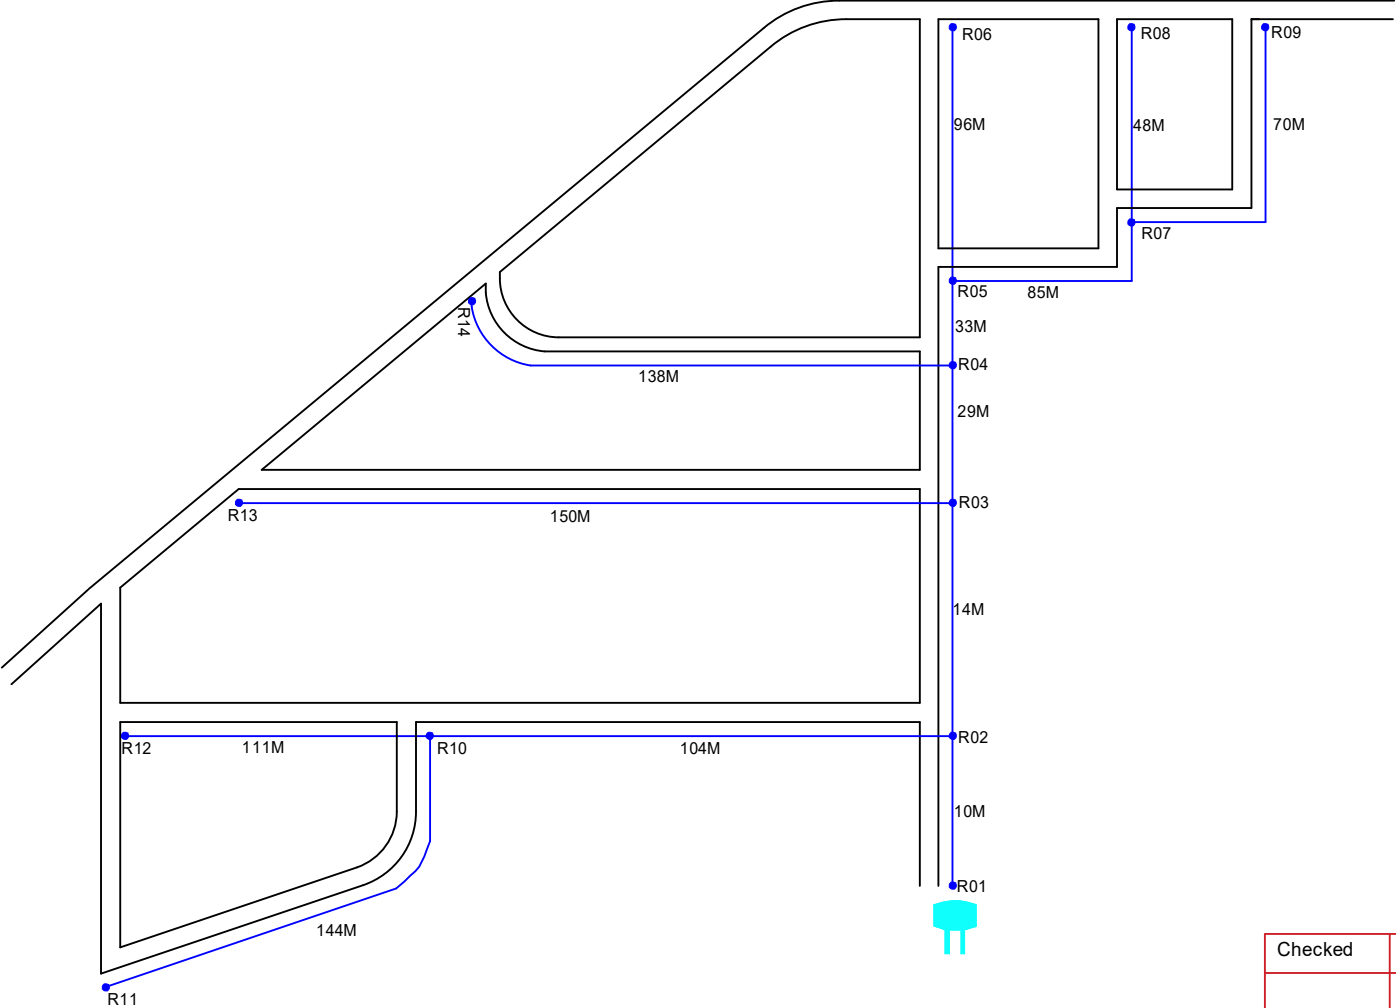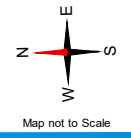

	DUCT PIPE
	ROAD
	OHSR
	G.P OFFICE
	TEMPLE
	HOSPITAL
	SCHOOL
	DUCT GAP

Sheet No. 01
Route Distance : 1102 M

Checked	Designation	Signature

DUCTLAYING ROUTE DIAGRAM FOR RAVULAPALLE (MOMINPET)




	DUCT PIPE
	ROAD
	OHSR
	G.P OFFICE
	TEMPLE
	HOSPITAL
	SCHOOL
	DUCT GAP

Sheet No. 01
Route Distance : 1102 M

Checked	Designation	Signature


ROAD OFFSET DETAILING FOR RAVULAPALLE (MOMINPET)

Arb : R01-R02

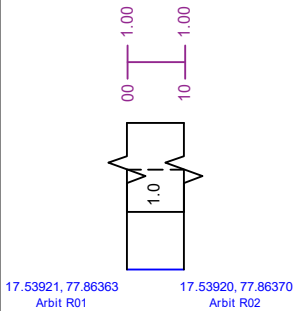


Length : 10 M

Arb : R02-R03

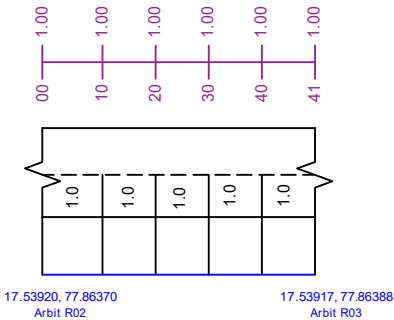


Length : 41 M

Arb : R03-R04

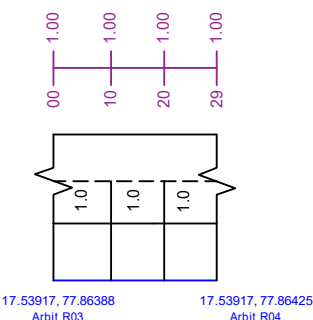


Length : 29 M

Arb : R04-R05

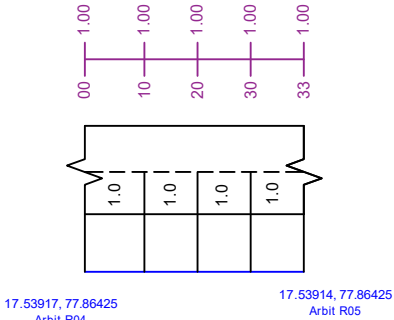


Length : 33 M

Arb : R05-R06

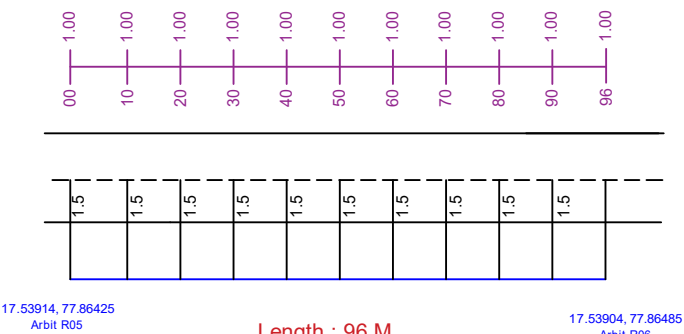

Length : 96 M

Arb : R05-R07

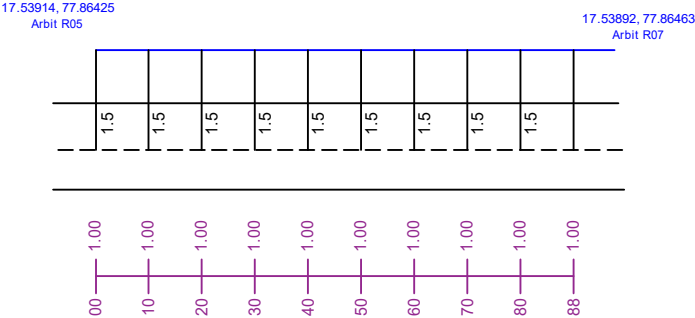


Length : 88 M

Checked	Designation	Signature


ROAD OFFSET DETAILING FOR RAVULAPALLE (MOMINPET)

Arb : R07-R08

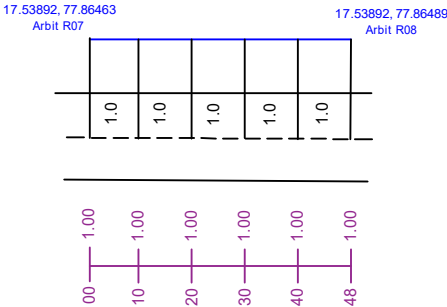


Length : 48 M

Arb : R07-R09

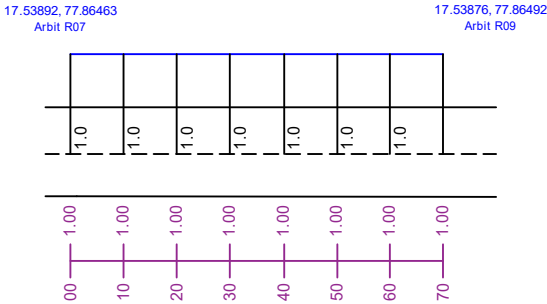


Length : 70 M

Arb : R02-R10

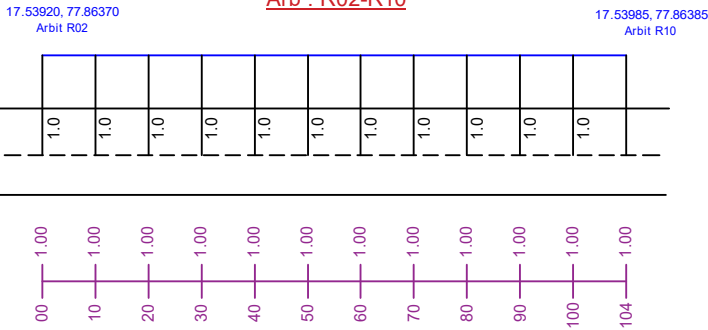


Length : 104 M

Arb : R10-R11

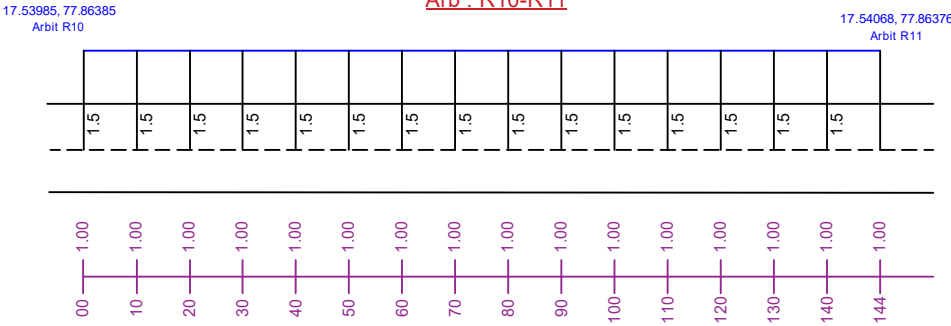

Length : 144 M

Arb : R10-R12

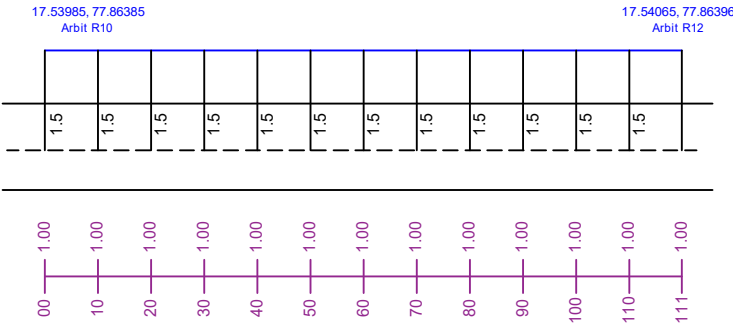

Length : 111 M

Checked	Designation	Signature



TELANGANA FIBER GRID

TELANGANA FIBER GRID

ITE & C GOVERNMENT OF TELANGANA

7th Floor, Splendid Towers, S.P. Road

Opp: Begumpet Police Station,



Begumpet, Hyderabad-500016.


 






AS - BUILT DRAWINGS (ABD)

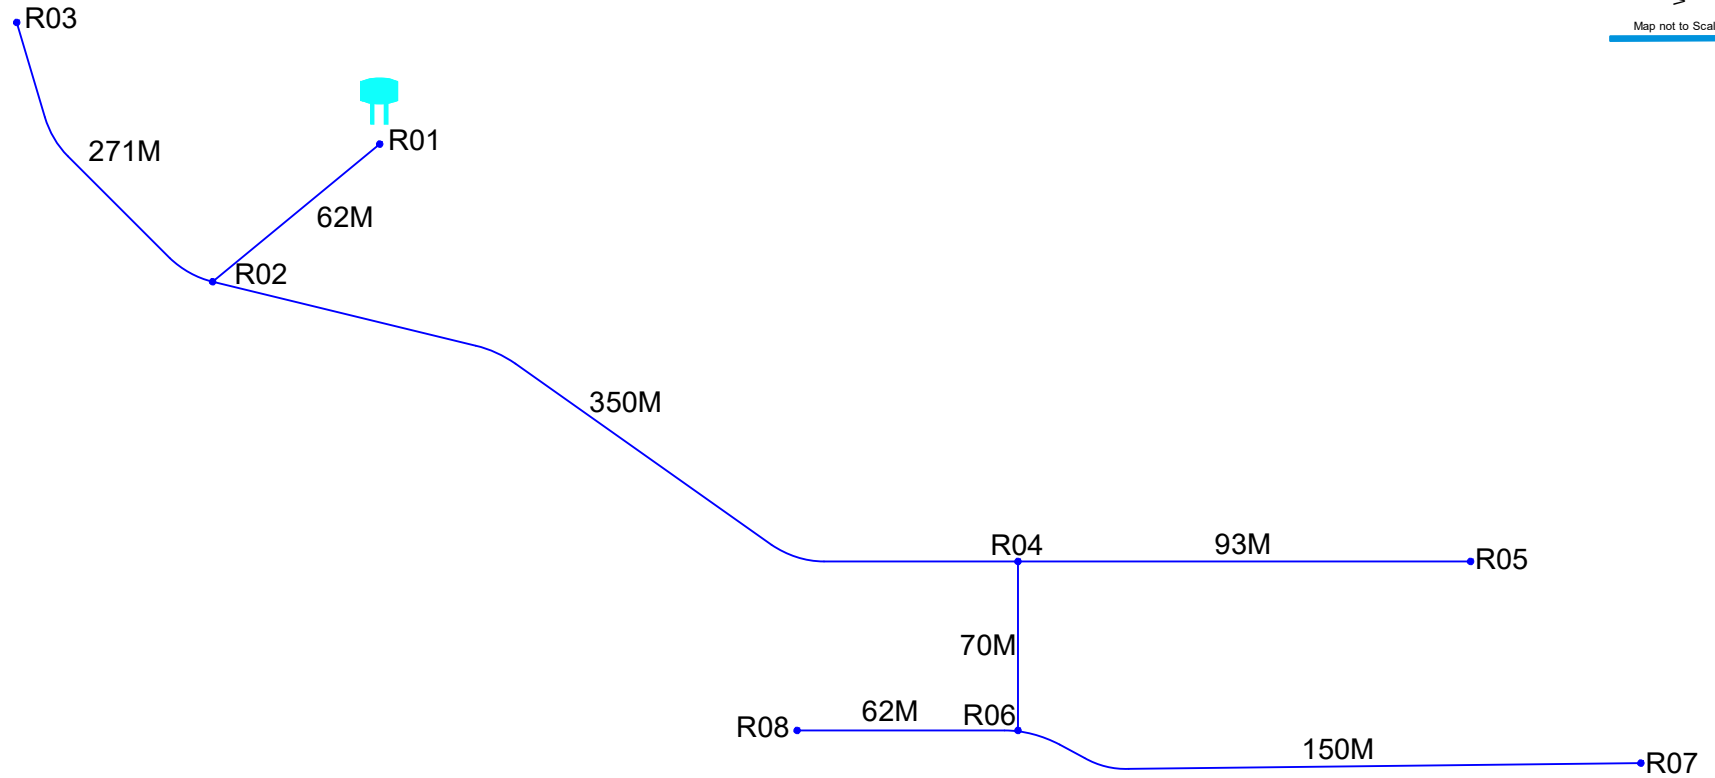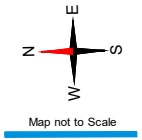SOMLANAIK TANDA

(MOMINPET MANDAL-VIKARABAD DIST.)

SINGLELINE LOOP DIAGRAM FOR SOMLANAIK TANDA (MOMINPET)






 






	DUCT PIPE
	ROAD
	OHSR
	G.P OFFICE
	TEMPLE
	HOSPITAL
	SCHOOL
	DUCT GAP

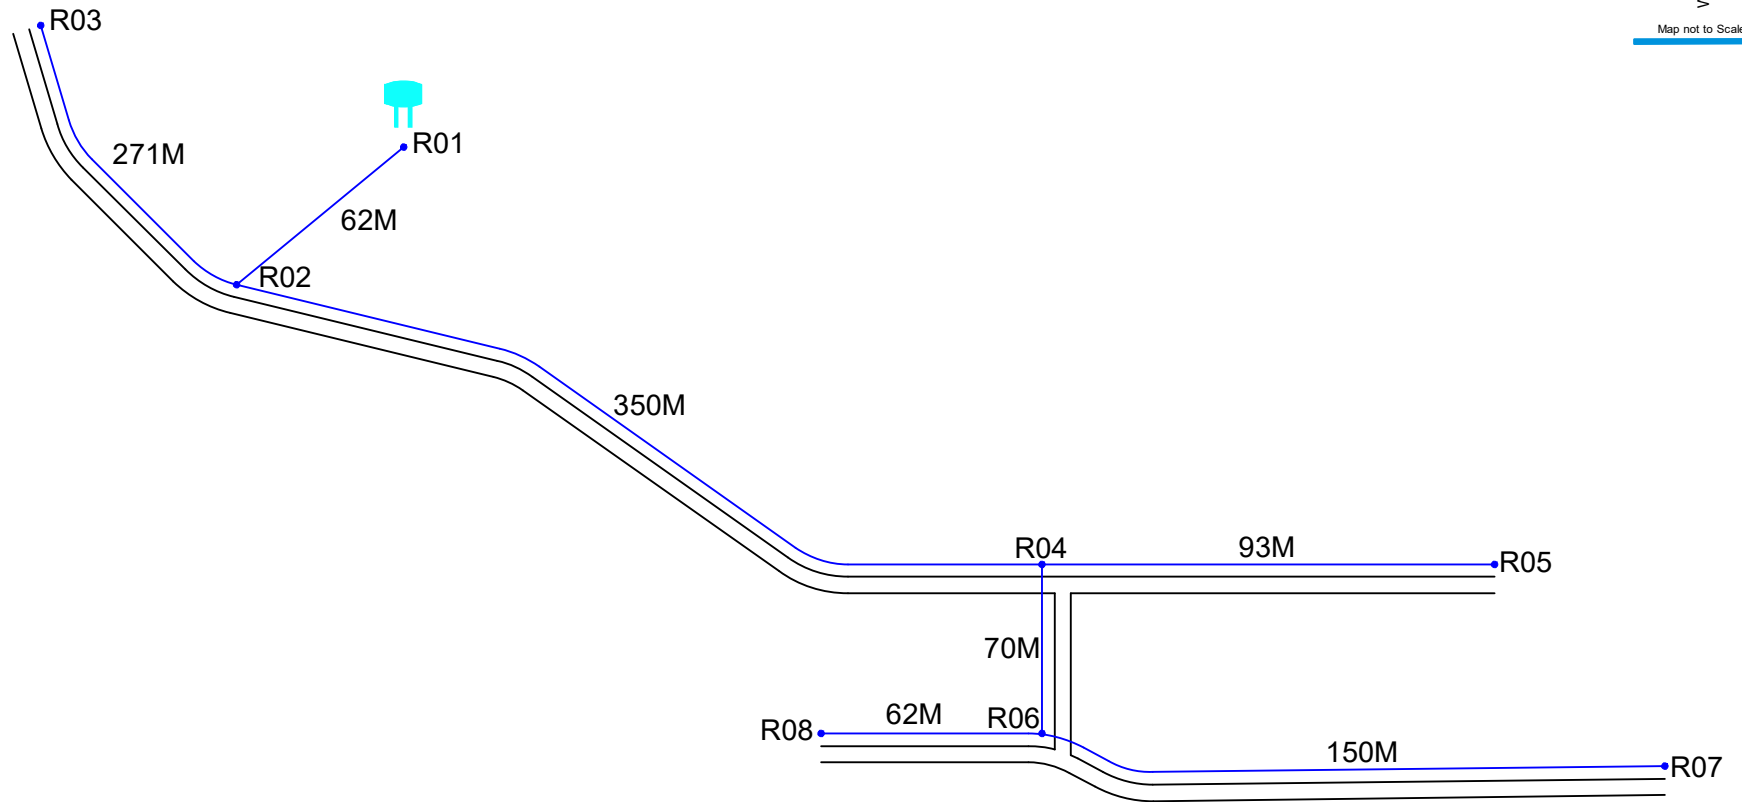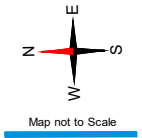Sheet No. 01
Route Distance : 1059 M

Checked	Designation	Signature

DUCTLAYING ROUTE DIAGRAM FOR SOMLANAIK TANDA (MOMINPET)



	DUCT PIPE
	ROAD
	OHSR
	G.P OFFICE
	TEMPLE
	HOSPITAL
	SCHOOL
	DUCT GAP

Sheet No. 01
Route Distance : 1059 M


Checked	Designation	Signature

ROAD OFFSET DETAILING FOR SOMLANAIK TANDA (MOMINPET)

Arb : R01-R02


17.55462, 77.93383
Arbit R01

17.55479, 77.93374
Arbit R02

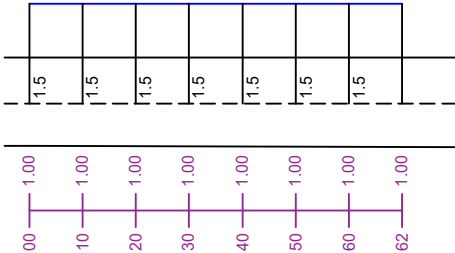

Length : 62 M

Arb : R02-R03

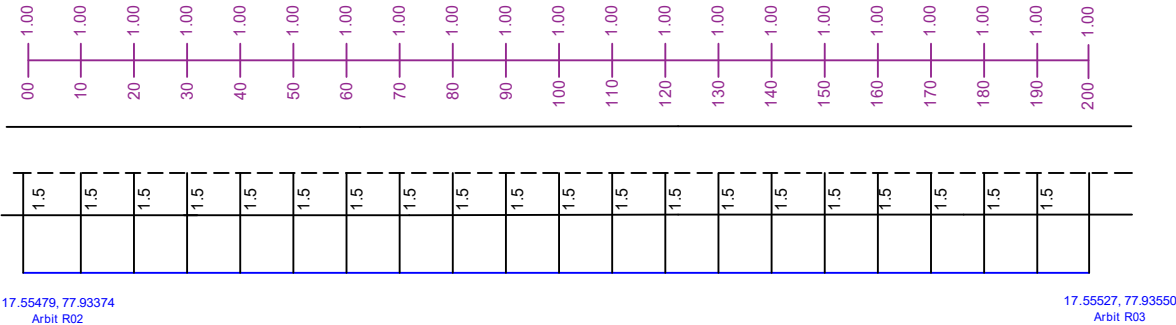


Length : 271 M

Arb : R02-R03

17.55479, 77.93374
Arbit R02




17.55527, 77.93550
Arbit R03

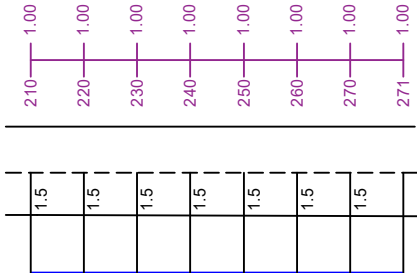

Length : 271 M




Checked	Designation	Signature

ROAD OFFSET DETAILING FOR SOMLANAIK TANDA (MOMINPET)

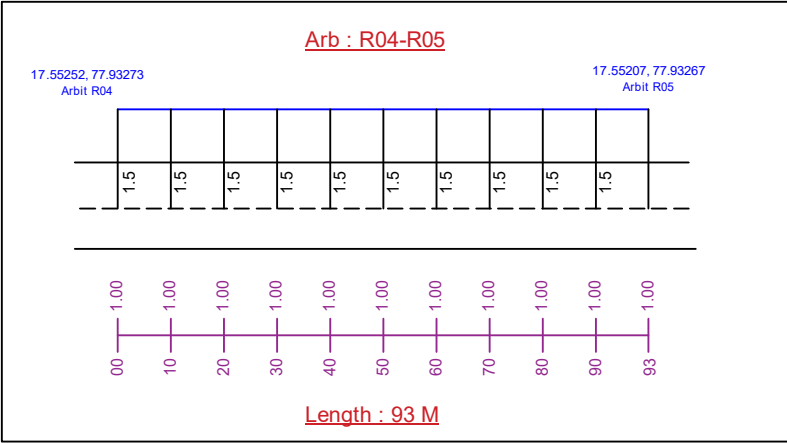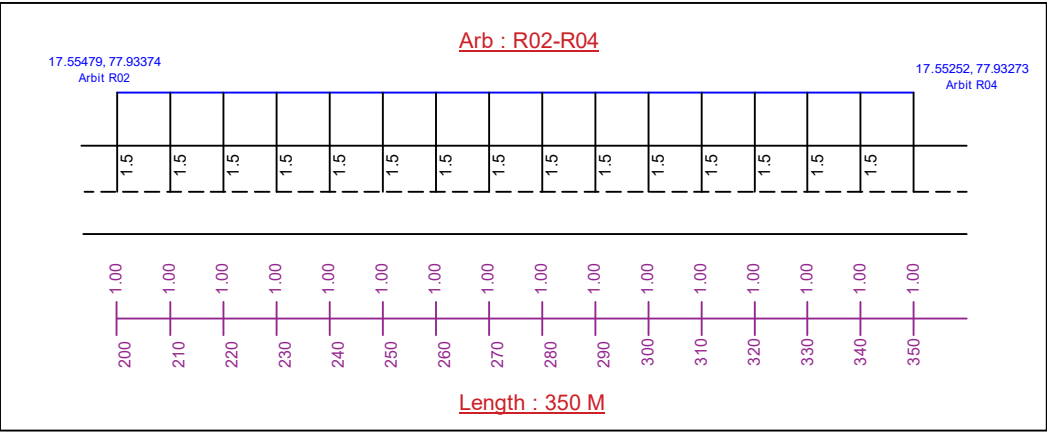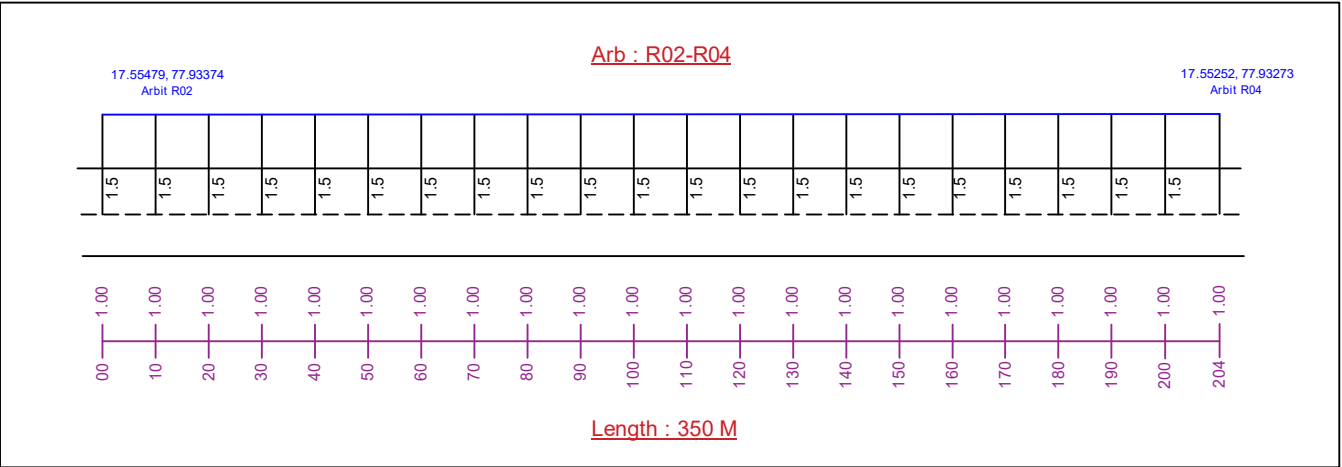

Checked	Designation	Signature

ROAD OFFSET DETAILING FOR SOMLANAIK TANDA (MOMINPET)

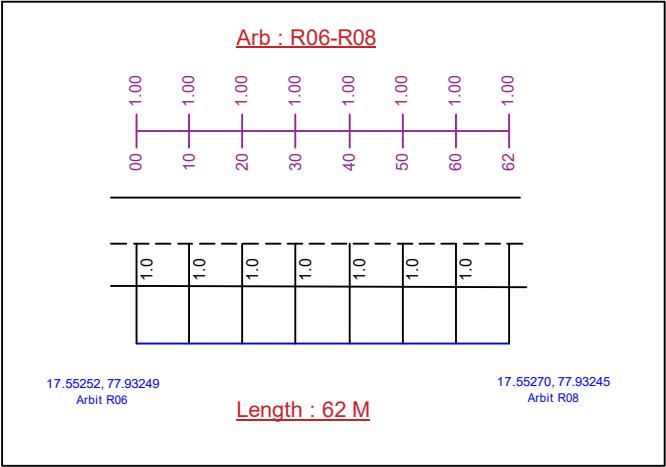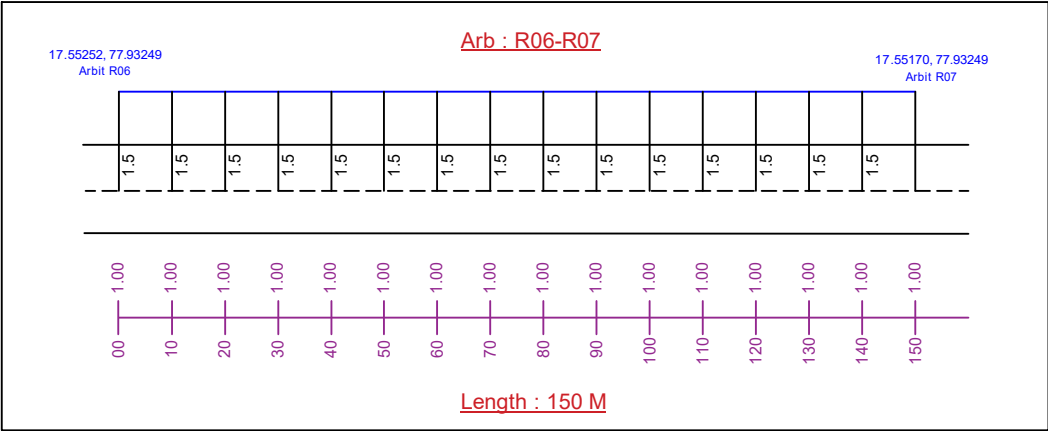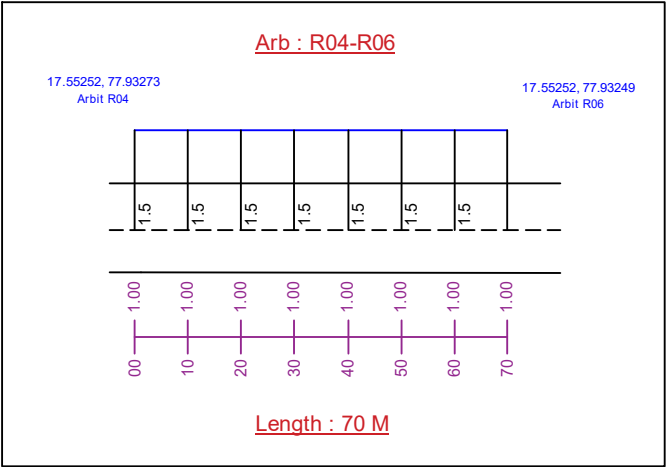

Checked	Designation	Signature



TELANGANA FIBER GRID

TELANGANA FIBER GRID

ITE & C GOVERNMENT OF TELANGANA

7th Floor, Splendid Towers, S.P. Road

Opp: Begumpet Police Station,



Begumpet, Hyderabad-500016.







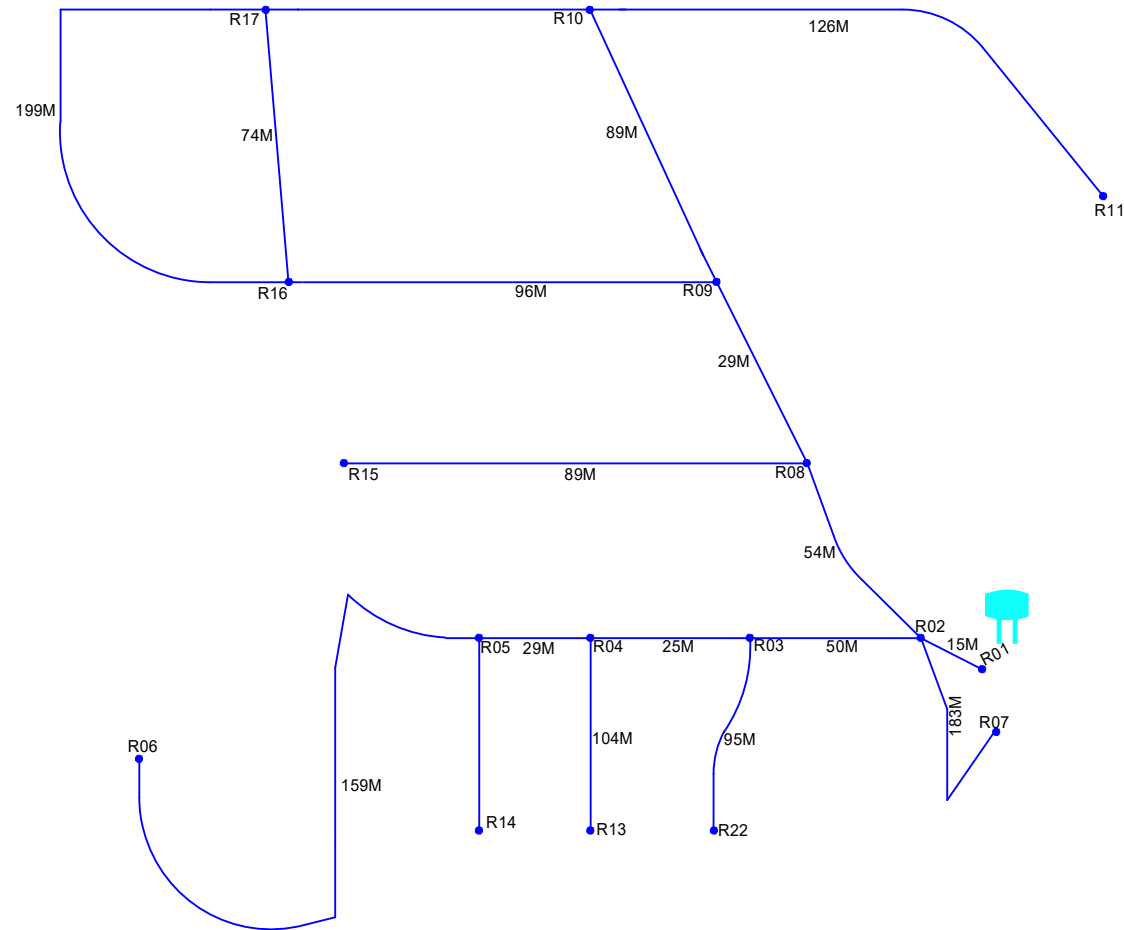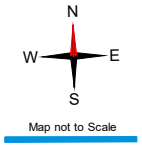

AS - BUILT DRAWINGS (ABD)

SYEDALIPUR

(MOMINPET MANDAL-VIKARABAD DIST.)

SINGLELINE LOOP DIAGRAM FOR SYEDALIPUR (MOMINPET)






 






	DUCT PIPE
	ROAD
	OHSR
	G.P OFFICE
	TEMPLE
	HOSPITAL
	SCHOOL
	DUCT GAP

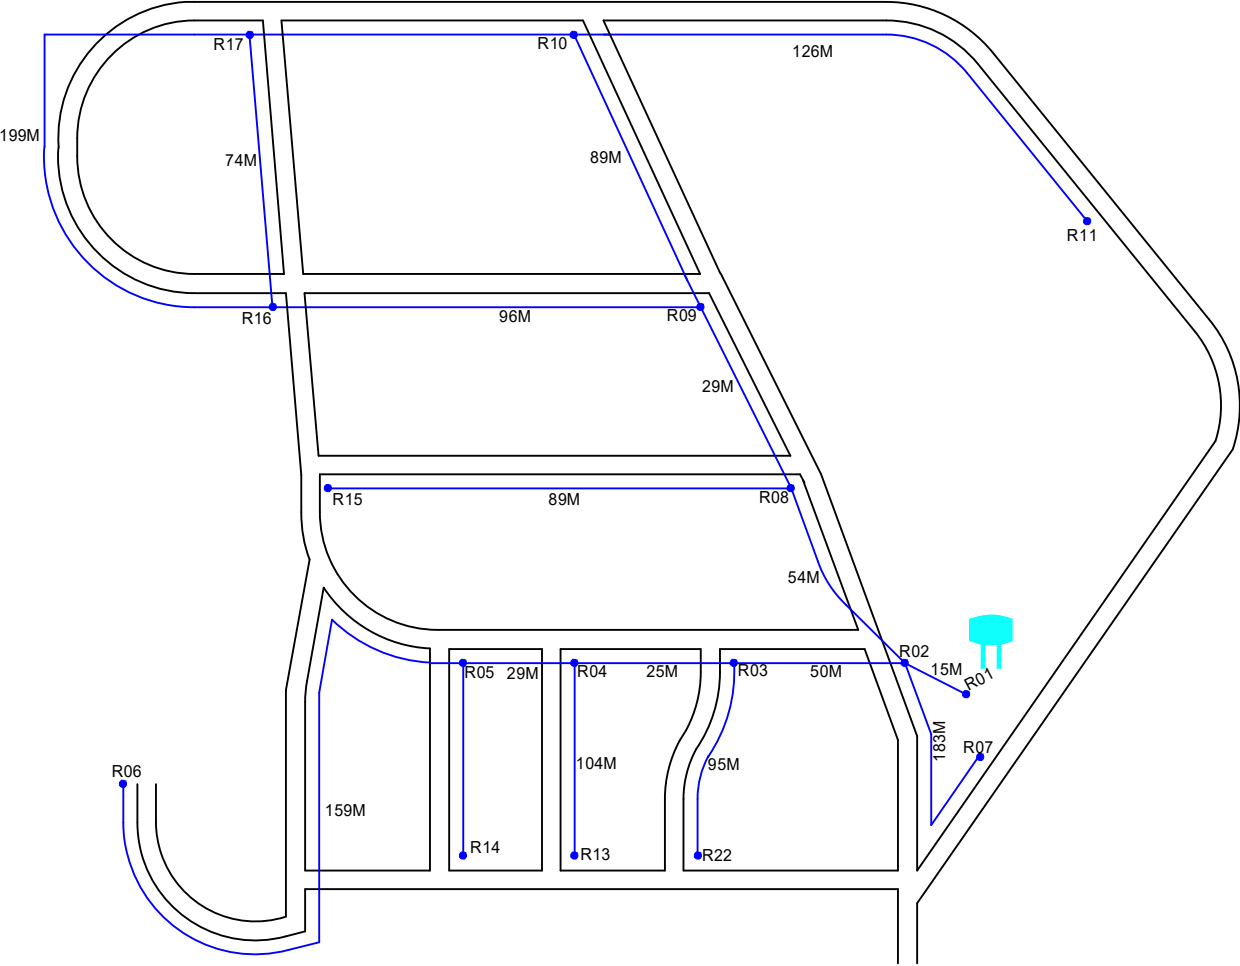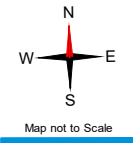Sheet No. 01
Route Distance : 1637 M

Checked	Designation	Signature

DUCTLAYING ROUTE DIAGRAM FOR SYEDALIPUR (MOMINPET)



	DUCT PIPE
	ROAD
	OHSR
	G.P OFFICE
	TEMPLE
	HOSPITAL
	SCHOOL
	DUCT GAP

Sheet No. 01
Route Distance : 1637 M


Checked	Designation	Signature

ROAD OFFSET DETAILING FOR SYEDALIPUR (MOMINPET)

Arb : R01-R02

17.49930, 77.81929
Arbit R01

17.49940, 77.81919
Arbit R02

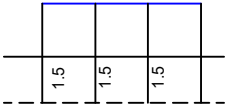

Length : 25 M

Arb : R02-R03

17.49940, 77.81919
Arbit R02

17.49943, 77.81883
Arbit R03




Length : 50 M

Arb : R03-R04

17.49943, 77.81883
Arbit R03

17.49942, 77.81870
Arbit R04

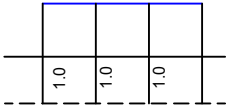


Length : 25 M

Arb : R04-R05

17.49942, 77.81870
Arbit R04

17.49940, 77.81853
Arbit R05

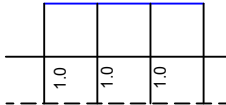


Length : 29 M

Arb : R05-R06

17.49940, 77.81853
Arbit R05





17.49898, 77.81969
Arbit R06

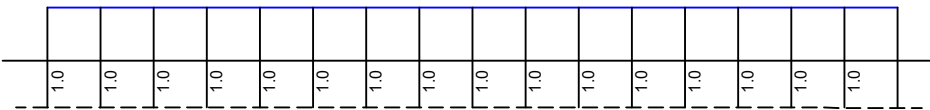

Length : 159 M

Checked	Designation	Signature


ROAD OFFSET DETAILING FOR SYEDALIPUR (MOMINPET)

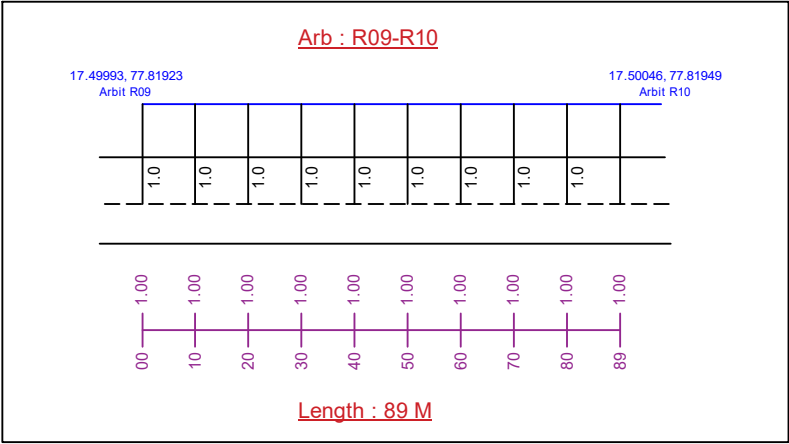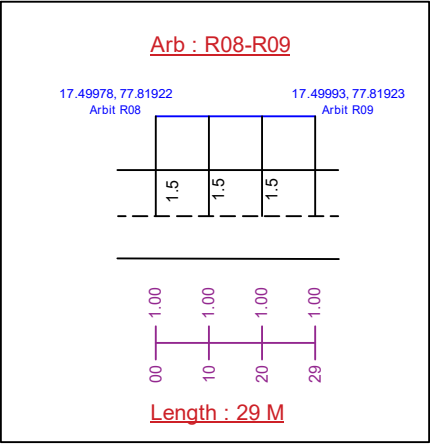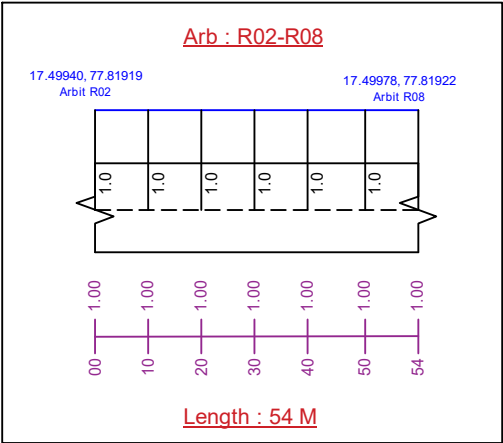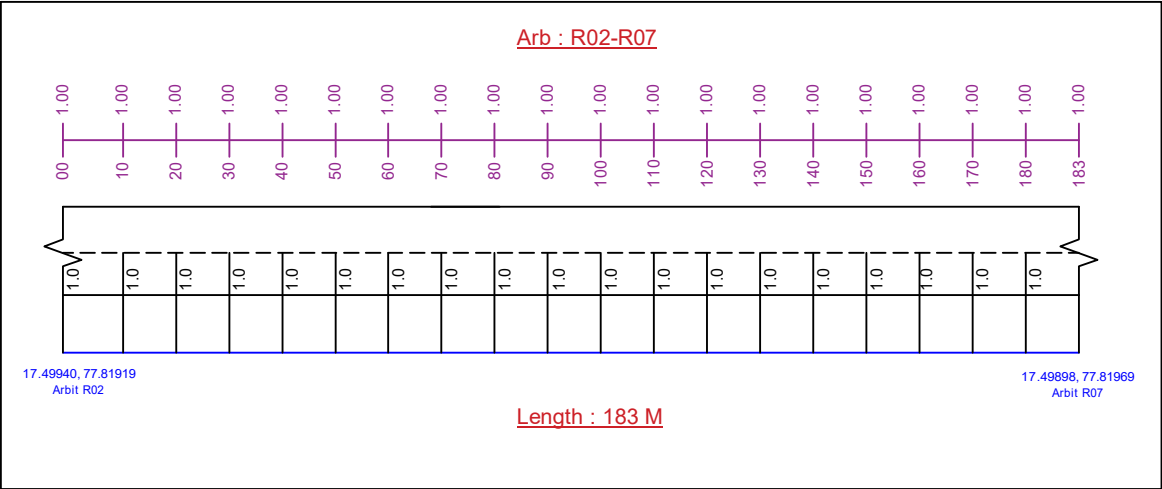


Checked	Designation	Signature

ROAD OFFSET DETAILING FOR SYEDALIPUR (MOMINPET)


Arb : R10-R11

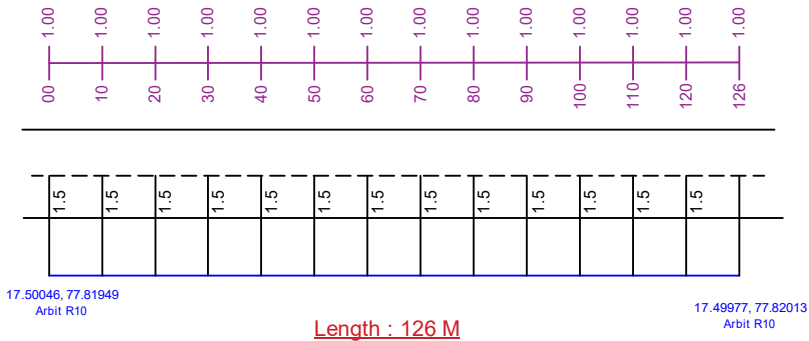


Arb : R03-R12

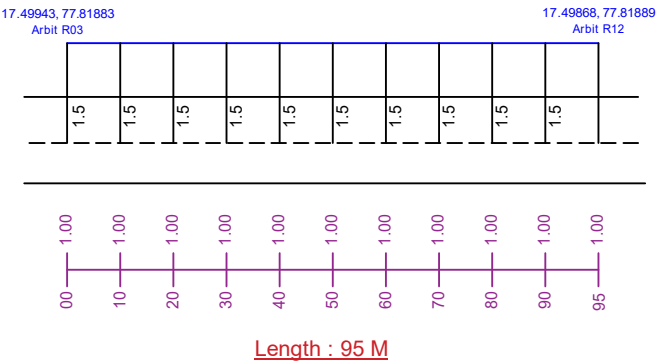

Arb : R04-R13

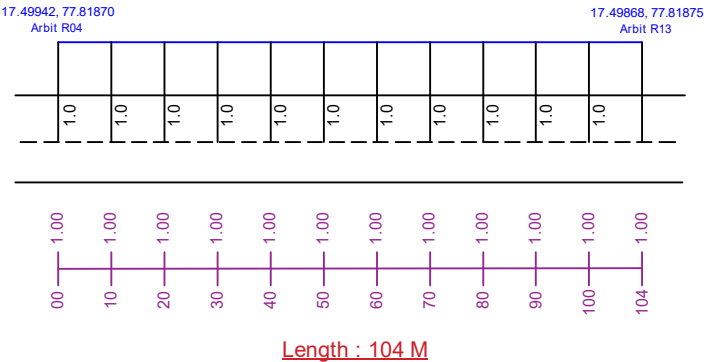


Arb : R05-R14

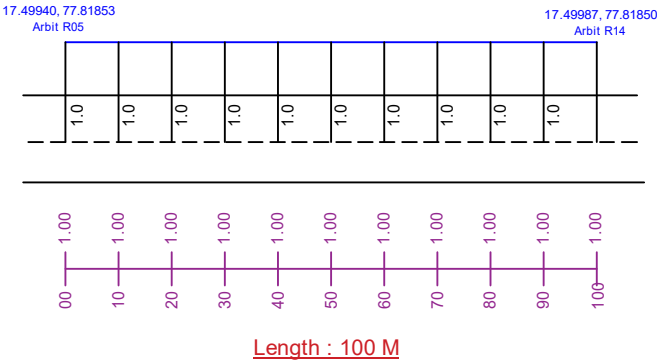


Checked	Designation	Signature

ROAD OFFSET DETAILING FOR SYEDALIPUR (MOMINPET)


Arb : R08-R15

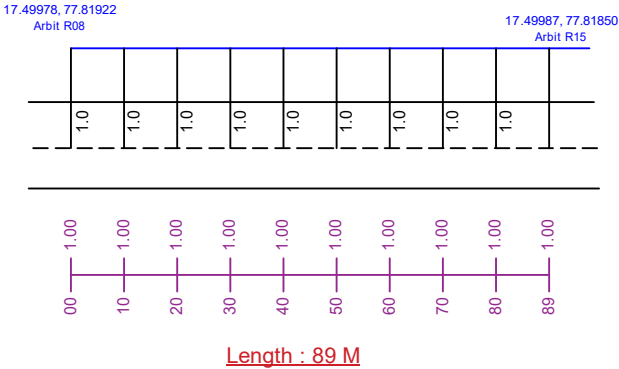


Arb : R09-R16

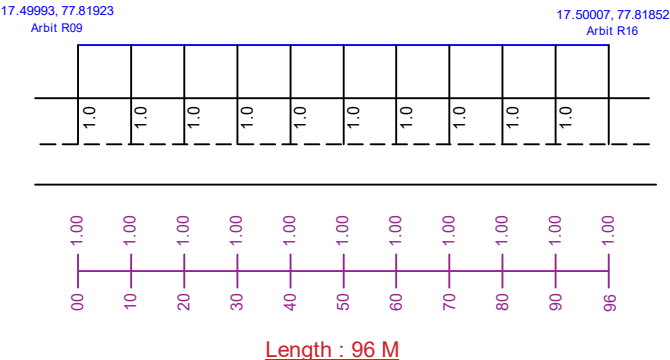

Arb : R16-R17

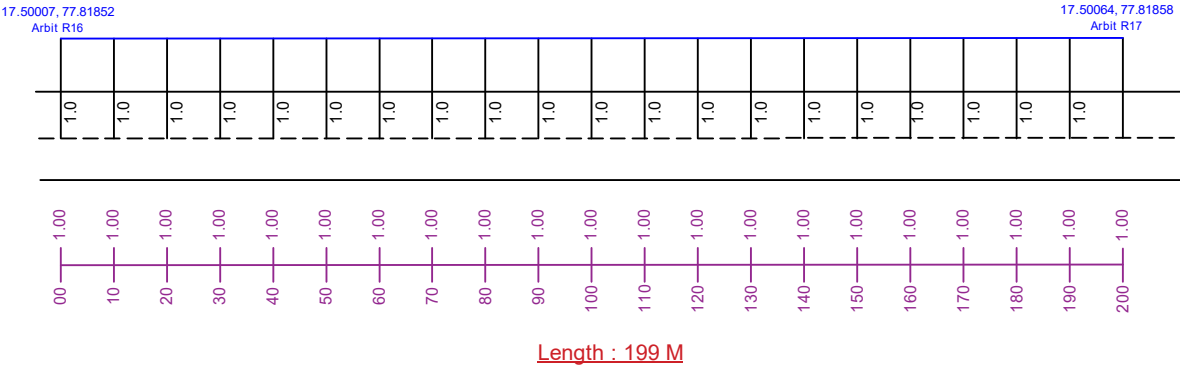


Arb : R16-R17

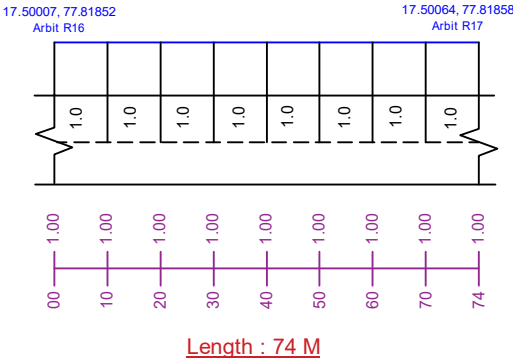

Checked	Designation	Signature

ROAD OFFSET DETAILING FOR SYEDALIPUR (MOMINPET)

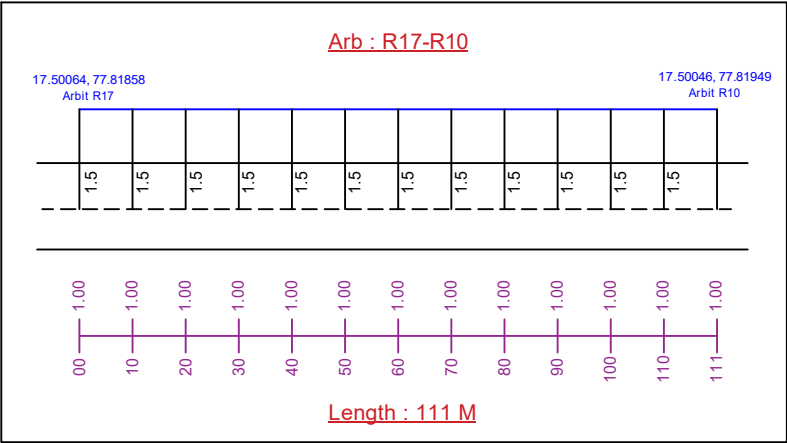

Sheet No. 05
Route Distance : 1637M

Checked	Designation	Signature



TELANGANA FIBER GRID

TELANGANA FIBER GRID

ITE & C GOVERNMENT OF TELANGANA

7th Floor, Splendid Towers, S.P. Road

Opp: Begumpet Police Station,



Begumpet, Hyderabad-500016.

AS - BUILT DRAWINGS (ABD)

TEKULAPALLE

(MOMINPET MANDAL-VIKARABAD DIST.)

SINGLELINE LOOP DIAGRAM FOR TEKULAPALLE OHSR1 (MOMINPET)

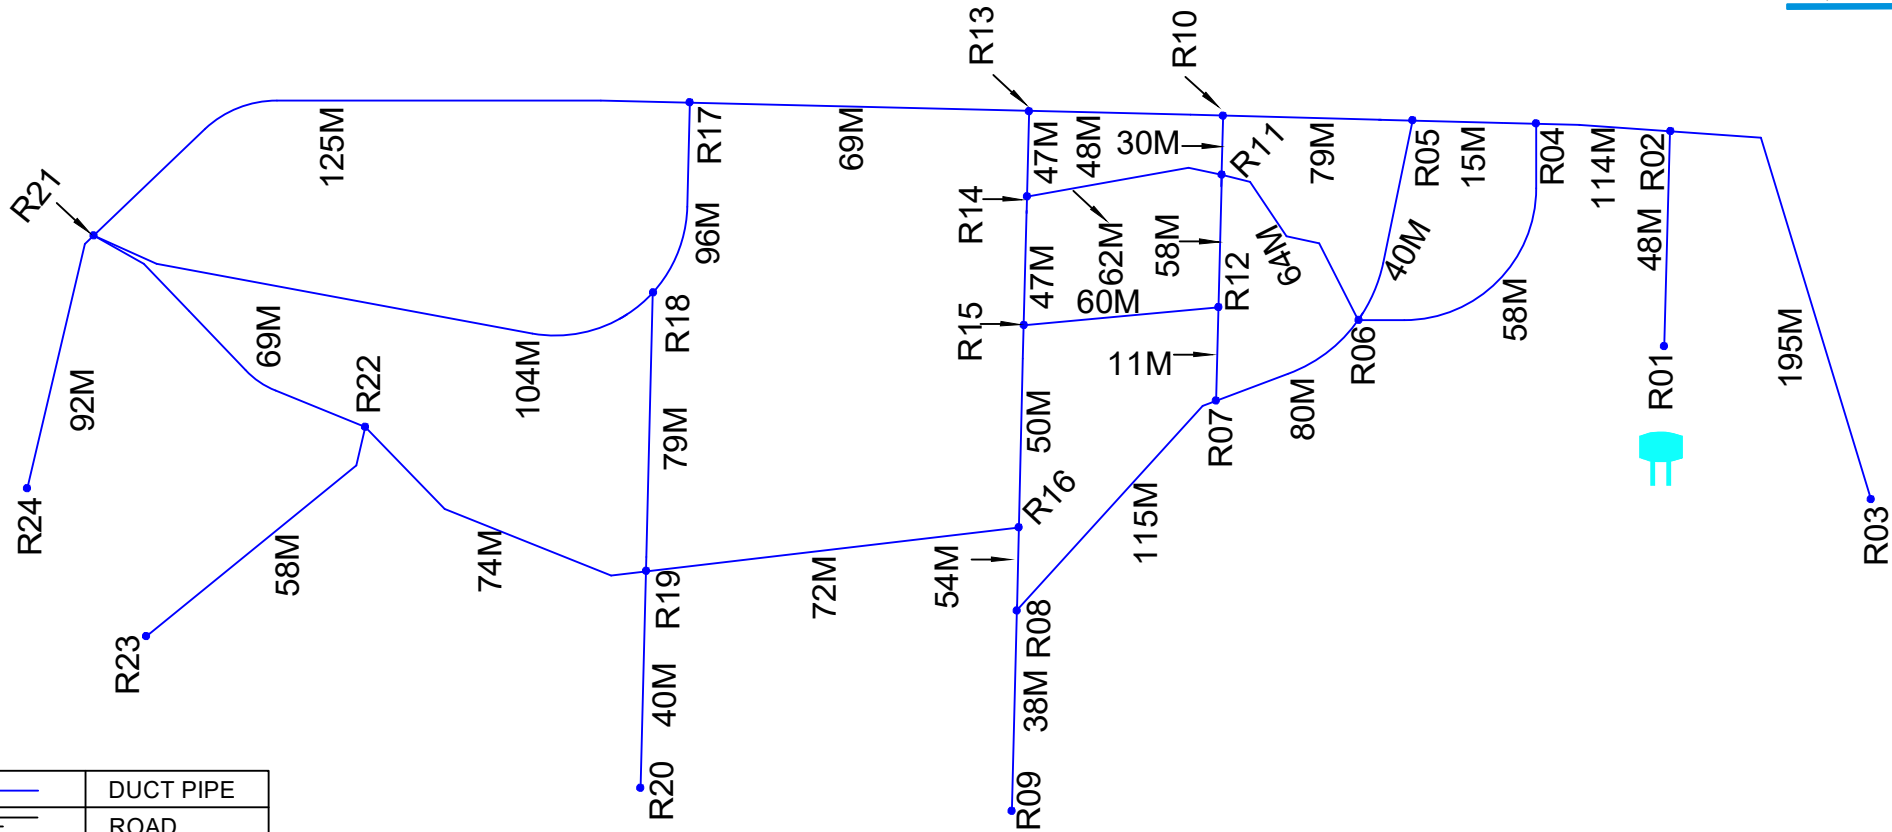
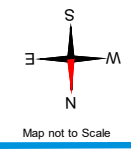


	DUCT PIPE
	ROAD
	OHSR
	G.P OFFICE
	TEMPLE
	HOSPITAL
	SCHOOL
	DUCT GAP

Sheet No. 01
Route Distance : 6027 M

Checked	Designation	Signature

DUCTLAYING ROUTE DIAGRAM FOR TEKULAPALLE OHSR1 (MOMINPET)

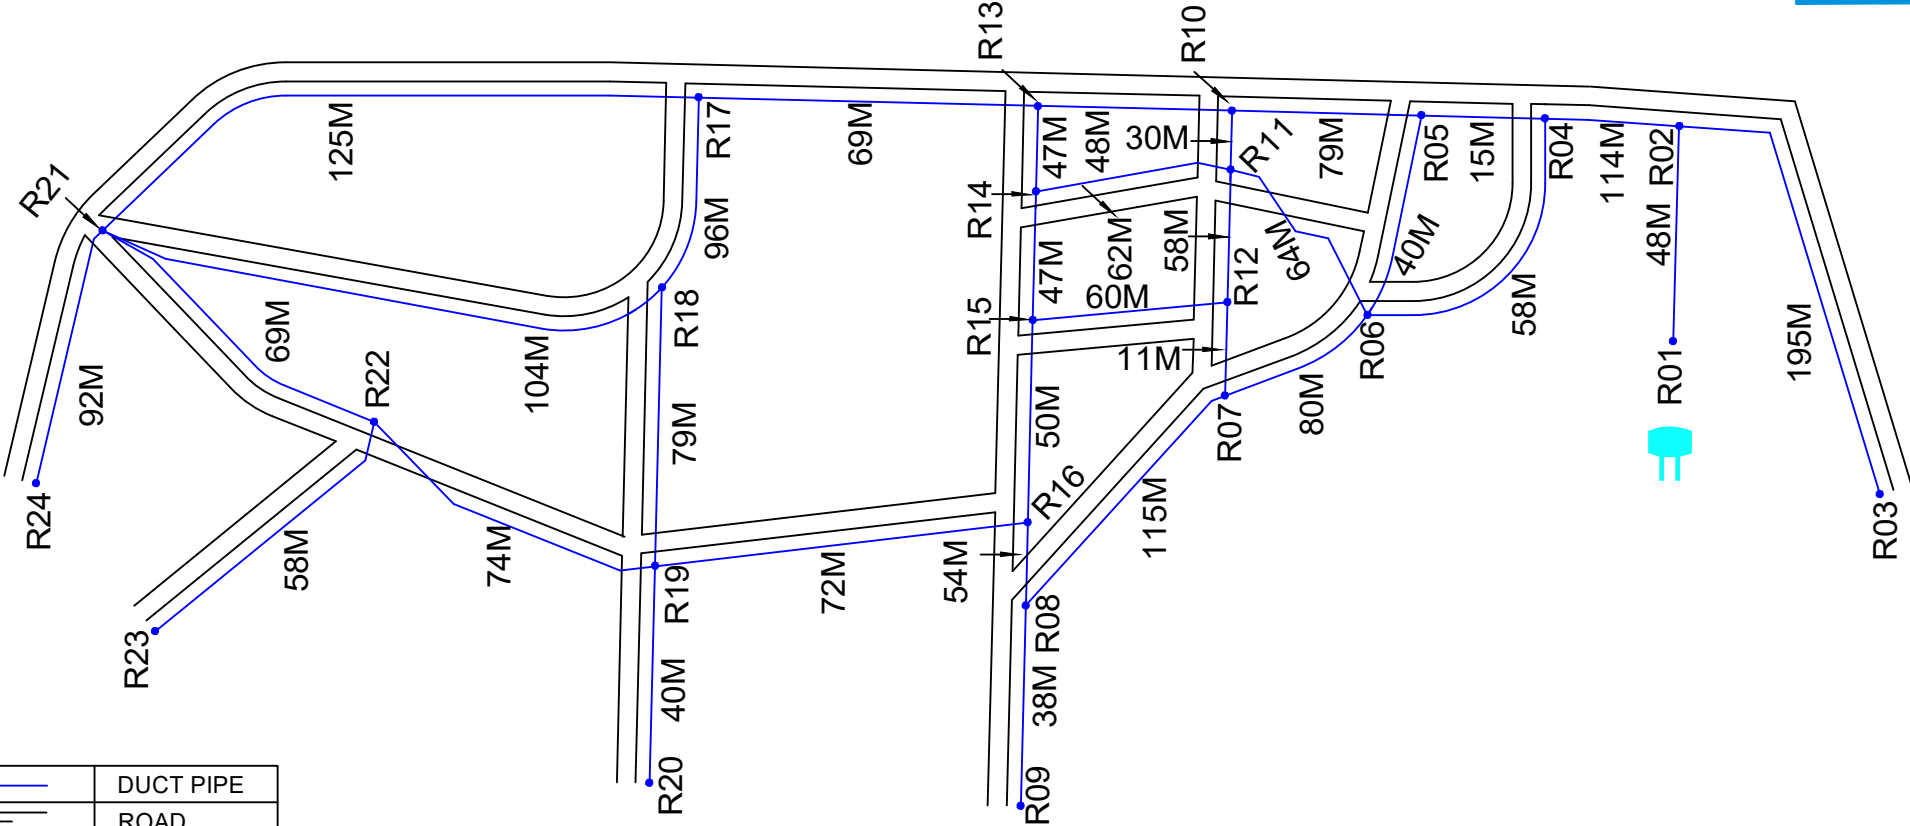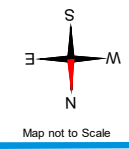


	DUCT PIPE
	ROAD
	OHSR
	G.P OFFICE
	TEMPLE
	HOSPITAL
	SCHOOL
	DUCT GAP

Checked	Designation	Signature


Sheet No. 01
Route Distance : 6027 M

ROAD OFFSET DETAILING FOR TEKULAPALLE OHSR1 (MOMINPET)


Arb : R01-R02

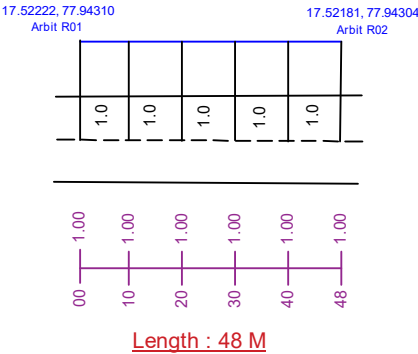


Arb : R02-R03

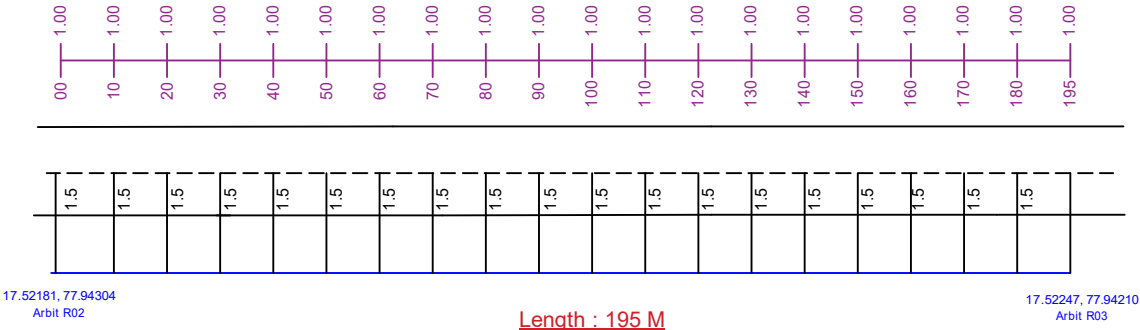


Arb : R02-R04

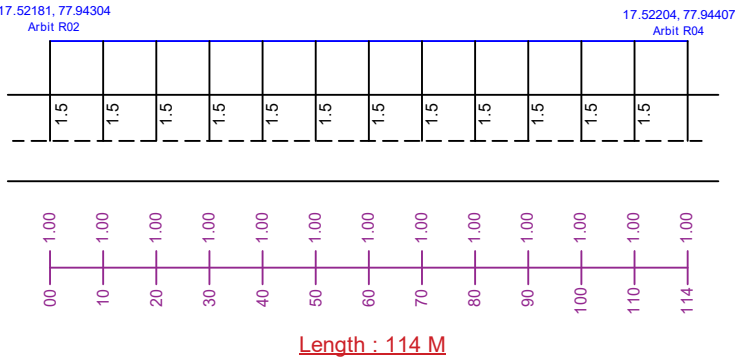

Arb : R04-R05

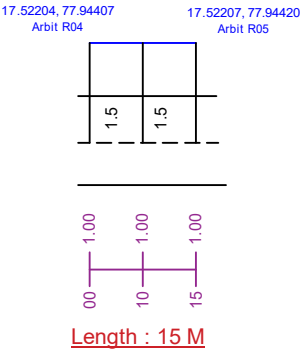

Arb : R05-R06

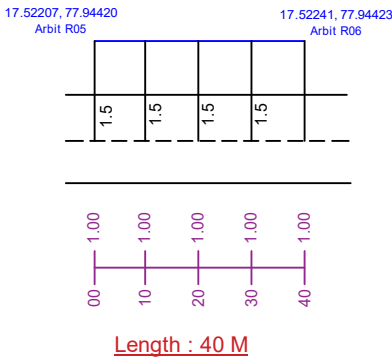


Checked	Designation	Signature

ROAD OFFSET DETAILING FOR TEKULAPALLE OHSR1 (MOMINPET)

Arb : R04-R06

Arbit R04

Arbit R06

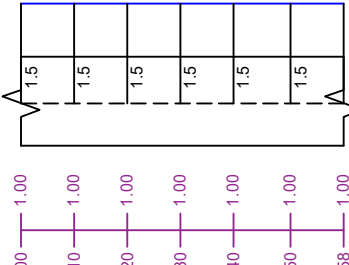


Length : 58 M

Arb : R06-R07

17.52241, 77.9
Arbit R06

Arbit R07

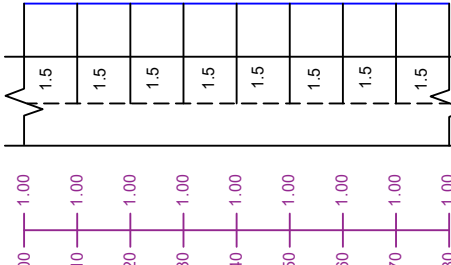


Length : 80 M

Arb : R07-R08


Arbit R07

17.52382, 77
Arbit R0

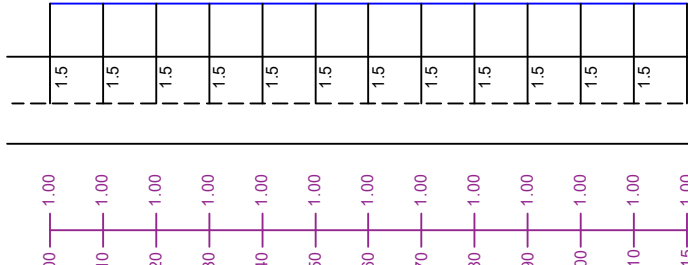

Length : 115

Arb : R08-R09

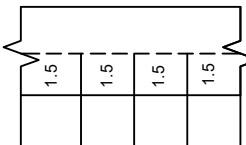

Arbit R08


17.52414, 77.9
Arbit B09

Length : 38 M

Arb : R05-R10

Arbit R05

Arbit B10

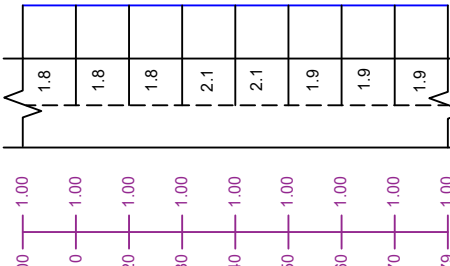


Length : 79 M

Arb : R10-R11

17.52216, 77.9
Arbit R10

17.52240, 77.
Arbit. R1

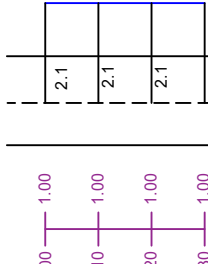

Length : 30 M


Checked	Designation	Signature
---------	-------------	-----------

Sheet No. 02
Route Distance : 6027 M


--	--	--

ROAD OFFSET DETAILING FOR TEKULAPALLE OHSR1 (MOMINPET)


Arb : R06-R11

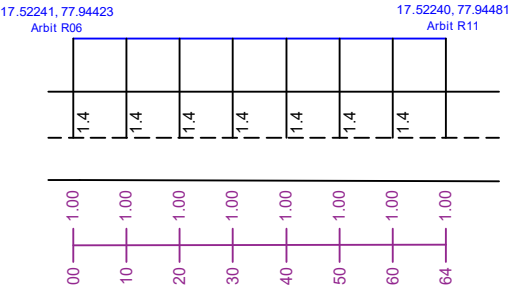


Arb : R11-R12

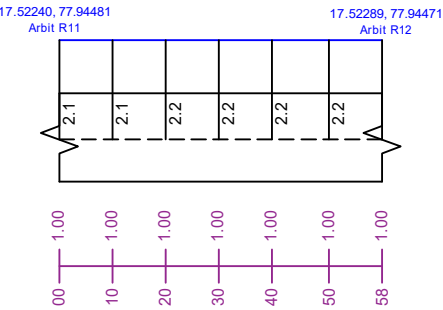


Arb : R12-R07

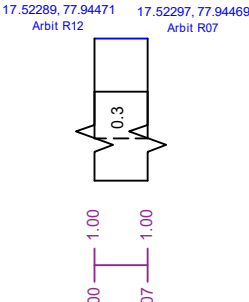


Arb : R10-R13

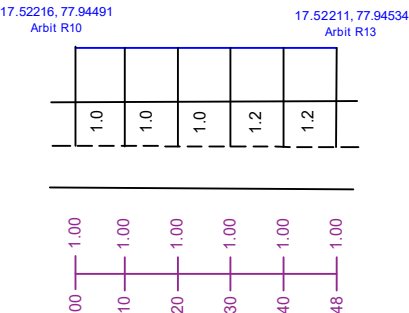

Arb : R13-R14

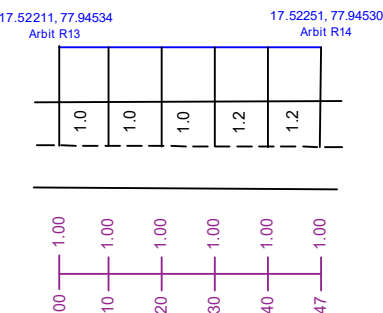


Arb : R11-R14

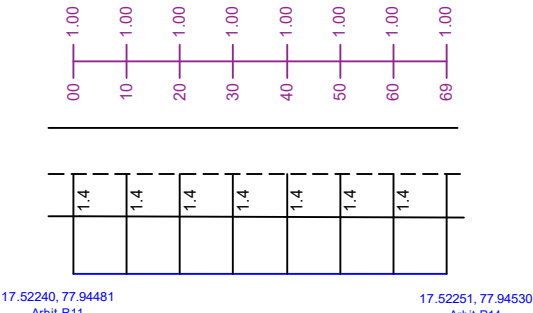


Checked	Designation	Signature

ROAD OFFSET DETAILING FOR TEKULAPALLE OHSR1 (MOMINPET)


Arb : R17-R18

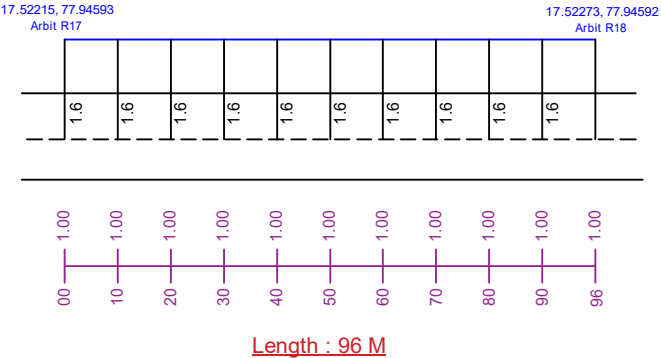


Arb : R18-R19

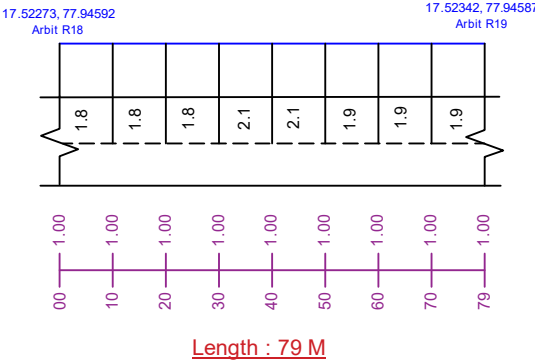


Arb : R19-R20

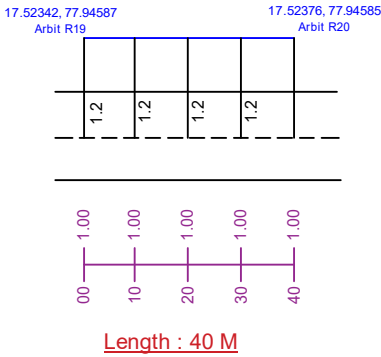

Arb : R16-R19





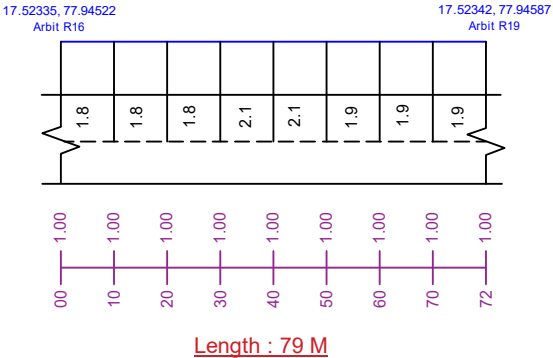


Arb : R17-R21

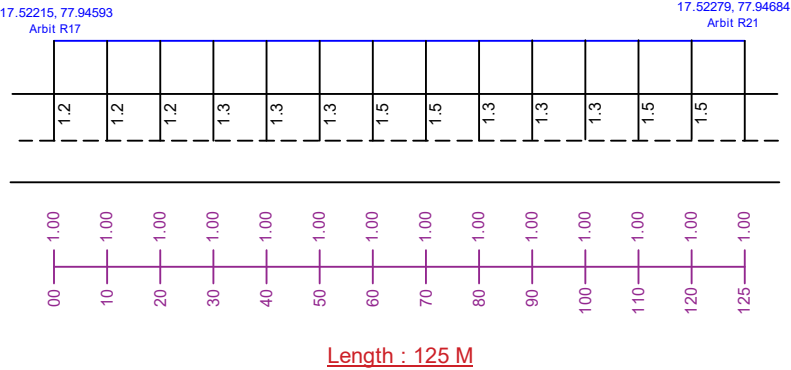



Checked	Designation	Signature

ROAD OFFSET DETAILING FOR TEKULAPALLE OHSR1 (MOMINPET)

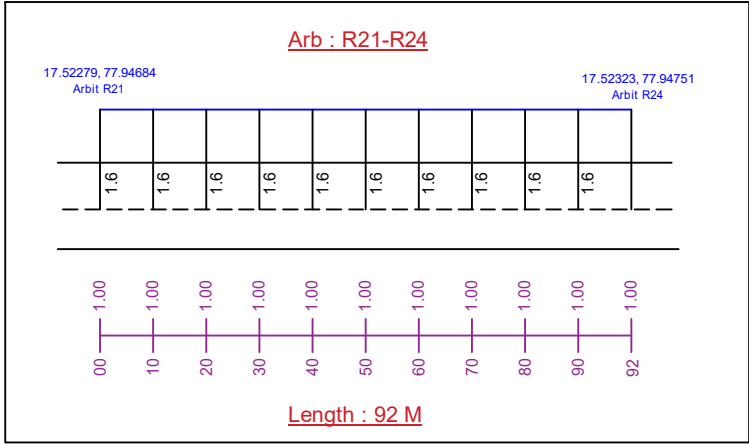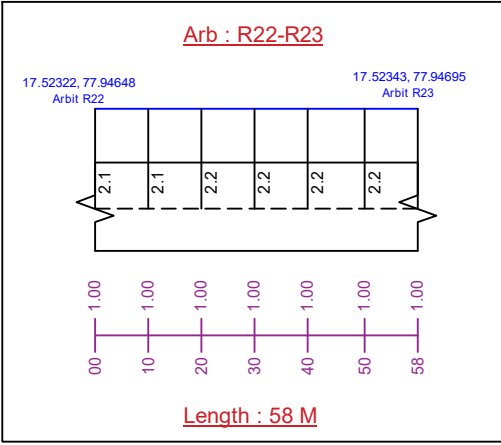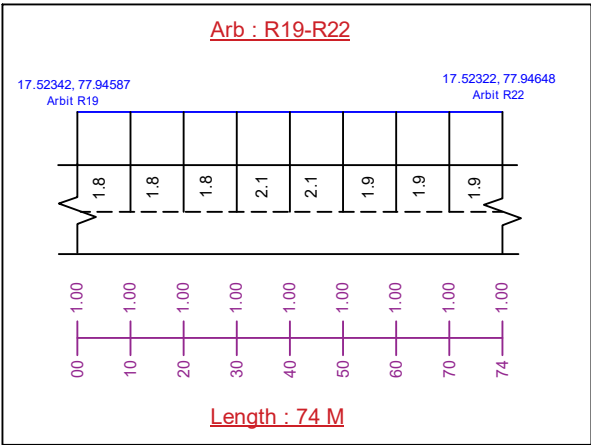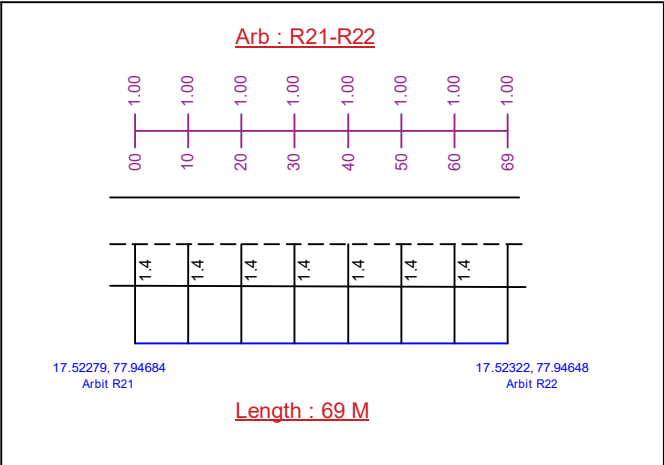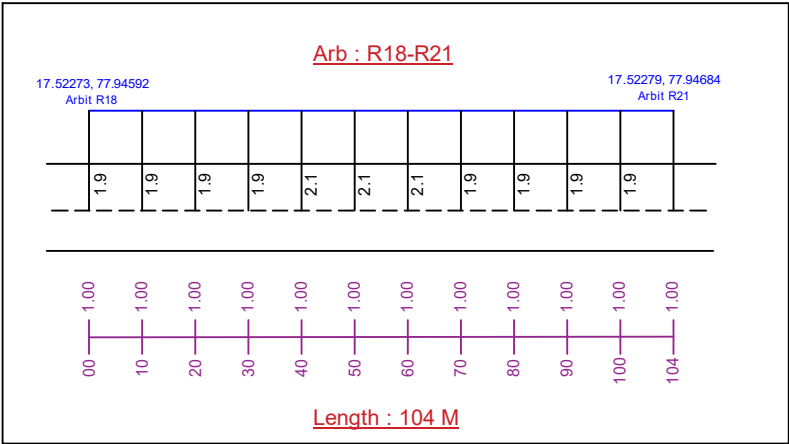

Checked	Designation	Signature

SINGLELINE LOOP DIAGRAM FOR TEKULAPALLE OHSR2 (MOMINPET)

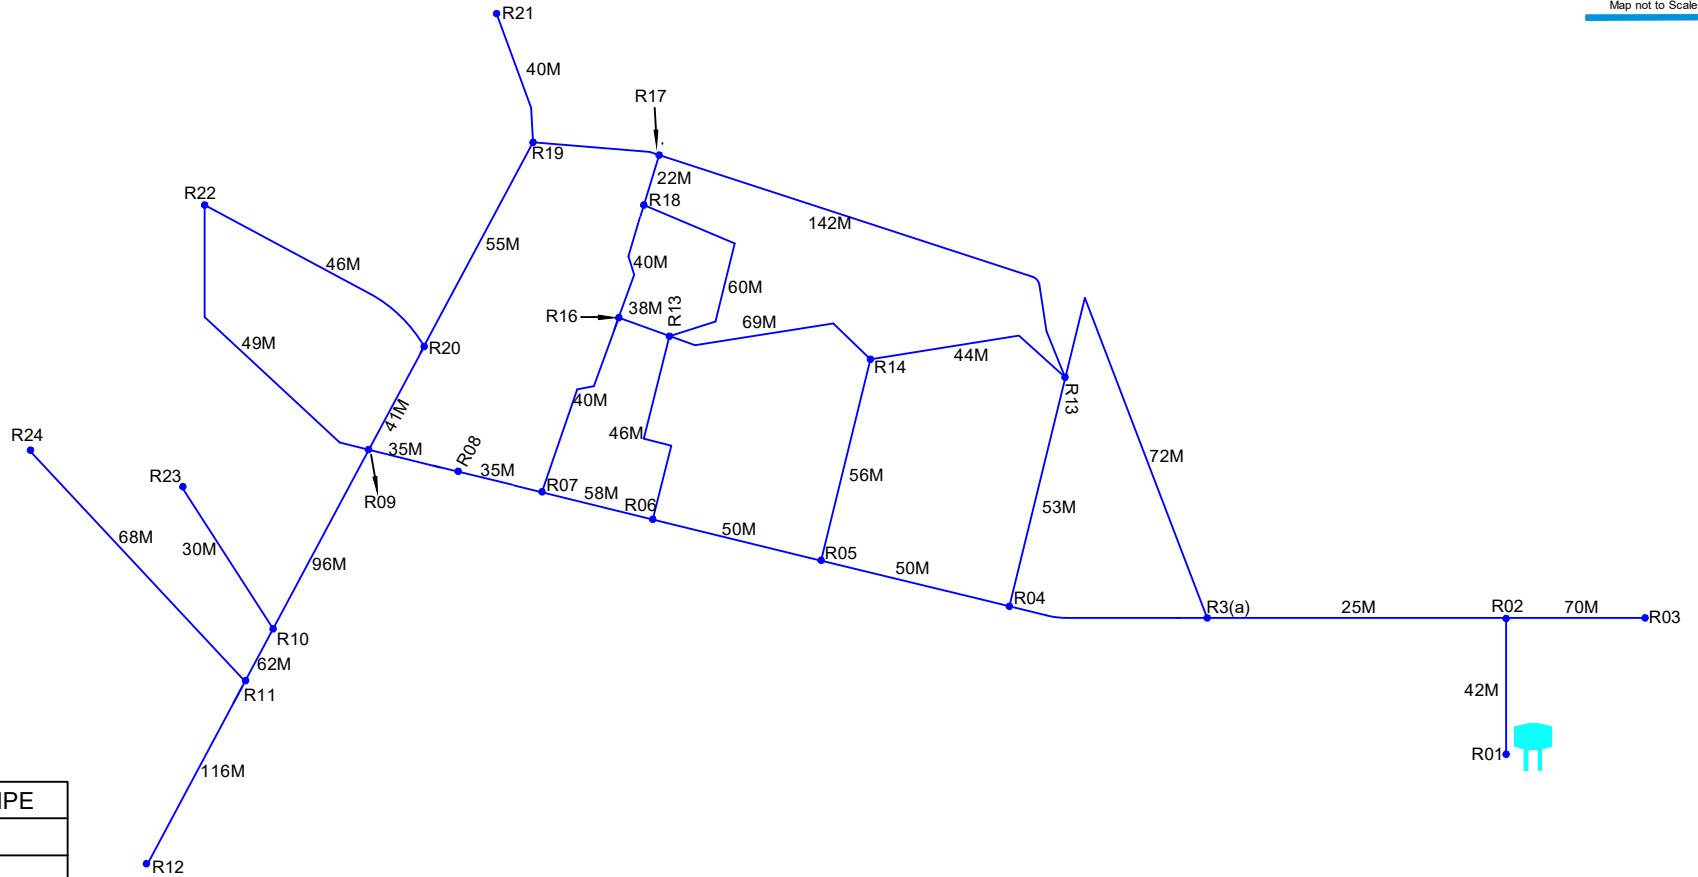
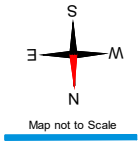


	DUCT PIPE
	ROAD
	OHSR
	G.P OFFICE
	TEMPLE
	HOSPITAL
	SCHOOL
	DUCT GAP

Sheet No. 01
Route Distance : 6027 M

Checked	Designation	Signature

DUCTLAYING ROUTE DIAGRAM FOR TEKULAPALLE OHSR2 (MOMINPET)

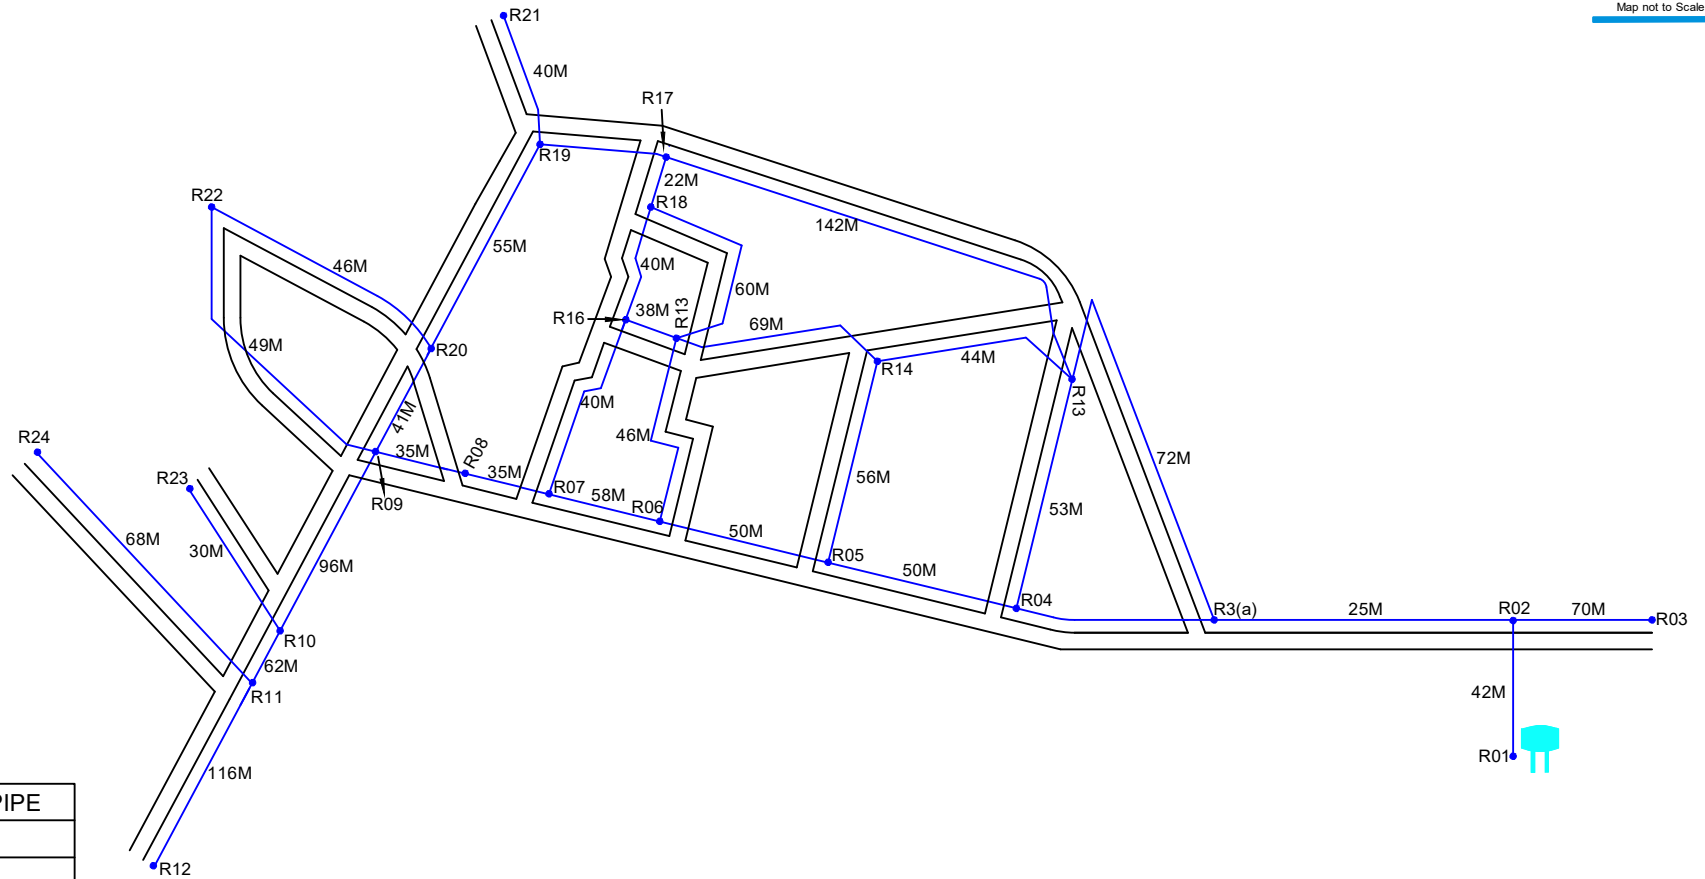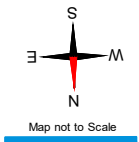


	DUCT PIPE
	ROAD
	OHSR
	G.P OFFICE
	TEMPLE
	HOSPITAL
	SCHOOL
	DUCT GAP

Sheet No. 01
Route Distance : 6027 M

Checked	Designation	Signature


ROAD OFFSET DETAILING FOR TEKULAPALLE OHSR2 (MOMINPET)

Arb : R01-R02

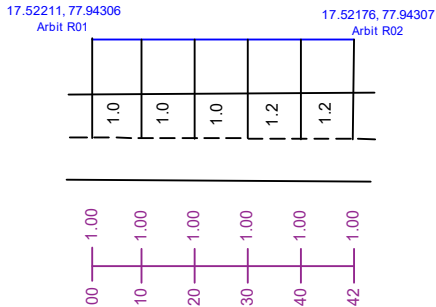


Length : 42 M

Arb : R02-R03

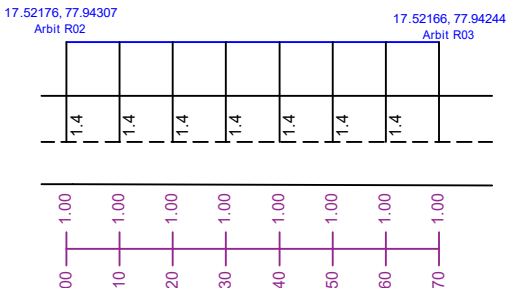


Length : 70 M

Arb : R02-R3A

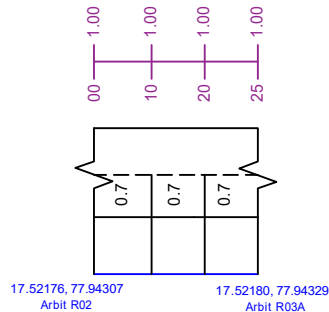


Length : 25 M

Arb : R3A-R04

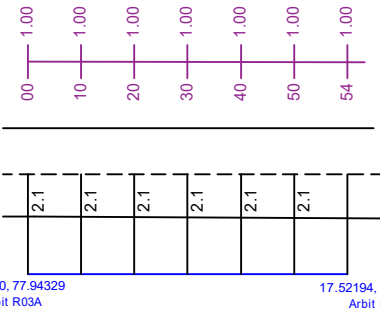


Length : 52 M

Arb : R04-R05

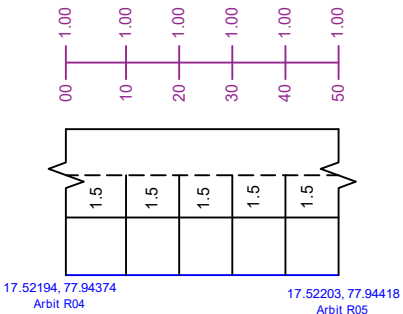

Length : 50 M

Arb : R05-R06

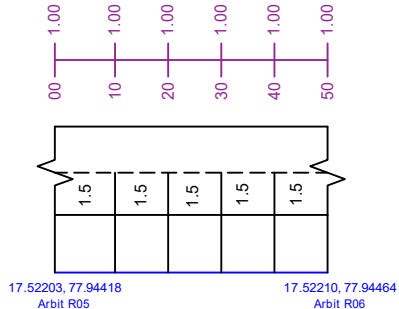


Length : 50 M

Checked	Designation	Signature
---------	-------------	-----------

Sheet No. 01
Route Distance : 6027 M


ROAD OFFSET DETAILING FOR TEKULAPALLE OHSR2 (MOMINPET)

Arb : R06-R07

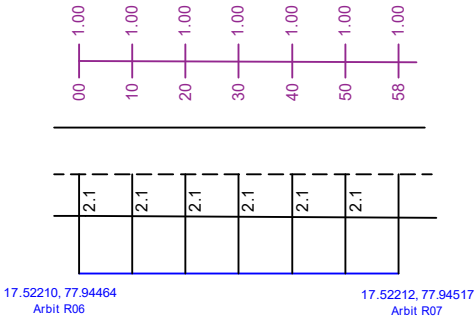


Length : 58 M

Arb : R07-R08

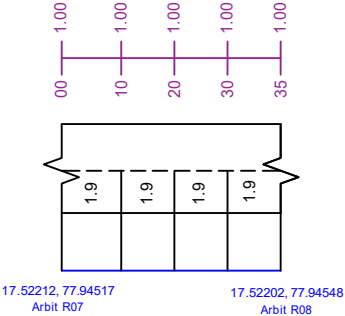


Length : 35 M

Arb : R08-R09

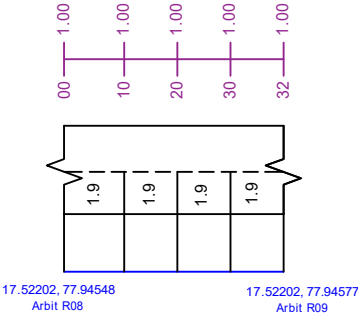


Length : 32 M

Arb : R09-R10

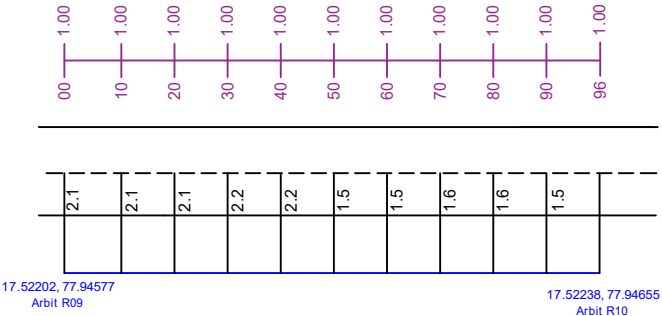

Length : 96 M







Arb : R10-R11

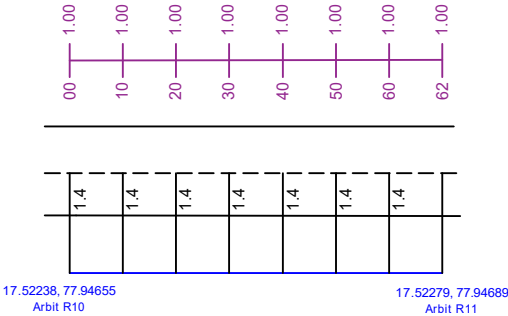

Length : 62 M

Checked	Designation	Signature


ROAD OFFSET DETAILING FOR TEKULAPALLE OHSR2 (MOMINPET)

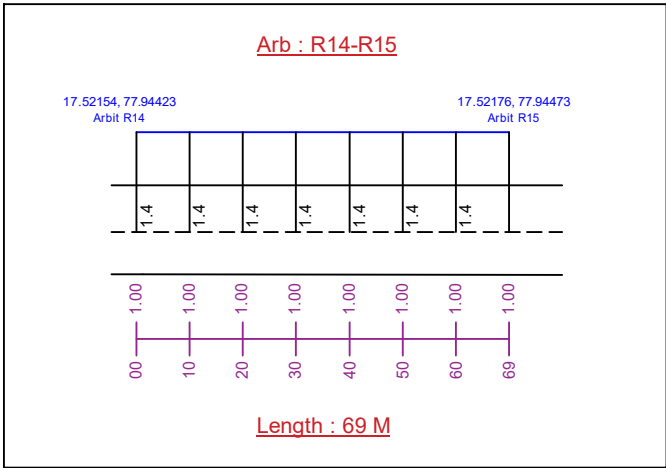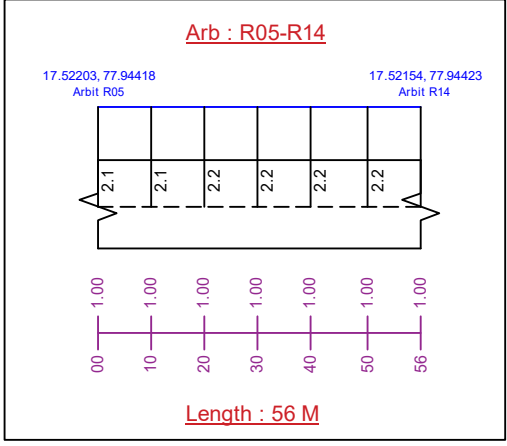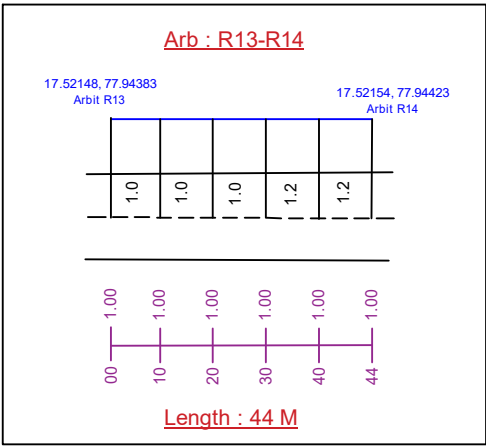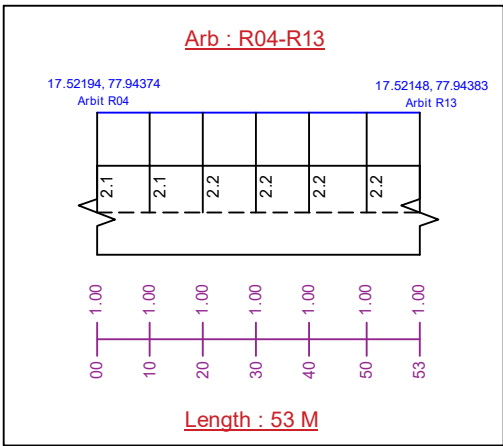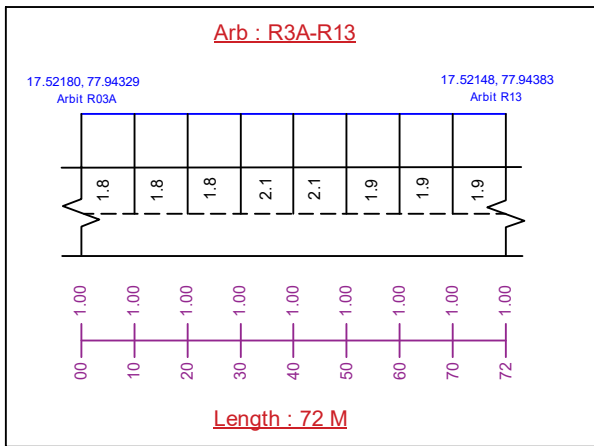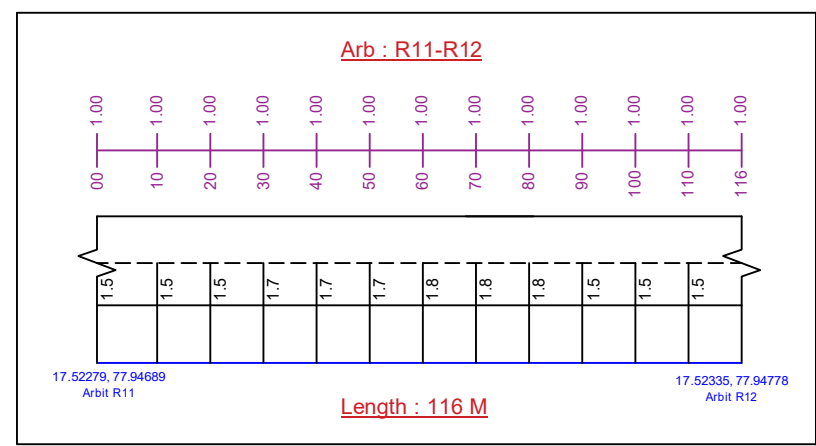

Checked	Designation	Signature


ROAD OFFSET DETAILING FOR TEKULAPALLE OHSR2 (MOMINPET)

Arb : R06-R15

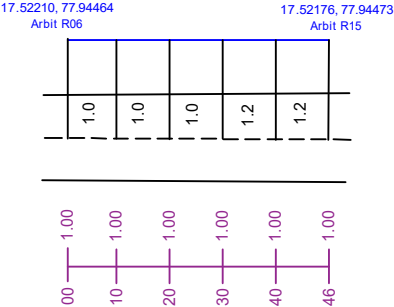


Length : 46 M

Arb : R15-R16

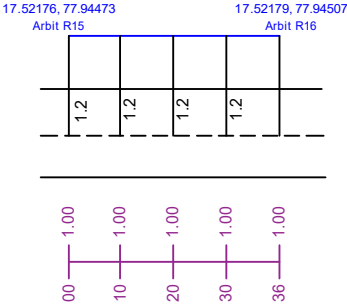


Length : 36 M

Arb : R07-R16

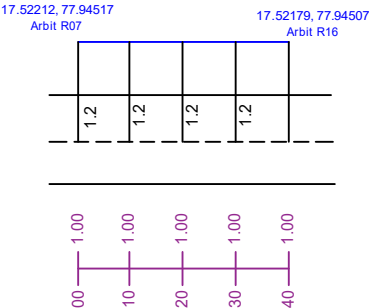


Length : 40 M

Arb : R13-R17

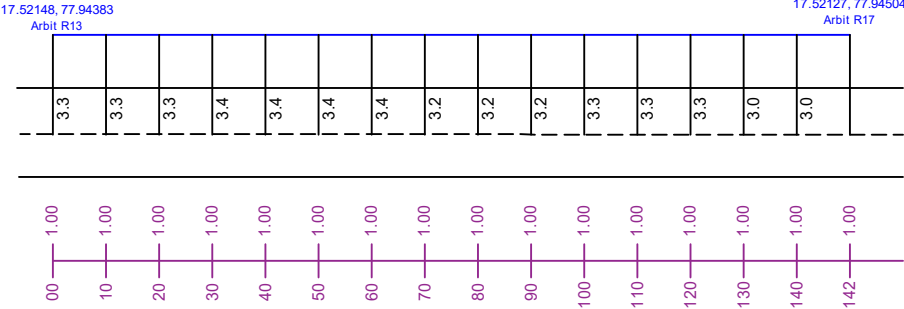

Length : 142 M

Arb : R17-R18

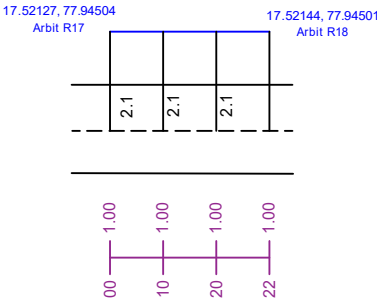


Length : 22 M

Checked	Designation	Signature


ROAD OFFSET DETAILING FOR TEKULAPALLE OHSR2 (MOMINPET)

Arb : R16-R18

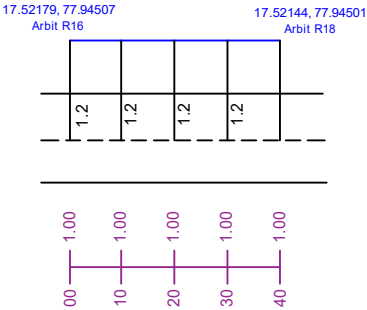


Length : 40 M

Arb : R18-R15

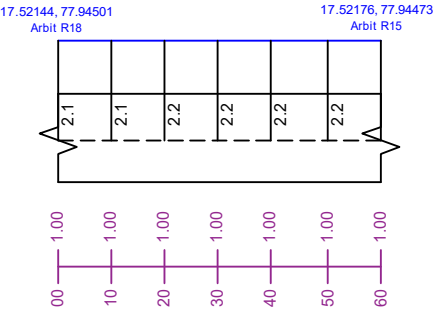


Length : 60 M

Arb : R17-R19

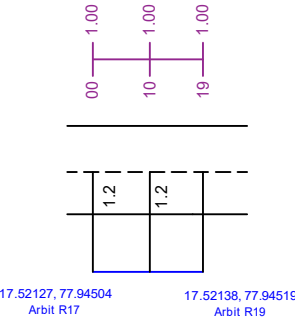


Length : 20 M

Arb : R19-R20

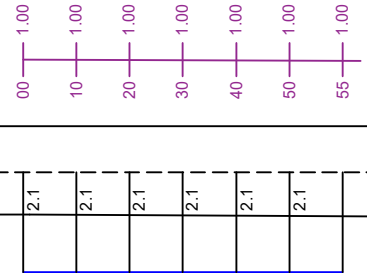


Length : 55 M

Arb : R20-R09

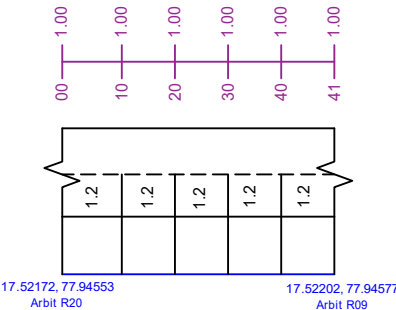

Length : 41 M

Arb : R19-R21

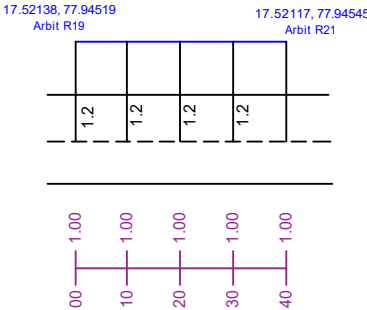


Length : 40 M

Checked	Designation	Signature


ROAD OFFSET DETAILING FOR TEKULAPALLE OHSR2 (MOMINPET)

Arb : R19-R21

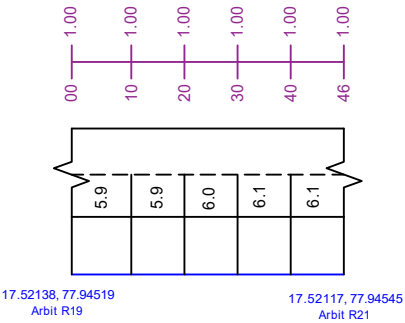


Length : 46 M

Arb : R20-R22

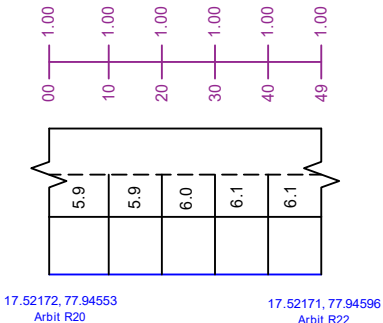


Length : 49 M

Arb : R10-R23

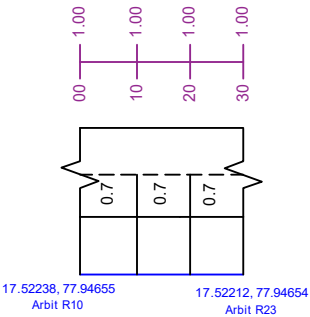

Length : 30 M



Arb : R11-R24

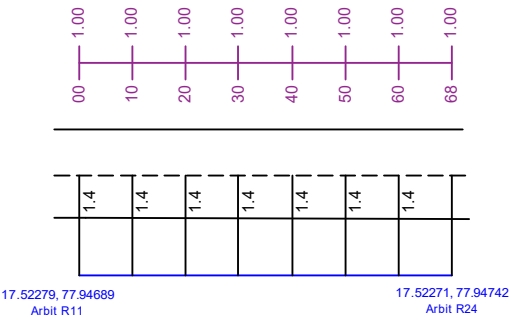







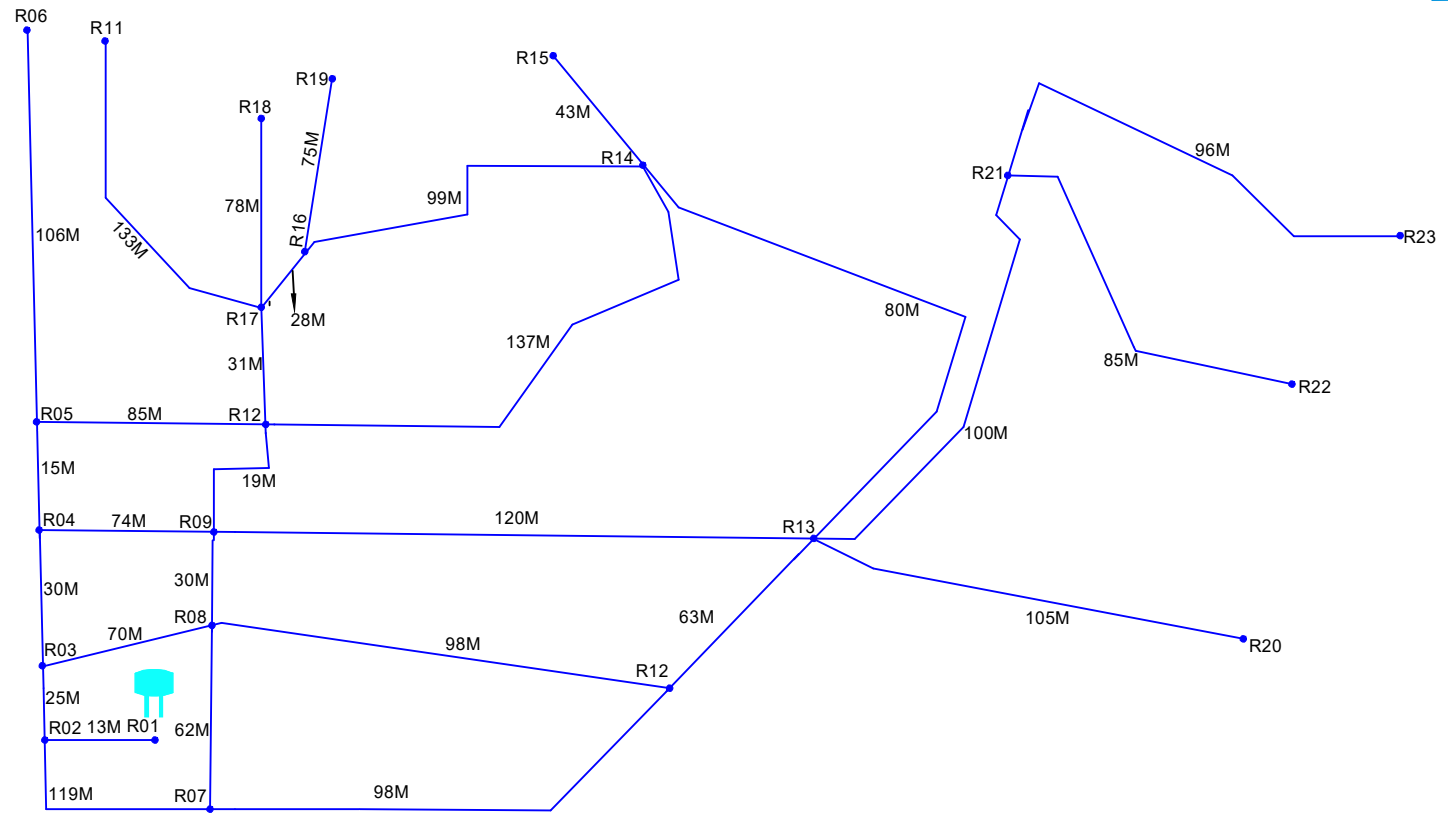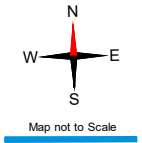

Length : 68 M

Checked	Designation	Signature

SINGLELINE LOOP DIAGRAM FOR TEKULAPALLE OHSR3 (MOMINPET)






 






	DUCT PIPE
	ROAD
	OHSR
	G.P OFFICE
	TEMPLE
	HOSPITAL
	SCHOOL
	DUCT GAP

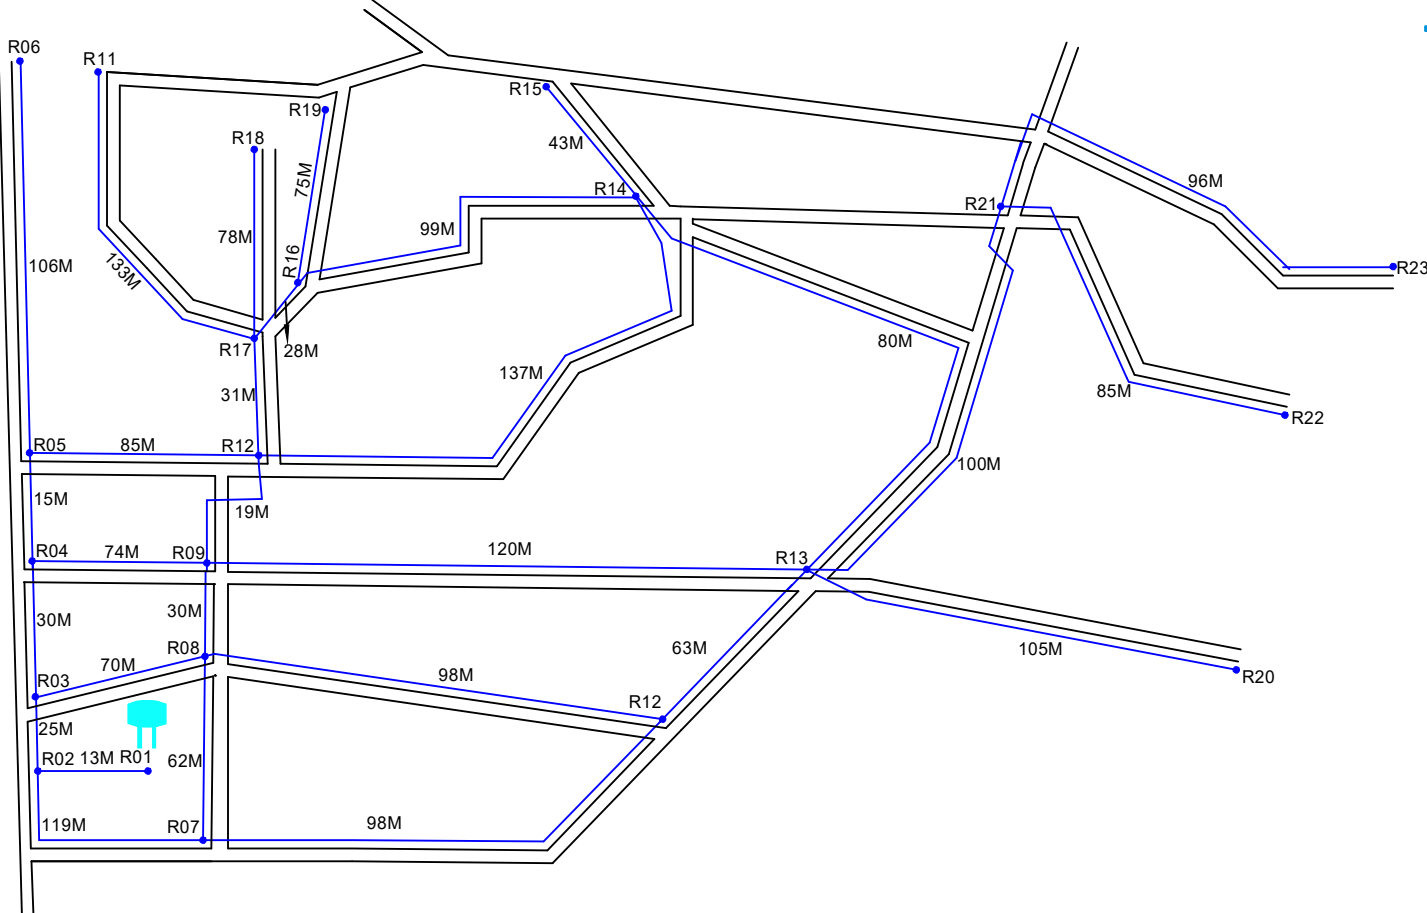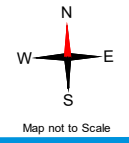Checked	Designation	Signature

Sheet No. 01
Route Distance : 6027 M

DUCTLAYING ROUTE DIAGRAM FOR TEKULAPALLE OHSR3 (MOMINPET)




	DUCT PIPE
	ROAD
	OHSR
	G.P OFFICE
	TEMPLE
	HOSPITAL
	SCHOOL
	DUCT GAP

Checked	Designation	Signature


Sheet No. 01
Route Distance : 6027 M

ROAD OFFSET DETAILING FOR TEKULAPALLE OHSR3 (MOMINPET)


Arb : R01-R02

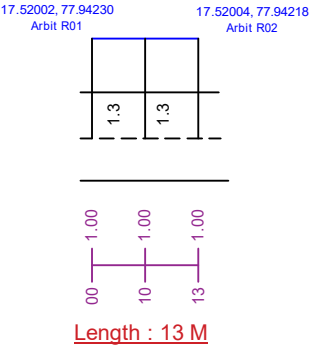


Arb : R02-R03

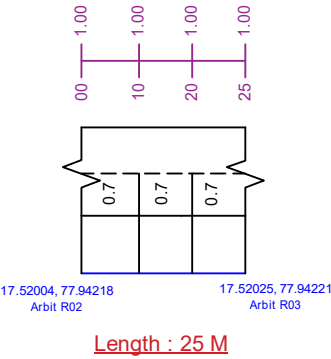


Arb : R03-R04

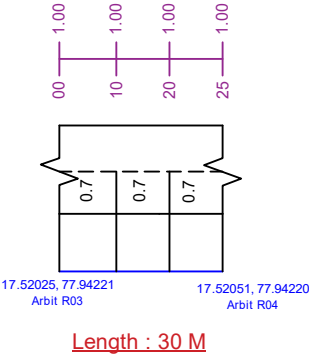


Arb : R04-R05

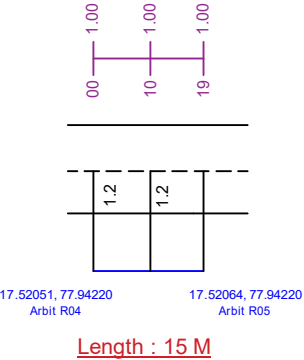

Arb : R05-R06

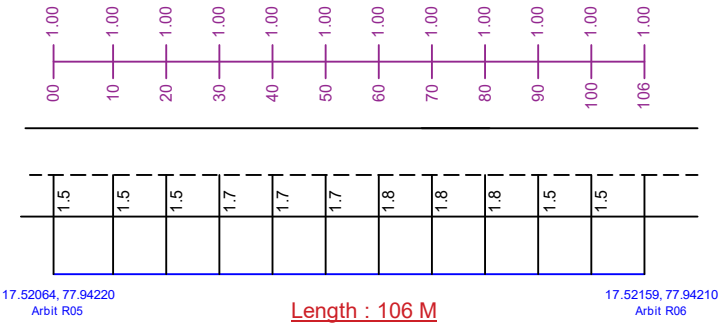


Arb : R02-R07

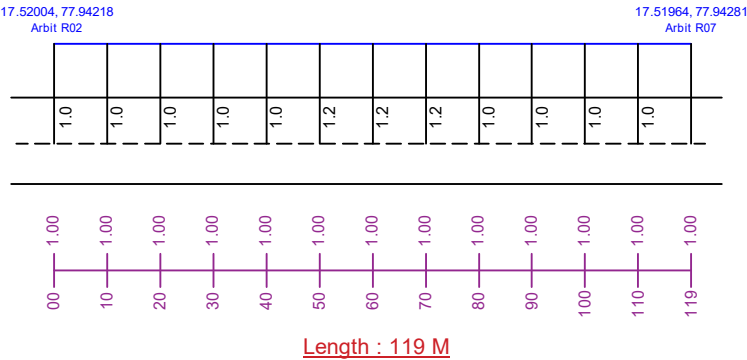

Checked	Designation	Signature


ROAD OFFSET DETAILING FOR TEKULAPALLE OHSR3 (MOMINPET)

Arb : R07-R08

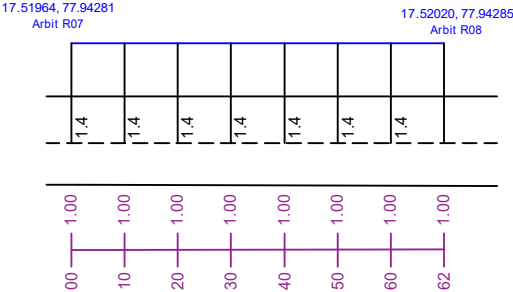


Length : 62 M

Arb : R08-R09

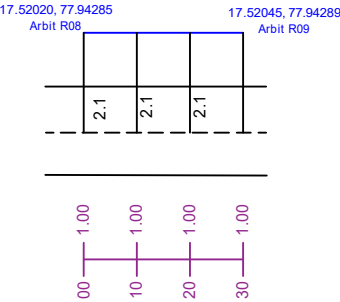


Length : 30 M

Arb : R09-R10

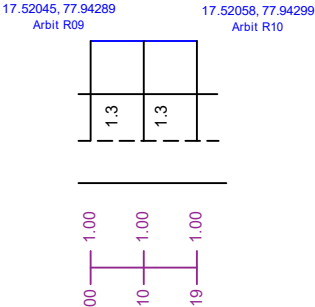


Length : 19 M

Arb : R10-R17

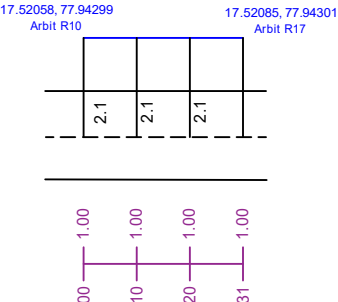


Length : 31 M

Arb : R17-R18

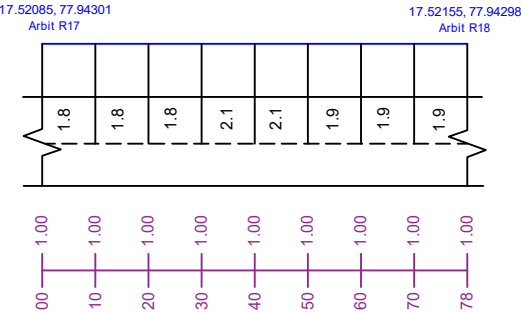


Length : 78 M

Arb : R03-R08

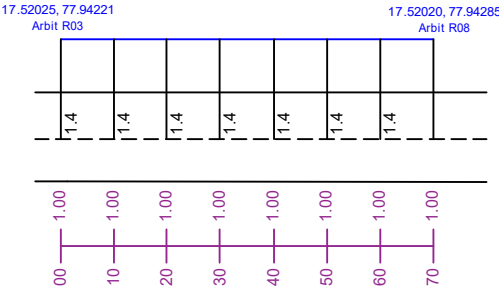

Length : 70 M

Arb : R04-R09

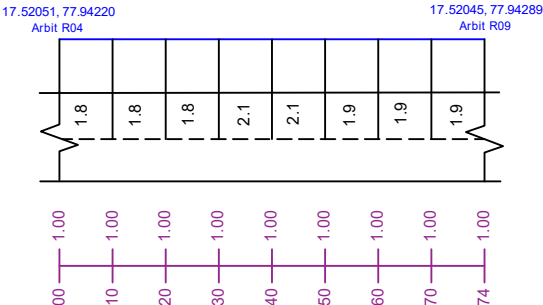


Length : 74 M


Checked	Designation	Signature

ROAD OFFSET DETAILING FOR TEKULAPALLE OHSR3 (MOMINPET)


Arb : R05-R10

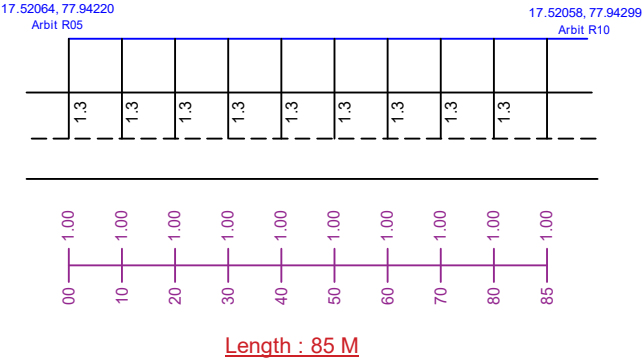


Arb : R17-R16

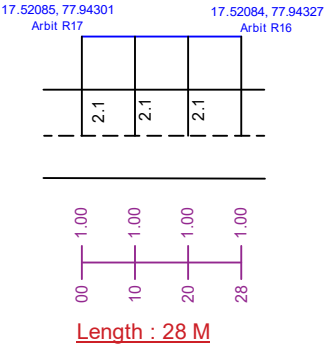


Arb : R16-R19

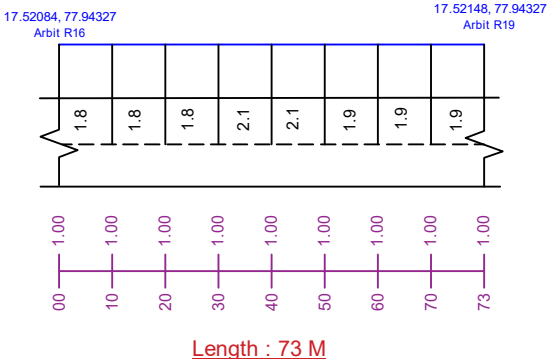

Arb : R17-R11

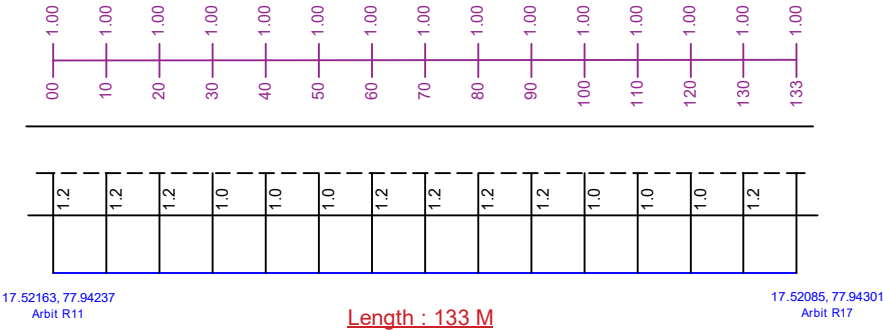


Arb : R07-R12

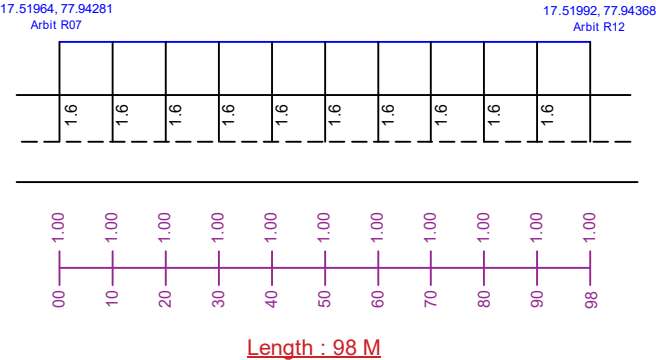


Checked	Designation	Signature

ROAD OFFSET DETAILING FOR TEKULAPALLE OHSR3 (MOMINPET)


Arb : R12-R13

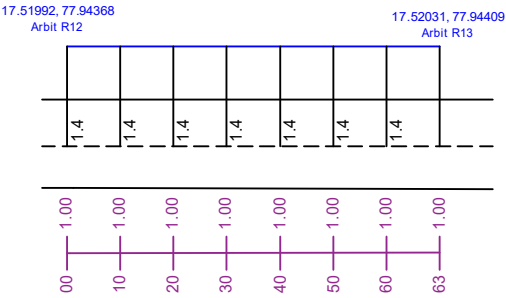


Arb : R13-R14

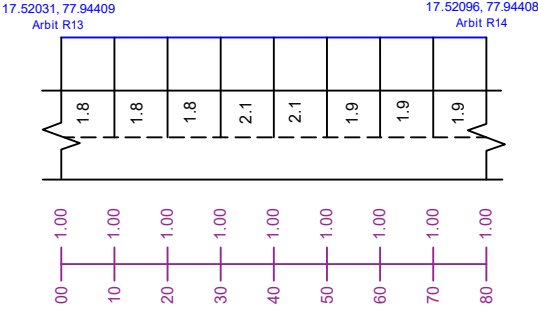


Arb : R14-R15

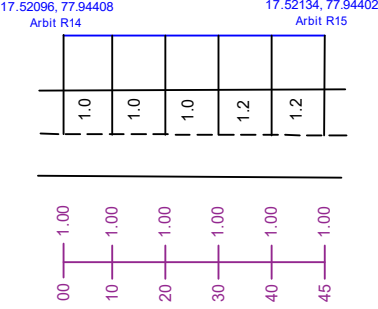

Arb : R08-R12

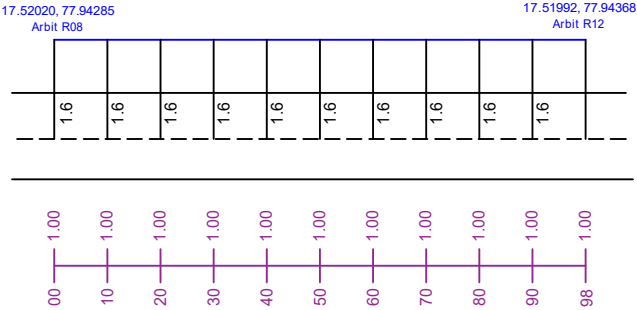


Arb : R09-R13

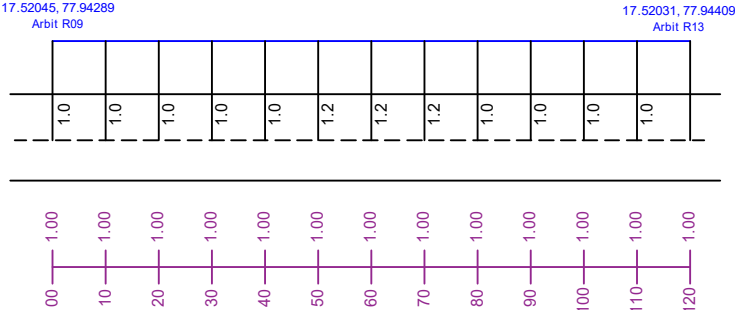


Checked	Designation	Signature

ROAD OFFSET DETAILING FOR TEKULAPALLE OHSR3 (MOMINPET)


Arb : R16-R14

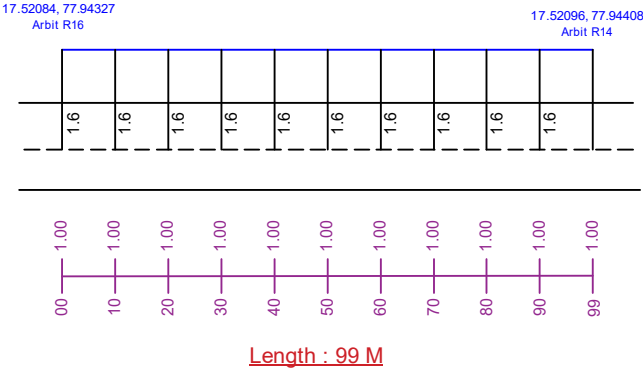


Arb : R13-R20

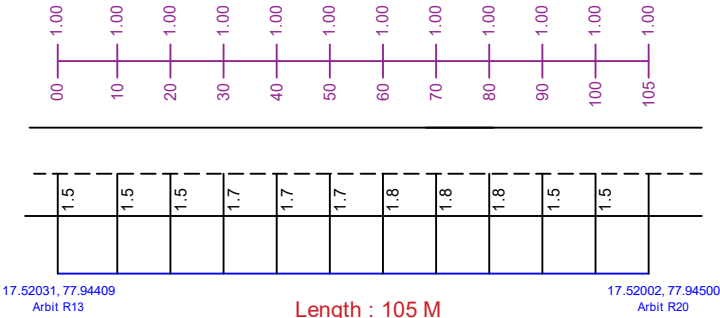

Arb : R13-R21

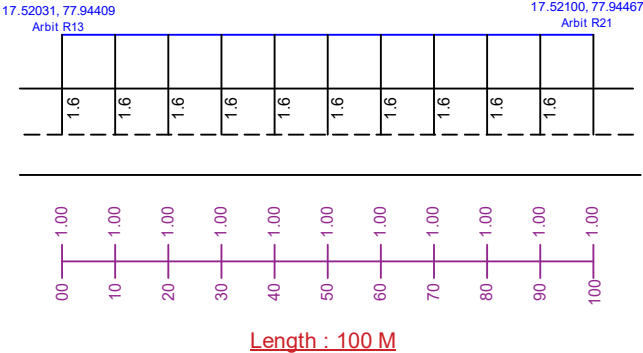


Arb : R21-R22

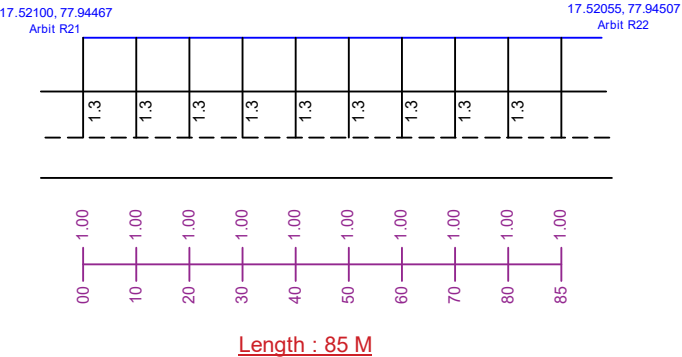

Checked	Designation	Signature

ROAD OFFSET DETAILING FOR TEKULAPALLE OHSR3 (MOMINPET)

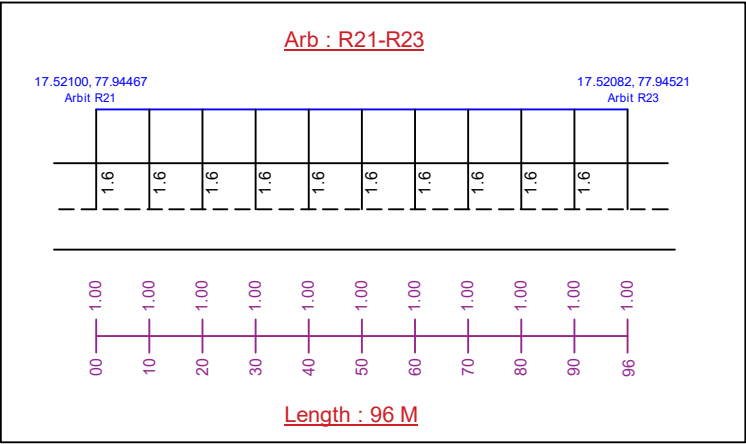

Sheet No. 06
Route Distance : 6027 M

Checked	Designation	Signature



TELANGANA FIBER GRID

TELANGANA FIBER GRID

ITE & C GOVERNMENT OF TELANGANA

7th Floor, Splendid Towers, S.P. Road

Opp: Begumpet Police Station,



Begumpet, Hyderabad-500016.

AS - BUILT DRAWINGS (ABD)

VELCHAL

(MOMINPET MANDAL-VIKARABAD DIST.)

SINGLELINE LOOP DIAGRAM FOR VELCHAL OHSR1 (MOMINPET)

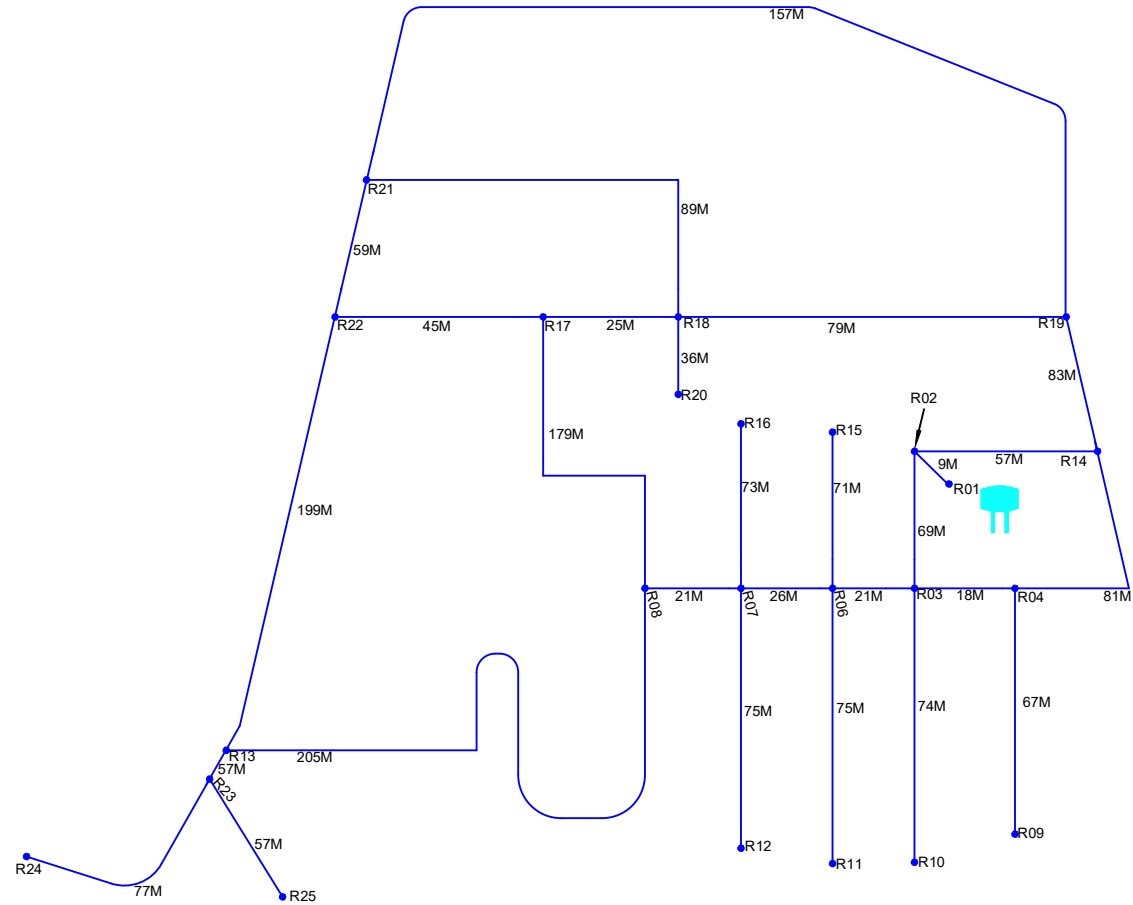
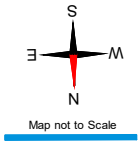



 






	DUCT PIPE
	ROAD
	OHSR
	G.P OFFICE
	TEMPLE
	HOSPITAL
	SCHOOL
	DUCT GAP

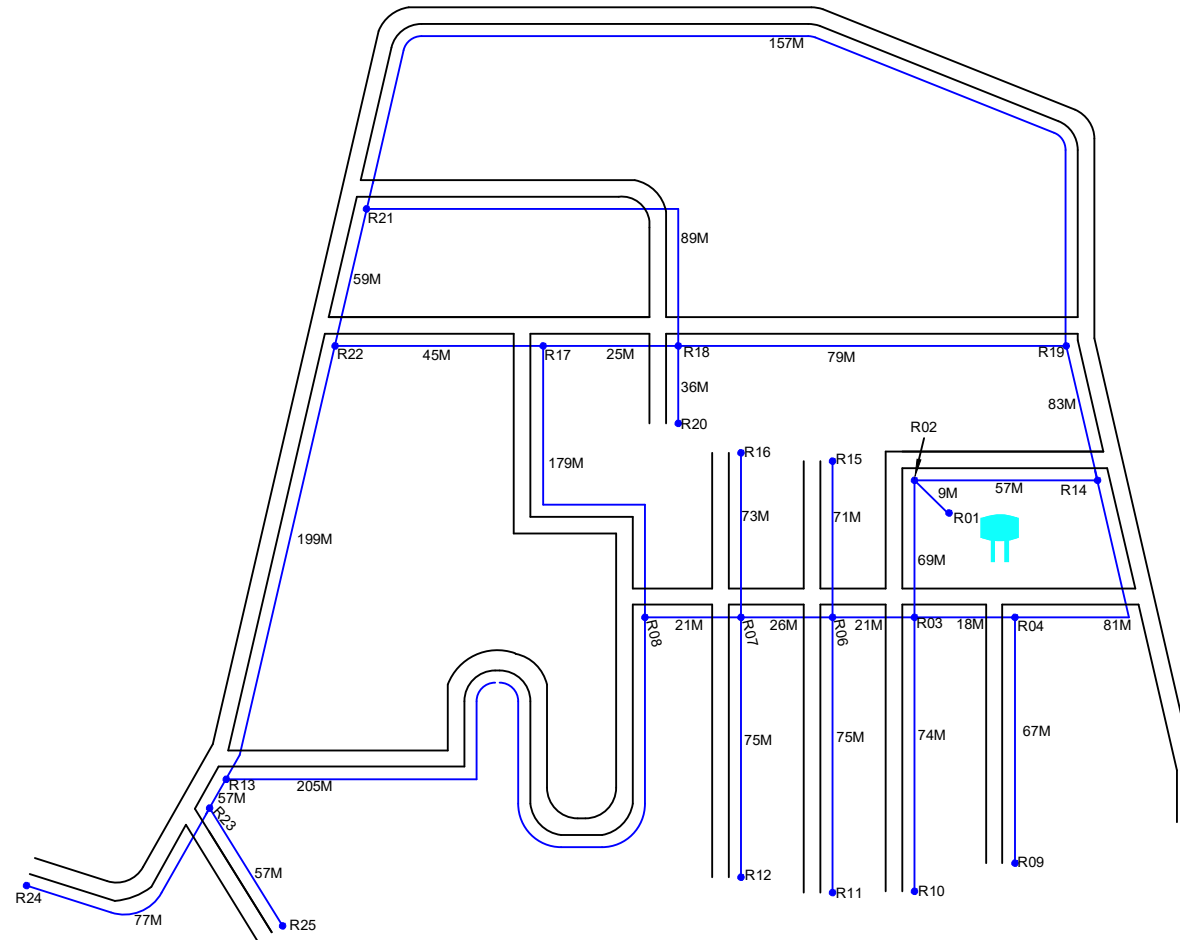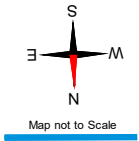Checked	Designation	Signature

Sheet No. 01
Route Distance : 3519 M

DUCTLAYING ROUTE DIAGRAM FOR VELCHAL OHSR1 (MOMINPET)




	DUCT PIPE
	ROAD
	OHSR
	G.P OFFICE
	TEMPLE
	HOSPITAL
	SCHOOL
	DUCT GAP

Checked	Designation	Signature

Sheet No. 01
Route Distance : 3519 M


ROAD OFFSET DETAILING FOR VELCHAL OHSR1 (MOMINPET)

Arb : R01-R02

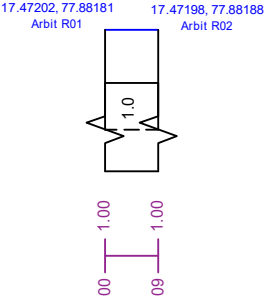


Length : 09 M

Arb : R02-R03

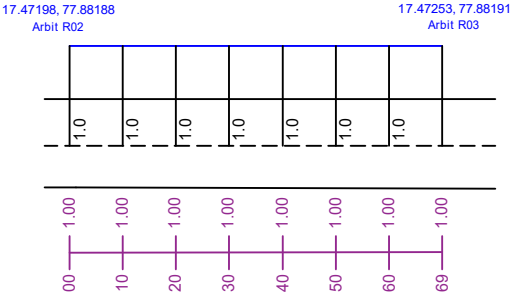


Length : 69 M

Arb : R03-R04

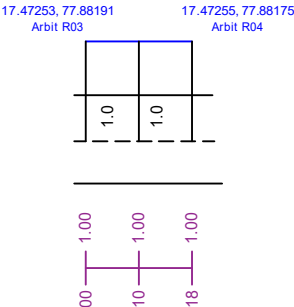


Length : 18 M

Arb : R04-R05

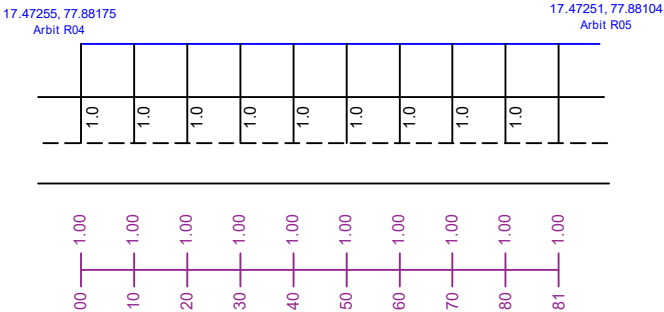


Length : 81 M

Arb : R03-R06

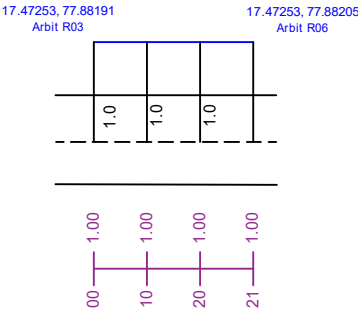

Length : 21 M

Arb : R06-R07

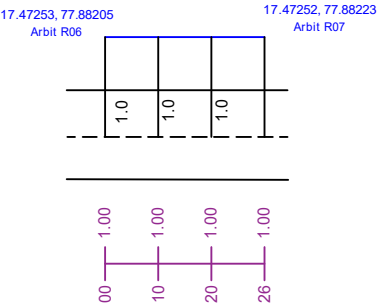


Length : 26 M


Checked	Designation	Signature

ROAD OFFSET DETAILING FOR VELCHAL OHSR1 (MOMINPET)


Arb : R07-R08

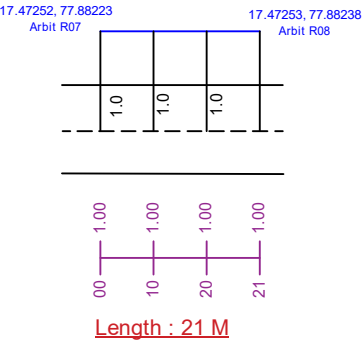


Arb : R04-R09

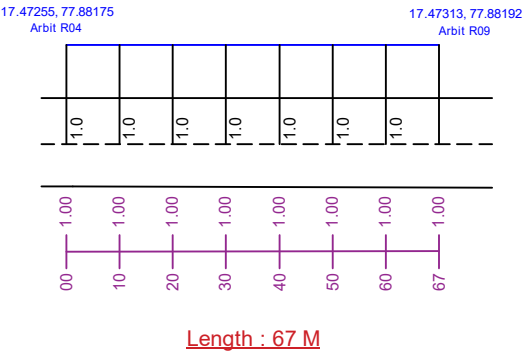


Arb : R03-R10

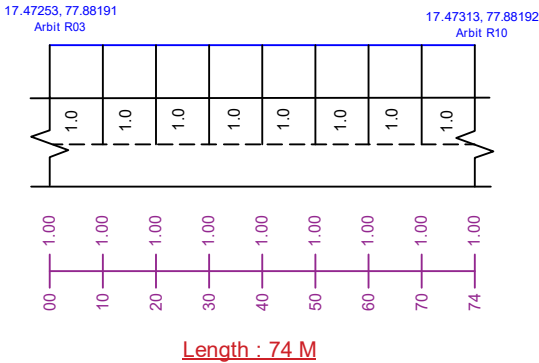

Arb : R06-R11




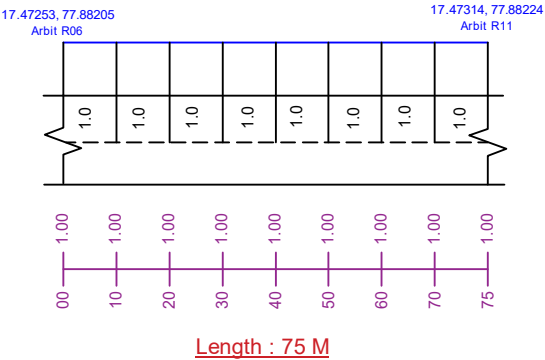


Arb : R07-R12

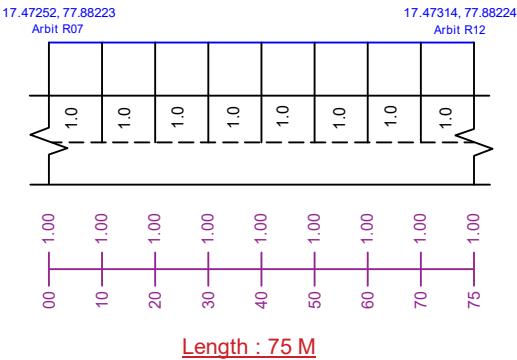

Checked	Designation	Signature


ROAD OFFSET DETAILING FOR VELCHAL OHSR1 (MOMINPET)

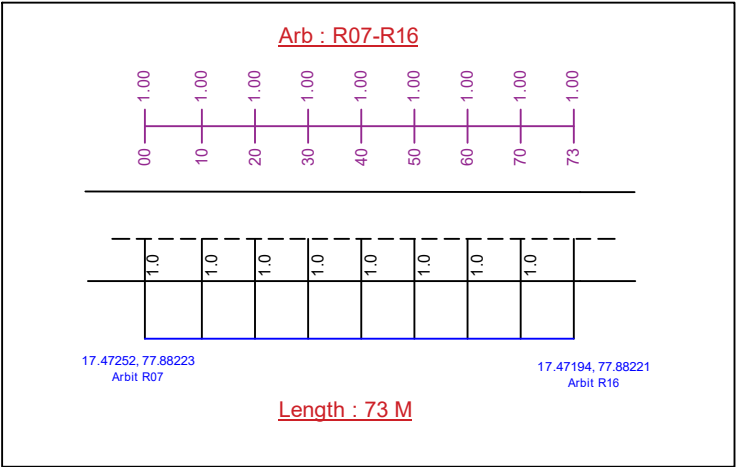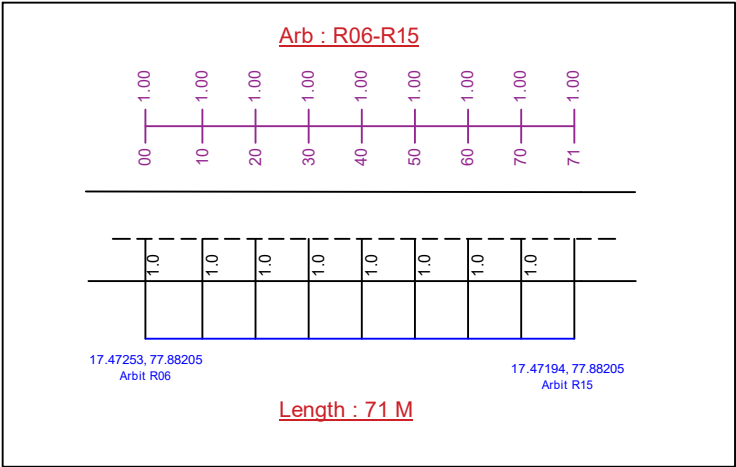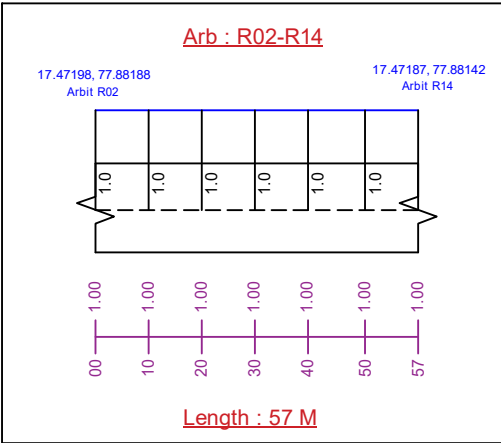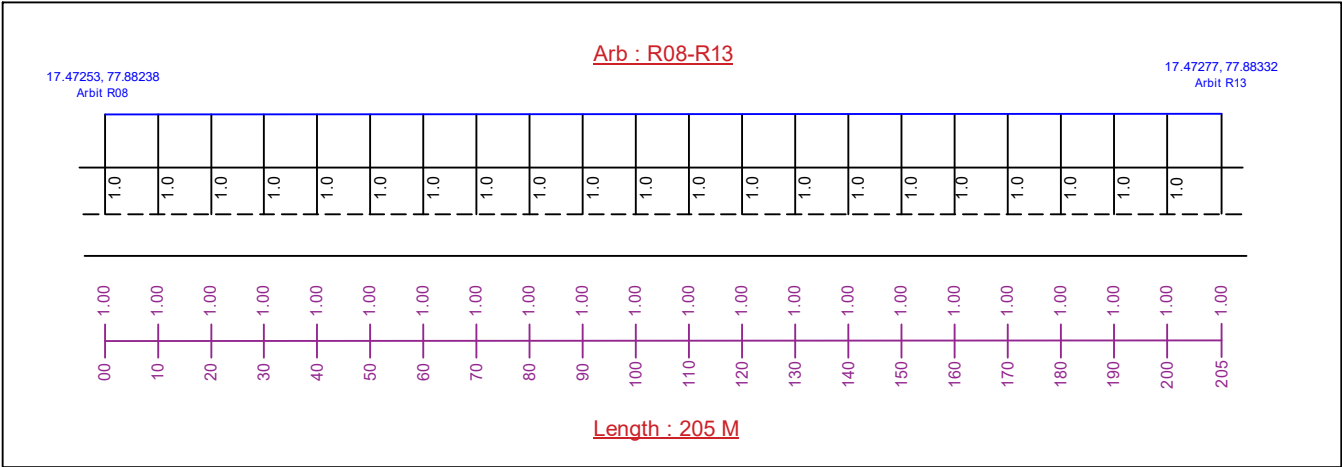


Checked	Designation	Signature

ROAD OFFSET DETAILING FOR VELCHAL OHSR1 (MOMINPET)


Arb : R08-R17

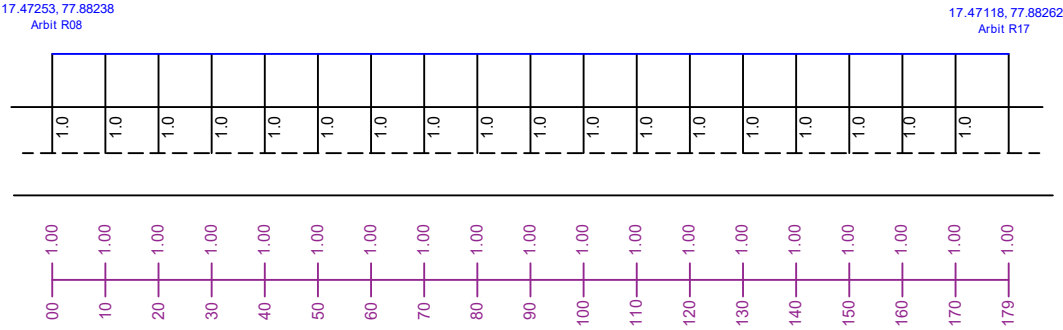


Arb : R17-R18

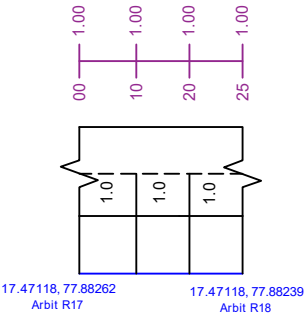

Arb : R18-R19

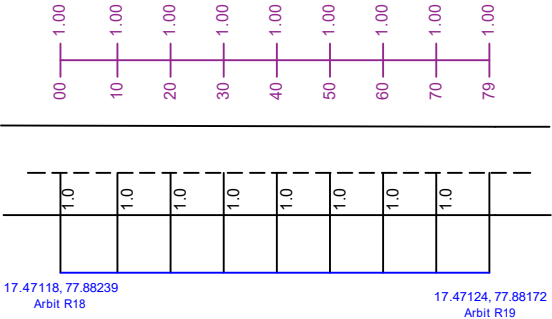


Arb : R18-R20

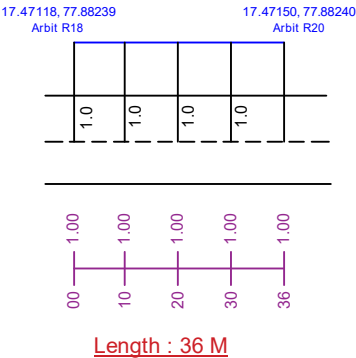


Checked	Designation	Signature

ROAD OFFSET DETAILING FOR VELCHAL OHSR1 (MOMINPET)


Arb : R18-R21

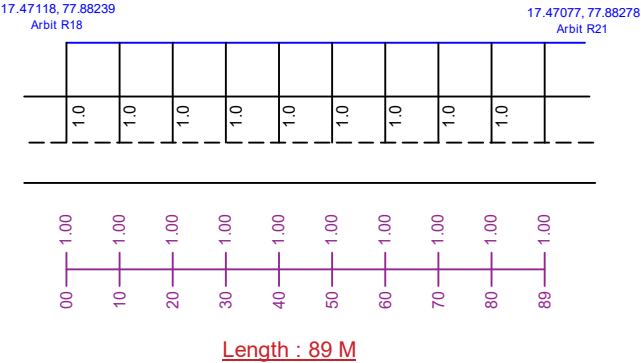


Arb : R17-R22

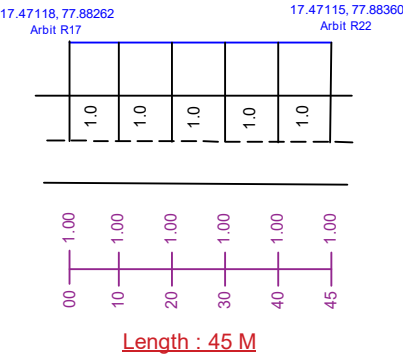

Arb : R22-R13





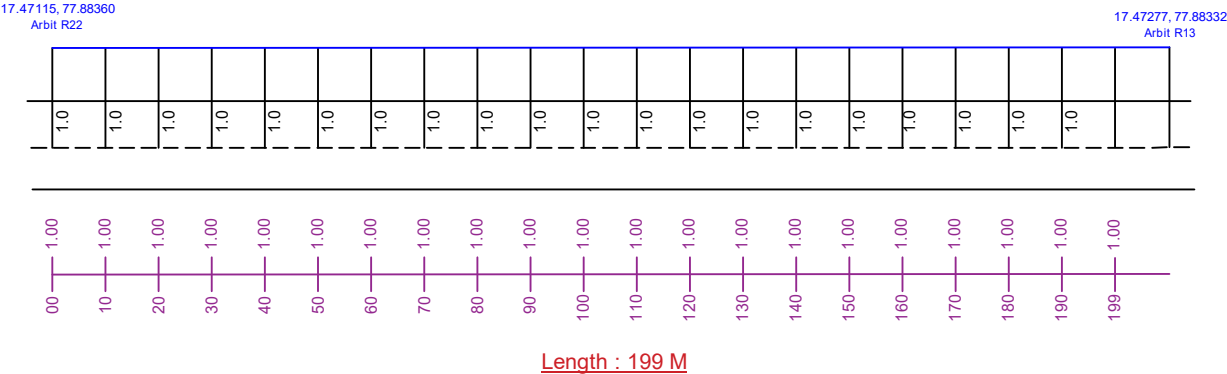


Arb : R22-R21

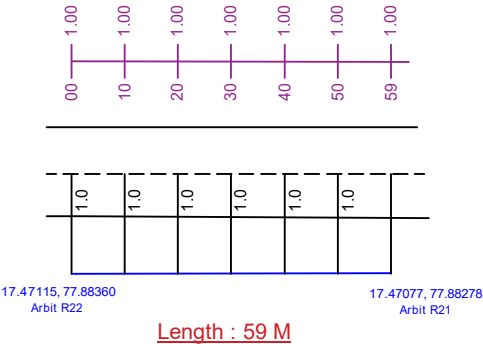


Checked	Designation	Signature

ROAD OFFSET DETAILING FOR VELCHAL OHSR1 (MOMINPET)

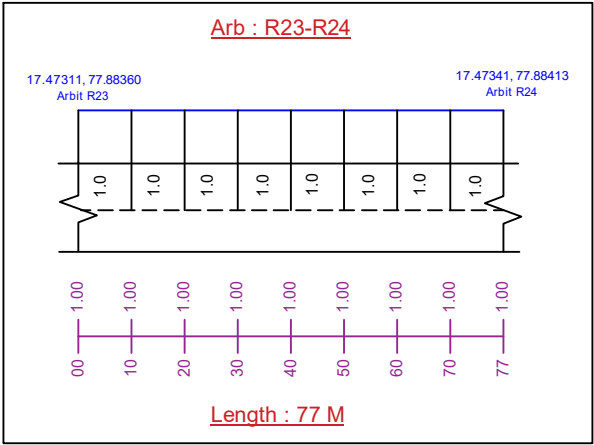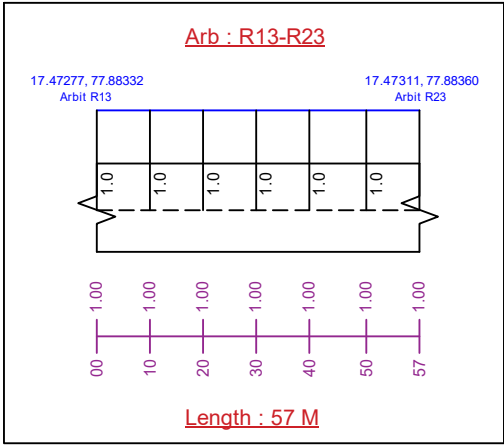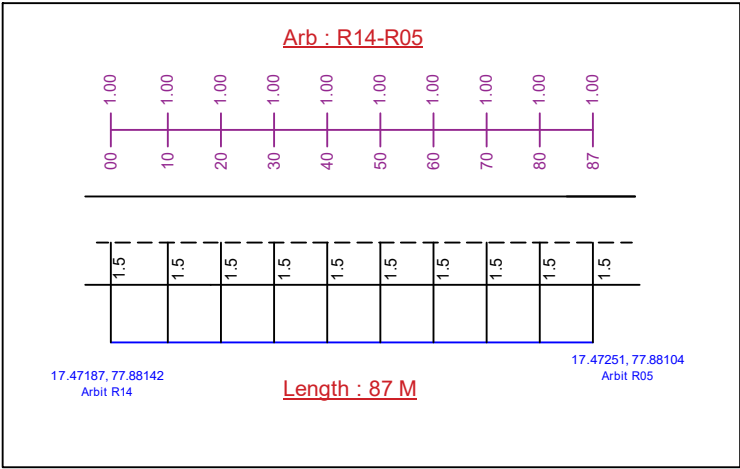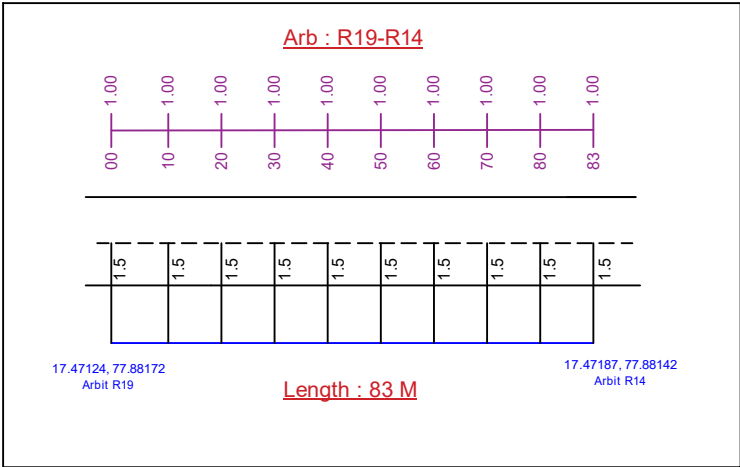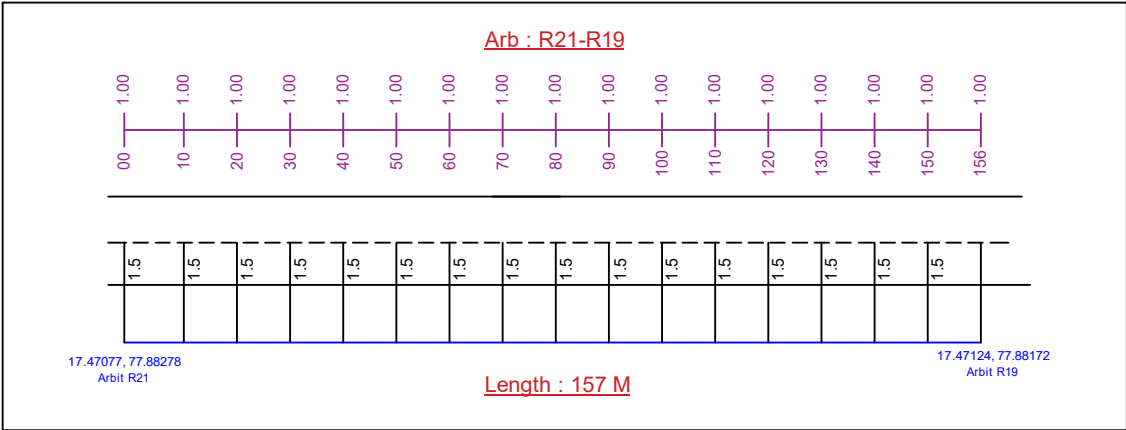

Checked	Designation	Signature



ROAD OFFSET DETAILING FOR VELCHAL OHSR1 (MOMINPET)

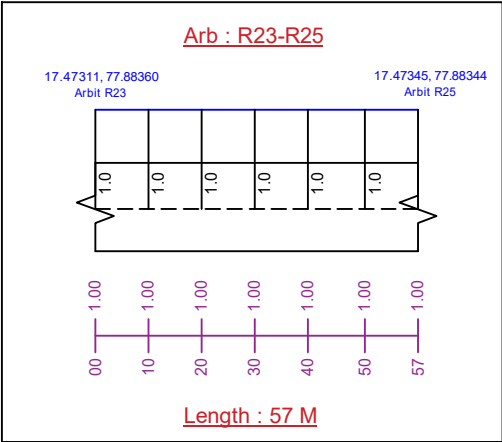
 






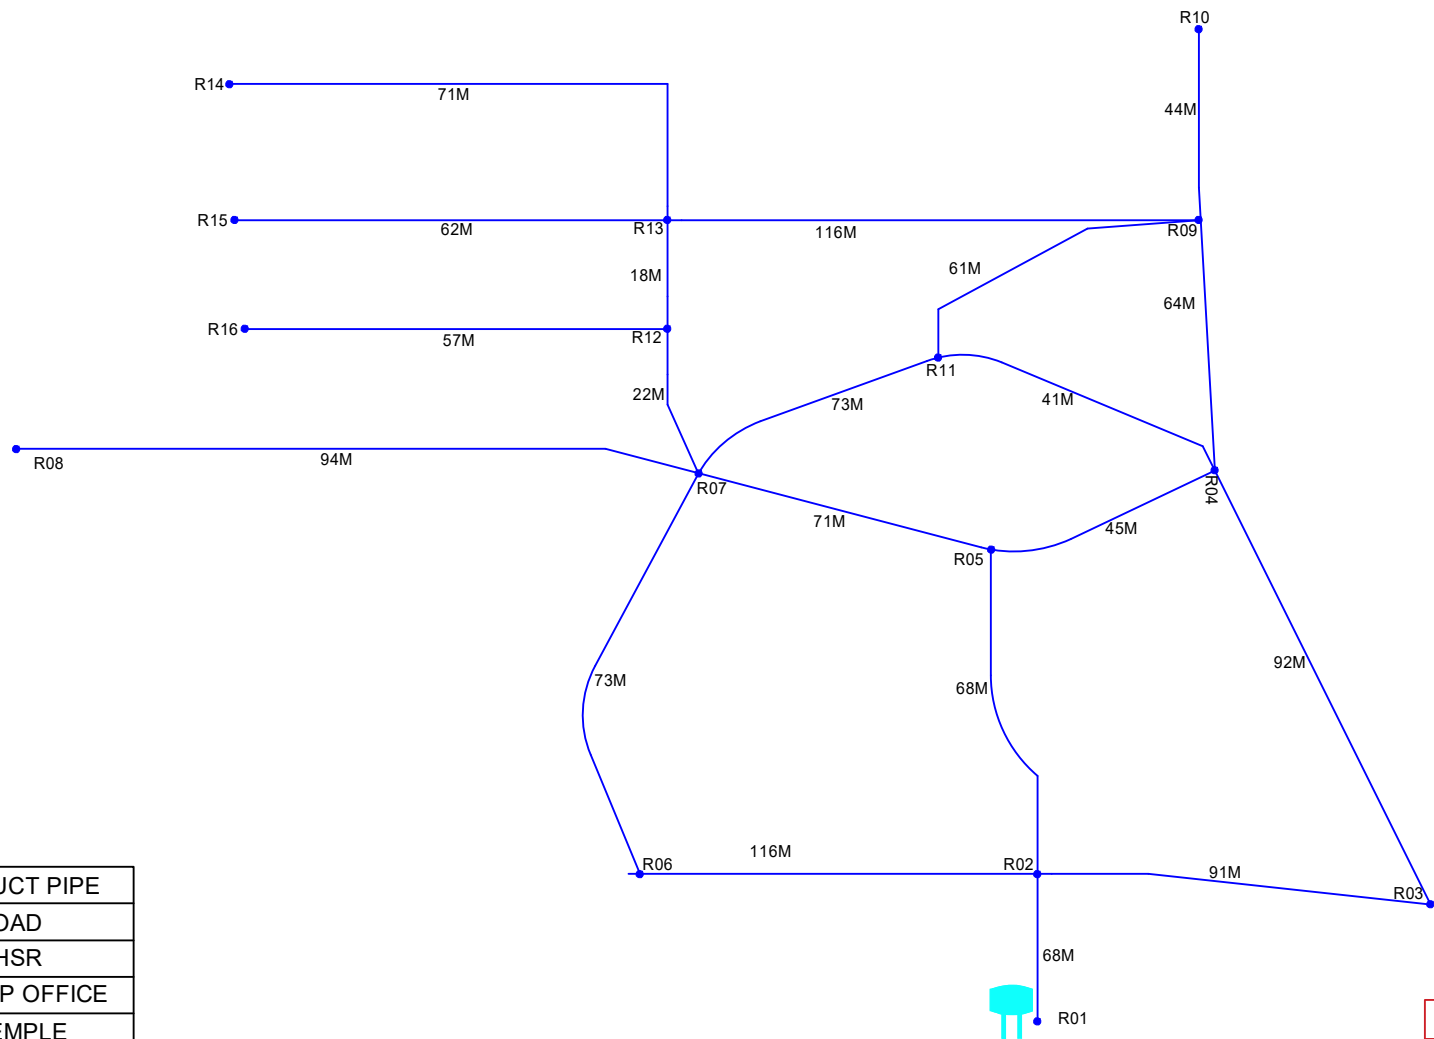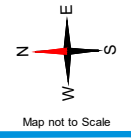

Sheet No. 07
Route Distance : 3519 M

Checked	Designation	Signature

SINGLELINE LOOP DIAGRAM FOR VELCHAL OHSR2 (MOMINPET)











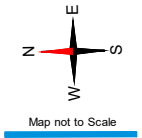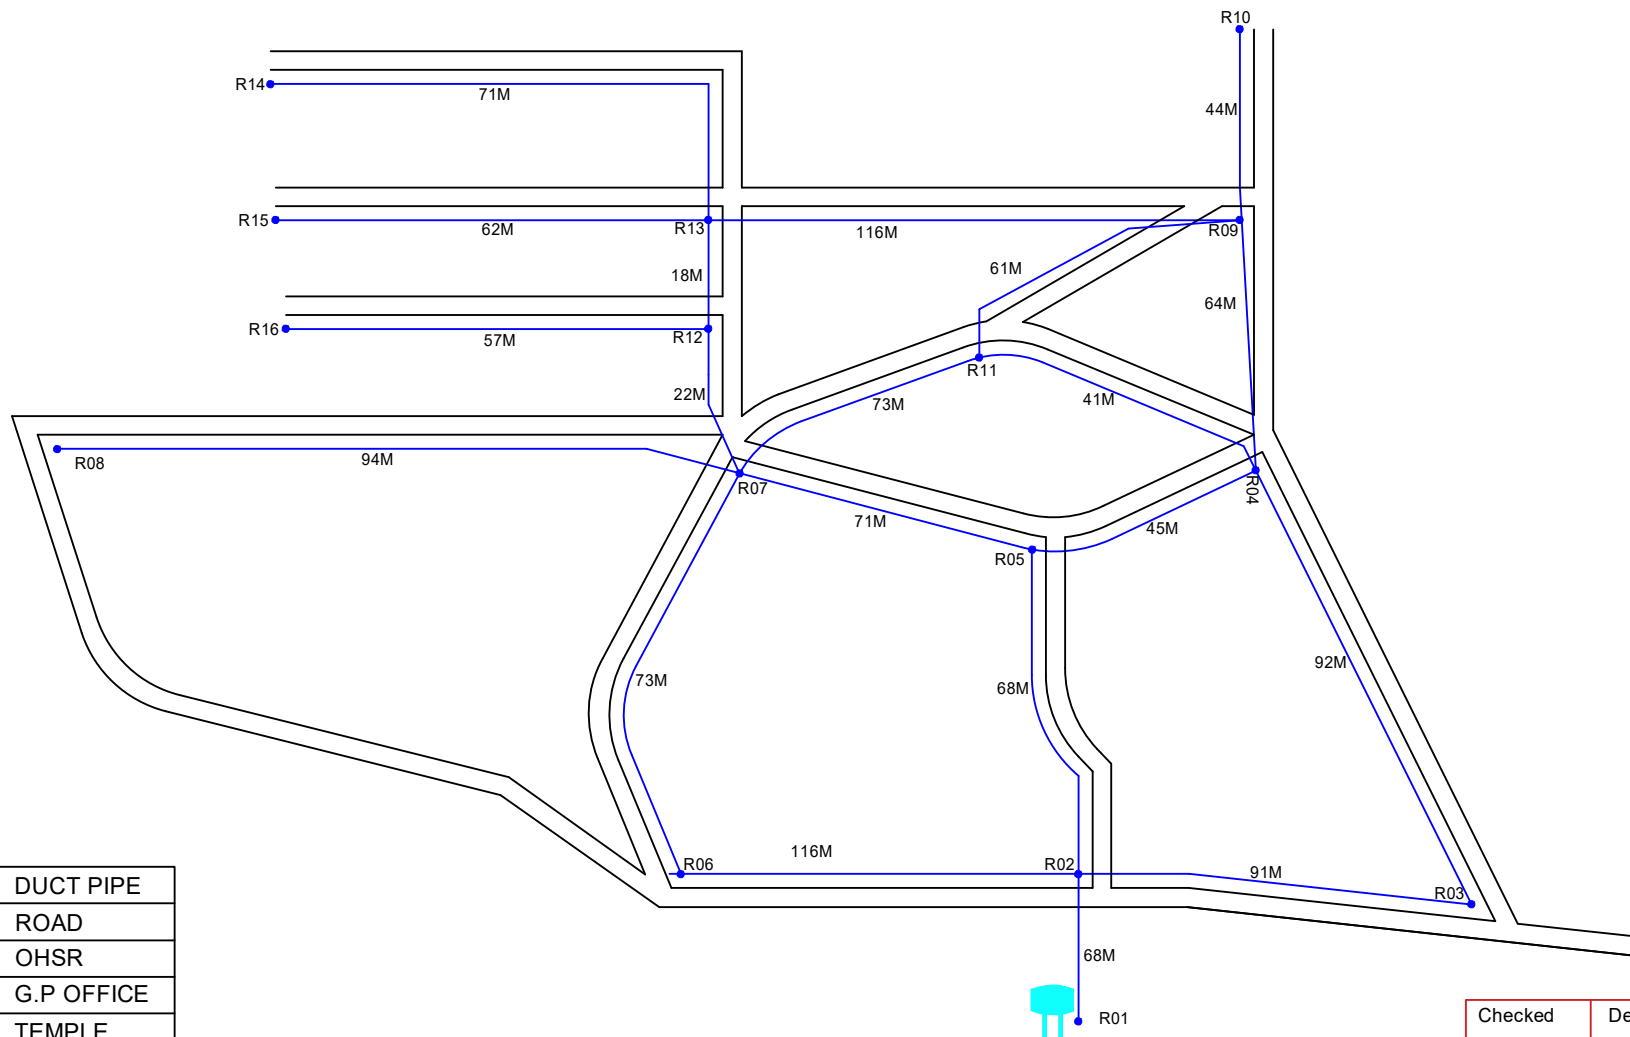

	DUCT PIPE
	ROAD
	OHSR
	G.P OFFICE
	TEMPLE
	HOSPITAL
	SCHOOL
	DUCT GAP

Sheet No. 01
Route Distance : 3519 M

Checked	Designation	Signature

DUCTLAYING ROUTE DIAGRAM FOR VELCHAL OHSR2 (MOMINPET)




	DUCT PIPE
	ROAD
	OHSR
	G.P OFFICE
	TEMPLE
	HOSPITAL
	SCHOOL
	DUCT GAP

Sheet No. 01
Route Distance : 3519 M


Checked	Designation	Signature

ROAD OFFSET DETAILING FOR VELCHAL OHSR2 (MOMINPET)


Arb : R01-R02

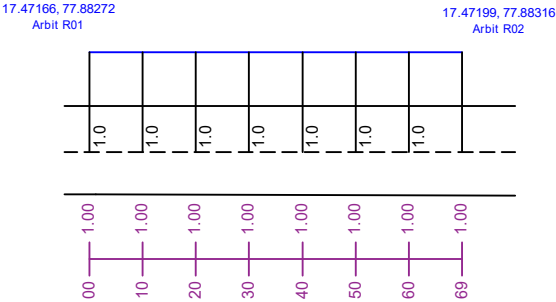


Arb : R02-R03

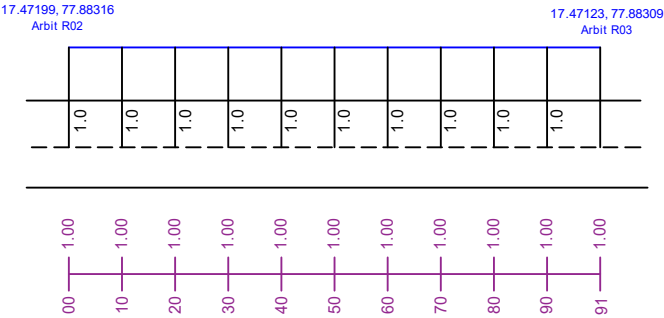


Arb : R03-R04

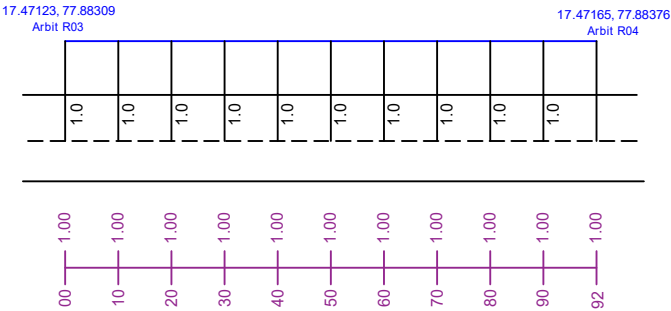

Arb : R04-R05




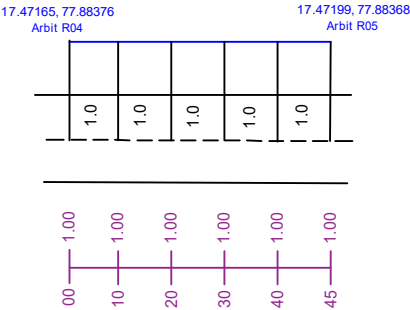


Arb : R02-R05

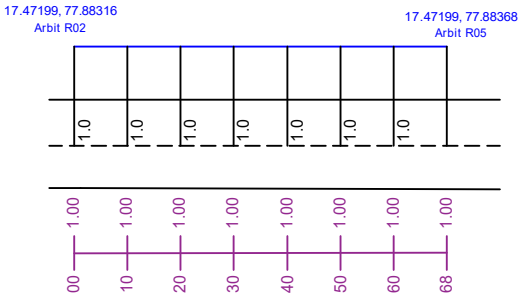

Checked	Designation	Signature


ROAD OFFSET DETAILING FOR VELCHAL OHSR2 (MOMINPET)

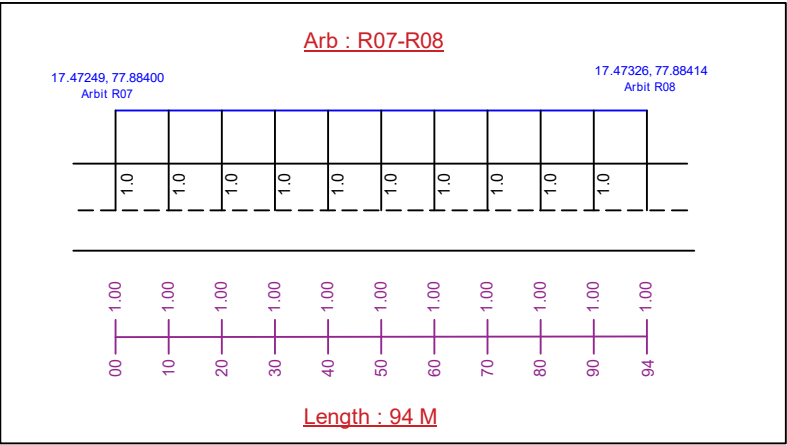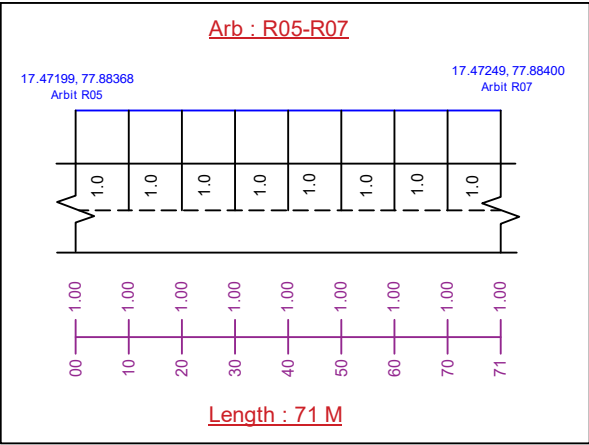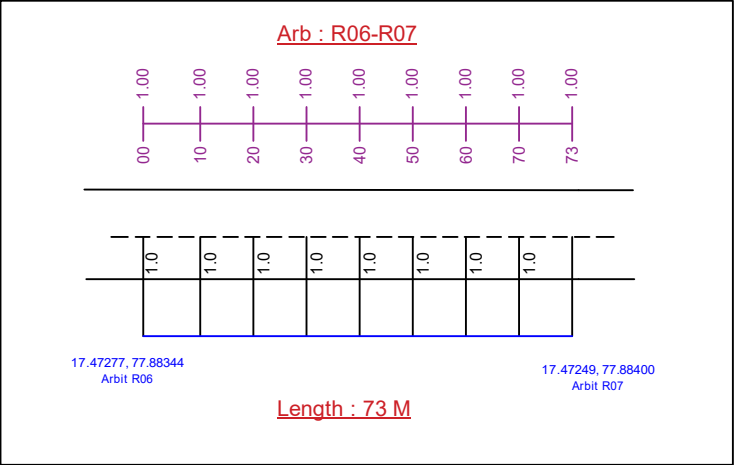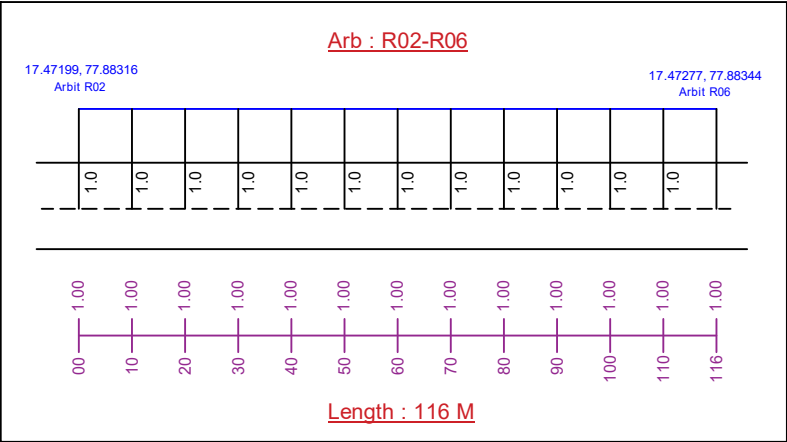

Checked	Designation	Signature


ROAD OFFSET DETAILING FOR VELCHAL OHSR2 (MOMINPET)

Arb : R04-R09

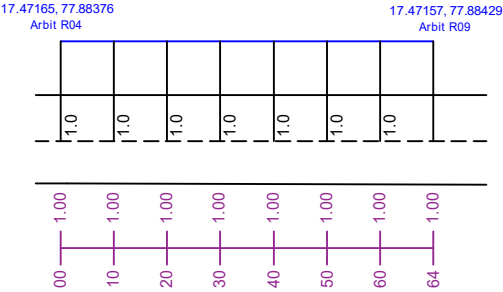


Length : 64 M

Arb : R09-R10

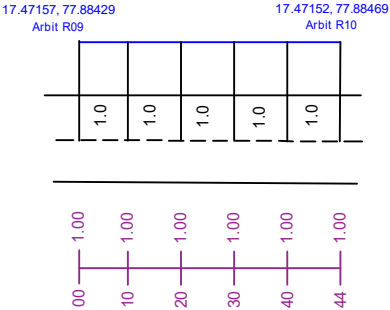


Length : 44 M

Arb : R09-R11

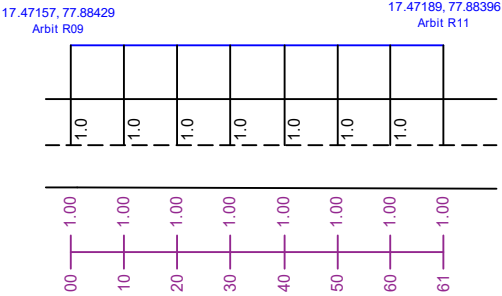


Length : 61 M

Arb : R04-R11

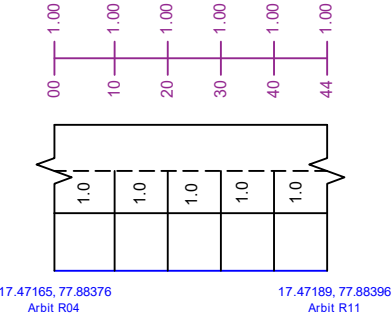


Length : 44 M

Arb : R11-R07

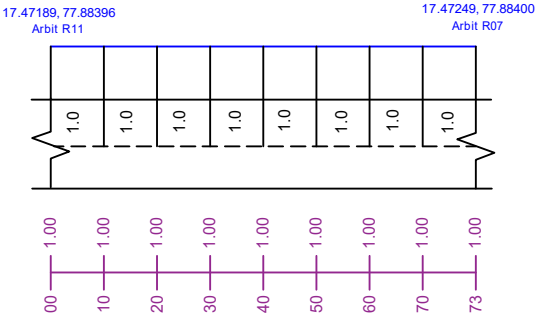

Length : 73 M

Arb : R07-R12

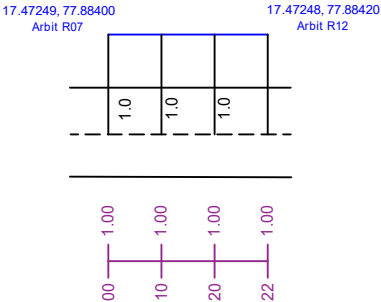

Length : 22 M



Checked	Designation	Signature

ROAD OFFSET DETAILING FOR VELCHAL OHSR2 (MOMINPET)

Arb : R12-R13

17.47248, 77.88420
Arbit R12

17.47247, 77.88435
Arbit R13

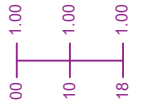
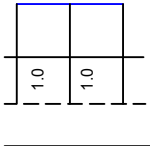


Length : 18 M

Arb : R13-R14

17.47247, 77.88435
Arbit R13

17.47290, 77.88456
Arbit R14

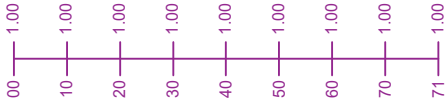
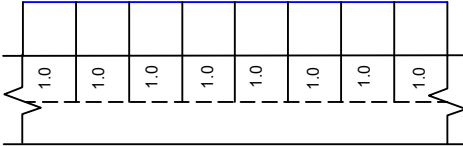


Length : 71 M

Arb : R12-R16

17.47248, 77.88420
Arbit R12

17.47294, 77.88427
Arbit R16

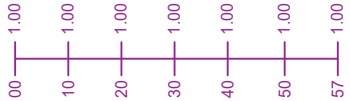
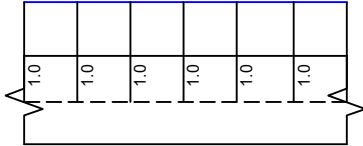


Length : 57 M

Arb : R13-R15

17.47247, 77.88435
Arbit R13

17.47293, 77.88441
Arbit R15

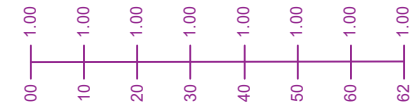
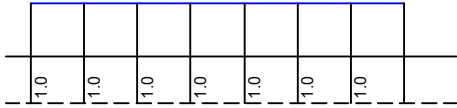


Length : 62 M

Arb : R09-R13

17.47157, 77.88429
Arbit R09

17.47247, 77.88435
Arbit R13

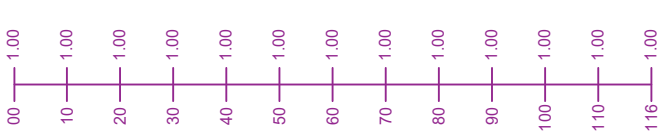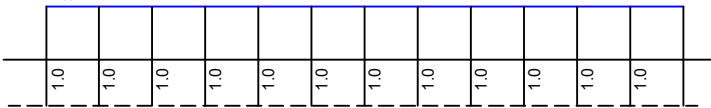

Length : 116 M

Checked	Designation	Signature



TELANGANA FIBER GRID

TELANGANA FIBER GRID

ITE & C GOVERNMENT OF TELANGANA

7th Floor, Splendid Towers, S.P. Road

Opp: Begumpet Police Station,



Begumpet, Hyderabad-500016.







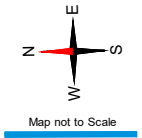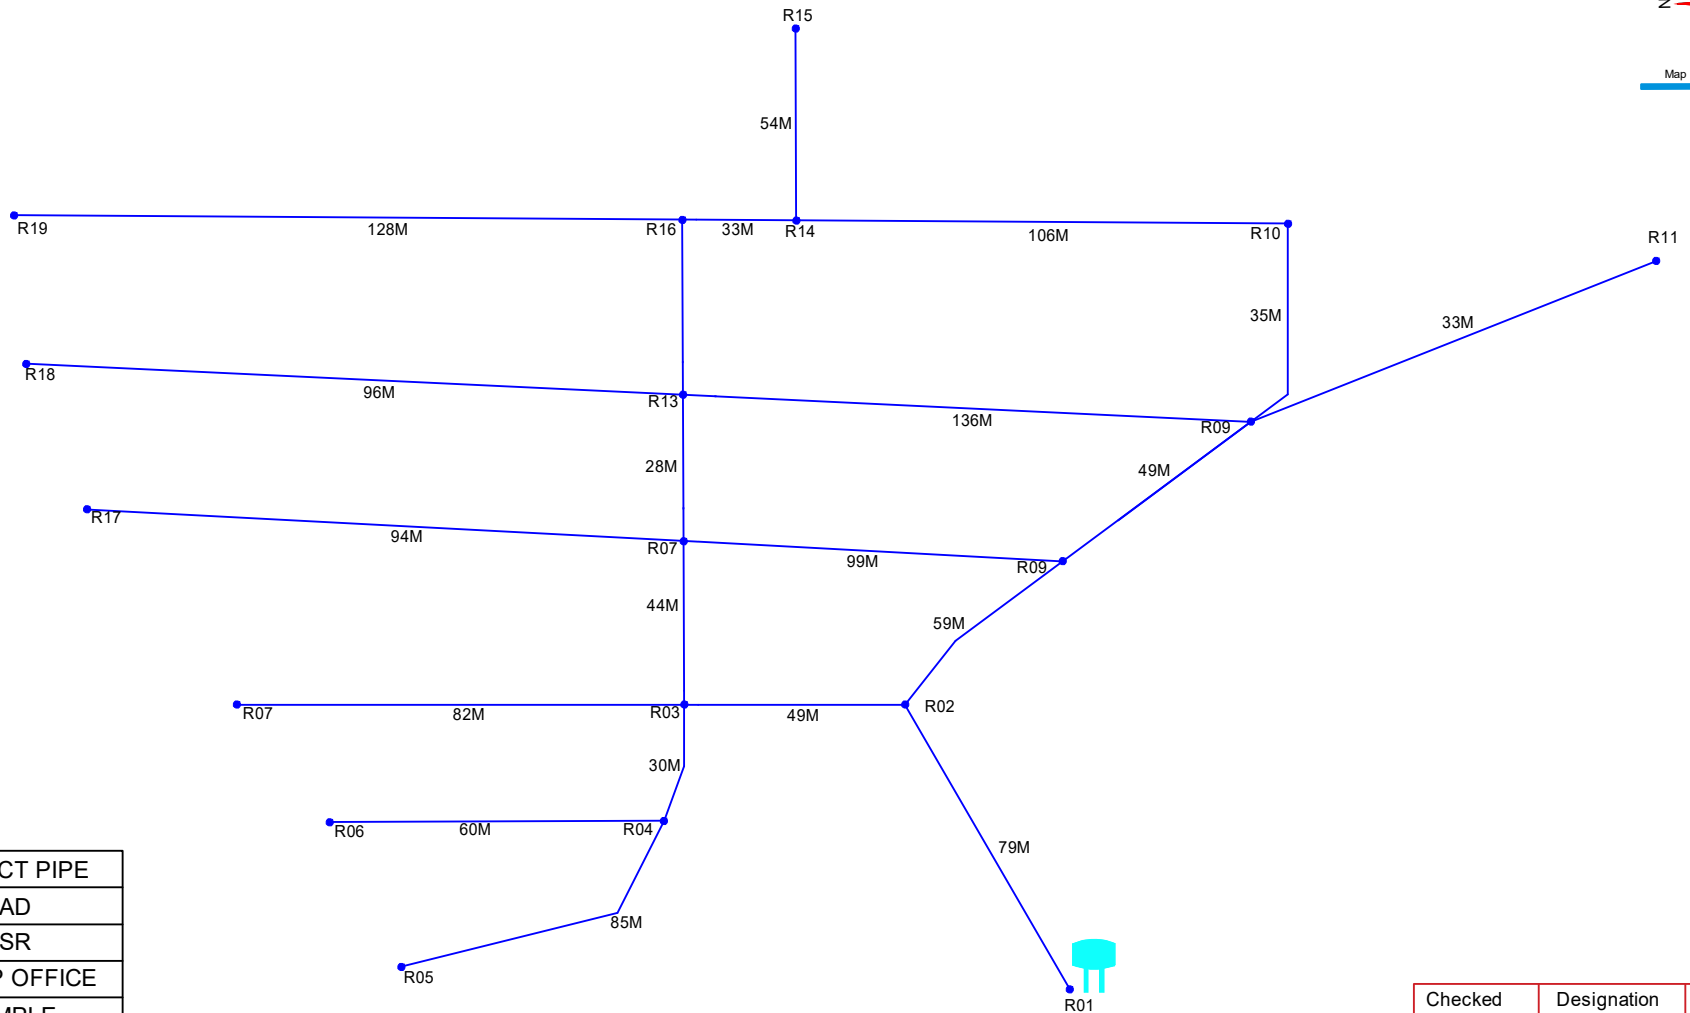

AS - BUILT DRAWINGS (ABD)

YENKEPALLE

(MOMINPET MANDAL-VIKARABAD DIST.)

SINGLELINE LOOP DIAGRAM FOR YENKEPALLE OHSR1 (MOMINPET)





	DUCT PIPE
	ROAD
	OHSR
	G.P OFFICE
	TEMPLE
	HOSPITAL
	SCHOOL
	DUCT GAP

Sheet No. 01
Route Distance : 2631 M

Checked	Designation	Signature

DUCTLAYING ROUTE DIAGRAM FOR YENKEPALLE OHSR1 (MOMINPET)

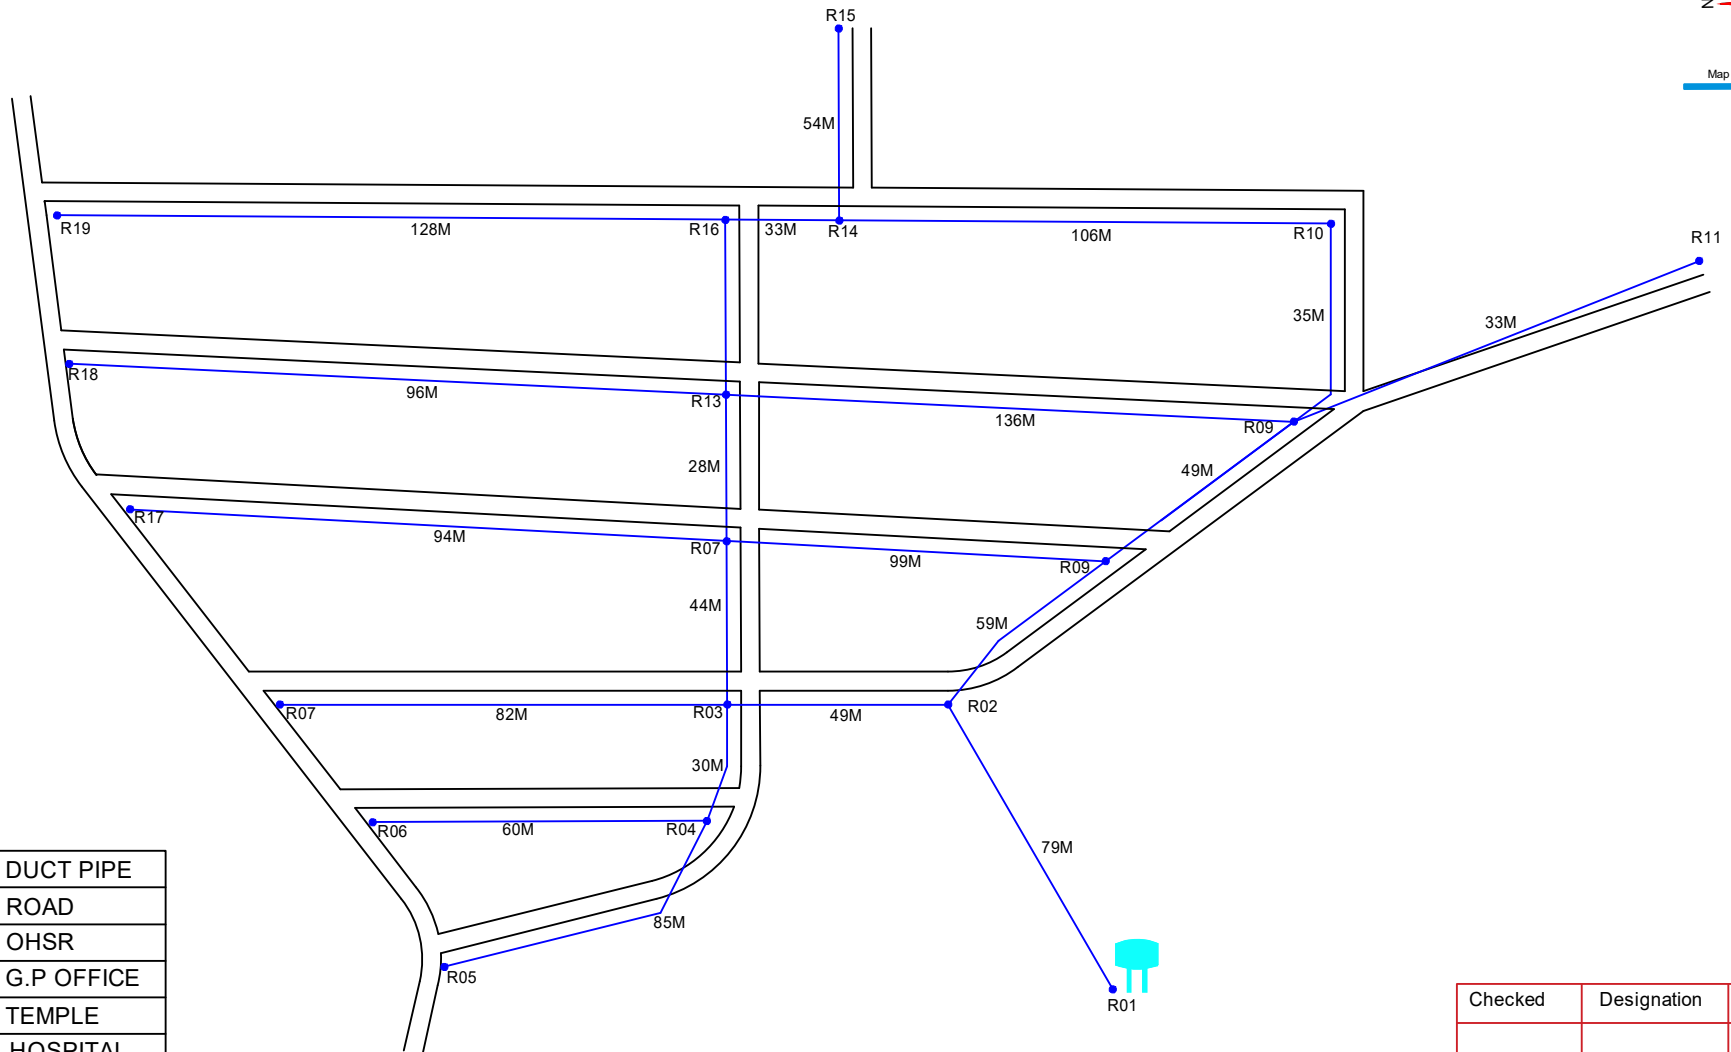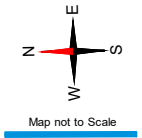


	DUCT PIPE
	ROAD
	OHSR
	G.P OFFICE
	TEMPLE
	HOSPITAL
	SCHOOL
	DUCT GAP

Sheet No. 01
Route Distance : 2631 M

Checked	Designation	Signature


ROAD OFFSET DETAILING FOR YENKEPALLE OHSR1 (MOMINPET)

Arb : R01-R02

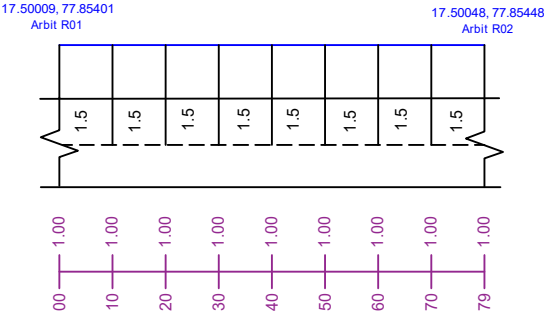


Length : 79 M

Arb : R02-R03

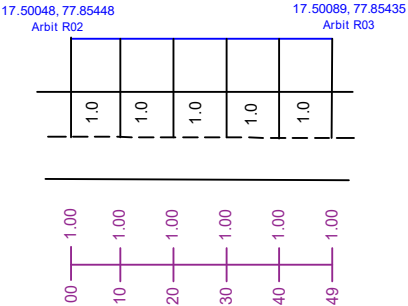


Length : 49 M

Arb : R03-R04

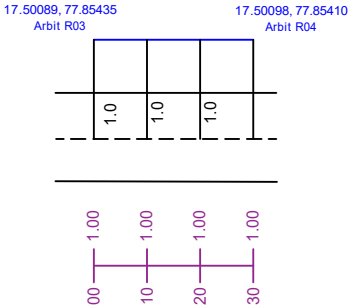


Length : 30 M

Arb : R04-R05

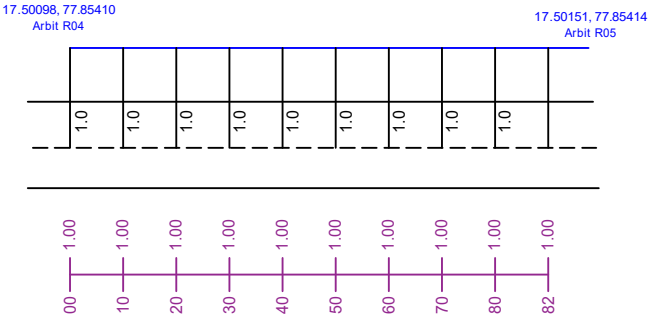

Length : 82 M

Arb : R04-R06

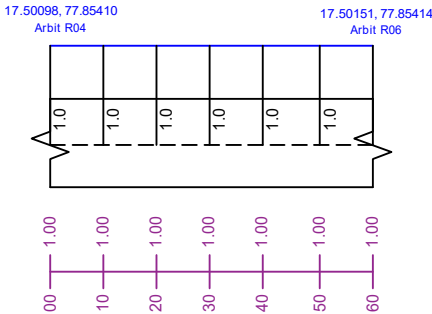


Length : 60 M

Checked	Designation	Signature


ROAD OFFSET DETAILING FOR YENKEPALLE OHSR1 (MOMINPET)

Arb : R03-R07

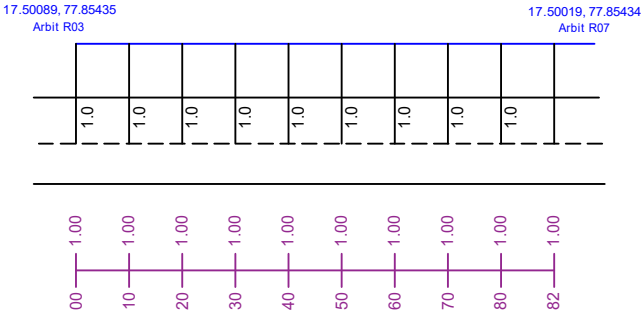


Length : 82 M

Arb : R02-R08

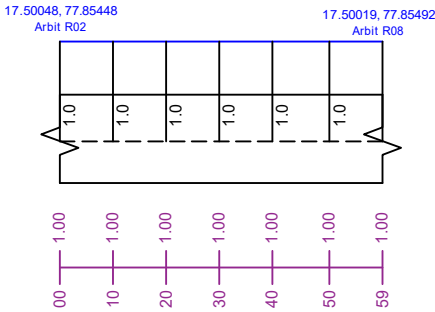


Length : 59 M

Arb : R08-R09

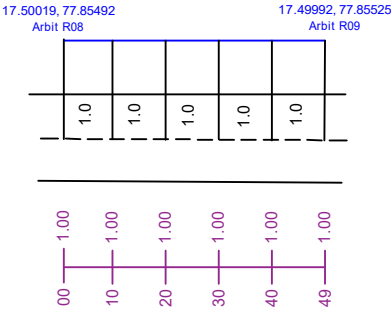


Length : 49 M

Arb : R09-R10

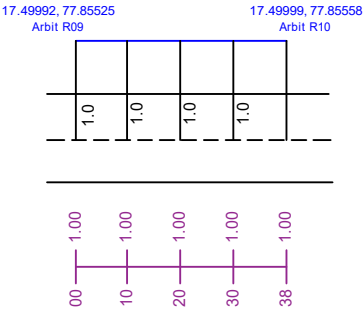


Length : 38 M

Arb : R09-R11

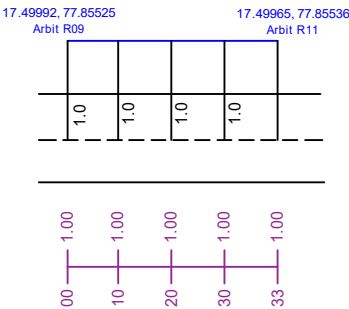

Length : 33 M

Arb : R08-R12

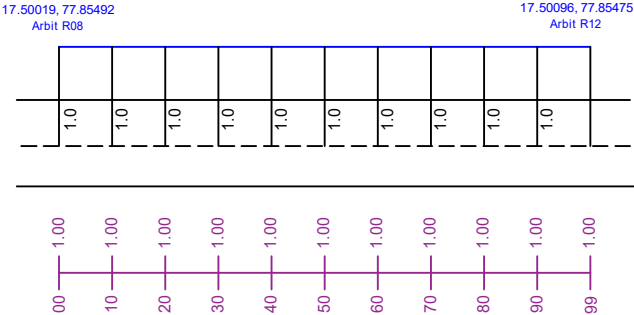


Length : 99 M

Checked	Designation	Signature


ROAD OFFSET DETAILING FOR YENKEPALLE OHSR1 (MOMINPET)

Arb : R03-R12

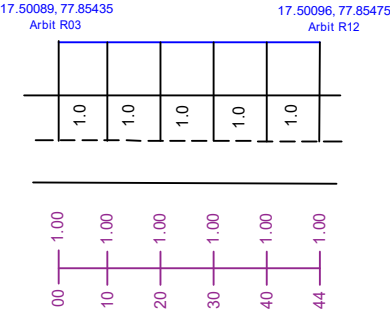


Length : 44 M

Arb : R09-R13

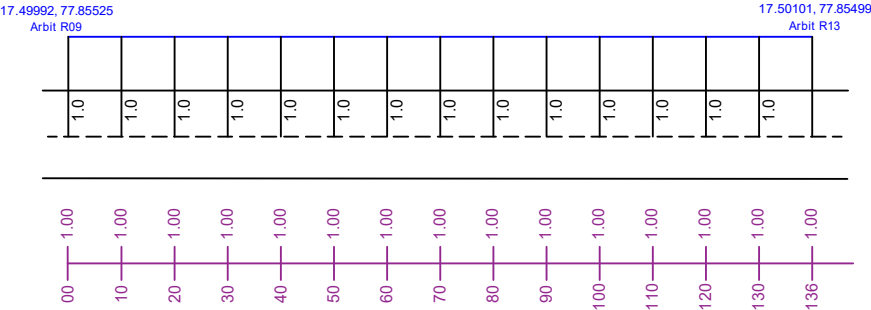


Length : 136 M

Arb : R12-R13

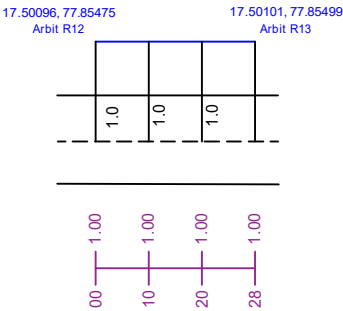


Length : 28 M

Arb : R10-R14

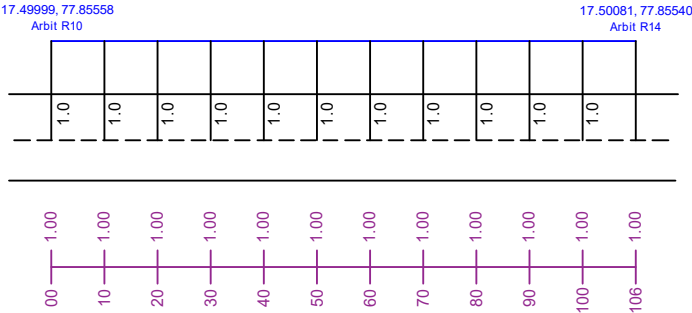


Length : 106 M

Arb : R14-R15

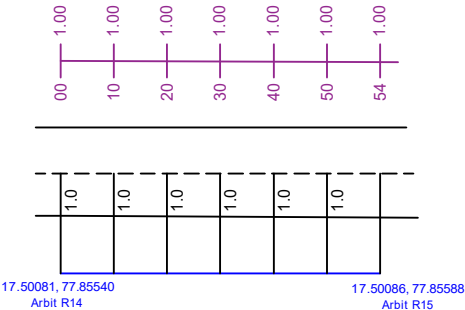

Length : 54 M

Arb : R14-R16

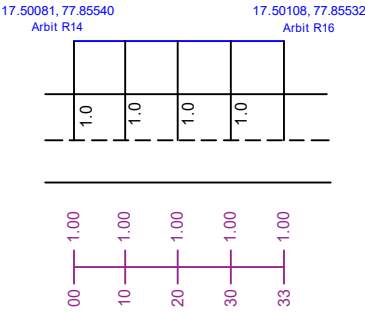

Length : 33 M



Checked	Designation	Signature

ROAD OFFSET DETAILING FOR YENKEPALLE OHSR1 (MOMINPET)

Arb : R13-R16

17.50101, 77.85499
Arbit R13

17.50108, 77.85532
Arbit R16

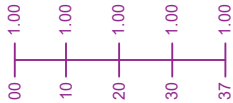
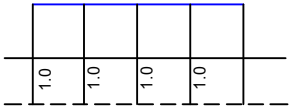


Length : 37 M

Arb : R12-R17

17.50096, 77.85475
Arbit R12

17.50169, 77.85463
Arbit R17

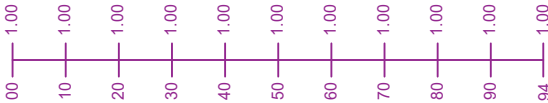
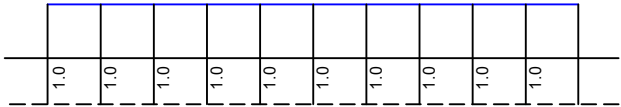


Length : 94 M

Arb : R13-R18

17.50101, 77.85499
Arbit R13

17.50175, 77.85482
Arbit R18

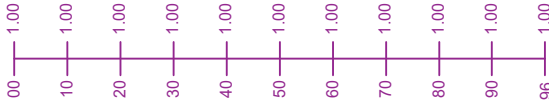
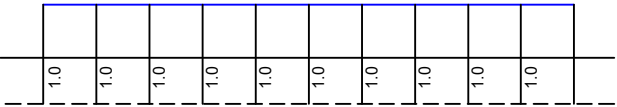


Length : 96 M

Arb : R16-R19

17.50108, 77.85532
Arbit R16


17.50212, 77.85514
Arbit R19

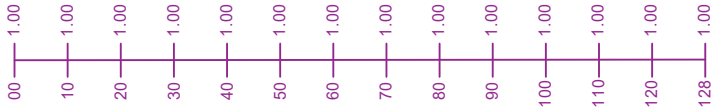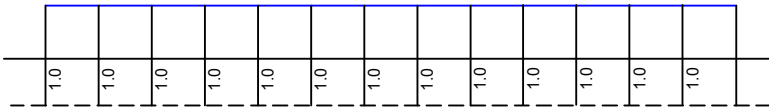

Length : 128 M

Checked	Designation	Signature



ROAD OFFSET DETAILING FOR YENKEPALLE OHSR1 (MOMINPET)

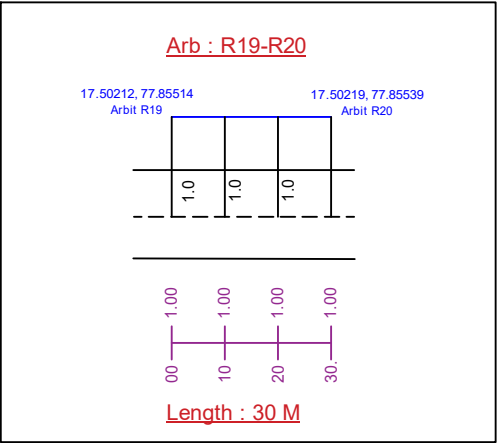
 






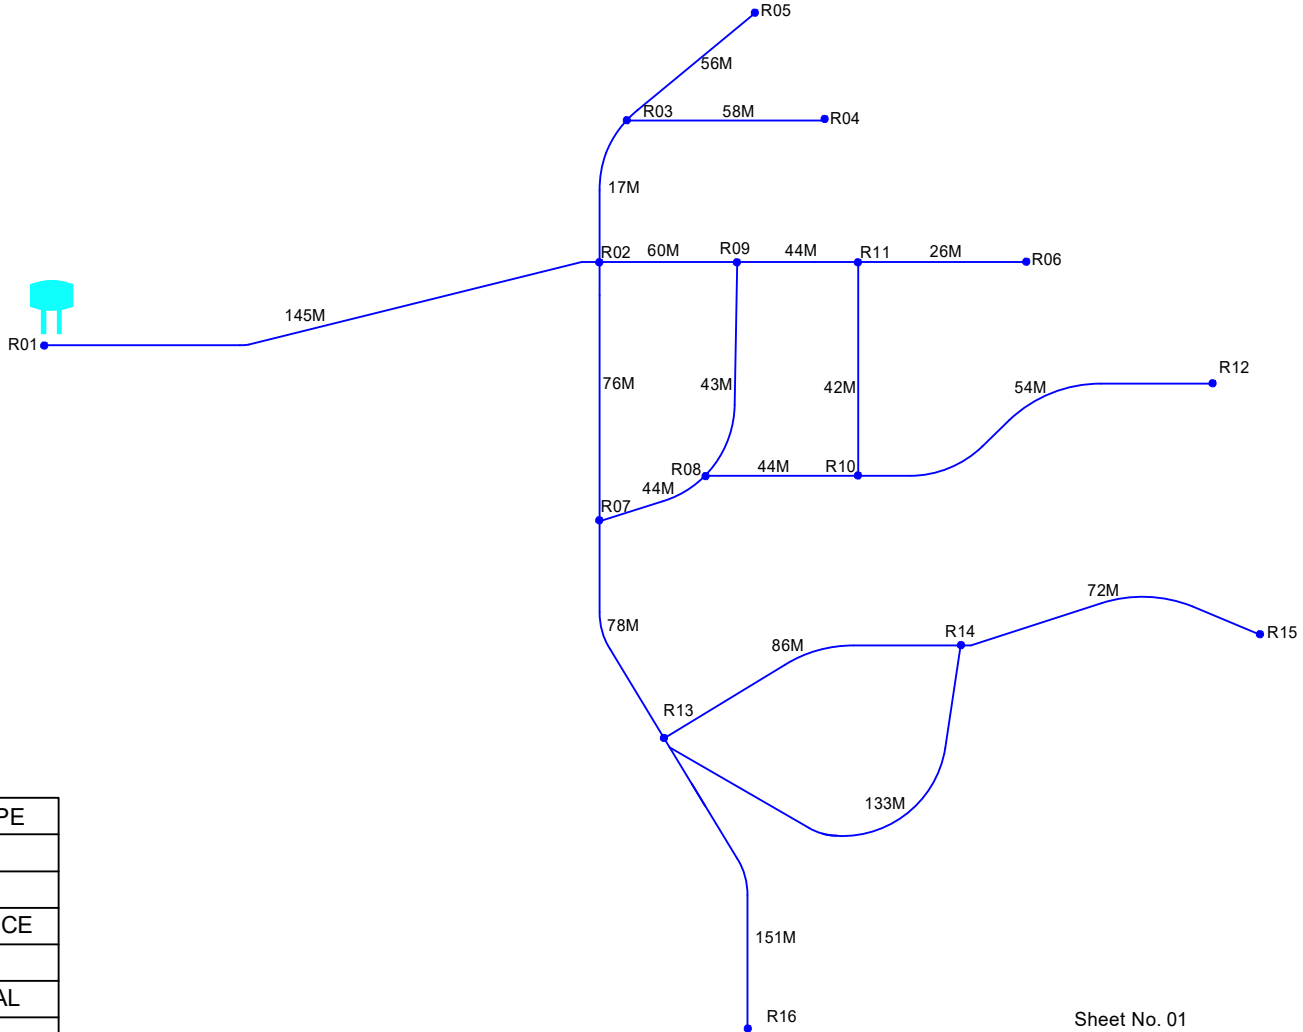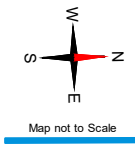

Sheet No. 05
Route Distance : 2631 M

Checked	Designation	Signature

SINGLELINE LOOP DIAGRAM FOR YENKEPALLE OHSR2 (MOMINPET)






 






	DUCT PIPE
	ROAD
	OHSR
	G.P. OFFICE
	TEMPLE
	HOSPITAL
	SCHOOL
	DUCT GAP

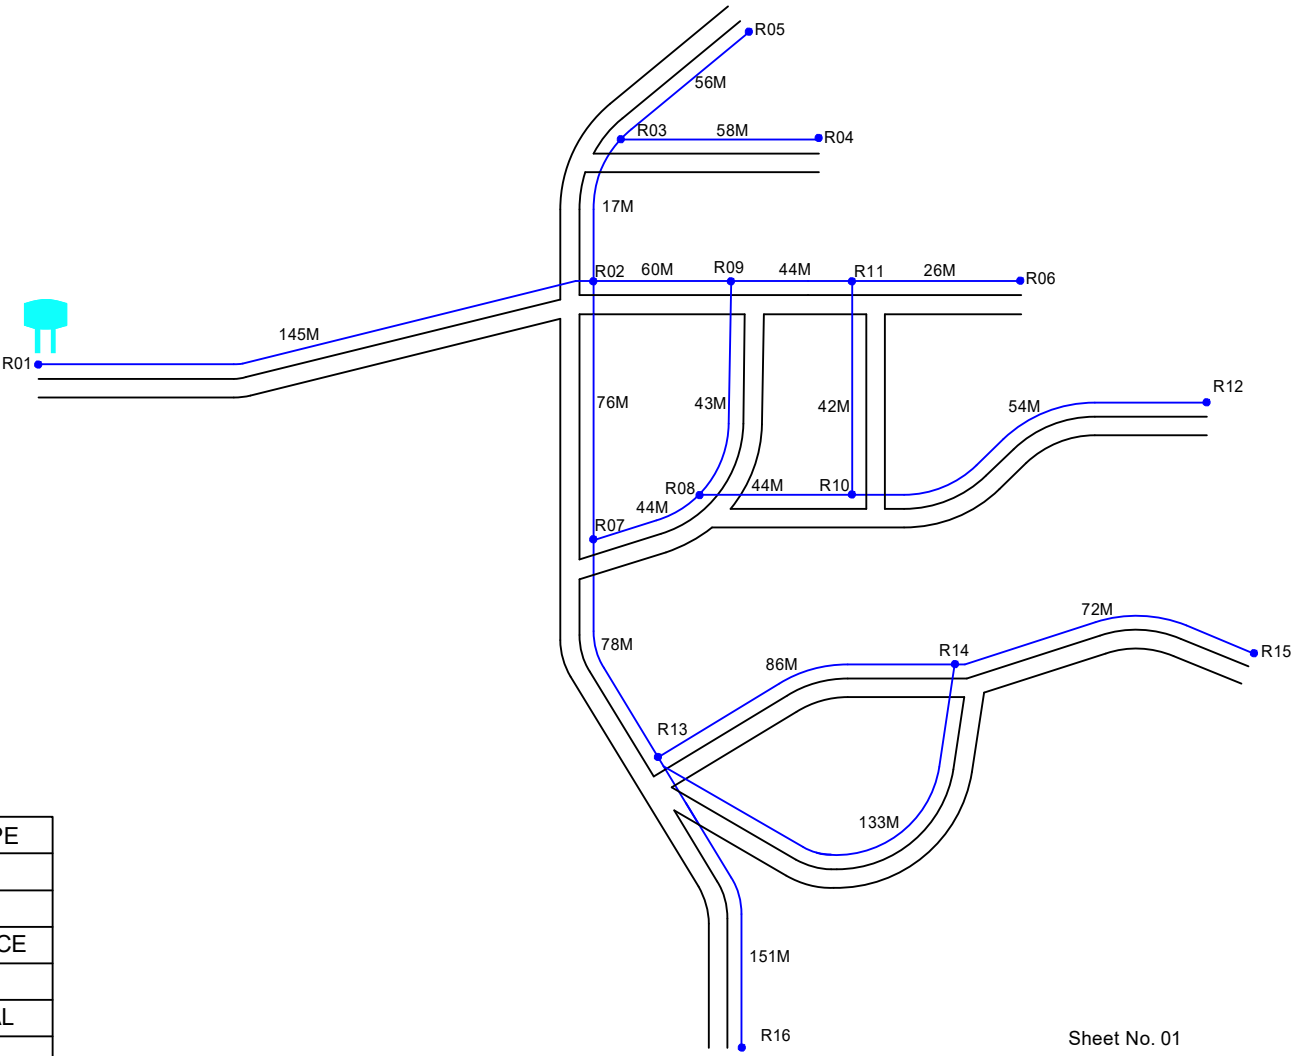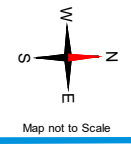Sheet No. 01
Route Distance : 2631 M

Checked	Designation	Signature

DUCTLAYING ROUTE DIAGRAM FOR YENKEPALLE OHSR2 (MOMINPET)




	DUCT PIPE
	ROAD
	OHSR
	G.P OFFICE
	TEMPLE
	HOSPITAL
	SCHOOL
	DUCT GAP

Sheet No. 01
Route Distance : 2631 M

Checked	Designation	Signature


ROAD OFFSET DETAILING FOR YENKEPALLE OHSR2 (MOMINPET)

Arb : R01-R02

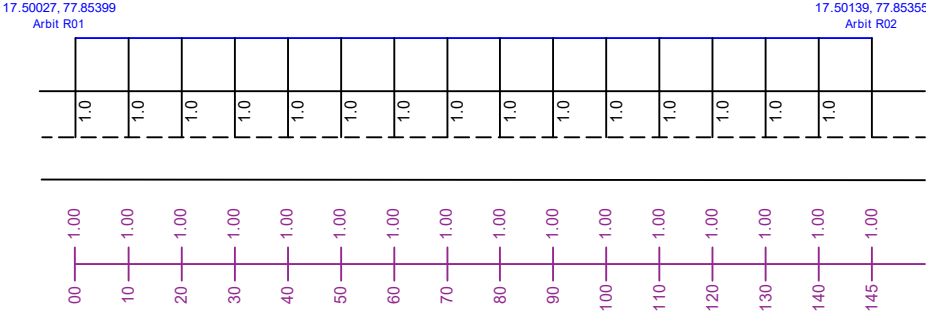


Length : 145 M

Arb : R02-R03

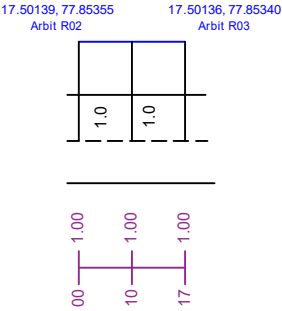


Length : 17 M

Arb : R03-R04

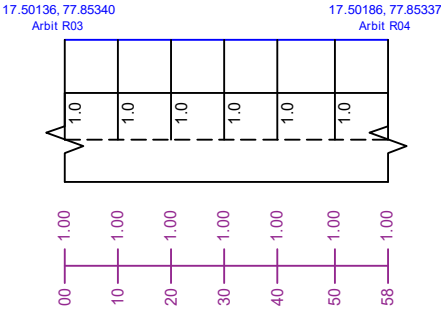


Length : 58 M

Arb : R03-R05

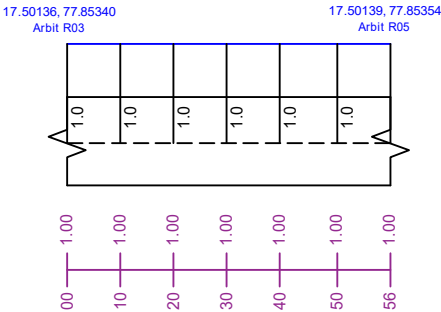


Length : 56 M

Arb : R02-R07

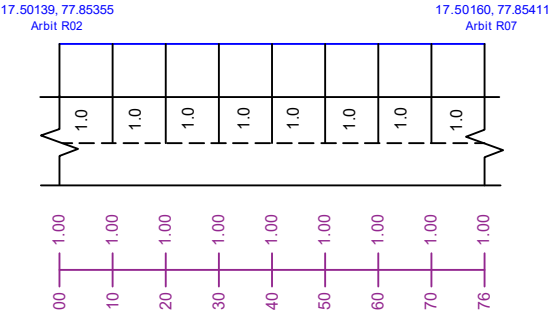

Length : 76 M

Arb : R07-R08

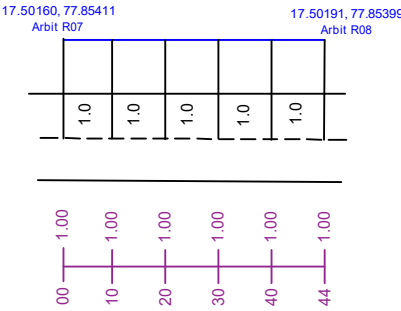


Length : 44 M


Checked	Designation	Signature

ROAD OFFSET DETAILING FOR YENKEPALLE OHSR2 (MOMINPET)


Arb : R08-R09

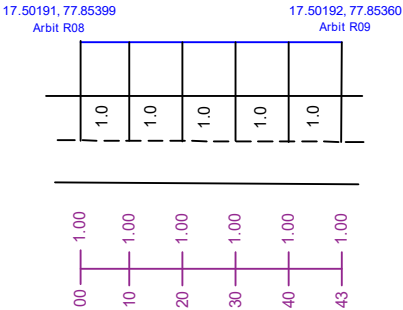


Arb : R10-R11

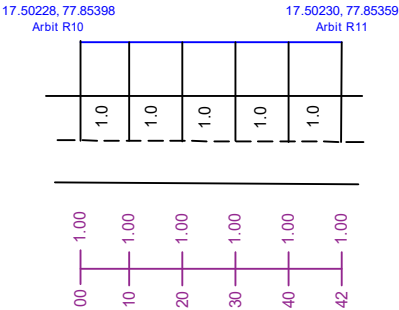


Arb : R02-R09

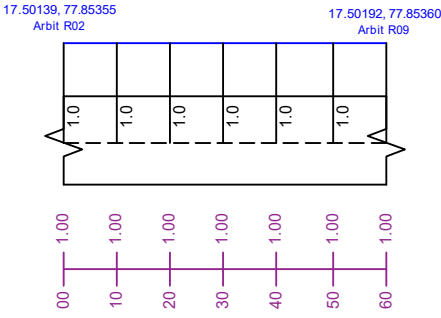


Arb : R09-R11

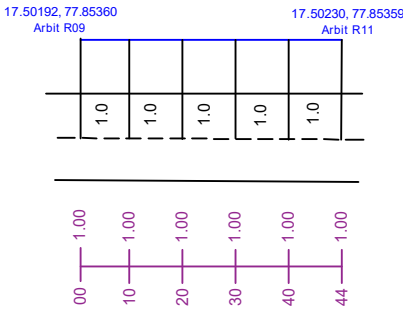

Arb : R11-R06




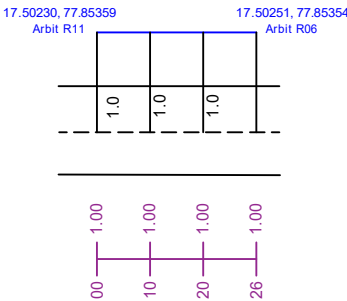


Arb : R10-R12

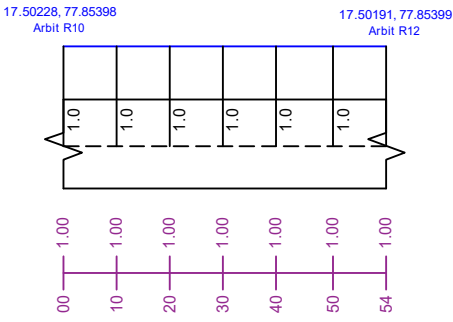


Checked	Designation	Signature

ROAD OFFSET DETAILING FOR YENKEPALLE OHSR2 (MOMINPET)

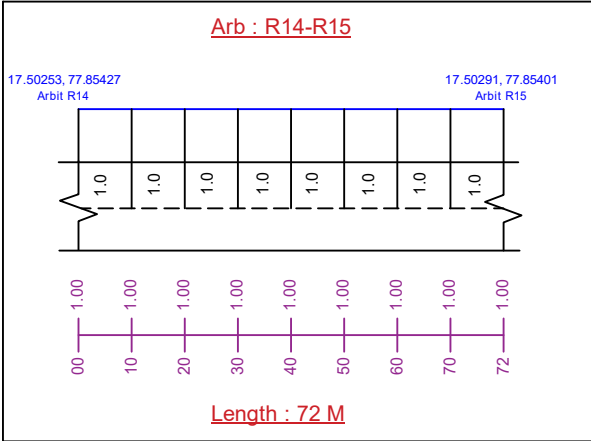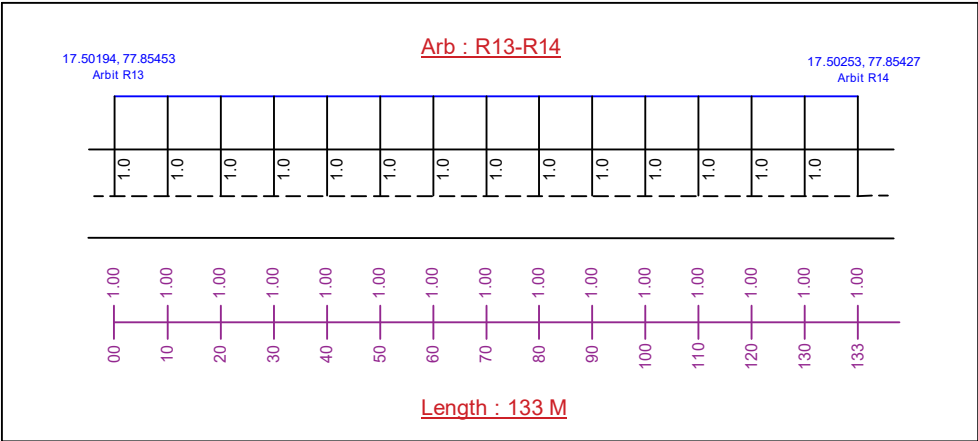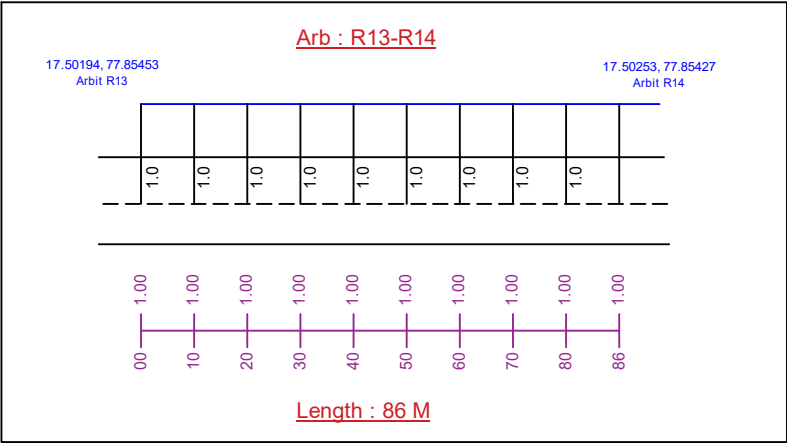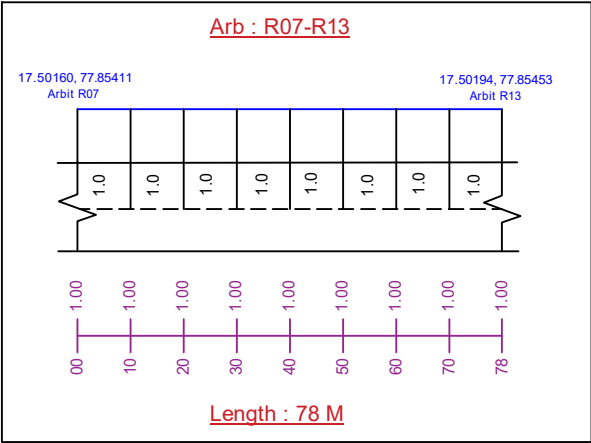

Checked	Designation	Signature

ROAD OFFSET DETAILING FOR YENKEPALLE OHSR2 (MOMINPET)

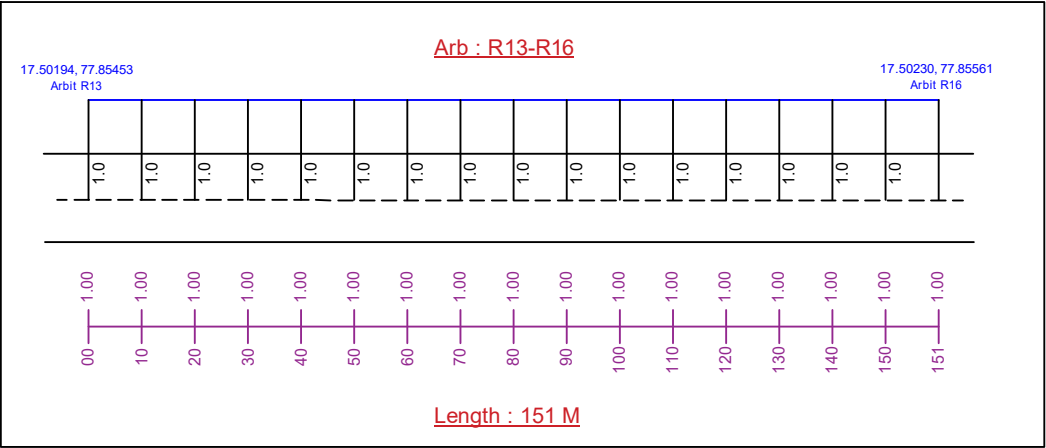

Checked	Designation	Signature